
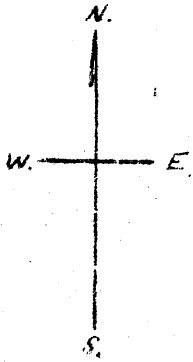


Latitude 39° 35'

Longitude 81° 00'

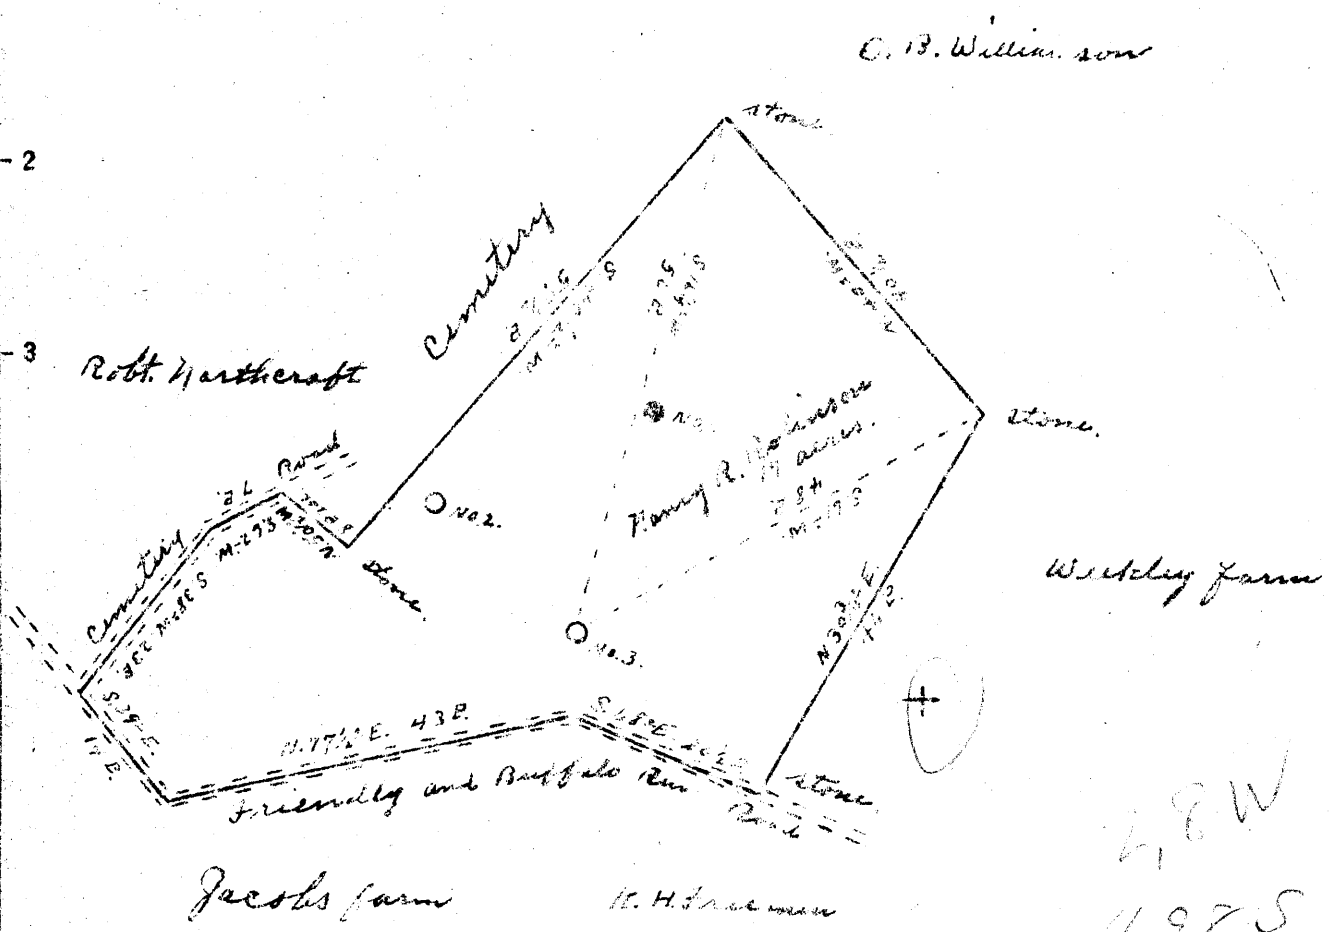

New Location X
 Drill Deeper
 Abandonment

Abd. June 52

Company Carmel Oil Company
 Address New Matamoras Ohio
 Farm Nancy R. Robinson
 Tract _____ Acres 17 Lease No. _____
 Well (Farm) No. 3 Serial No. _____
 Elevation (Spirit Level) 865'
 Quadrangle New Matamoras SE.
 County Tyler District Union
 Engineer Robert R. Anderson
By Triplicat. Surveys
 Engineer's Registration No. 296
 File No. _____ Drawing No. _____
 Date Dec. 24, 1909 Scale 1" = 20'

STATE OF WEST VIRGINIA
 DEPARTMENT OF MINES
 OIL AND GAS DIVISION
 CHARLESTON

WELL LOCATION MAP
 FILE NO. 24-176

+ Denotes location of well on U.S. States
 Topographic Maps, scale 1 to 62,500,
 latitude and longitude lines being represented
 by border lines as shown.

- Denotes one inch spaces on border line
 of original tracing.

WEST VIRGINIA DEPARTMENT OF MINES
OIL & GAS DIVISION
W E L L R E C O R D

Permit No. Tyl 176
New Matamoras Quad.
Company
Address
Farm
Location
Well No.
District
Surface
Mineral
Commenced
Completed
Date shot
Oil
Fresh Water
Salt Water

Carmel Oil Co.
New Matamoras, Ohio
E.L. Robinson Acres 40
No. 3 Elev. 865'
Union Tyler County
E.L. & Nancy Robinson
Box 13, Friendly, W.Va.
Same
April 10, 1950
May 20, 1950
5-5-50 Depth 1625 to 1629½
with 40 qts. glycerine
4 bbls. 1st 24 hrs.
418'; 1195'
1625'

Oil Well
CASING & TUBING

10	100		
8½	720		
6 5/8	1277	1277	
2			1658
Perf. bottom 1627½			
Coal at 400' 24"			

Top clay		0	13	
Sandstone	Y	13	25	
Red Rock		25	75	
Sand Gr		75	195	
Lime Red		195	265	
Sandy Shale Blue		265	400	
Coal Blk		400	402	
Shale Gr		402	416	
Sandy Shale Gr		416	428	
Lime and Shale Lt		428	512	
Red Rock		512	620	
Shale Gr		620	670	
Pink Rock		670	715	
Shale		715	765	
Lime Gr		765	840	Broken
Shale		840	900	
Sand White		900	910	
Shale		910	990	
Sand White		990	1000	
Shale Gray		1000	1040	
Sand White	H	1040	1085	
Shale Blue		1085	1097	
Lime Sandy		1097	1120	
Shale		1120	1150	
Sand		1150	1165	
Shale		1165	1175	
Sand Wh	H	1175	1210	
Shale Blk		1210	1260	
Lime Gr		1260	1285	
Shale Blk	S	1285	1360	
Sand Gr		1360	1445	
Shale Blk		1445	1495	
Lime Blk		1495	1545	Broken
Lime White		1545	1598	
Sand Keener		1598	1608	
Lime White	H	1608	1625	
Sand Injun		1625	1658	
T.D.			1658	

Oil - very little gas
Salt Water
Pay 1625-1629½

Handwritten notes:
1598
585
733
1625
1629½