

Company DELBERT BACHELOR

Address MOUNTAIN, W.VA.

Farm W.D. DAVIS

Tract 1 Acres 125 Lease No. _____

Well (Farm) No. 1 Serial No. _____

Elevation (Spirit Level) 1108.7'

Quadrangle WEST UNION C

County TYLER District CENTERVILLE

Engineer J.M. Cochran

Engineer's Registration No. 60 Surveyor

File No. _____ Drawing No. _____

Date 1-23-'52 Scale 1" = 600'

STATE OF WEST VIRGINIA
 DEPARTMENT OF MINES
 OIL AND GAS DIVISION
 CHARLESTON

WELL LOCATION MAP
 FILE NO. JYL-207

+ Denotes location of well on United States Topographic Maps, scale 1 to 62,500, latitude and longitude lines being represented by border lines as shown.

-- Denotes one inch spaces on border line of original tracing.

60 (087)



STATE OF WEST VIRGINIA
DEPARTMENT OF MINES
OIL AND GAS DIVISION

WELL RECORD

Permit No. Ty-207

Oil or Gas Well dry hole
(KIND)


Company Bachelor Kay Inc
Address Mountain Sh Va
Farm R.D. Davis Acres 125
Location (waters) Big Run
Well No. 1 Elev. 1108-7
District Centerville County Pulaski
The surface of tract is owned in fee by R.D. Davis
Address Joseph Mills
Mineral rights are owned by W.H. News et al
Address Mountain
Drilling commenced 2/12/52
Drilling completed 2/25/52
Date Shot No shot From _____ To _____
With _____

Casing and Tubing	Used in Drilling	Left in Well	Packers
Size			Kind of Packer
16			
13			
10	<u>21'</u>		Size of
8 1/4	<u>600</u>		
6 3/4	<u>1077</u>		Depth set
5 3/16			
3			Perf. top
2			Perf. bottom
Liners Used			Perf. top
			Perf. bottom

Open Flow _____ /10ths Water in _____ Inch
_____ /10ths Merc. in _____ Inch
Volume _____ Cu. Ft.
Rock Pressure _____ lbs. _____ hrs.
Oil No oil dug bbls., 1st 24 hrs.
Fresh water _____ feet
Salt water 200 ft over night feet

CASING CEMENTED No SIZE _____ No-Ft. _____ Date _____
COAL WAS ENCOUNTERED AT 740 FEET 741 INCHES
_____ FEET _____ INCHES _____ FEET _____ INCHES
_____ FEET _____ INCHES _____ FEET _____ INCHES

Formation	Color	Hard or Soft	Top	Bottom	Oil, Gas or Water	Depth Found	Remarks
Soil			0	15			
Sand			15	75			
Red Rock			75	100			
Sand			100	150			
Slate			150	175			
Sand			175	200			
Red Rock			200	225			
Slate			225	250			
Limestone			250	265			
Slate			265	300			
Red Rock			300	350			
Sand			350	360			
Red Rock			360	390			
Sand			390	430			
Red Rock			430	450			
Sand			450	460			
Slate			460	500			
Red Rock			500	525			
Slate with shells			525	575			
Red Rock			575	585			
Sand			585	660			
Slate with shells			660	695			
Sand			695	710			
Slate			710	735			
Limestone			735	740			

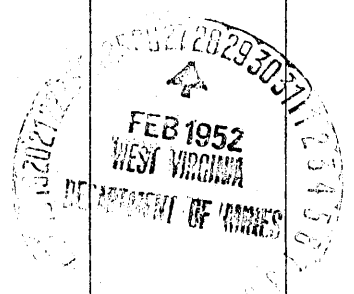

Formation	Color	Hard or Soft	Top	Bottom	Oil, Gas or Water	Depth Found	Remarks
Conc Pitts			740	741			
Lime Pitts			741	745			
Slate			745	760			
Red Rock			760	765			
Slate			765	840			
Red Rock			840	865			
Slate			865	895			
Red Rock			895	955			
Lime		Hard	955	960			
Slate & Shells			960	1010			
Black slate			1010	1050			
Pink Rock			1050	1055			
Slate			1055	1077			
Sand Con Run 1 in			1077	1105	Water	1100	
Slate			1105	1115			
Bottom of hole				1115			

Date 2/26, 1942

APPROVED Bachelor Ray Jr, Own

By Bachelor Ray Jr
(Title)