


M

Latitude 39° 30'


Longitude 80° 55'

M. E. ROBINSON

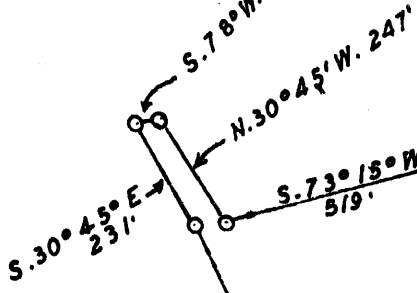

W. C. SOLE
34 ACRES


411 S
1.87 W

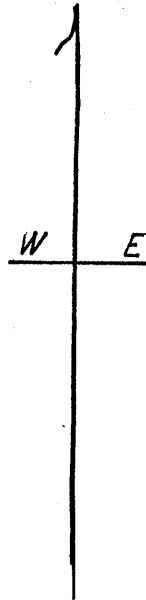

J. H. HADLEY

Br. of Little Sancho Creek

JOHN WILKARD

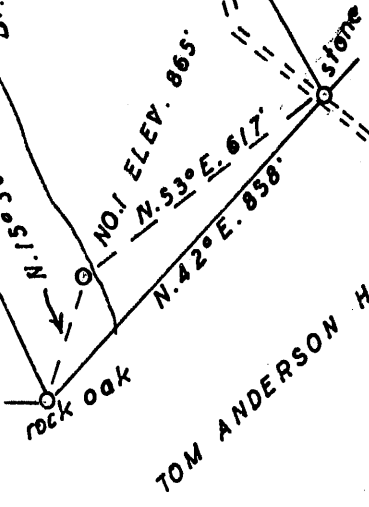

TOM ANDERSON HEIRS

- New Location...
- Drill Deeper.....
- Abandonment.....

Company	<u>O. E. HADLEY</u>
Address	<u>RT. 1. MIDDLEBOURNE. W. VA.</u>
Farm	<u>W. C. SOLE</u>
Tract	Acres <u>34</u> Lease No. _____
Well (Farm) No.	<u>1</u> Serial No. _____
Elevation (Spirit Level)	<u>865'</u>
Quadrangle	<u>WEST UNION</u>
County	<u>TYLER</u> District <u>MEADE</u>
Engineer	<u>George R. Clarke</u>
Engineer's Registration No.	<u>102</u>
File No.	_____ Drawing No. _____
Date	<u>AUG. 29. 1955</u> Scale <u>1" = 400'</u>

STATE OF WEST VIRGINIA
DEPARTMENT OF MINES
OIL AND GAS DIVISION
CHARLESTON

WELL LOCATION MAP
FILE NO. JYL-244

- + Denotes location of well on United States Topographic Maps, scale 1 to 62,500, latitude and longitude lines being represented by border lines as shown.
- Denotes one inch spaces on border line of original tracing.

5-0-0



STATE OF WEST VIRGINIA
DEPARTMENT OF MINES
OIL AND GAS DIVISION

Quad - West Union

Permit No. TYL-244

WELL RECORD

Oil or Gas Well Dry
(TYPE)


Company O. E. HADLEY
Address RED #1 MIDDLEBOURNE, W. VA
Farm W. E. Sole Acres 190
Location (waters) LITTLE SAND
Well No. 1 Elev. 865'
District MEADE County TYLER
The surface of tract is owned in fee by W. E. SOLE
MIDDLEBOURNE Address W. VA
Mineral rights are owned by SAME
Address _____
Drilling commenced SEPT - 1955
Drilling completed OCT - 1955
Date Shot From _____ To _____
With _____
Open Flow /10ths Water in _____ Inch
/10ths Merc. in _____ Inch
Volume 5-10 THOUSAND Cu. Ft.
Rock Pressure 165 lbs. 16 hrs.
Oil NONE bbls., 1st 24 hrs.
Fresh water _____ feet _____ feet
Salt water _____ feet _____ feet

Casing and Tubing	Used in Drilling	Left in Well	Packers
Size			Kind of Packer
16			
13			
10	<u>225</u>		Size of
8 1/2	<u>950 ft</u>		
6 1/2	<u>1370 "</u>		Depth set
5 3/16			
3			Perf. top
2			Perf. bottom
Liners Used			Perf. top
			Perf. bottom

CASING CEMENTED _____ SIZE _____ No. Ft. _____ Date _____
COAL WAS ENCOUNTERED AT _____ FEET _____ INCHES
_____ FEET _____ INCHES FEET _____ INCHES
_____ FEET _____ INCHES FEET _____ INCHES

Formation	Color	Hard or Soft	Top	Bottom	Oil, Gas or Water	Depth Found	Remarks
SURFACE	RED	SOFT	0	100			
LIME	WHITE	HARD	100	152			
SAND	" "		152	190			
RED LIME	SOFT		190	210			
SAND			210	310			
RED ROCK			310	330			
BROKEN LIME			330	480			
RED ROCK			480	557			
SAND			557	700			
PINK ROCK			700	740			
SLATE			740	743			
LIME			743	860			
SLATE LIME			860	895			
SAND			895	1003			
SLATE LIME			1003	1070			
SAND			1070	1325			
SLATE LIME			1325	1350			
SAND			1350	1388			
LIME SLATE			1388	1435			
SAND			1435	1460			
LIME			1460	1565			
SAND 3rd salt			1565	1631			
SLATE LIME			1631	1681			
SAND			1681	1706			
BIG LIME			1706	1757			
NEEDLE SAND			1757	1782			
BIG BENTONITE			1782	1865			
BREAK			1865	1870			
TOTAL				1870			

1706
865
841

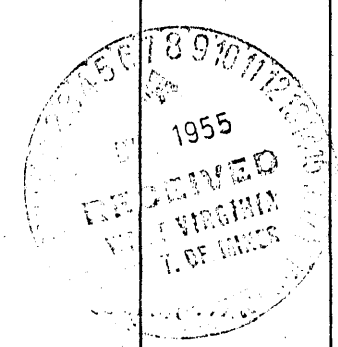

FARMER WANTS A WATER WELL LEFT
of OK WITH YOU