


Latitude 39° 35'

Longitude 81° 00'

2645  
0.19W

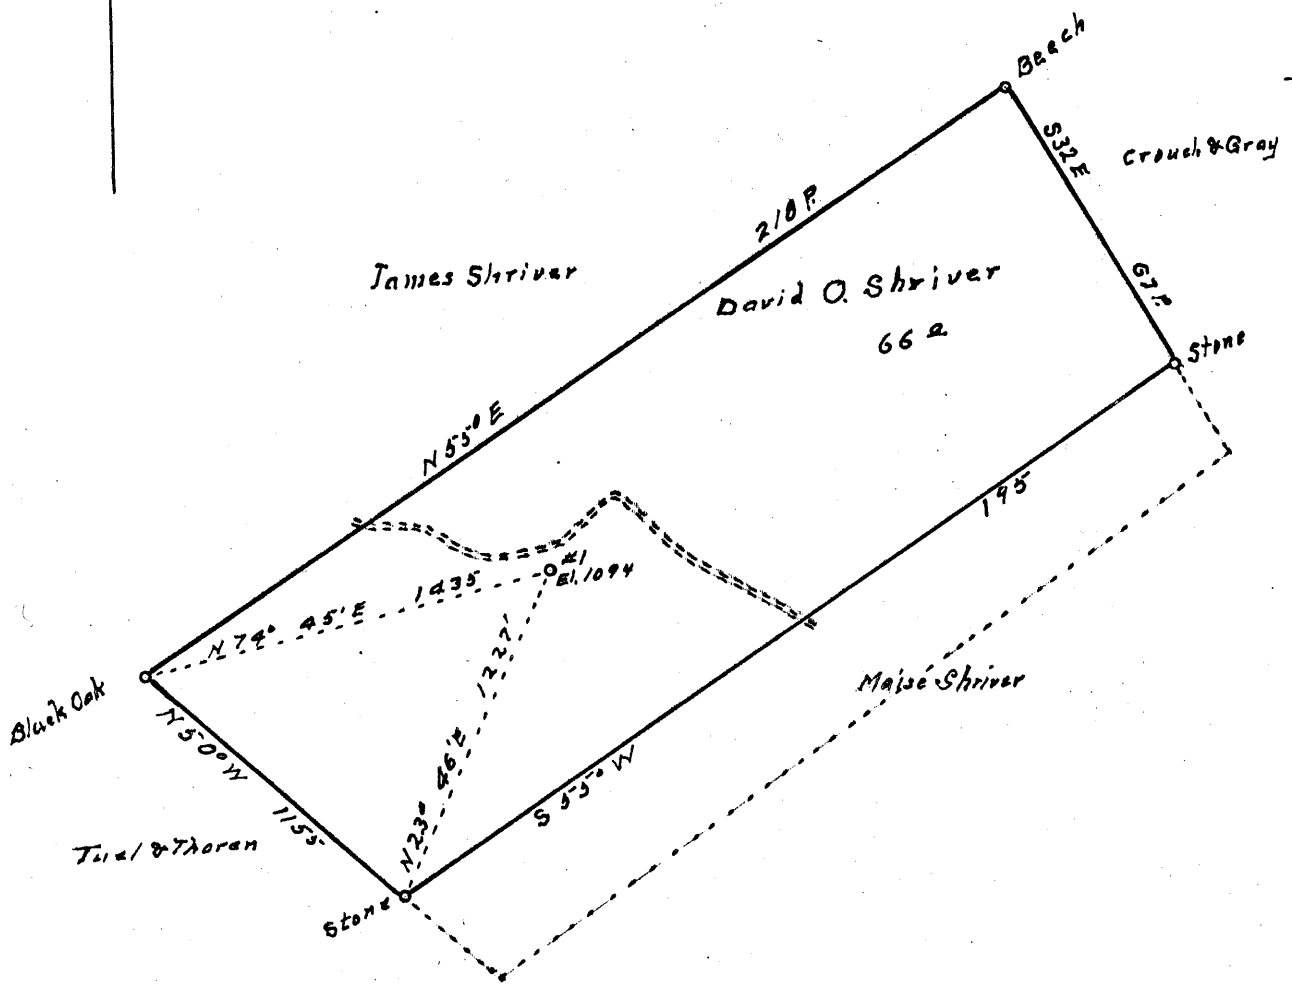

New Location..   
 Drill Deeper.....   
 Abandonment.....

Company Jack G. Howe & Keith Robinson  
 Address 602 Mt. Nat. Bank Bldg. Denver, Colorado  
 Farm David O. Shriver  
 Tract \_\_\_\_\_ Acres 66 Lease No. \_\_\_\_\_  
 Well (Farm) No. 1 Serial No. \_\_\_\_\_  
 Elevation (Spirit Level) 1094  
 Quadrangle New Matamoros  
 County Tyler District Lincoln  
 Engineer Robert R. Anderson  
 Engineer's Registration No. 296  
 File No. \_\_\_\_\_ Drawing No. \_\_\_\_\_  
 Date August 29, 56 Scale 1" = 40 Poles

STATE OF WEST VIRGINIA  
 DEPARTMENT OF MINES  
 OIL AND GAS DIVISION  
 CHARLESTON

WELL LOCATION MAP  
 FILE NO. JYL-256

+ Denotes location of well on United States Topographic Maps, scale 1 to 62,500, latitude and longitude lines being represented by border lines as shown.

- Denotes one inch spaces on border line of original tracing.



STATE OF WEST VIRGINIA  
DEPARTMENT OF MINES  
OIL AND GAS DIVISION 7

Quadrangle New Matamoros

Permit No. TYL 256

**WELL RECORD**

Oil or Gas Well Dry  
(KIND)

Company Keith Robinson & Jack G. Howe  
Address B-416 U.S. Nat'l Bank Bldg., Denver, Colo.  
Farm D. O. Shriver Acres 66  
Location (waters) \_\_\_\_\_  
Well No. 1 Elev. 1094  
District Lincoln County Tyler  
The surface of tract is owned in fee by D. O. Shriver  
111 Catherine Street Address Sistersville, W. VA.  
Mineral rights are owned by D. O. Shriver  
Address Same  
Drilling commenced 11-16-56  
Drilling completed 12-31-56  
Date Shot None From \_\_\_\_\_ To \_\_\_\_\_  
With None  
Open Flow /10ths Water in 0 Inch  
/10ths Merc. in 0 Inch  
Volume 0 Cu. Ft.  
Rock Pressure 0 lbs. \_\_\_\_\_ hrs.  
Oil 0 bbls., 1st 24 hrs.  
WELL ACIDIZED none  
WELL FRACTURED none

Casing and Tubing	Used in Drilling	Left in Well	Packers
Size			Kind of Packer <u>None</u>
16		none	
18		none	
10	29'	<del>pulled</del> <u>29' 300'</u>	Size of _____
8 1/4	1230	<del>pulled</del> <u>1230'</u>	Depth set _____
6 5/8	none	none	
5 3/16			
3			Perf. top <u>none</u>
2			Perf. bottom _____
Liners Used			Perf. top _____
			Perf. bottom _____

CASING CEMENTED none SIZE \_\_\_\_\_ No. Ft. \_\_\_\_\_ Date \_\_\_\_\_

COAL WAS ENCOUNTERED AT 449 FEET \_\_\_\_\_ INCHES  
710 FEET \_\_\_\_\_ INCHES FEET \_\_\_\_\_ INCHES  
\_\_\_\_\_ FEET \_\_\_\_\_ INCHES FEET \_\_\_\_\_ INCHES


RESULT AFTER TREATMENT none

ROCK PRESSURE AFTER TREATMENT none

Fresh Water \_\_\_\_\_ Feet Salt Water 1940 Feet

Formation	Color	Hard or Soft	Top	Bottom	Oil, Gas or Water	Depth	Remarks
Sandstone	White	Soft	0	20			
Redrock		Soft	20	90			
Slate	Dark	Soft	9	110			
Sandstone	White	Soft	110	140			
Slate	Dark	Soft	140	145			
Redrock		Soft	145	200			
Sandstone	White	Soft	200	215			
Slate	Dark	Soft	215	225			
Sandstone	White	Soft	225	240			
Slate & Shells	Light	Soft	240	350			
Redrock		Soft	350	370			
Slate & Shells	Light	Soft	370	449			
Coal			449	450			
Slate & Shell	Light	Soft	459	490			
Redrock		Soft	490	515			
Sandstone	White	Soft	515	522			
Lime	Gray	Soft	522	565			
Shale	Dark	Soft	565	575			
Sandstone	White	Soft	575	630			
Shale	Dark	Soft	630	690			
Sandstone	White	Soft	690	710			
Coal			710	711			
Sandstone	White	Soft	711	720			
Shale	Dark	Soft	720	725			
Sandstone	White	Soft	725	745			
Shale	Gray	Soft	745	785			
Sandstone	White	Soft	785	800			
Shale	Gray	Soft	800	805			
Sandstone	White	Soft	805	815			
Limestone	Gray	Soft	815	823			

1094  
710  
384

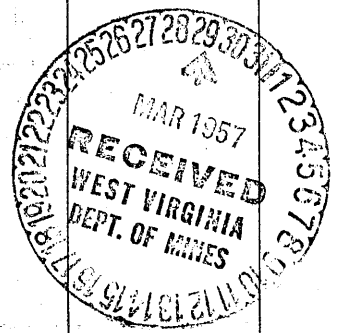

Pittsburgh

Formation	Color	Hard or Soft	Top	Bottom	Oil, Gas or Water	Depth Found	Remarks
Redrock		Soft	823	925			
Sandstone	White	Soft	925	970			
Shale	Gray	Soft	970	990			
Redrock		Soft	990	1018			
Sandstone	White	Soft	1018	1050			
Slate	Black	Hard	1050	1070			
Redrock		Soft	1070	1085			
Sandstone	White	Soft	1085	1117			
Shale	Gray	Soft	1117	1165			
Sandstone	White	Soft	1165	1210			
Limestone	Gray	Hard	1210	1260			
Sandstone	White	Soft	1260	1315	1849		
Shale	Gray	Soft	1315	1345	1694		
Sandstone	White	Soft	1345	1375	755		
Slate	Dark	Hard	1375	1410			
Sandstone	White	Soft	1410	1540			
Shale	Gray	Soft	1540	1663			
Sandstone	White	Soft	1663	1740			
Shale	Gray	Soft	1740	1785			
Sandstone	White	Soft	1785	1800			
Shale	Black	Soft	1800	1815			
Limestone	Gray	Hard	1815	1838			
Sandstone	White	Hard	1838	1849			
Limestone	Brown	Hard	1849	1866			
Sandstone	White	Hard	1866	1898	Show Oil & Gas	1884	
Slate	Black	Hard	1898	1917			
Sandstone	White	Hard	1917	2077	HFW	1940	
Limestone	Brown	Hard	2077	2100			
Slate	Black	Hard	2100	2123			
				TD			

Date 3/28/57, 19

APPROVED Keith Robinson, Owner

By \_\_\_\_\_ (Title)