


Latitude 39° 20'

Longitude 80° 50'

1.31 S
2.50 W

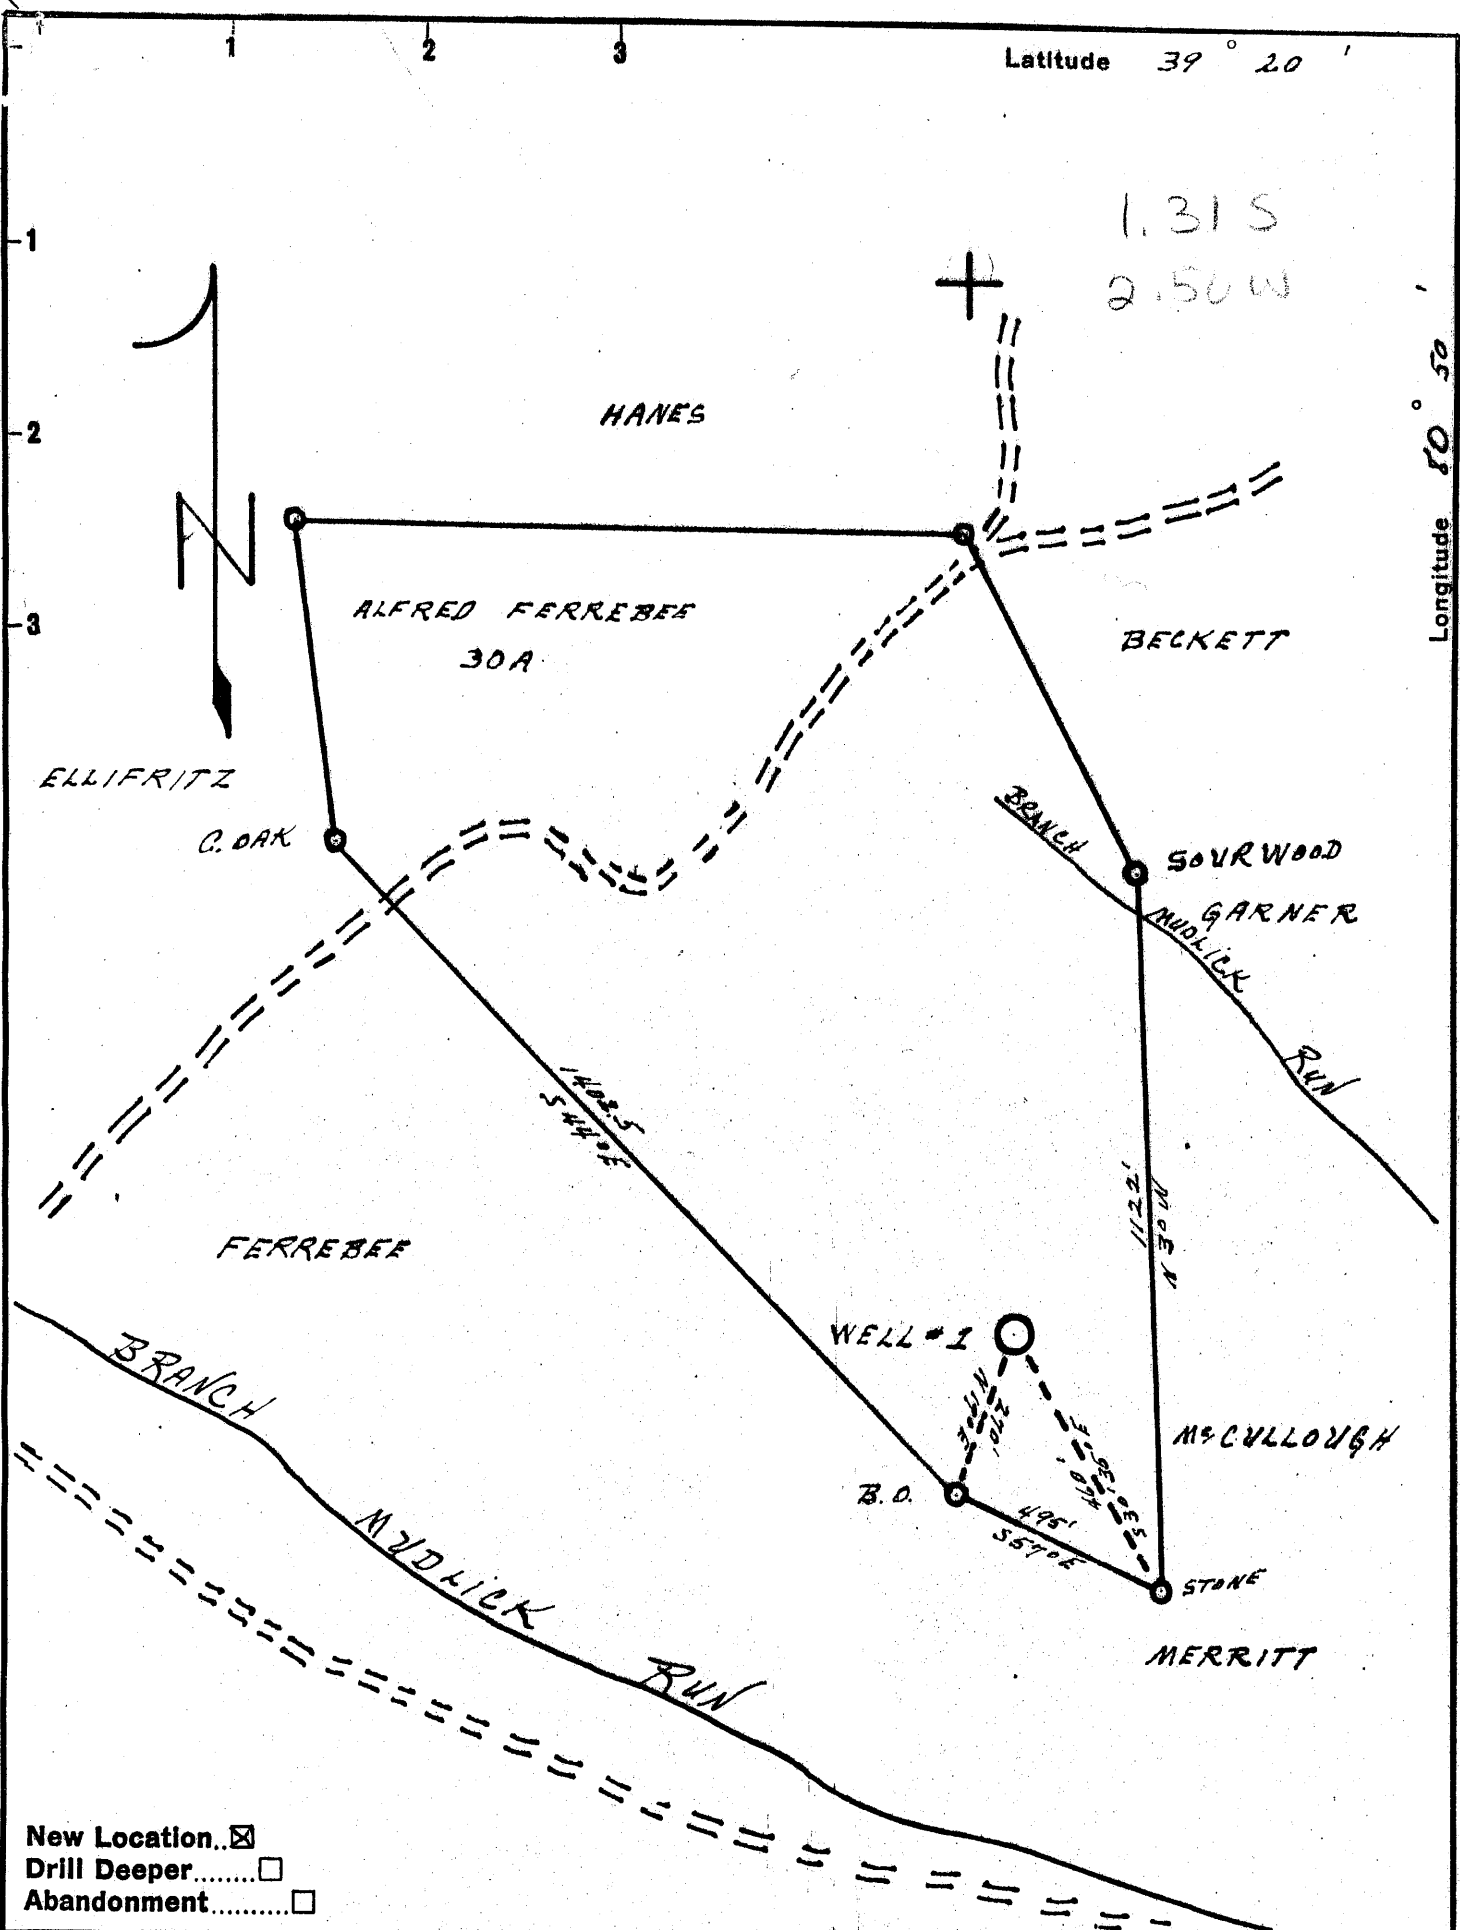

New Location...
 Drill Deeper.....
 Abandonment.....

Company W. H. MOSSOR
 Address HARRISVILLE, W. VA.
 Farm ALFRED FERREBEE
 Tract _____ Acres 30 Lease No. _____
 Well (Farm) No. HONE Serial No. _____
 Elevation (Spirit Level) 1090
 Quadrangle WEST UNION
 County TYLER District CENTERVILLE
 Engineer Donald W. Morris
 BY: J. F. DEEM
 Engineer's Registration No. 1653
 File No. _____ Drawing No. _____
 Date NOV 25, 1956 Scale 1" = 300'

STATE OF WEST VIRGINIA
 DEPARTMENT OF MINES
 OIL AND GAS DIVISION
 CHARLESTON

WELL LOCATION MAP
 FILE NO. JYL-259

+ Denotes location of well on United States Topographic Maps, scale 1 to 62,500, latitude and longitude lines being represented by border lines as shown.
 - Denotes one inch spaces on border line of original tracing.



STATE OF WEST VIRGINIA
DEPARTMENT OF MINES
OIL AND GAS DIVISION //

West Union

WELL RECORD

Permit No. Tyler 259


Oil or Gas Well Gas
(KIND)

Company Ferrebee Oil & Gas Co.
Address Harrisville, W. Va.
Farm Alfred Ferrebee # 1 Acres 60
Location (waters) Mud Lick Run
Well No. 1 Elev. 1090
District Centerville County Tyler
The surface of tract is owned in fee by Alfred Ferrebee
Address Central Station
Mineral rights are owned by same
Address _____
Drilling commenced Dec. 1, 1956
Drilling completed Feb. 29, 1957
Date Shot none From _____ To _____
With _____
Open Flow 6 /10ths Water in 5 1/2 Inch
_____ /10ths Merc. in _____ Inch
Volume 657,000 Cu. Ft.
Rock Pressure 80 lbs. 24 hrs.
Oil show 1890 bbls., 1st 24 hrs.
Fresh water _____ feet 640 feet
Salt water _____ feet 1551 feet

Casing and Tubing	Used in Drilling	Left in Well	Packers
Size			
16	18		Kind of Packer
18			
10			Size of
8 1/4	981		
6 3/8	1544	1544	Depth set
5 3/16	1972	1972	
3			Perf. top
2			Perf. bottom
Liners Used			Perf. top
			Perf. bottom

CASING CEMENTED _____ SIZE _____ No. Ft. _____ Date _____
COAL WAS ENCOUNTERED AT _____ FEET _____ INCHES
_____ FEET _____ INCHES FEET _____ INCHES
_____ FEET _____ INCHES FEET _____ INCHES

Formation	Color	Hard or Soft	Top	Bottom	Oil, Gas or Water	Depth Found	Remarks
Clay			0	30			
Red Rock			30	50			
Slate			50	80			
White			80	100			
Slate	Blue		100	110			
Sand			110	136			
Slate			136	200			
Red Rock			200	220			
Sand			220	245			
Red Rock			245	255			
Slate			255	320			
Red Rock			320	385			
Lime Shell			385	395			
Red Rock			395	420			
Slate	White		420	425			
Red Rock			425	475			
Slate	White		475	495			
Red Rock			495	545			
Shell Lime			545	560			
Red Rock			560	595			
Little Dunkard			595	645			
Slate	White		645	655	water 640		
Lime Shells			655	670			
Slate	White		670	680			
Red Rock			680	720			
Slate			720	745			
Lime	Black		745	765			
Slate	White		765	860			
Big Red			860	935			
Lime			935	977			
Slate			977	990			
Lime Shell			990	995			
Shells			995	1015			
Slate	White		1015	1045			
Slate	Black		1045	1055			
Slate	White		1055	1075			
Red Rock			1075	1080			

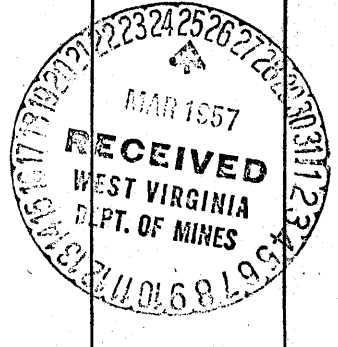

Formation	Color	Hard or Soft	Top //	Bottom	Oil, Gas or Water	Depth Found	Remarks
Slate	White		1080	1115			
Slate	Black		1115	1140			
Slate	White		1140	1200			
Slate	Black		1200	1245			
Sand			1245	1270			
Slate	White		1270	1280			
Lime Shells			1280	1300			
Slate	White		1300	1365			
Slate	Dark		1365	1390			
Lime Shells			1390	1410			
Sand			1410	1440			
Slate	Dark		1440	1450			
Sand			1450	1455			
Slate & Shells	White		1455	1475			
Sand 1st Salt			1475	1645			
Slate	Dark		1645	1685			Hole full water 1551
Slate	White		1685	1720			
Black Slate			1720	1770			
Lime Shells			1770	1774			
Sand 3rd. Salt			1774	1840			
Lime	Black		1840	1850			
Slate	Black		1850	1878			
Maxon Sand			1878	1932			Show Oil 1890
Little Lime			1932	1958			
Pencil Cave			1958	1964			
Dig Lime			1964	2037			
Injun Sand			2037	2060			Gas 2037 120/10 W. 2"
Total Depth			2064				657,000 Cu. Ft.

1964
1090
974

Date March 20, 19 57

APPROVED W. H. Mossor, Owner