


3.145
4.410

G. B. & C. Jones
90 acres.

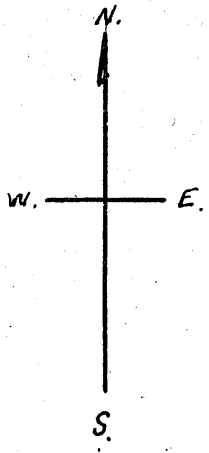

DRILL DEEPER
 New Location...
 Drill Deeper.....
 Abandonment.....

NOW: W. H. MOSSER - HARRISVILLE, W. VA.

Company Dinsmore Oil Co.
 Address St. Marys, W. Va.
 Farm G. B. & C. Jones
 Tract _____ Acres 90 Lease No. _____
 Well (Farm) No. 8 Serial No. _____
 Elevation (Spirit Level) 800'
 Quadrangle West Union
 County Tyler District Meade
 Engineer Jno Triplett
 Engineer's Registration No. _____
 File No. _____ Drawing No. _____
 Date June 29, 1947 Scale 1" = 30 P.

STATE OF WEST VIRGINIA
 DEPARTMENT OF MINES
 OIL AND GAS DIVISION
 CHARLESTON

WELL LOCATION MAP
 FILE NO. JYL-264-D

+ Denotes location of well on United States Topographic Maps, scale 1 to 62,500, latitude and longitude lines being represented by border lines as shown.

- Denotes one inch spaces on border line of original tracing.



STATE OF WEST VIRGINIA
DEPARTMENT OF MINES
OIL AND GAS DIVISION 9

Quadrangle West Union
Permit No. TYL-264-D

WELL RECORD

Oil or Gas Well oil
(KIND)

Company W. H. Mossor
Address Harrisville, W. Va.
Farm G. B. & C. Jones (Geo. Grove) Acres 5
Location (waters) McKim Creek
Well No. 8 Elev. 800'
District Meade County Tyler
The surface of tract is owned in fee by Geo. W. Grove
Address Hebron, W. Va.
Mineral rights are owned by same
Address _____
Drilling commenced June 12, 1957
Drilling completed July 24, 1957
Date Shot none From _____ To _____
With _____
Open Flow /10ths Water in none Inch
/10ths Merc. in _____ Inch
Volume _____ Cu. Ft.
Rock Pressure _____ lbs. _____ hrs.
Oil none now bbls., 1st 24 hrs.
WELL ACIDIZED no
WELL FRACTURED no

Casing and Tubing	Used in Drilling	Left in Well	Packers
Size			Kind of Packer
16			
13			
10			Size of
8 1/4		893	
6 5/8			Depth set
5 3/16			
3			Perf. top
2			Perf. bottom
Liners Used			Perf. top
			Perf. bottom

CASING CEMENTED _____ SIZE _____ No. Ft. _____ Date _____


COAL WAS ENCOUNTERED AT _____ FEET _____ INCHES
_____ FEET _____ INCHES _____ FEET _____ INCHES
_____ FEET _____ INCHES _____ FEET _____ INCHES

RESULT AFTER TREATMENT

ROCK PRESSURE AFTER TREATMENT

Fresh Water _____ Feet Salt Water _____ Feet

Formation	Color	Hard or Soft	Top	Bottom	Oil, Gas or Water	Depth	Remarks
✓ Sand, Cow Run			897	925	Oil 904 thru 925		
Sand			925	930			
Pink Rock			930	935			
Slate &			935	1023			
Sand			1023	1043			
Slate			1043	1100			
Lime			1100	1145			
Slate			1145	1150			
Sand			1150	1198			
Slate			1198	1200			
Sand			1200	1235			
Lime			1235	1245			
Slate			1245	1281			
Lime			1287	1317			
Slate			1317	1355			
Sand			1355	1385			
Slate	Black		1385	1391			
Lime	Black	Hard	1391	1414			
Sand			1414	1435			
Slate			1435	1485			
Slate	Black		1485	1556			
Sand			1556	1580			
Slate			1580	1585			
Lime			1585	1645			
Slate			1645	1665			
Slate		Soft	1665	1668			
Lime			1668	1680			
Slate			1680	1685			

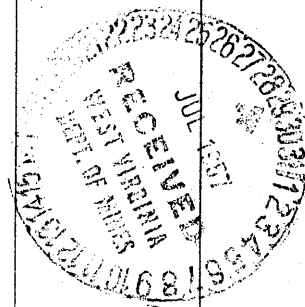

Formation	Color	Hard or Soft	Top <i>9</i>	Bottom	Oil, Gas or Water	Depth Found	Remarks
Slate&Shells Line			1685	1712			
			1712	1774			
Sand, Keener			1774	1777			
Sand, Engine			1777	1915	Gas	1844	Small Show
Sand, Squaw Line			1915	1940			
			1940	1947			
					1712 1774 1777		

Date _____, 19____

APPROVED _____, Owner

By _____
(Title)