


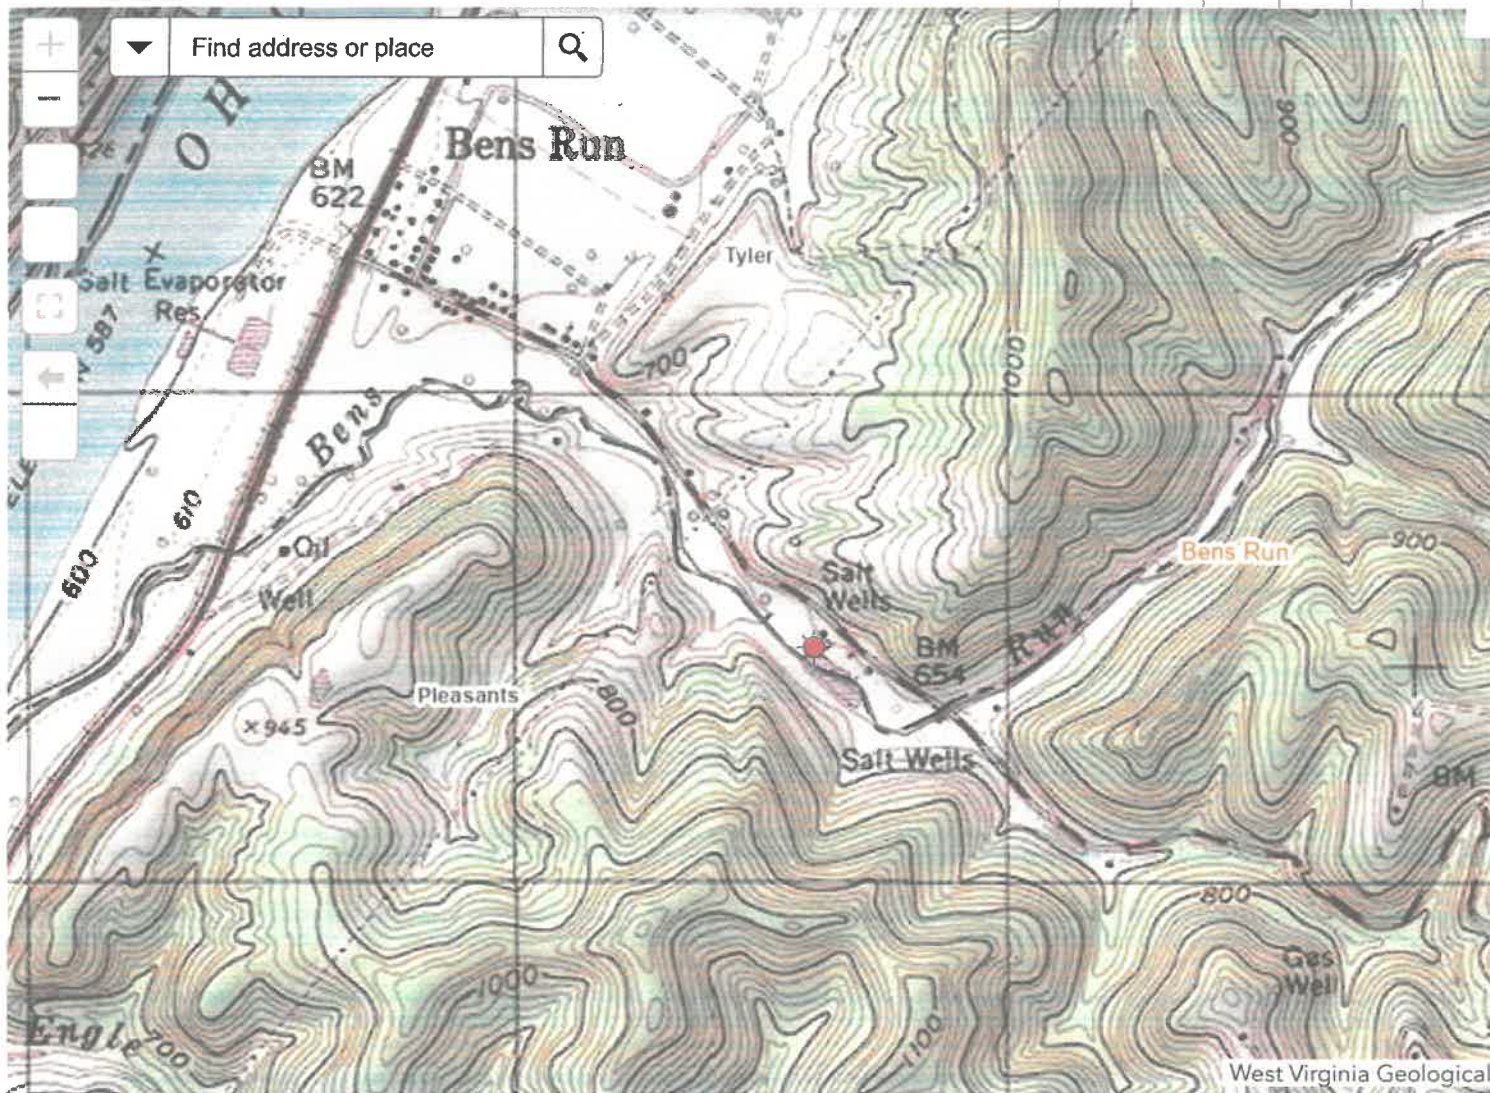

4709500266

RECEIVED
Office of Oil and Gas


AUG 12 2026

WV Department of
Environmental Protection


RECEIVED
Office of Oil and Gas

AUG 12 2026

WV Department of
Environmental Protection

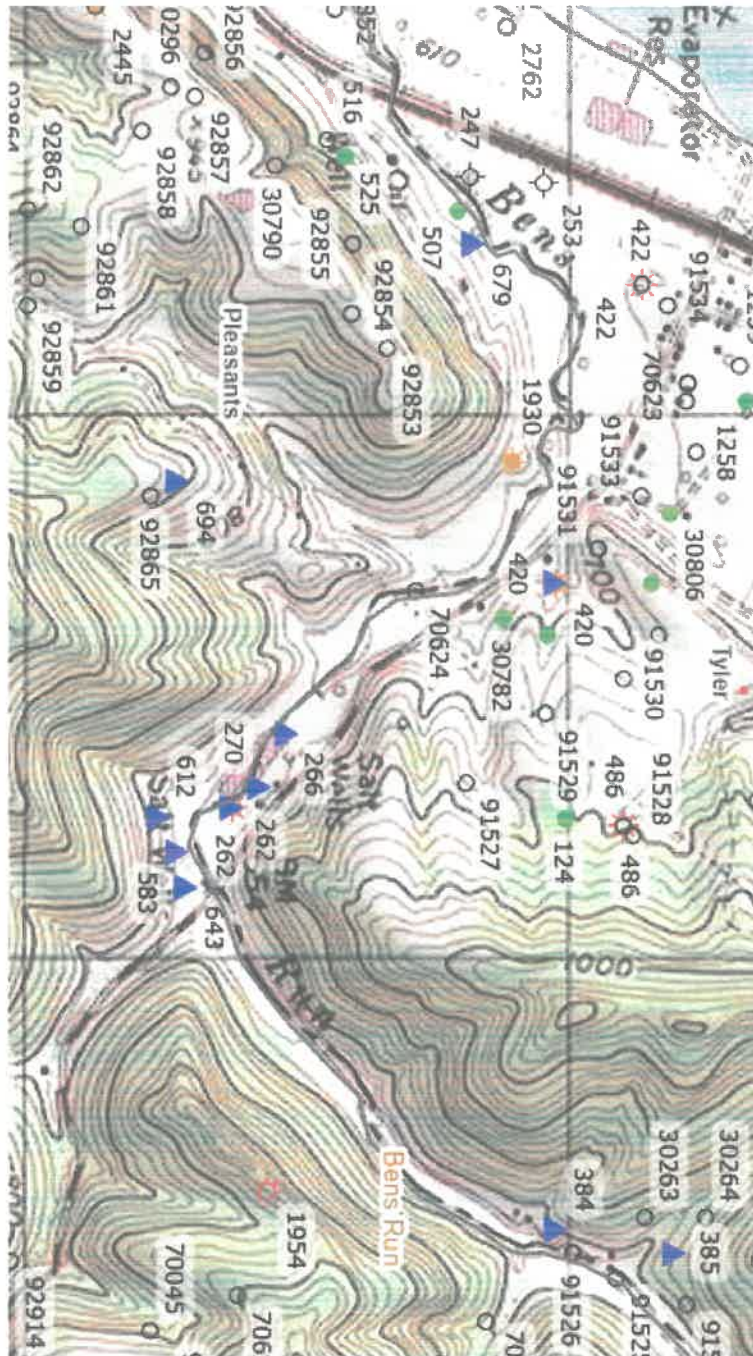

09/25/2026

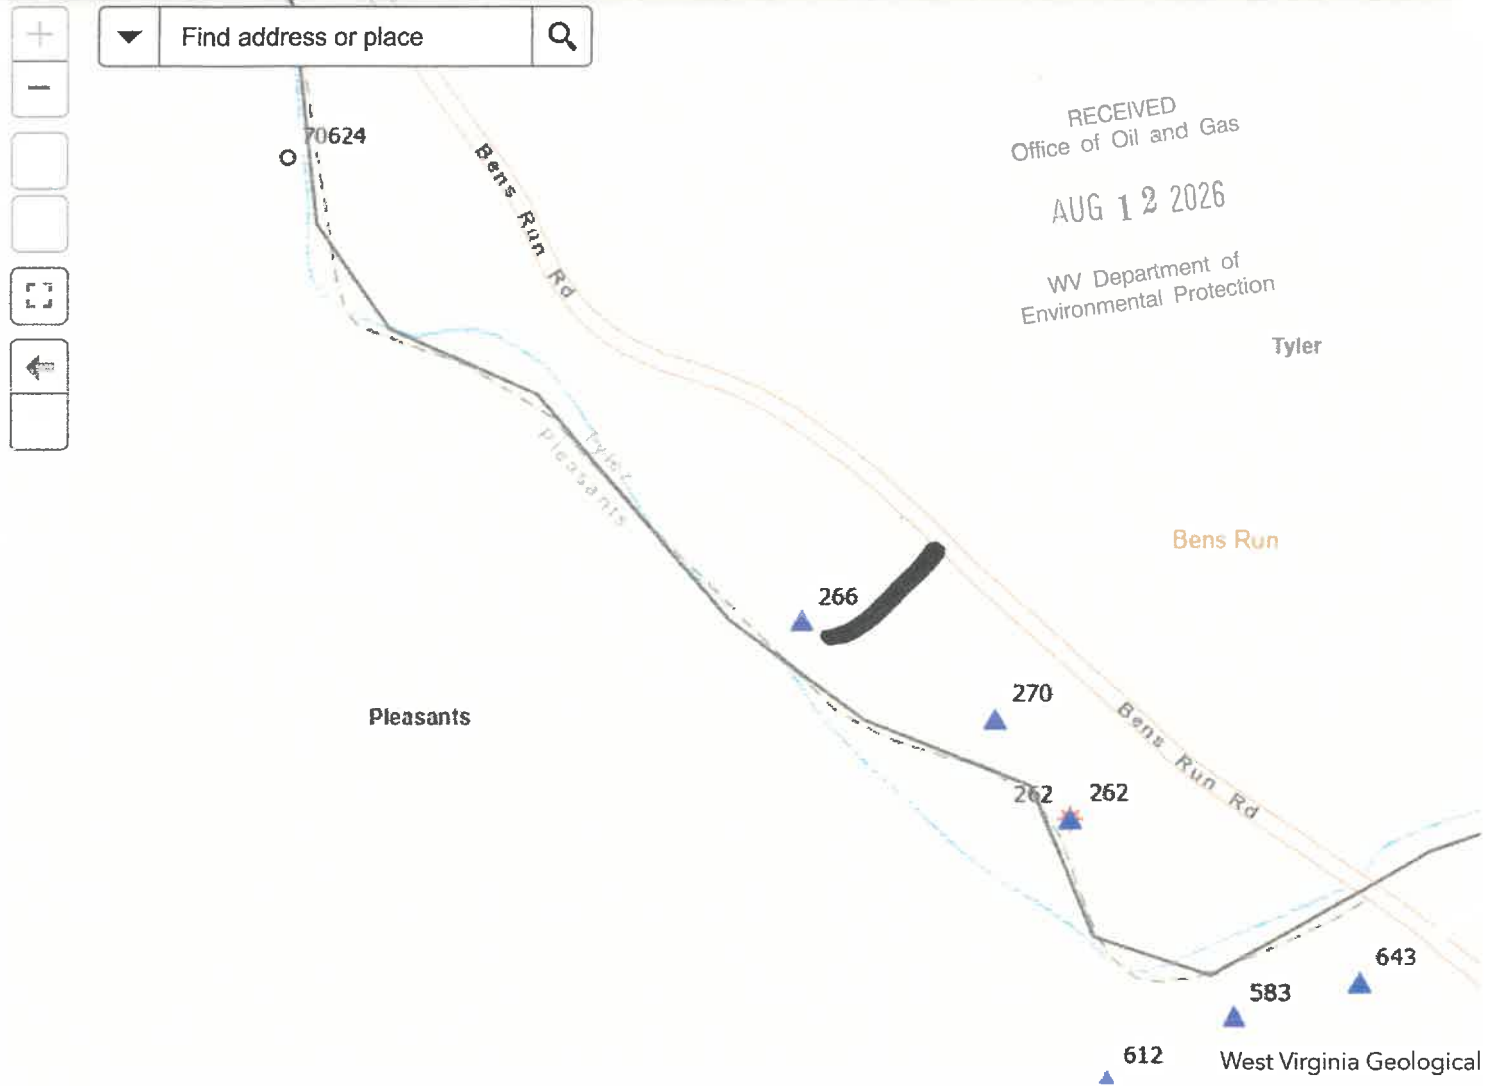

47-095-00266

AUG 12 2026

WV Department of
Environmental Protection

WW-7
8-30-06



West Virginia Department of Environmental Protection
Office of Oil and Gas

WELL LOCATION FORM: GPS

API: 4709500266 WELL NO.: Bens Run 2

FARM NAME: Bens Run

RESPONSIBLE PARTY NAME: Bens Run Land Company Limited Partnership

COUNTY: Tyler DISTRICT: Union

QUADRANGLE: Bens Run

SURFACE OWNER: Bens Run Land Company Limited Partnership

ROYALTY OWNER: Bens Run Land Company Limited Partnership

UTM GPS NORTHING: 4367495

UTM GPS EASTING: 491595.6 GPS ELEVATION: 640

The Responsible Party named above has chosen to submit GPS coordinates in lieu of preparing a new well location plat for a plugging permit or assigned API number on the above well. The Office of Oil and Gas will not accept GPS coordinates that do not meet the following requirements:

1. Datum: NAD 1983, Zone: 17 North, Coordinate Units: meters, Altitude: height above mean sea level (MSL) – meters.
2. Accuracy to Datum – 3.05 meters
3. Data Collection Method:

Survey grade GPS ____: Post Processed Differential ____

Real-Time Differential ____

Mapping Grade GPS ____: Post Processed Differential ____

Real-Time Differential X

4. Letter size copy of the topography map showing the well location.

I the undersigned, hereby certify this data is correct to the best of my knowledge and belief and shows all the information required by law and the regulations issued and prescribed by the Office of Oil and Gas.

[Signature]
Signature

Consultant
Title

7-16-26
Date

09/25/2026