


Latitude 39° 25'

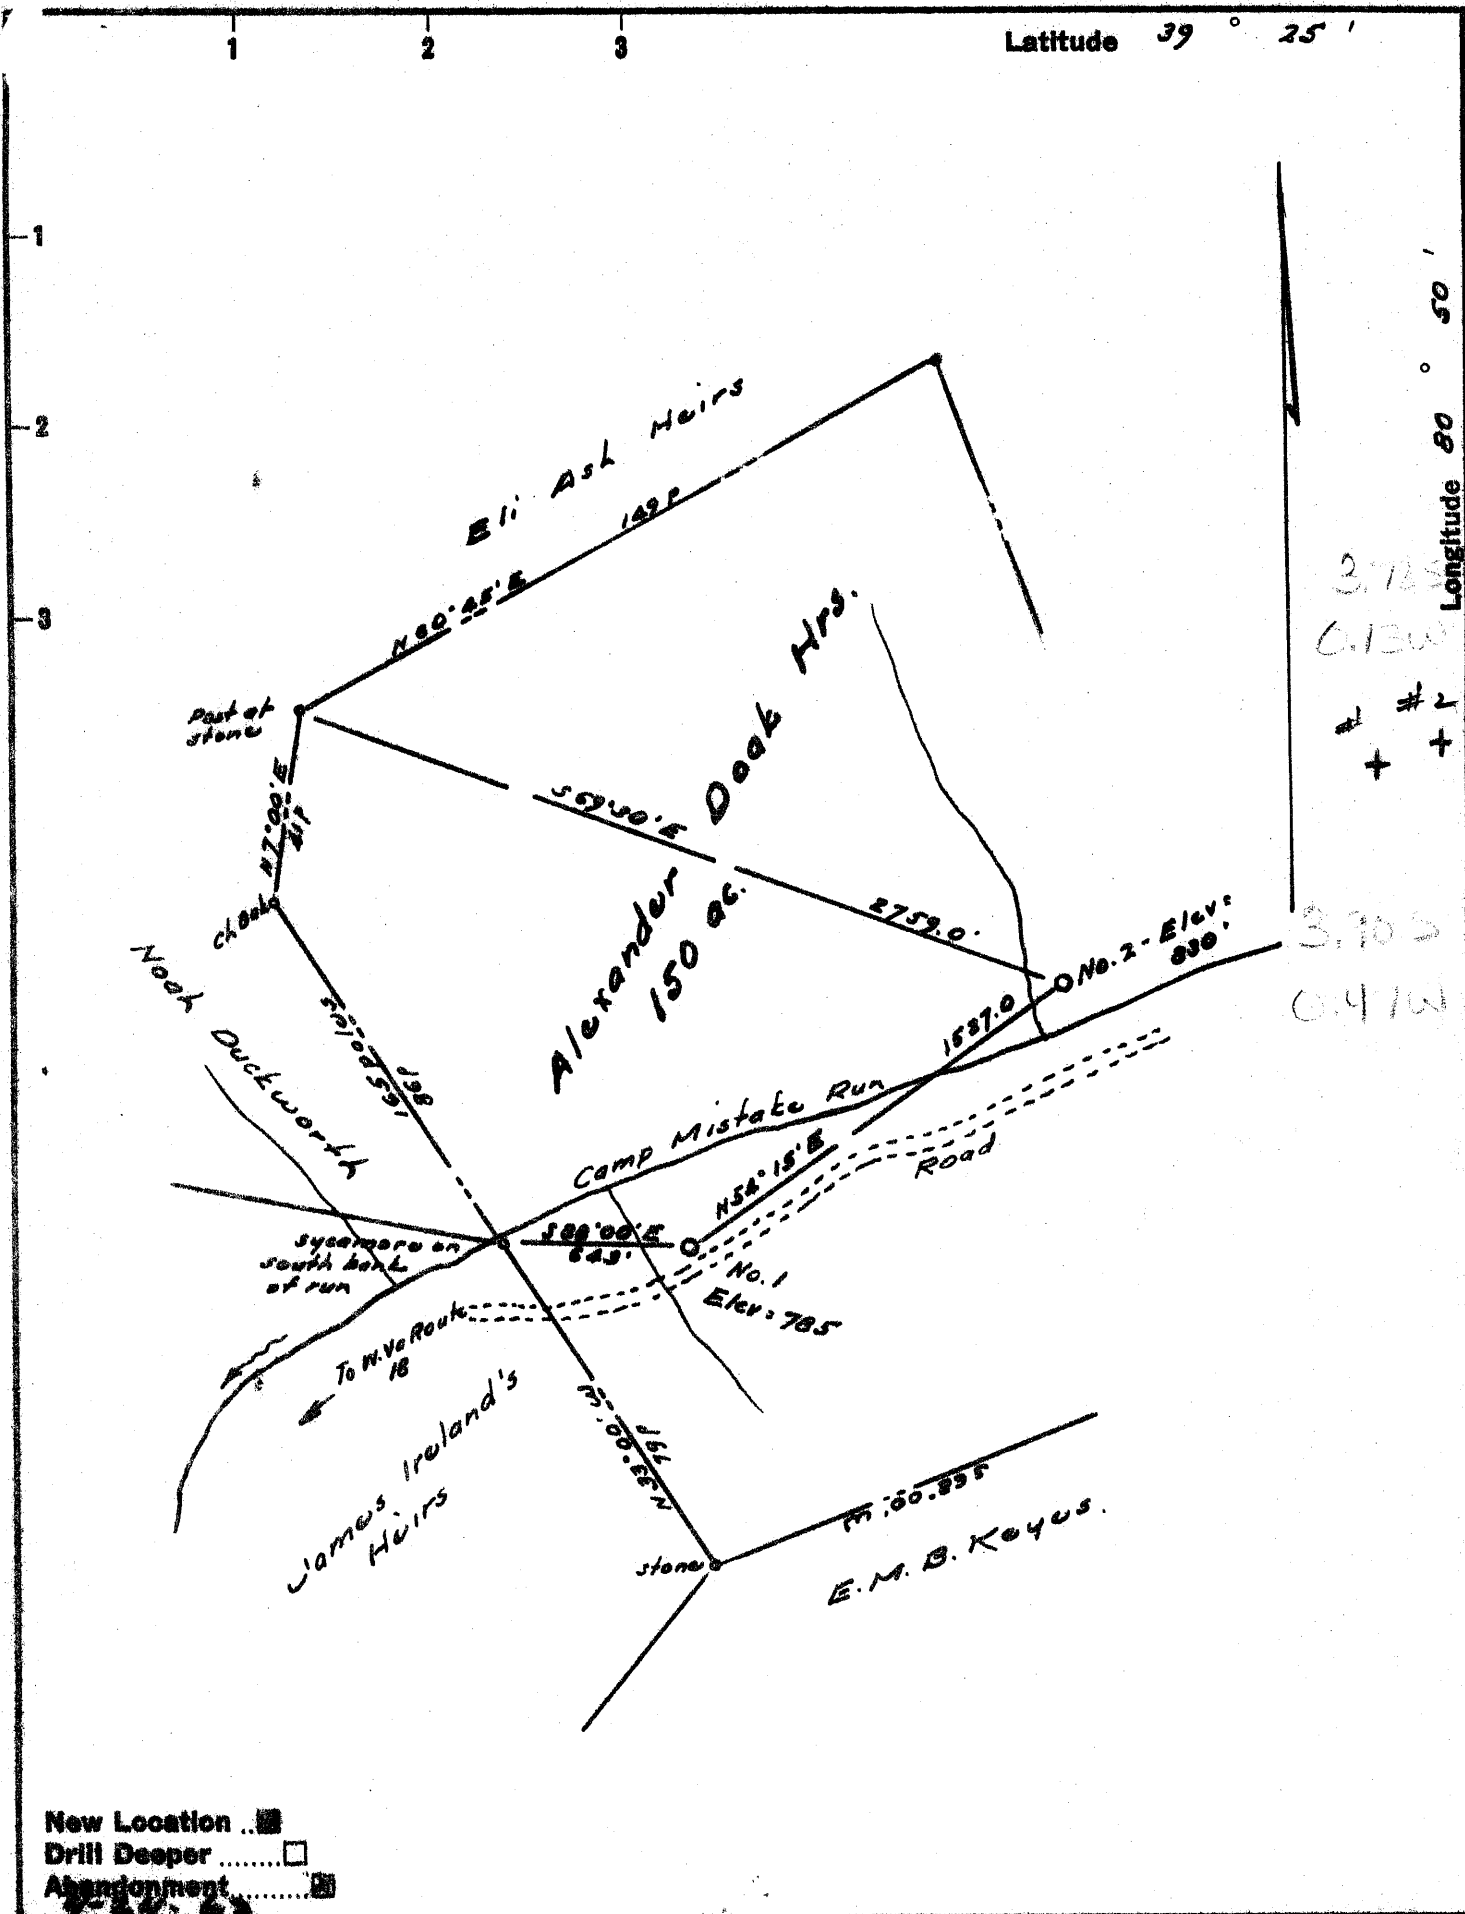

New Location
 Drill Deeper
 Abandonment

Company ERRELL L. PRIOR
 Address 700 Union Trust Bldg., Parkersburg, W. Va.
 Farm Alexander Deak Heirs
 Tract _____ Acres 150.0 Lease No. _____
 Well (Farm) No. One and Two Serial No. _____
 Elevation (Spirit Level) No. 1 = 785 No. 2 = 830'
 Quadrangle West Union
 County Tyler District Centerville
 Engineer [Signature]
 Engineer's Registration No. 1227
 File No. _____ Drawing No. _____
 Date Oct 23, 1960 Scale 1" = 660'

STATE OF WEST VIRGINIA
 DEPARTMENT OF MINES
 OIL AND GAS DIVISION
 CHARLESTON

WELL LOCATION MAP

FILE NO. TYL-300 #1-P 5/22/68
TYL-301 #2 never drilled

+ Denotes location of well on United States Topographic Maps, scale 1 to 62,500, latitude and longitude lines being represented by border lines as shown.

- Denotes one inch spaces on border line of original tracing.