

New Location   
 Drill Deeper   
 Abandonment

NOTE:  
 C.I. Wadsworth et ux owns the surface Rights.  
 John Baker Hrs. % Wanda Baker - Tyler City, W. Va. own the Oil & Gas Rights.

Company	INCO - 3
Address	90 C.F. MICHELS WEST UNION, W. VA.
Farm	C.I. WADSWORTH ET UX
Tract	Acres 76 1/2 Lease No.
Well (Farm) No.	2 Serial No.
Elevation (Spirit Level)	983'
Quadrangle	CENTERPOINT NW
County	TYLER District M <sup>c</sup> ELROY
Engineer	John W. Hamilton
Engineer's Registration No.	2274
File No.	Drawing No.
Date	JULY 9, 1961 Scale 1" = 30 POLES

STATE OF WEST VIRGINIA  
 DEPARTMENT OF MINES  
 OIL AND GAS DIVISION  
 CHARLESTON

WELL LOCATION MAP  
 FILE NO. TYL-320

+ Denotes location of well on United States Topographic Maps, scale 1 to 62,500, latitude and longitude lines being represented by border lines as shown.

- Denotes one inch spaces on border line of original tracing.



STATE OF WEST VIRGINIA  
DEPARTMENT OF MINES  
OIL AND GAS DIVISION 19

Quadrangle CENTERPOINT

Permit No. TYL-320

WELL RECORD

Oil or Gas Well OIL & GAS  
(KIND)


Company INCO 3 INC.  
Address P.O. BOX 215 WEST UNION, W. VA.  
Farm C.I. WADSWORTH Acres 76 1/2  
Location (waters) INDIAN CREEK  
Well No. 2 Elev. 983  
District McELROY County TYLER  
The surface of tract is owned in fee by C.I. WADSWORTH  
Address ALVY, W. VA.  
Mineral rights are owned by JOHN BAKER HEIRS  
WANDA BURNETTE Address ALVY, W. VA.  
Drilling commenced 7-29-61  
Drilling completed 9-23-61  
Date Shot From To  
With  
Open Flow /10ths Water in Inch  
/10ths Merc. in Inch  
Volume Cu. Ft.  
Rock Pressure lbs. hrs.  
Oil bbls., 1st 24 hrs.  
WELL ACIDIZED  
WELL FRACTURED 10-6-61 TO 11-7-61

Casing and Tubing	Used in Drilling	Left in Well	Packers
Size			
16	40'	40'	Kind of Packer
13			
10	328'		Size of
8 1/4	1323' 6"		
6 1/4			Depth set
5 3/16			
3			Perf. top
2			Perf. bottom
Liners Used			Perf. top
4 1/2		2984'	Perf. bottom

CASING CEMENTED 4 1/2 SIZE No. Ft. 2984 Date  
9-30-61 115 sks. cement, 4 sks. aquagel  
GARATON SERVICE  
COAL WAS ENCOUNTERED AT FEET INCHES  
FEET INCHES FEET INCHES  
FEET INCHES FEET INCHES  
36,000 GAL RIVERFRAC., 36,000 # SAND.

RESULT AFTER TREATMENT 5 BBL'S OIL SHOW OF GAS PRODUCTION SCREENED OFF BY DOWELL  
ROCK PRESSURE AFTER TREATMENT 240 # - 12 HRS.  
Fresh Water Feet Salt Water Feet

Formation	Color	Hard or Soft	Top	Bottom	Oil, Gas or Water	Depth	Remarks
VARIOUS COLORED MUD			0	75=	WATER	75	1/3 BALER PER HR.
SHALE		SANDY	75	220			
SAND			220	260			
ROCK	RED		260	320			
SHALE	BLUE		320	337			
SAND			337	350			
SHALE			350	398			
LIME			398	412			
SHALE 1/2	BLUE-RED		412	615			
COAL			615	618			
SHALE			618	630			
LIME			630	650			
ROCK	RED		650	695			
LIME			695	750			
SHALE-SHELLS			750	861			
LIME	BROWN		861	838			
SHALE			838	907			
SAND			907	944			
SHALE			944	1010			
LIME			1010	1028			
SHALE			1028	1100			
ROCK	RED		1100	1135			
LIME			1135	1173			
SHALE	RED-BLUE		1173	1254			
SHELL		HARD	1254	1264			
SAND		HARD	1264	1320			
SHALE			1320	1400			
LIME			1400	1473			

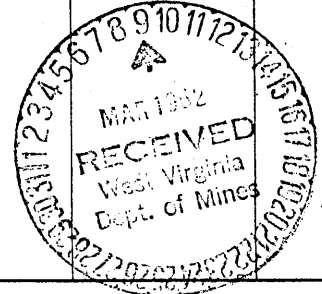

Formation	Color	Hard or Soft	Top 19	Bottom	Oil, Gas or Water	Depth Found	Remarks
SAND			1478	1512			
SHALE			1512	1528			
SAND			1528	1580			
SHALE			1580	1585			
SAND			1585	1615			
SHALE			1615	1697		2138	
SAND <i>1st Soft</i>			1697	1727		983	
SHALE			1727	1733		1155	
SAND <i>2nd Soft</i>			1733	1743			
SHALE-SHELLS			1743	1835			
SAND <i>3rd Soft</i>			1835	1894			
SHALE			1894	1945			
LIME SHELL			1945	1953			
SHALE-SHELLS			1953	1955			
ROCK	RED		1955	2100			
SHALE	BLUE		2100	2132			
LITTLE LIME			2132	2135			
PENCIL CAVE			2135	2135			
BTG LIME			2135	2226			
UNJUN SAND			2226	2288			
BRAKE SHALE			2288	2291			
UNJUN SAND			2291	2370		2295	GREEN
SLATE-LIME SHELLS			2370	2505	OIL SHOW BACK OIL	2324-2341	
SAND		HARD	2505	2539			
LIME			2539	2530			
SHALE-SHELLS			2530	2728			
LIME			2728	2740			
SHALE-SHELLS			2740	2806			
	PINK		2806	2816			
	BLUE-PINK		2816	2840			
SHALE	ALT.						
SHALE	BLUE		2840	2919			
GORDON <i>Sand</i>			2919	2935	OIL	2922-2924	
SHALEBREAK			2935	2936			
GORDON PROPER			2936	2940	GAS	2940	Plugged back to 3000"

*Contractor did not keep a log below the Gordon. Checked however have Schlumberger log this section. Total depth 3370*

Date 3-7, 1962  
 APPROVED James B. James, Owner  
 By (O. J. Nichols), Deputy  
 (Title)