

New Location
 Drill Deeper
 Abandonment issued 7/24/74

Stone Street Lands Company
 Company J. E. WEBBER & CLARENCE M. ROGERS
 Box 350, SPENCER
 Address 7th FRONT ST., CLARKSBURG, W. VA. 25726
 Farm CONAWAY RIGGS
 Tract 1 Acres 124 Lease No. _____
 Well (Farm) No. 1 Serial No. _____
 Elevation (Spirit Level) 745.73'
 Quadrangle WEST UNION WC
 County TYLER District CENTERVILLE
 Engineer Wm. W. Wilmeth
 Engineer's Registration No. 3935
 File No. _____ Drawing No. _____
 Date MARCH 29, 1962 Scale 1" = 40P

STATE OF WEST VIRGINIA
 DEPARTMENT OF MINES
 OIL AND GAS DIVISION
 CHARLESTON

WELL LOCATION MAP
 FILE NO. TYL-336-P


+ Denotes location of well on United States Topographic Maps, scale 1 to 62,500, latitude and longitude lines being represented by border lines as shown.

- Denotes one inch spaces on border line of original tracing.

Latitude $39^{\circ} 25'$

Longitude $80^{\circ} 55'$

0.14 S
0.62 W

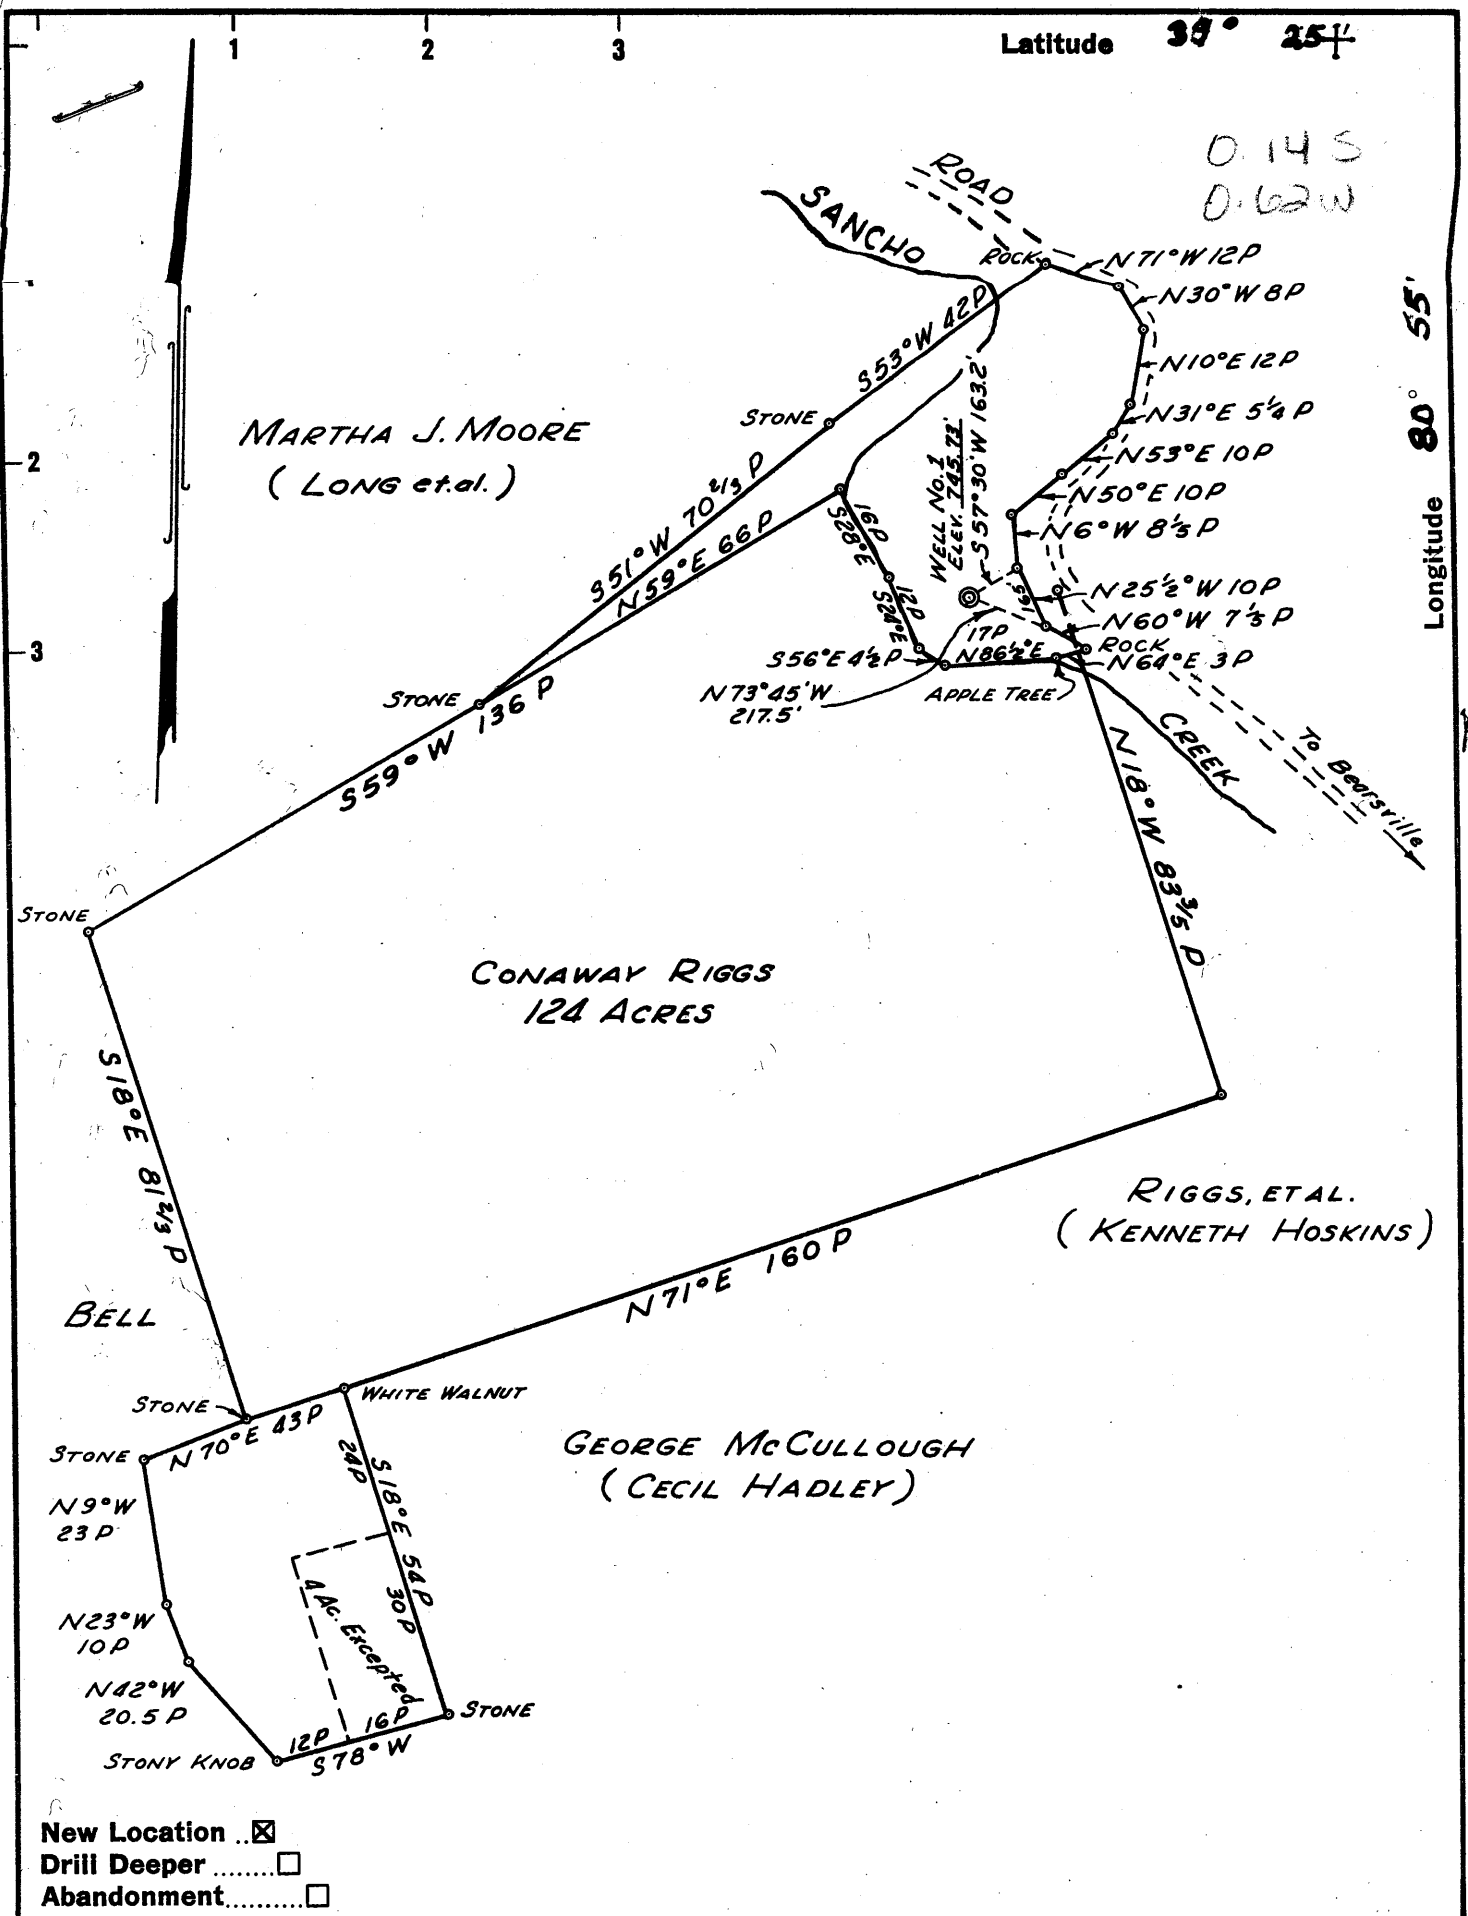

Company J.E. WEBBER % CLARENCE M. ROGERS
 Address 710 PRUNTY BLDG., CLARKSBURG, W. VA
 Farm CONAWAY RIGGS
 Tract 1 Acres 124 Lease No. _____
 Well (Farm) No. 1 Serial No. _____
 Elevation (Spirit Level) 745.73'
 Quadrangle WEST UNION WC
 County TYLER District CENTERVILLE
 Engineer Wm. D. Wilmoth
 Engineer's Registration No. 3935
 File No. _____ Drawing No. _____
 Date MARCH 29, 1962 Scale 1" = 40P

STATE OF WEST VIRGINIA
 DEPARTMENT OF MINES
 OIL AND GAS DIVISION
 CHARLESTON

WELL LOCATION MAP
 FILE NO. TYL-336

+ Denotes location of well on United States Topographic Maps, scale 1 to 62,500, latitude and longitude lines being represented by border lines as shown.

- Denotes one inch spaces on border line of original tracing.



STATE OF WEST VIRGINIA
DEPARTMENT OF MINES
OIL AND GAS DIVISION 25

Quadrangle West Union

WELL RECORD

Permit No. TYL-336

Oil or Gas Well Gas
(KIND)


Company <u>J. E. Webber</u>	Casing and Tubing	Used in Drilling	Left in Well	Packers
Address <u>710 Prunty Building, Clks. W. Va.</u>	Size			
Farm <u>Conaway Riggs</u> Acres <u>124</u>	16			Kind of Packer
Location (waters) <u>Sancho, Sancho Creek</u>	13	<u>48 ft</u>	<u>none</u>	
Well No. <u>1</u> Elev. <u>745 ft.</u>	10 <u>3/4</u>	<u>178</u>	<u>none</u>	Size of
District <u>Centerville</u> County <u>Tyler</u>	8 <u>1/4</u>	<u>937</u>	<u>none</u>	Depth set
The surface of tract is owned in fee by <u>Conaway Riggs</u>	6 <u>3/16</u>	<u>1703</u>	<u>1703</u>	
R.F.D. Address <u>Middlebourne, W. Va.</u>	3			Perf. top
Mineral rights are owned by <u>Conaway Riggs, et al.</u>	2			Perf. bottom
Address <u>Middlebourne, W. Va.</u>	Liners Used			Perf. top
Drilling commenced <u>March 27, 1962</u>				Perf. bottom
Drilling completed <u>April 29, 1962</u>				
Date Shot From To				
With				
Open Flow /10ths Water in Inch				
/10ths Merc. in Inch				
Volume <u>800,000</u> Cu. Ft.	CASING CEMENTED	SIZE	No. Ft.	Date
Rock Pressure <u>500</u> lbs. hrs.	did not cement			
Oil bbls., 1st 24 hrs.	COAL WAS ENCOUNTERED AT	FEET	INCHES	
WELL ACIDIZED	FEET	INCHES	FEET	INCHES
WELL FRACTURED <input checked="" type="checkbox"/> <u>not fractured</u>	FEET	INCHES	FEET	INCHES

RESULT AFTER TREATMENT natural 800,000
ROCK PRESSURE AFTER TREATMENT 400# 12 hrs.
Fresh Water 1 bailer per hr. Feet 340 Salt Water none Feet

Formation	Color	Hard or Soft	Top	Bottom	Oil, Gas or Water	Depth	Remarks
Black Soil			0	8			
Gravel			8	15			
Slate			15	25			
Red Rock			25	85			
Sand			85	96			
Slate			96	125			
Red Rock			125	175			
Slate			175	280			
Lime			280	315			
Red Rock			315	330			
Sand			330	350			
Slate			350	405			
Red Rock			405	410			
Slate			410	427			
Lime			427	445			
Slate			445	450			
Lime			450	475			
Slate			475	518			
Lime			518	590			
Slate & Shells			590	650			
Red Rock			650	655			
Slate			655	680			
Sand			680	697			
Slate			697	760			
Red Rock			760	778			
Lime			778	790			
Slate shells			790	827			
Pink Rock			827	848			
Slate shells			848	1060			

1665
745
920

water at 340

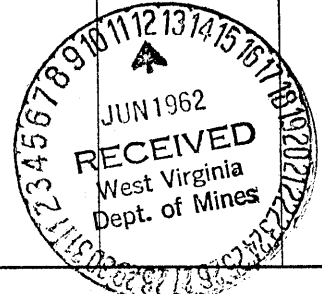

Formation	Color	Hard or Soft	Top 25	Bottom	Oil, Gas or Water	Depth Found	Remarks
Lime			1060	1070			
Sand			1070	1155			
Slate			1155	1173			
Sand			1173	1254			
Slate			1254	1270			
Sand			1270	1314			
Slate			1314	1342			
Sand			1342	1370			
Slate			1370	1412			
Sand			1412	1525			
Slate			1525	1553			
Lime			1553	1570			
Slate			1570	1625			
Lime, little			1625	1647			
Slate			1647	1665			
Lime, big			1665	1690			
Sand			1690	1700			
Lime			1700	1703			Top of Packer 1681
Sand			1703	1885			Bottom of Packer
Slate			1885	2085			
Sand			2085	2128			
Slate			2128	2130			
Lime			2130	2132			

Top of Packer 1681
Bottom of Packer

Pays: Gas 1691
Oil 1745
Show of gas 1807

Date 6-8, 1962

APPROVED [Signature], Owner

By [Signature]
(Title)