
Prot Logy Card CSDA Mflm M Latitude - 1 2 - 3 L. Davis CARL PERKINS 50 ac. M. Cottrill Source of Elevation B.M. 834' Bridge of Comp Mistoke Fracture....  $\Box$ Recondition X . I, the undersigned, hereby certify that this map is correct to the best of my knowledge and belief and shows all the information required by paragraph 6 of the rules and regula-New Location. Drill Deeper . . . . . . tions of the oil and gas section of the mining laws of West Virginia. Abandonment ..... & 1844 10/16/74 Minimum accuracy, one part in 200 Company EQUITABLE GAS CO. W.M. DIV STATE OF WEST VIRGINIA Address PITTSBURGH. PA. 15219 DEPARTMENT OF MINES Farm CARL OIL AND GAS DIVISION PERKINS **CHARLESTON** Acres 50 Lease No. 262/8 Well (Farm) No. 2 Serial No. 5492 WELL LOCATION MAPW Elevation (Spirit Level) 966.16' FILE NO. T41- 357-RED Quadrangle WEST UNION #22 EC County TYLER District McELROY + Denotes location of well on United States Topographic Maps, scale 1 to 62,500, latitude Engineer M. M. Mille and longitude lines being represented by Engineer's Registration No. 105 1.1.5. border lines as shown. File No. 222//48 Vate 8-27-73 - Denotes one inch spaces on border line of \_\_\_\_Drawing No.\_\_\_\_\_Scale / = 500' original tracing. 8-0 Plugged- not a storage well OCT 31 1974 William

OWWO


Form CARL PURKINS Well (Farm) No. 4 Elevation (Spirit Level) 966./6' Quadrangle WEST UNION 222 County TYLER Engineer & Manual Manual Engineer's Registration No. 105 2.2.5. File No. 222/148 Drawing No. Date 8-27-73 Scale\_

- + Denotes location of well on United States Topographic Maps, scale 1 to 62,500, latitude and longitude lines being represented by border lines as shown.
- Denotes one inch spaces on border line of original tracing. 47 095



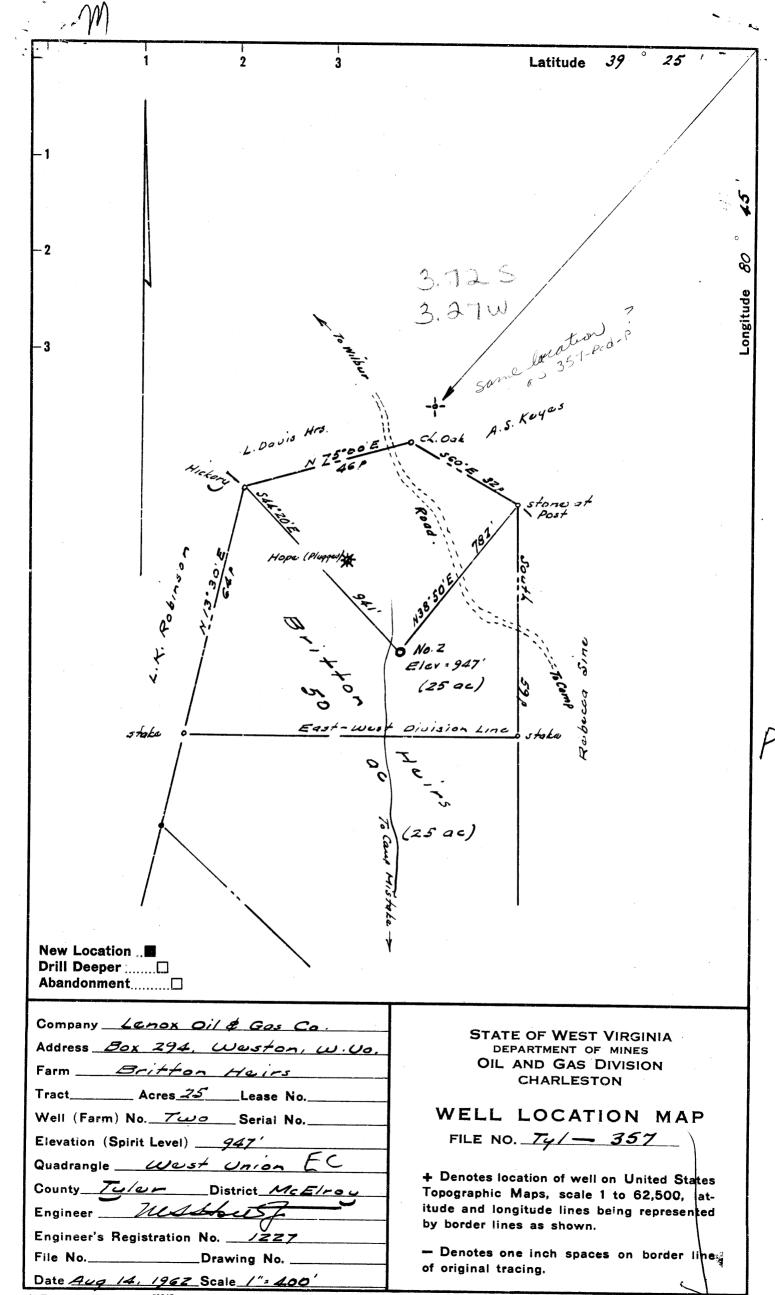

### STATE OF WEST VIRGINIA DEPARTMENT OF MINES

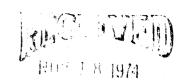

# Oil and Gas Division

Quadrangle West Union SE 2.1 Permit No. Ty1-357-Red	WELL	KECOKD		Rotary_XX Cable Recycling_ Water Floo Disposal	Gas Comb d Storage
Company Equitable Gas					(Kind)
Address Pittsburgh, PA 152	219	Casing and	Used in	Left	Cement fill up
	cres 50	Tubing	Drilling	in Well	Cu. ft. (Sks.)
Location (waters) Camp Mistake Ru	in			+	
Well No. 5492 E	966.16	Size	15.		·
District McElroy County Ty	-1	<b>20</b> -16	10		
The surface of tract is owned in fee by	TEL	Cond.	19	19	
Carl D. Perkins	· ·	<b>16</b> -10"	240	0	
		9 5/8	<del> </del>		
Address Rt. 3, Pennsboro, W.V.	20413	8 5/8	1014	0	
Mineral rights are owned by Same as su		7			
Address		5 1/2			
Re Drilling Commenced 10-10-74		4 1/2	2014	99	
Re Drilling Completed 10-23-74		3			
Initial open flowcu. ft	bbls.	2			
Final productioncu. ft. per day _	bbls	Liners Used	1		
Well openhrs. before test_	₽p			1	
Coal was encountered atFee	et	Salt V	Inche		Feet
Producing Sand		Planel			
Formation Color Hard or Soft	Top Feet	Bottom Feet	Oil, Gas or	Water *	Remarks
Gamma Log from 1300 to 2009					
Salt Sand Maxton Sand Little Lime Big Lime Big Injun Sand	1321 1649 1770 1803 1870	1600 1689 1797 1866 2006			
Total Depth		2014			
Plugged 10-23-74					
		.]			
		1			

(over)

<sup>\*</sup> Indicates Electric Log tops in the remarks section.



#### STATE OF WEST VIRGINIA DEPARTMENT OF MINES OIL AND GAS DIVISION $\phi$

Quadrangle W	<u>est Unio</u>	<u>1</u>					
Permit No. TY	L-357		WELL	RECORD		Oil or	Gas Well oil and gas
Address Box		nd Gas Comp ston, W. Va. n		Casing and Tubing	Used in Drilling	Left in Well	Packers
Location (waters Well No. 2	) Camp	Mistake  _CountyTyle	Elev. 947'	16	19	19	Kind of Packer none
		n fee by W. A.			240	00	Size of
	re owned by	Address West   W. A. Britto   Address West	n	65%	1014	0	Depth set
	ced Augus	t 22, 1962		3 4-1/2	0	2010	Perf. top 1916
-		<u>nber 22, 196</u>		M	00	2010	Perf. bottom 1918
With		mTo	77		0		Perf. top 1973 Perf. bottom 1975
Volume Rock Pressure Oil	240 show <sub>D</sub> no	in	M_Cu. Ft. hrs. _bbls., 1st 24 hrs.	October 10 aqua COAL WAS E	1, 1962 4 Igel-Hall NCOUNTERE	O sks. H iburton D AT none CHES	/2No. Ft. 2010 Date .E. cement .FEET INCHES .FEET INCHES .FEET INCHES
RESULT AFTER ROCK PRESSUR Fresh Water	RE AFTER TI	TOPEN FLOW  REATMENT 46  Feet	00 lbs.	Salt Water_	none	Fe	et
Formation	Color	Hard or Soft	Тор	Bottom	Oil, Gas or Water	Depth	Remarks
Clay Sand Rock	Red		0 18 25	18 25 48			
Slate Rock	Red		48 58	58 70			
20020	itteu		56	70		1.	

RESULT AFTER TREATMENT Open flow 370 MCF -6/2?  ROCK PRESSURE AFTER TREATMENT 460 lbs.							
Fresh Water	none	Feet	^	Salt Water_	none	Feet	
Formation	Color	Hard or Soft	Тор	Bottom	Oil, Gas or Water	Depth	Remarks
Clay			0	18			
Sand			18	25			
Rock	Red		25	48		**	
Slate			48	58			
Rock	Red		58	70			
Slate-shale			70	149			
Rock	Red		149	186			
Slate-shale			186	195			
Rock	Red		195	200			
Shale			200	210			
Sand			210	262	13141576		
Lime shale			262	287	10,130		
Slate-shale			287	335	g) (363 2		
Slate	Blue		335	342	BUM LIVE	[ 집	
Lime-shale			342	346	SEC THEIR	2 P	
Lime	Blue		346	359	FIEL WINN		
Rock	Red		359	368	Dobr.		
Lime-shale			368	415	12829303	A STATE OF THE STA	
Rock	Red		415	431			
Lime-shale			431	442			
Sand, rock			442	465			
Slate-shale			465	503			
Sand			503	508			
Slate			508	560			
Lime, shale			560	568			
Lime	Black		568	579			

Formation	Color	Hard or Soft	Top 6	Bottom	Oil, Gas or Water	Depth Found	Remarks
Lime	Brown		579	600			
late, shale			600	608			
Lime, shale			608	616			
and, lime			616	627			
late	Blue		627	641			
Sand			641	649	İ	į	
hale	1		649	674			
Broken lime			674	689	1		
Shale			689	709			
Rock	Red		709	1			
Slate	Blue		i c	720			
Rock	1		720	728			
	Red		728	751			
Shale			751	756		. 1	
Rock			756	764			ľ
Shale			764	790			
Rock	Red		790	829			
Shale			829	844			
Slate	Blue		844	867			
Lime	Black		867	893			
Rock	Red		893	920			
Slate			920	966			
Sand, lime			966	970			
Rock	Red		970	991			
Slate, shale	1100		991	1012			
Sand			1012	1			
Slate	121		1	1016			*
	Blue		1016	1034			
Shale			1034	1051			
Sand, lime			1051	1064			1
Slate	Blue		1064	1089			
Sand			1089	1110			
Slate, shale	1		1110	1148			
Lime, sand			1148	1192			
Lime, sand	I		1192	1210			ļ
Slate, shale	į		1210	1260	r		
Lime	ļ		1260	1272			
Slate	Black		1272	1293	•		
Shale	Black		1293	1314			
Sand	Black		1314	1435	•		
Lime	Black						
	Diack		1435	1452			
Lime, sand			1452	1490			
Slate, shale			1490	1523			
Sand			1523	1552	1		1
and, lime			1552	1632			
$Sand oxedows_{q} \circ \circ \circ \circ$	yaa siistoo T	1 .	1632	1673			
hale			1673	1682			
Lime, sand	1		1682	1749		<b>!</b>	
Lime	light	•	1749	1776			
late	- 1		1776	1783			
Lime	Blue		1783	1882			
Sand SI			1	1996	Oil	1898-1906	Show INIL
See Mari	. [		1882	1 -7/0	Gas	1906-1917	Show INIL
					1	II .	•
	ł		1		Gas & Oil	1950-1962	Show
					Gas	1962-1970	Show
Slate			1004	2010	Gas & Oil	1980-1996	Show
rate	4		1996	2010			Total depth
	ĺ						
	i	•	1	4	ł	1	I .

	Date	, 19
APPROVED		, Owner
Ву	(Title)	





JUN 14 1974

OIL & GAS DIVISION
DEFT. OF MINES

### Oil and Gas Division

## OIL AND GAS WELL PERMIT APPLICATION

Charleston, W. Va.	DATE June 12,	1974
Surface Owner PERKINS, Carl D.		e Gas Company
Address Rt. 3, Pennsboro, West Virginia		
Mineral Owner Same as above		Acres 50
Address		
Sama ag ahorro		Elevation 966.16
Address		
Coal Operator		
Address		
S PERMIT MUST BE POSTED AT THE WELL SITE	· ·	
provisions being in accordance with Chapter 22, the W. Va. Code, the location is hereby approved		
redrilling This permit shall expire if rations have not commenced by 10-17-74		
Total Thous	INSPECTOR TO BE M	OTIFIED Paul Goodni ght
uty Director - Oil & Gas Division	Smithville,W.Va.	PH: 477-2455
and the All Control of the Control o		
GENTLEMEN:  The undersigned well operator is entitled to drill upon title thereto, (or as the case may be) under grant or leas made to Equitable Gas Compa	the above named farm or tract	of land for oil and gas, having f
The undersigned well operator is entitled to drill upon title thereto, (or as the case may be) under grant or leas made to Equitable Gas Compa	the above named farm or tract the dated August 2, any and recorded on the	of land for oil and gas, having f
The undersigned well operator is entitled to drill upon title thereto, (or as the case may be) under grant or leas made to Equitable Gas Compa 19.73, in Tyler County, Book 198	the above named farm or tract se dated <u>August 2,</u> any and recorded on the Page 396	of land for oil and gas, having f 1973 by <u>Carl D. Per</u> e <u>23rd</u> day of August
The undersigned well operator is entitled to drill upon title thereto, (or as the case may be) under grant or leas	the above named farm or tract se dated August 2, any and recorded on the Page 396 XX REDRILL	of land for oil and gas, having f  19 73 by <u>Carl D. Per</u> e <u>23rd</u> day of August
The undersigned well operator is entitled to drill upon title thereto, (or as the case may be) under grant or leas made to Equitable Gas Compa 1973, inTyler County, Book 198 NEW WELL DRILL DEEPER OIL AND GAS WELL ORIGINALLY DRILI The enclosed plat was prepared by a registered engineer	the above named farm or tract the dated August 2, any and recorded on the Page 396 XX REDRILL LED BEFORE JUNE 5, 1969.	of land for oil and gas, having f  19 73 by Carl D. Per e 23rd day of August  FRACTURE OR STIMULATE
The undersigned well operator is entitled to drill upon title thereto, (or as the case may be) under grant or leas made to Equitable Gas Compa 19.73, inTyler County, Book 198 NEW WELL DRILL DEEPER OIL AND GAS WELL ORIGINALLY DRILI The enclosed plat was prepared by a registered enginee have been notified as of the above date.  The above named coal owners and/or operator are herely	the above named farm or tract  the dated August 2,  any and recorded on the  Page 396  XX	of land for oil and gas, having f  19 73 by Carl D. Per e 23rd day of August  FRACTURE OR STIMULATE d all coal owners and/or operator
The undersigned well operator is entitled to drill upon title thereto, (or as the case may be) under grant or leas made to Equitable Gas Compa 19.73, in County, Book 198 NEW WELL DRILL DEEPER OIL AND GAS WELL ORIGINALLY DRILI The enclosed plat was prepared by a registered enginee have been notified as of the above date.  The above named coal owners and/or operator are herel to make by Section 3 of the Code, must be received by, or Copies of this notice and the enclosed plat were mailed or coal owners at their above shown respective address	the above named farm or tract se dated August 2, any and recorded on the Page 396 XX REDRILL LED BEFORE JUNE 5, 1969. See or licensed land surveyor and the profiled with the Department of the by registered mail, or delivered day day	of land for oil and gas, having f  19 73 by Carl D. Per e 23rd day of August  FRACTURE OR STIMULATE d all coal owners and/or operator they wish to make, or are require Mines within ten (10) days. *  to the above named coal operator before, or on th
The undersigned well operator is entitled to drill upon title thereto, (or as the case may be) under grant or leas made to Equitable Gas Compa 19.73, inTyler County, Book 198 NEW WELL DRILL DEEPER OIL AND GAS WELL ORIGINALLY DRILL The enclosed plat was prepared by a registered enginee have been notified as of the above date.  The above named coal owners and/or operator are herel to make by Section 3 of the Code, must be received by, or Copies of this notice and the enclosed plat were mailed or coal owners at their above shown respective address	the above named farm or tract se dated August 2, any and recorded on the Page 396 XX REDRILL LED BEFORE JUNE 5, 1969. See or licensed land surveyor and the profiled with the Department of the by registered mail, or delivered day day	of land for oil and gas, having f  19 73 by Carl D. Per e 23rd day of August  FRACTURE OR STIMULATE d all coal owners and/or operator they wish to make, or are require Mines within ten (10) days. *  to the above named coal operator before, or on th
The undersigned well operator is entitled to drill upon title thereto, (or as the case may be) under grant or leas made to Equitable Gas Compared E	the above named farm or tract se dated August 2, any and recorded on the Page 396 XX REDRILL LED BEFORE JUNE 5, 1969. For or licensed land surveyor and by notified that any objection to filed with the Department of by registered mail, or delivered day Department of Mines at Charles Very truly yours,	of land for oil and gas, having f  19 73 by Carl D. Per e 23rd day of August  FRACTURE OR STIMULATE d all coal owners and/or operator they wish to make, or are require Mines within ten (10) days. *  to the above named coal operator before, or on th
The undersigned well operator is entitled to drill upon title thereto, (or as the case may be) under grant or leas	the above named farm or tract to dated August 2, any and recorded on the Page 396 XX REDRILL LED BEFORE JUNE 5, 1969.  The provided that any objection to refiled with the Department of by registered mail, or delivered day Department of Mines at Charles Very truly yours, (Sign Name) Very EQUITABLE	of land for oil and gas, having for the story wish to make, or are required Mines within ten (10) days. *  to the above named coal operators before, or on the story, West Virginia.
The undersigned well operator is entitled to drill upon title thereto, (or as the case may be) under grant or leas made to Equitable Gas Compand 1973, in Tyler County, Book 198 NEW WELL DRILL DEEPER OIL AND GAS WELL ORIGINALLY DRILL The enclosed plat was prepared by a registered engineer have been notified as of the above date.  The above named coal owners and/or operator are herely to make by Section 3 of the Code, must be received by, or Copies of this notice and the enclosed plat were mailed for coal owners at their above shown respective address—same day with the mailing or delivery of this copy to the THYSICAL LOGS DIRECTLY TO	the above named farm or tract to dated August 2, any and recorded on the Page 396 XX REDRILL LED BEFORE JUNE 5, 1969.  The proof of licensed land surveyor and the proof of	of land for oil and gas, having for the story wish to make, or are required Mines within ten (10) days. *  to the above named coal operators before, or on the story, West Virginia.
The undersigned well operator is entitled to drill upon title thereto, (or as the case may be) under grant or leas made to Equitable Gas Compared Equitable Gas Compared to Equitable Gas Compared Equitable Gas Compared to Equitable Gas Compared E	the above named farm or tract  the dated August 2,  any and recorded on the  Page 396  XX REDRILL  LED BEFORE JUNE 5, 1969.  The provided that any objection to be pregistered mail, or delivered day  Department of Mines at Charles  Very truly yours,  (Sign Name)  EQUITABLE  420 Boulevalures  Output  We EQUITABLE  420 Boulevalures  Great August 2,  We EQUITABLE  420 Boulevalures  Great August 2,  We EQUITABLE  420 Boulevalures  Output  Research  August 2,  Research  August 2,  Research  August 2,  Research  Research  August 2,  Re	of land for oil and gas, having for the land for oil and gas, having for the land gas, having for land
The undersigned well operator is entitled to drill upon title thereto, (or as the case may be) under grant or leas made to Equitable Gas Compared to Equitable Gas Compared to Equitable Gas Compared 19.73, in County, Book 198 NEW WELL DRILL DEEPER OIL AND GAS WELL ORIGINALLY DRILL The enclosed plat was prepared by a registered engineer have been notified as of the above date.  The above named coal owners and/or operator are herel to make by Section 3 of the Code, must be received by, or Copies of this notice and the enclosed plat were mailed or coal owners at their above shown respective address same day with the mailing or delivery of this copy to the COPIES OF ALL OF DIRECTLY TO:  Add O. BOK 379  Eantown if the compared to Equipment of the control of the compared to the control of the compared to the comp	the above named farm or tract  the dated August 2,  any and recorded on the  Page 396  XX	of land for oil and gas, having f  19 73 by Carl D. Per  e 23rd day of August  FRACTURE OR STIMULATE  d all coal owners and/or operator  they wish to make, or are require Mines within ten (10) days. *  to the above named coal operator  before, or on the ston, West Virginia.  Operator  GAS COMPANY  ard of the Allies
The undersigned well operator is entitled to drill upon title thereto, (or as the case may be) under grant or leas made to Equitable Gas Compated to Equitable Gas Compated Eq	the above named farm or tract  the dated August 2,  any and recorded on the  Page 396  XX	of land for oil and gas, having f  19 73 by Carl D. Per  e 23rd day of August  FRACTURE OR STIMULATE  d all coal owners and/or operator  they wish to make, or are require Mines within ten (10) days. *  to the above named coal operator  before, or on the ston, West Virginia.  Il Operator  GAS COMPANY  ard of the Allies  Street

\*SECTION 3 . . . . If no objections are filed or found by the Department of mines, within said period of ten days from the receipt of notice and plat by the department of mines, to said proposed location, the department shall forthwith issue to the well operator a permit reciting the filing of such plat, that no objections have been made by the coal operators or found thereto by the department and that the same is approved and the well operator authorized to proceed.



TYL-357-RED.

PERMIT NUMBER

## THIS IS AN ESTIMATE ONLY ACTUAL INFORMATION WILL BE SUBMITTED ON OG-10 UPON COMPLETION

PROPOSED WORK ORDER TO	RE_DRILL	DEEPEN	FRACTURE-STIMULATE		
DRILLING CONTRACTOR: (If	Known)	RESPONSIBLE AGENT:			
NAME		NAME H. E. Ga	rdner, Div., Supt.		
ADDRESS		ADDRESS Box 15	50, Clarksburg, W. Va. 2630		
TELEPHONE		TELEPHONE (30	4) 624-6576		
ESTIMATED DEPTH OF COMPI	LETED WELL: 1920	ROTARY XX	CABLE TOOLS		
PROPOSED GEOLOGICAL FOR	MATION: Big Injun				
TYPE OF WELL: OIL_	GAS (	COMB. STOR	AGE XX DISPOSAL		
			FLOODOTHER		
TENTATIVE CASING PROGRAM  CASING AND TUBING SIZE	USED FOR DRILLING	LEFT IN WELL	CEMENT FILL UP OR SACKS - CUBIC FT.		
20 - 16					
13 - 10					
9 - 5/8					
8 - 5/8	1014	1014	Cem. to surface		
7					
5 ½	1880	1880	Cem. to 800'		
4 ½					
2			Perf. Top Perf. Bottom		
Liners			D. C. C.		
			Perf. Bottom		
WELLS DRILLED PRIOR MUST ALSO BE SUBMITT.  TO FRACTURE - STIMULATE: OIL AND/OR GAS WELL OBOND, PERMANENT PLATOIL AND/OR GAS WELL OIL AND/OR GAS WELL OIL AND/OR GAS WELL OING ORIGINAL PERMIT NU	OF OG - 1, SHOWING ORIGITO 1929, A PERMANENT OED.  PRIGINALLY DRILLED BEFORMAND ORIGINAL WELL REPRIGINALLY DRILLED ON AUTHORICAN AND PERFORMANCE	OPY OF THE PLAT A.D. ORE JUNE 5, 1929, FIVE CORD. AND/OR AFTER JUNE 5, E BOND.	R AND PERFORMANCE BOND. ON ND THE ORIGINAL WELL RECORD  (5) COPIES OG - 1, PERFORMANCE  , 1929, FIVE COPIES OG - 1, SHOW- ease. Inspector to be notified twenty-		
thereof.  WAIVER: I the undersigned, Age this lease have examine We the	ent for on our mine n	Coal Company, Onaps this proposed well have no objections to sa	be issued within ten days of receipt wher or Operator of the coal under location.  and well being drilled at this location, and 7, Chapter 22 of the West Virginia		
		<del></del>	For Coal Company		
•			Official Title		