

MINIMUM ERROR OF CLOSURE 1/500 ±

SOURCE OF ELEVATION Well No 1 this farm (Donzel Ankrom)  
Elev. 916.

New Location  X  
 Drill Deeper   
 Abandonment

"I, THE UNDERSIGNED, HEREBY CERTIFY THAT THIS MAP IS CORRECT TO THE BEST OF MY KNOWLEDGE AND BELIEF AND SHOWS ALL THE INFORMATION REQUIRED BY PARAGRAPH 6 OF THE RULES AND REGULATIONS OF THE OIL AND GAS SECTION OF THE MINING LAWS OF WEST VIRGINIA."

Company James Proctor  
 Address 1233 Cloverfield Ave, Dayton, Ohio  
 Farm Donzel Ankrom  
 Tract 1 Acres 86 Lease No. \_\_\_\_\_  
 Well Farm No. 2 Serial No. \_\_\_\_\_  
 Elevation (Spirit Level) 897  
 Quadrangle West Union WC  
 County Tyler District Meade  
 Engineer Parker E. Pitzer  
 Engineer's Registration No. 485  
 File No. \_\_\_\_\_ Drawing No. \_\_\_\_\_  
 Date June 18, 1963 Scale 1" = 40 P

STATE OF WEST VIRGINIA  
 DEPARTMENT OF MINES  
 OIL AND GAS DIVISION  
 CHARLESTON

WELL LOCATION MAP  
 FILE NO. TYL-379

+ Denotes location of well on United States Topographic Maps, scale 1 to 62,500, latitude and longitude lines being represented by border lines as shown.

- Denotes one inch spaces on border line of original tracing.



STATE OF WEST VIRGINIA  
DEPARTMENT OF MINES  
OIL AND GAS DIVISION 19

Rotary   
Spudder   
Cable Tools   
Storage

Quadrangle West Union

Permit No. TYL-379

WELL RECORD

Oil or Gas Well Dry Hole  
(KIND)

Company Carter Development Co., Inc.  
Address 1233 Cloverfield Ave.  
Farm Donzel Ankrom Acres 81  
Location (waters) \_\_\_\_\_  
Well No. 2 Elev. 897  
District Meade County Tyler  
The surface of tract is owned in fee by Donzel Ankrom  
Address Parkersburg, W.Va.  
Mineral rights are owned by Donzel Ankrom, WIAL  
Address Parkersburg, W.Va.

Drilling commenced ~~XXXXXX~~ 7/1/63  
Drilling completed ~~XXXXXX~~ 9/27/63  
Date Shot \_\_\_\_\_ From \_\_\_\_\_ To \_\_\_\_\_  
With \_\_\_\_\_

Open Flow /10ths Water in \_\_\_\_\_ Inch  
/10ths Merc. in \_\_\_\_\_ Inch  
Volume \_\_\_\_\_ Cu. Ft.  
Rock Pressure \_\_\_\_\_ lbs. \_\_\_\_\_ hrs.  
Oil \_\_\_\_\_ bbls., 1st 24 hrs.  
WELL ACIDIZED \_\_\_\_\_

Casing and Tubing	Used in Drilling	Left in Well	Packers
Size			Kind of Packer _____
16			
13			Size of _____
10			Depth set _____
8 1/4			
6 5/8			
5 3/16			
3 <sup>4</sup> / <sub>8</sub>		<u>1973</u>	Perf. top _____
2			Perf. bottom _____
Liners Used			Perf. top <u>1900-1910</u>
			Perf. bottom <u>1960-1966</u>

CASING CEMENTED \_\_\_\_\_ SIZE \_\_\_\_\_ No. Ft. \_\_\_\_\_ Date \_\_\_\_\_

COAL WAS ENCOUNTERED AT \_\_\_\_\_ FEET \_\_\_\_\_ INCHES  
\_\_\_\_\_ FEET \_\_\_\_\_ INCHES FEET \_\_\_\_\_ INCHES  
\_\_\_\_\_ FEET \_\_\_\_\_ INCHES FEET \_\_\_\_\_ INCHES


WELL FRACTURED 1000 barrels water, 20,000 lbs. sand by Dowell, Perforation & logging by Lane Wells.

RESULT AFTER TREATMENT Dry hole

ROCK PRESSURE AFTER TREATMENT \_\_\_\_\_

Fresh Water \_\_\_\_\_ Feet Salt Water \_\_\_\_\_ Feet

Formation	Color	Hard or Soft	Top	Bottom	Oil, Gas or Water	Depth	Remarks
Surface	Brown		0	15			
Slate	Blue		15	25			
Sand	Brown		25	40			
Slate & Red Rock	Red		40	200			
Sand	Brown		200	230			
Red Rock	Red		230	275			
Lime Shells	Gray		275	320			
Slate	Gray		320	356			
Lime	Gray		356	382			
Red Rock	Red		382	395			
Slate & Shell - Blue & Gray			395	420			
Lime Shells	Gray		420	500			
Slate & Shell - Blue & Gray			500	525			
Sand	Blue		525	540			
Slate & Shell - Gray			540	610			
Lime	Gray		610	630			
Slate & Shell - Blue			630	695			
Sand	Brown		695	710			
Slate	Gray		710	777			
Sand	Brown		777	790			
Red Rock	Red		790	838			
Cave	Red		838	855			
Lime	Gray		855	876			
Sand	Brown		876	885			
Slate	Gray		885	919			
Lime	Gray		919	933			
Sand	Blue		933	947			
Red Rock	Red		947	967			

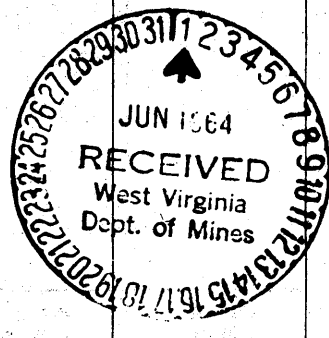

Formation	Color	Hard or Soft	Top 19	Bottom	Oil, Gas or Water	Depth Found	Remarks
Line	Gray		969	996			
Sand	Brown		996	1005			
Slate	Blue		1005	1030			
Line	Gray		1030	1050			
Slate	Blue		1050	1066			
Red Rock	Red		1066	1074			
Slate & Shell - Gray			1074	1081			
Slate	Blue		1081	1090			
Sand	Brown		1090	1110			
Slate	Gray		1110	1135			
Red Rock	Red		1135	1140			
Line	Gray		1140	1153			
Slate & Shell - Gray			1153	1174			
Line	Gray		1174	1182			
Slate & Shell - Gray			1182	1191			
Line	Black		1191	1197			
Slate & Shell - Blue			1197	1254			
Line	Gray		1254	1260			
Slate	Blue		1260	1361			
Salt Sand	White		1361	1410			
Slate	Blue		1410	1425			
Salt Sand	White		1425	1548	Water	1446	
Slate	Blue		1548	1644	Water	1540	
Line	Gray		1644	1705			
Slate	Gray		1705	1769			
Line	Gray		1769	1798			
Pencil Cave	Blue		1798	1802			
Big Line	Gray		1802	1864			
Keener	White		1864	1888			
Big Injun	Brownish	White	1888	1973	Oil Show	1947	

Date March 13, 19 63

APPROVED Carter Development Co., Inc. Owner

By [Signature]  
General Manager (Title)