


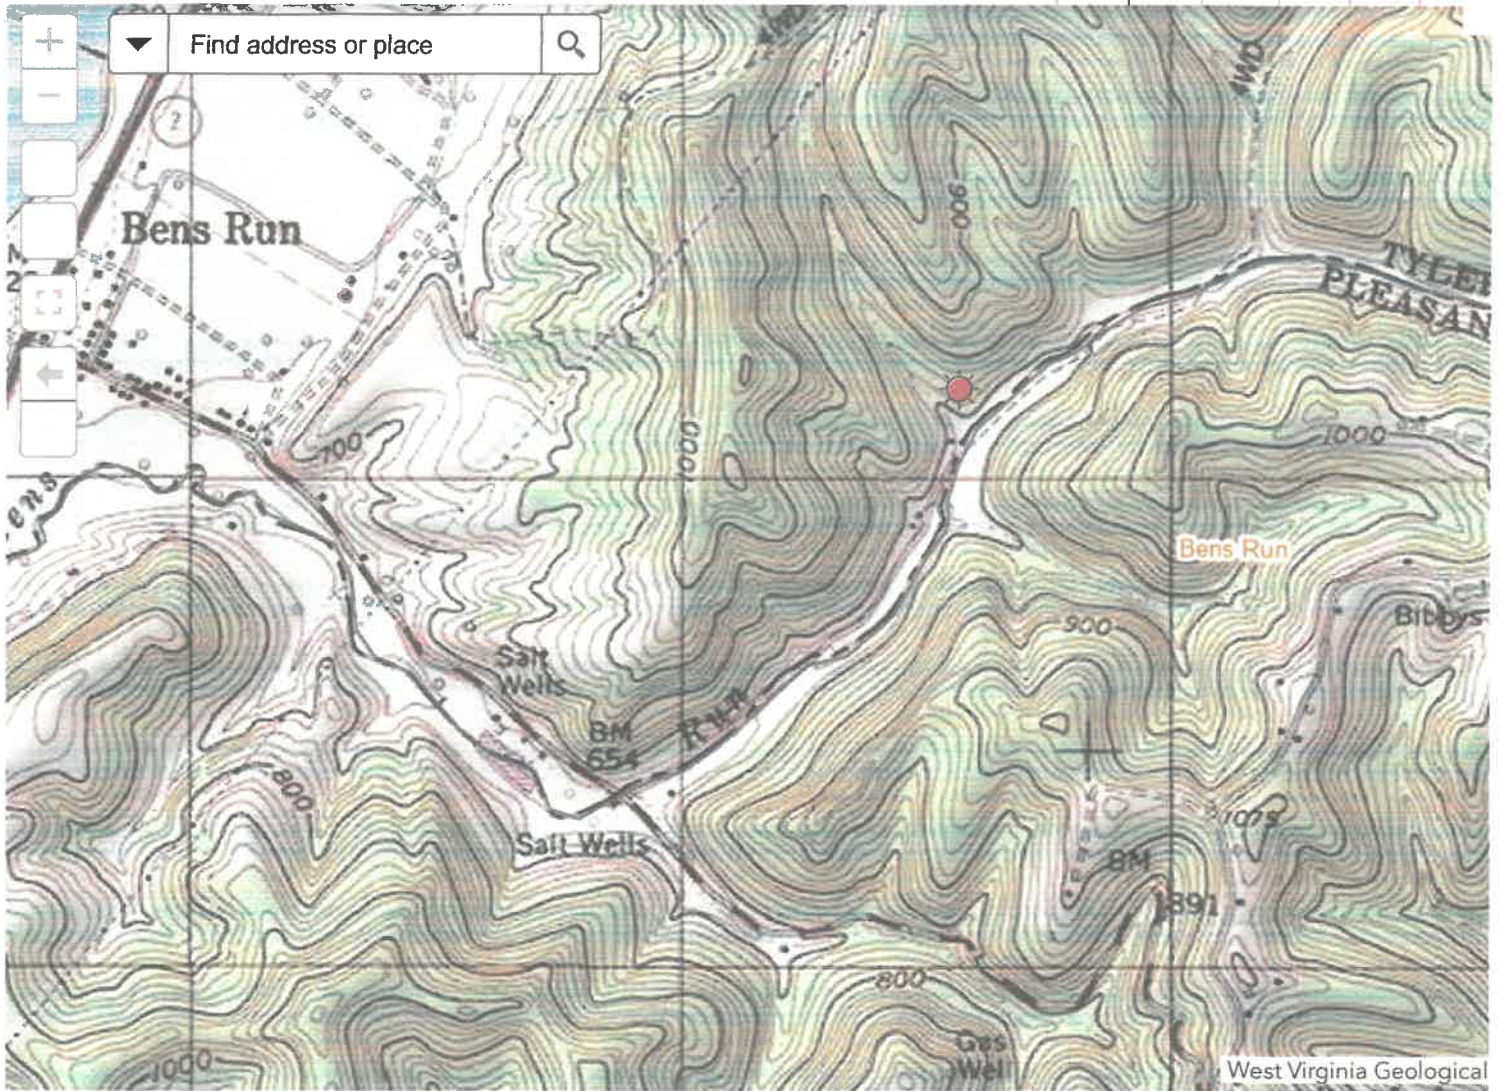


4709500385

RECEIVED
Office of Oil and Gas

AUG 12 2026

WV Department of
Environmental Protection

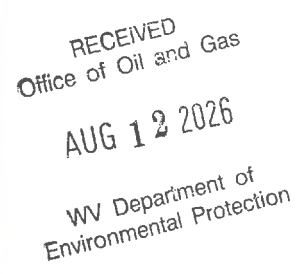

09/25/2026



+

-

▼

Find address or place

Q



47-095-00385

RECEIVED
Office of Oil and Gas

AUG 12 2026

WV Department of
Environmental Protection

AUG 12 2026

WW-7
8-30-06

WV Department of
Environmental Protection



West Virginia Department of Environmental Protection
Office of Oil and Gas

WELL LOCATION FORM: GPS

API: 4709500385 WELL NO.: Bens Run 7
FARM NAME: Bens Run
RESPONSIBLE PARTY NAME: Bens Run Land Company Limited Partnership
COUNTY: Tyler DISTRICT: Union
QUADRANGLE: Bens Run
SURFACE OWNER: Bens Run Land Company Limited Partnership
ROYALTY OWNER: Bens Run Land Company Limited Partnership
UTM GPS NORTHING: 4368404
UTM GPS EASTING: 492557.3 GPS ELEVATION: 683

The Responsible Party named above has chosen to submit GPS coordinates in lieu of preparing a new well location plat for a plugging permit or assigned API number on the above well. The Office of Oil and Gas will not accept GPS coordinates that do not meet the following requirements:

1. Datum: NAD 1983, Zone: 17 North, Coordinate Units: meters, Altitude: height above mean sea level (MSL) – meters.
2. Accuracy to Datum – 3.05 meters
3. Data Collection Method:

Survey grade GPS ____: Post Processed Differential ____

Real-Time Differential ____

Mapping Grade GPS ____: Post Processed Differential ____

Real-Time Differential X ____

4. Letter size copy of the topography map showing the well location.

I the undersigned, hereby certify this data is correct to the best of my knowledge and belief and shows all the information required by law and the regulations issued and prescribed by the Office of Oil and Gas.

Gene Smith
Signature

Consultant
Title

7-16-26
Date

09/25/2026