

MINIMUM ERROR OF CLOSURE $1/500$

SOURCE OF ELEVATION *Junction of roads 0.7 mile south of location -- Elev. 798*

New Location
 Drill Deeper
 Abandonment

"I, THE UNDERSIGNED, HEREBY CERTIFY THAT THIS MAP IS CORRECT TO THE BEST OF MY KNOWLEDGE AND BELIEF AND SHOWS ALL THE INFORMATION REQUIRED BY PARAGRAPH 6 OF THE RULES AND REGULATIONS OF THE OIL AND GAS SECTION OF THE MINING LAWS OF WEST VIRGINIA."

Company Smith and Zinkham Smith Drilling Contractors, Inc.
 Address R. D. 1, Wierton, W. Va.
 Farm Smith and Zinkham
 Tract 1 Acres 59.08 Lease No. _____
 Well (Farm) No. 1 Serial No. _____
 Elevation (Spirit Level) 910
 Quadrangle West Union NW
 County Tyler District Meade
 Engineer Parker & Peters
 Engineer's Registration No. 485
 File No. _____ Drawing No. _____
 Date Oct. 5, 1966 Scale 1" = 30 P.

STATE OF WEST VIRGINIA
 DEPARTMENT OF MINES
 OIL AND GAS DIVISION
 CHARLESTON

WELL LOCATION MAP
 FILE NO. Tyl-405P

+ Denotes location of well on United States Topographic Maps, scale 1 to 62,500, latitude and longitude lines being represented by border lines as shown.

— Denotes one inch spaces on border line of original tracing.

FORM OG-8

STATE OF WEST VIRGINIA
DEPARTMENT OF MINES
OIL AND GAS DIVISION

AFFIDAVIT OF PLUGGING AND FILLING WELL

AFFIDAVIT SHOULD BE MADE IN TRIPPLICATE, ONE COPY MAILED TO THE DEPARTMENT, ONE COPY TO BE RETAINED BY THE WELL OPERATOR AND THE THIRD COPY (AND EXTRA COPIES IF REQUIRED) SHOULD BE MAILED TO EACH COAL OPERATOR AT THEIR RESPECTIVE ADDRESSES.

None
COAL OPERATOR OR OWNER

Smith Drilling Cont Inc.
NAME OF WELL OPERATOR

R.D. 1 Box 16, Chester, W. Va.
COMPLETE ADDRESS

April 24 1967
WELL AND LOCATION

Meade District

D. Smith & B. Zinkham
LEASE OR PROPERTY OWNER

Tyler County

Well No. 1


Smith & Zinkham Farm

Arthur Null
STATE INSPECTOR SUPERVISING PLUGGING

AFFIDAVIT

STATE OF WEST VIRGINIA,
County of Tyler, } ss: Norman Locke
Russell H. Smith and Norman Locke
being first duly sworn according to law depose and say that they are experienced in the work of plugging and filling oil and gas wells and were employed by Smith Drilling Cont Inc. well operator, and participated in the work of plugging and filling the above well, that said work was commenced on the 10 day of April, 1967, and that the well was plugged and filled in the following manner:

SAND OR ZONE RECORD	FILLING MATERIAL	PLUGS USED	CASING	
			CSS PULLED	CSS LEFT IN
Molon Injunct Squaw sand	Filled Solid with Clay from 1971 back to 1670 above Molon bridge 7"	Cement 4 Bags	7" 0P	None
	Set Bridge at 1450 welded back to 1380 with clay.	Cement 5 Bags	8" 82 ft.	
	Pulled casing 8" Set Bridge at 350 Applied to bottom of conductor with clay.		10" none.	
	Pulled casing after setting Bridge at 350 welded pulling 10" Set 15 at 7" from 0 of conductor & Cemented to top			
COAL BEAMS			DESCRIPTION OF MONUMENT	
(NAME)			7" all close around 32" filled around 7" inside 7" with Cement	
(NAME) None			welded 6" 14 Beam against 7" + 14	
(NAME)			Conductor engaged name + Date	
(NAME)				

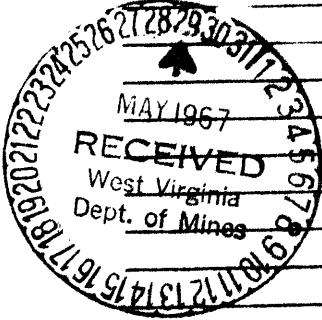

and that the work of plugging and filling said well was completed on the 24 day of April, 1967.
And further deponents saith not.

Russell H. Smith
Norman Locke
D. N. Raymond
Notary Public.

Sworn to and subscribed before me this 24 day of April 1967.

My commission expires: March 16, 1974

Permit No. TXL-405-1