

WW-7
8-30-06



West Virginia Department of Environmental Protection
Office of Oil and Gas
WELL LOCATION FORM: GPS

API: 47-095-00446 WELL NO.: 605470

FARM NAME: Orr, Esta-Agent

RESPONSIBLE PARTY NAME: Equitrans, L.P.

COUNTY: Tyler DISTRICT: McElroy

QUADRANGLE: West Union NE 4.3

SURFACE OWNER: Lloyd D. Talkington and Donna J. Talkington

ROYALTY OWNER: Lloyd D. Talkington and Donna J. Talkington ETAL

UTM GPS NORTHING: 4360536

UTM GPS EASTING: 518088 GPS ELEVATION: 245.9736m (807 ft)


The Responsible Party named above has chosen to submit GPS coordinates in lieu of preparing a new well location plat for a plugging permit or assigned API number on the above well. The Office of Oil and Gas will not accept GPS coordinates that do not meet the following requirements:

- 1. Datum: NAD 1983, Zone: 17 North, Coordinate Units: meters, Altitude: height above mean sea level (MSL) – meters.
- 2. Accuracy to Datum – 3.05 meters
- 3. Data Collection Method:
Survey grade GPS : Post Processed Differential
Real-Time Differential
Mapping Grade GPS : Post Processed Differential
Real-Time Differential
- 4. Letter size copy of the topography map showing the well location.

RECEIVED
Office of Oil and Gas
JUN 16 2017
WV Department of
Environmental Protection

I the undersigned, hereby certify this data is correct to the best of my knowledge and belief and shows all the information required by law and the regulations issued and prescribed by the Office of Oil and Gas.

[Signature] Landman III 5-12-17
Signature Title Date

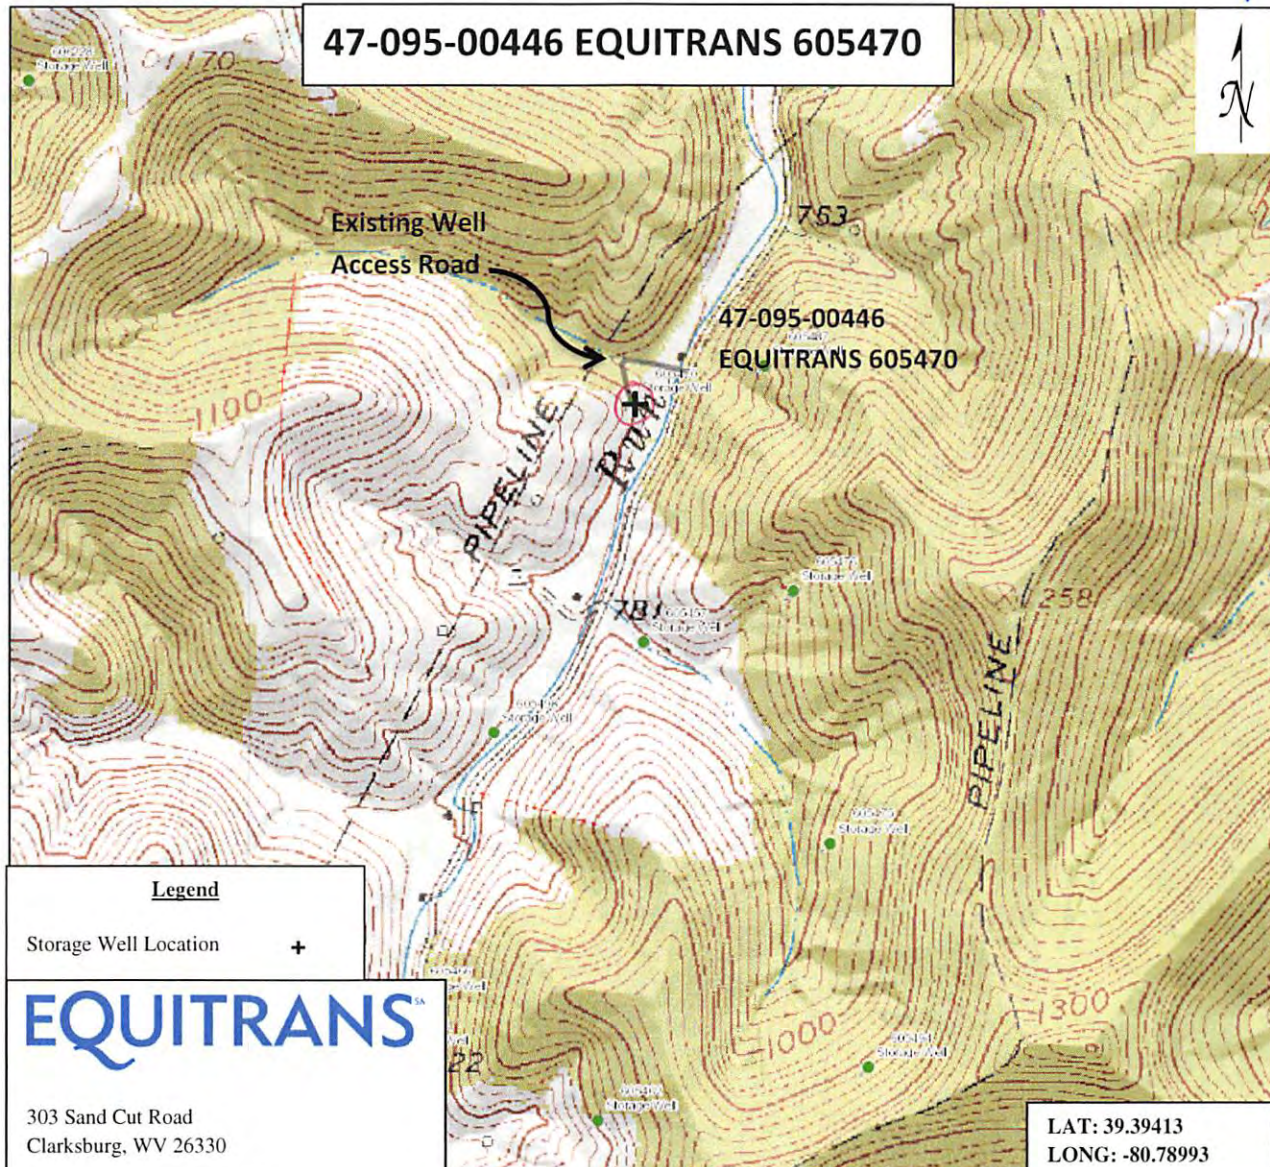

*DMH
6/8/17*

Quad: West Union NE 4.3 Scale: Not Mapped to Scale

County: Tyler Date: May 12, 2017

District: McElroy API: 47-095-00446

RECEIVED
Office of Oil and Gas

JUN 16 2017

WV Department of
Environmental Protection
07/14/2017