



West Virginia Department of Environmental Protection  
Office of Oil and Gas  
**WELL LOCATION FORM: GPS**

API: 47-095-00496 P WELL NO.: WV 451811 (Pitts 7135)

FARM NAME: Pitts

RESPONSIBLE PARTY NAME: Equitable Production Company, Inc.

COUNTY: Tyler DISTRICT: McElroy

QUADRANGLE: Shirley 7.5'

SURFACE OWNER: Dave and Annie Underwood, et al

ROYALTY OWNER: Appalachian Royalties, Inc. et al

UTM GPS NORTHING: 4,366,089.68

UTM GPS EASTING: 519,135.11 GPS ELEVATION: 249 m (817ft)

The Responsible Party named above has chosen to submit GPS coordinates in lieu of preparing a new well location plat for a plugging permit or assigned API number on the above well. The Office of Oil and Gas will not accept GPS coordinates that do not meet the following requirements:

1. Datum: NAD 1983, Zone: 17 North, Coordinate Units: meters, Altitude: height above mean sea level (MSL) – meters.
2. Accuracy to Datum – 3.05 meters
3. Data Collection Method:

Survey grade GPS     : Post Processed Differential       
Real-Time Differential     

Mapping Grade GPS X: Post Processed Differential X  
Real-Time Differential     

4. Letter size copy of the topography map showing the well location.

I the undersigned, hereby certify this data is correct to the best of my knowledge and belief and shows all the information required by law and the regulations issued and prescribed by the Office of Oil and Gas.

Ben R. Siefert  
Signature

P.S. 2092  
Title

9-9-11  
Date

RECEIVED  
Office of Oil & Gas  
OCT 17 2011  
West Virginia Department of  
Environmental Protection

Topo Quad: Shirley 7.5'

Scale: 1" = 2000'

County: Tyler


Date: August 8, 2011

District: McElroy

Project No: 69-54-00-08

47-095-00496 (WV 451811)

Topo

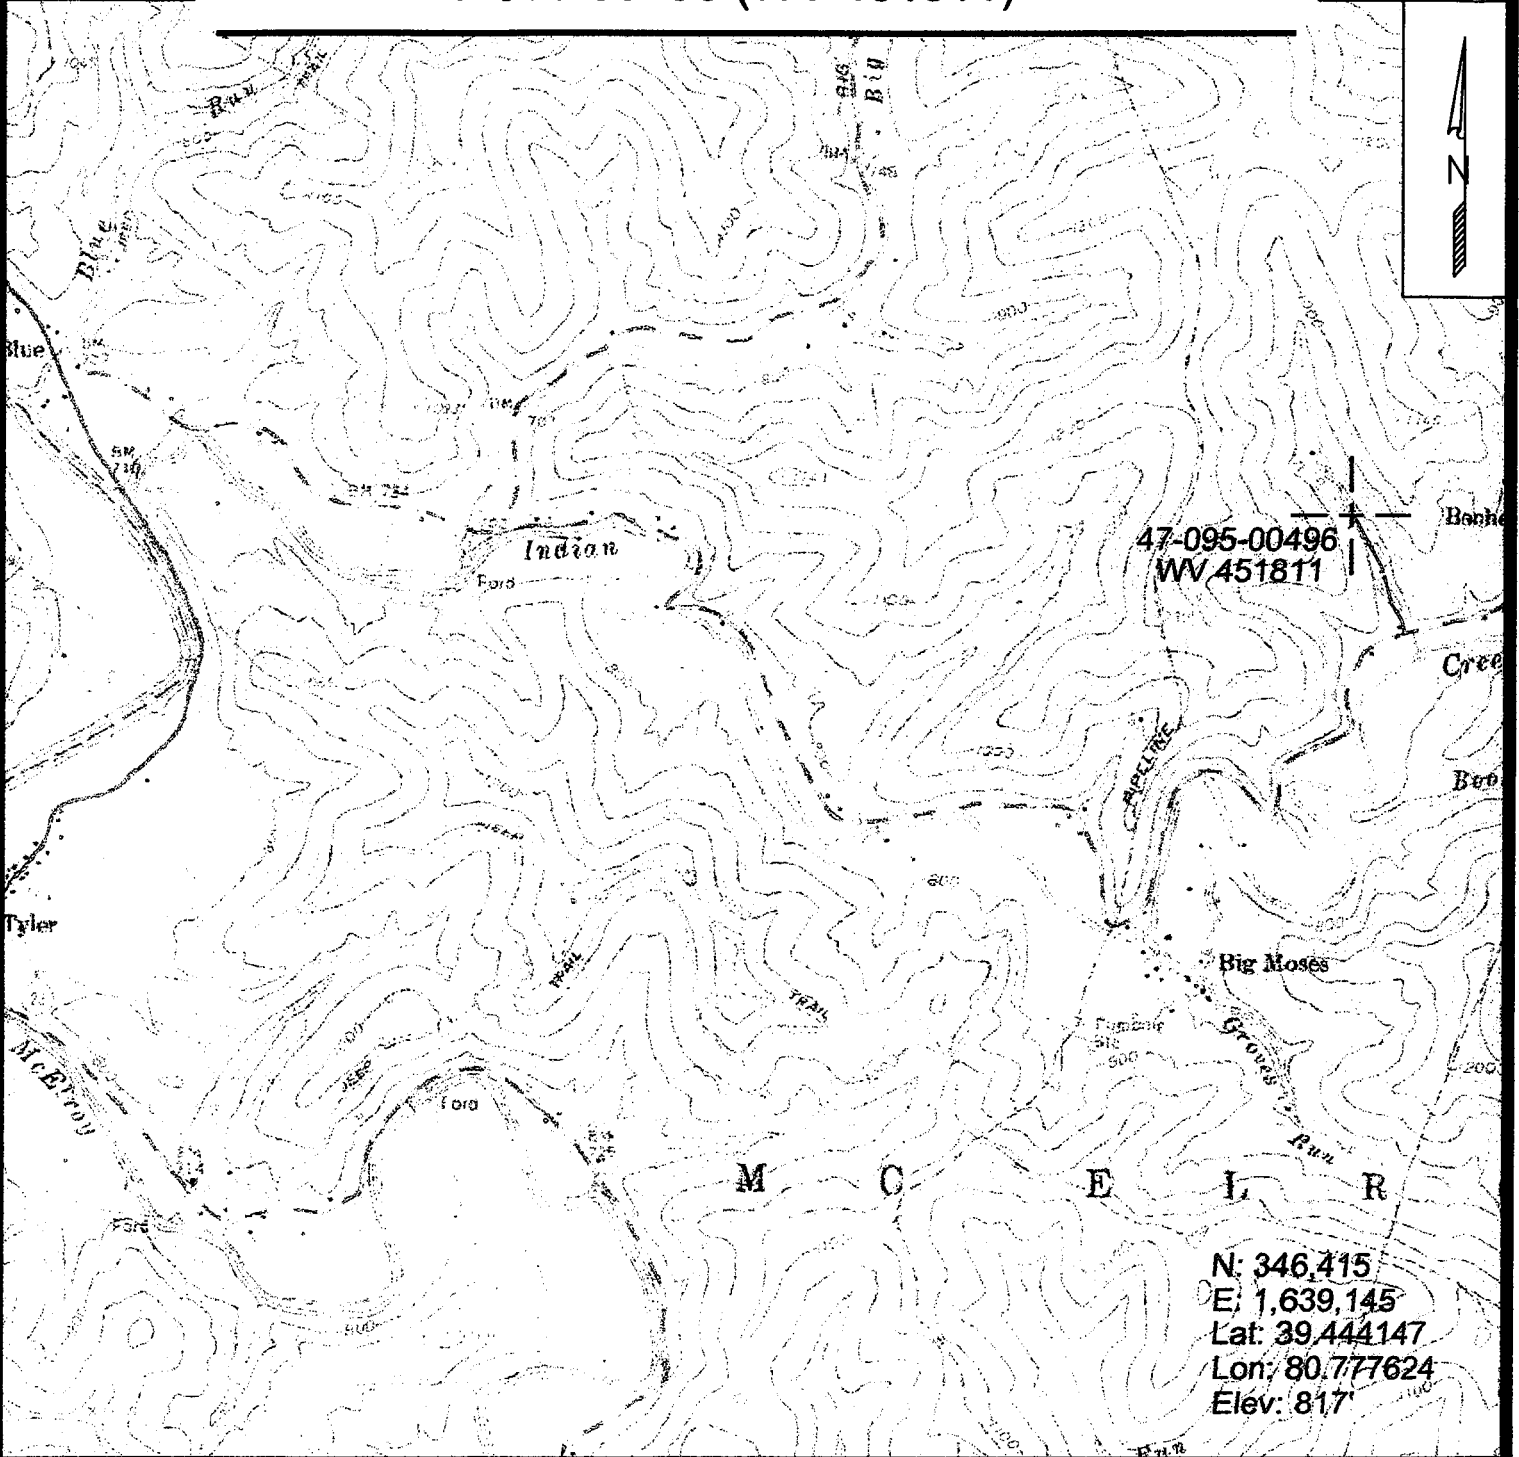

N: 346,415  
 E: 1,639,145  
 Lat: 39.444147  
 Lon: 80.777624  
 Elev: 817'



SURVEYING AND MAPPING SERVICES PERFORMED BY:

**ALLEGHENY SURVEYS, INC.**

1-800-482-8606  
 P.O. BOX 438  
 BIRCH RIVER, WV 26610  
 PH: (304) 649-8606  
 FAX: (304) 649-8608

PREPARED FOR:

**EQT Production Company**

1710 Pennsylvania Ave.  
 Charleston, WV 25302