


LATITUDE 39° 32' 30"

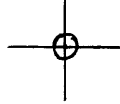

00, 05, 08

LONGITUDE

7'5 OGIS topo location

7.5' loc	<u>0.18 S</u>	15' loc	<u>3.06 S</u>
	<u>1.11 W</u>	(calc.)	<u>1.10 W</u>

Company _____

Farm _____

Quad New Martinsville SC
PORTERS FALLS 7 1/2'

County TYLER


District ELLSWORTH

WELL LOCATION MAP

File No. 095-523

(230)

39°32'

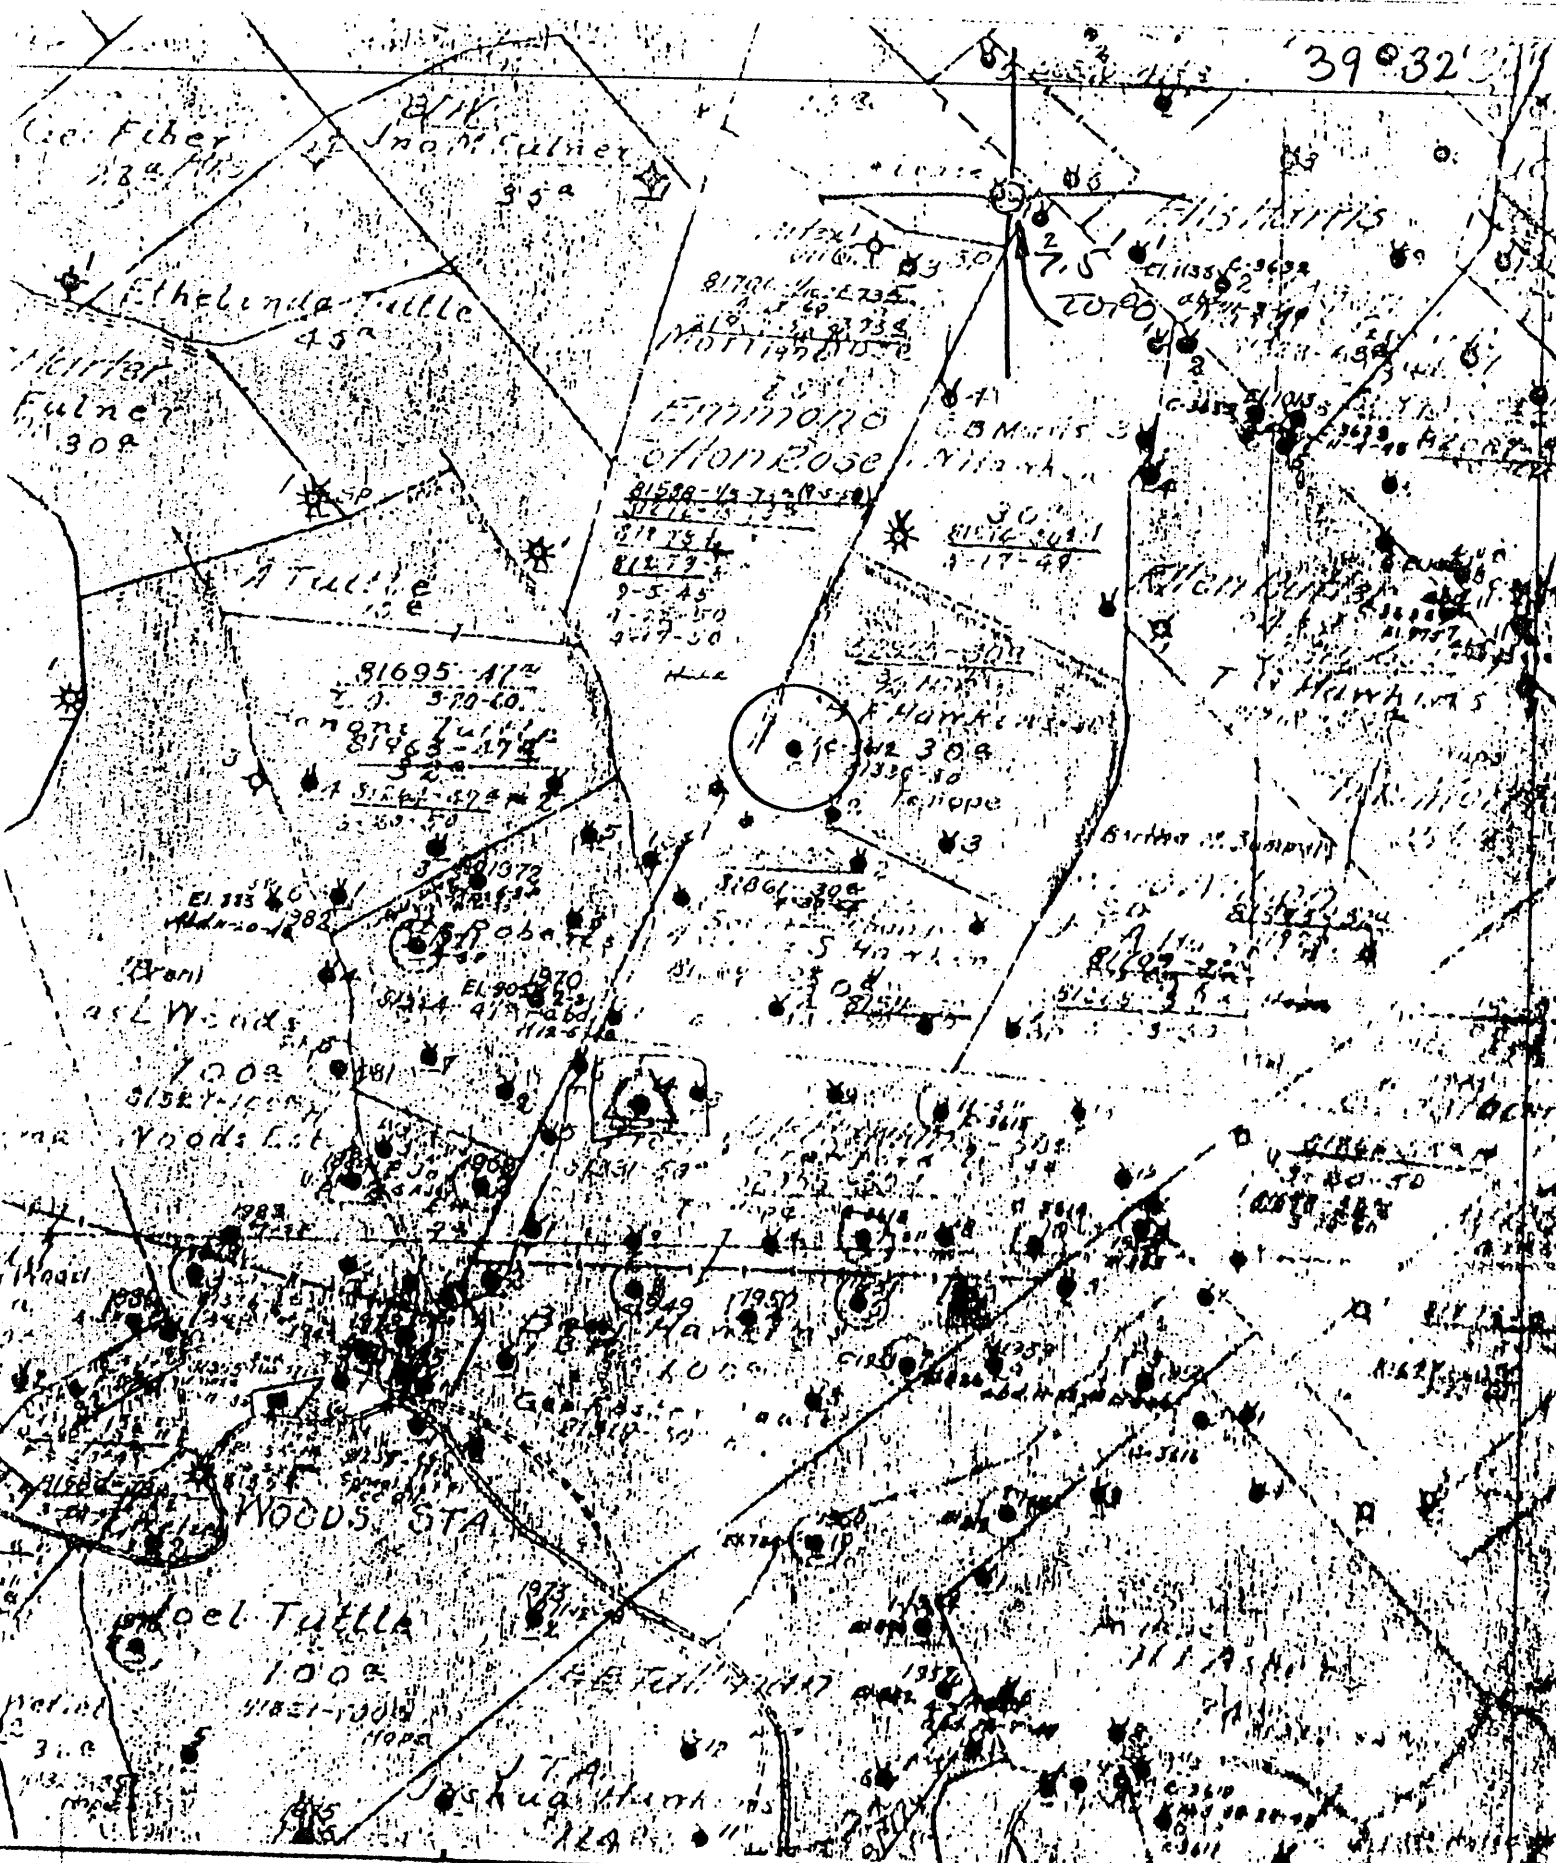

① DENOTES LOCATION OF WELL ON UNITED STATES TOPOGRAPHIC MAPS

FORM IV-6
3-78
156 N7W13



DATE 1-2- 1979
OPERATOR'S WELL NO. 1
API WELL NO. 47-095-0573
STATE COUNTY PERMIT

STATE OF WEST VIRGINIA
DEPARTMENT OF MINES
OIL AND GAS DIVISION

WELL TYPE: OIL GAS LIQUID INJECTION WASTE DISPOSAL
(IF "GAS", PRODUCTION STORAGE DEEP SHALLOW)
LOCATION: ELEVATION 246 WATER SHED ELK FORK
DISTRICT ELLSWORTH COUNTY TYLER
QUADRANGLE PORTER FALLS 7.5'

SURFACE OWNER _____ ACREAGE _____
OIL & GAS ROYALTY OWNER _____ LEASE NO. _____ LEASE ACREAGE _____

PROPOSED WORK: DRILL CONVERT DRILL DEEPER REDRILL FRACTURE OR STIMULATE PLUG OFF OLD FORMATION PERFORATE NEW FORMATION OTHER PHYSICAL CHANGE IN WELL (SPECIFY) _____

PLUG AND ABANDON CLEAN OUT AND REPLUG
TARGET FORMATION _____ ESTIMATED DEPTH _____
WELL OPERATOR Pennzoil Company DESIGNATED AGENT James A. Crews
ADDRESS P. O. Box 1588 ADDRESS P. O. Box 1588
Parkersburg, WV 26101

47-095-0523

County *Logan*
 State *W. Va.*
 Commenced *1935*
 Completed *1935*
 Contractor *James Lewis Olds*
 Purchased From *James Lewis Olds* Per Foot
 Date Purchased *April 15, 1935* *31 cent*
 Date Connected
 Date Connected
 Sold To
 Date Sold
 Date Plugged
 Date Abandoned

W. Va. State 846

Size	CASING AND TUBING		Pulled
	Put In Well	Left In Well	
13 In. Casing			
10 In. Casing			
8 1/2 In. Casing			
6 1/2 In. Casing			
6 In. Casing			
5 1/2 In. Casing			
4 1/2 In. Casing			
3 1/2 In. Casing			
2 In. Tubing			
In. Tubing			

Date	SHOOTING			
	Qty.	Sand	Depth	Notes

Formation	Elevation at Mouth of Well		Thickness	Oil at	Gas at	Water at	Thick
	Top	Bottom					
Pittsburgh Coal							
Red Rock Cave							
Cow Run (First)							
Cow Run (Second)							
Salt Sand (Upper)							
Salt Sand (Middle)							
Salt Sand (Lower)							
Mazen							
Little Lime							
Pencil Cave							
Big Lime							
Keanor Sand							
Injun Sand							
Squaw Sand							
Well Sand							
Berra Sand							
Gantz Sand							
Fifty Foot Sand							
Thirty Foot Sand							
Gordon Stray							
Gordon Sand							
Fourth Sand							
Fifth Sand							
Corniferous Lime							
Niagara Lime							
Cave							
Clinton							
Madina Shale							
Trenton							
Total Depth							

Remarks *Well owned by C. C. Moore Estate*

Box 1946, Tulsa, Oklahoma.

Size	Make	Set
6 1/2 X 4 1/2		1933

PACKERS