


LATITUDE 39° 27' 30"

LONGITUDE 80° 47' 30"

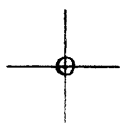

7'5 OGIS topo location

7.5' 10c	<u>1.96 S</u>	15' 10c	<u>4.84 S</u>
	<u>1.38 W</u>	(calc.)	<u>3.61 W</u>

Company _____

Farm _____

West Union NE

Quad SHIRLEY 7 1/2'

County TYLER

District Mc ELROY


WELL LOCATION MAP

File No. 095-350

(095)

39° 27' 30"

80° 47' 30"

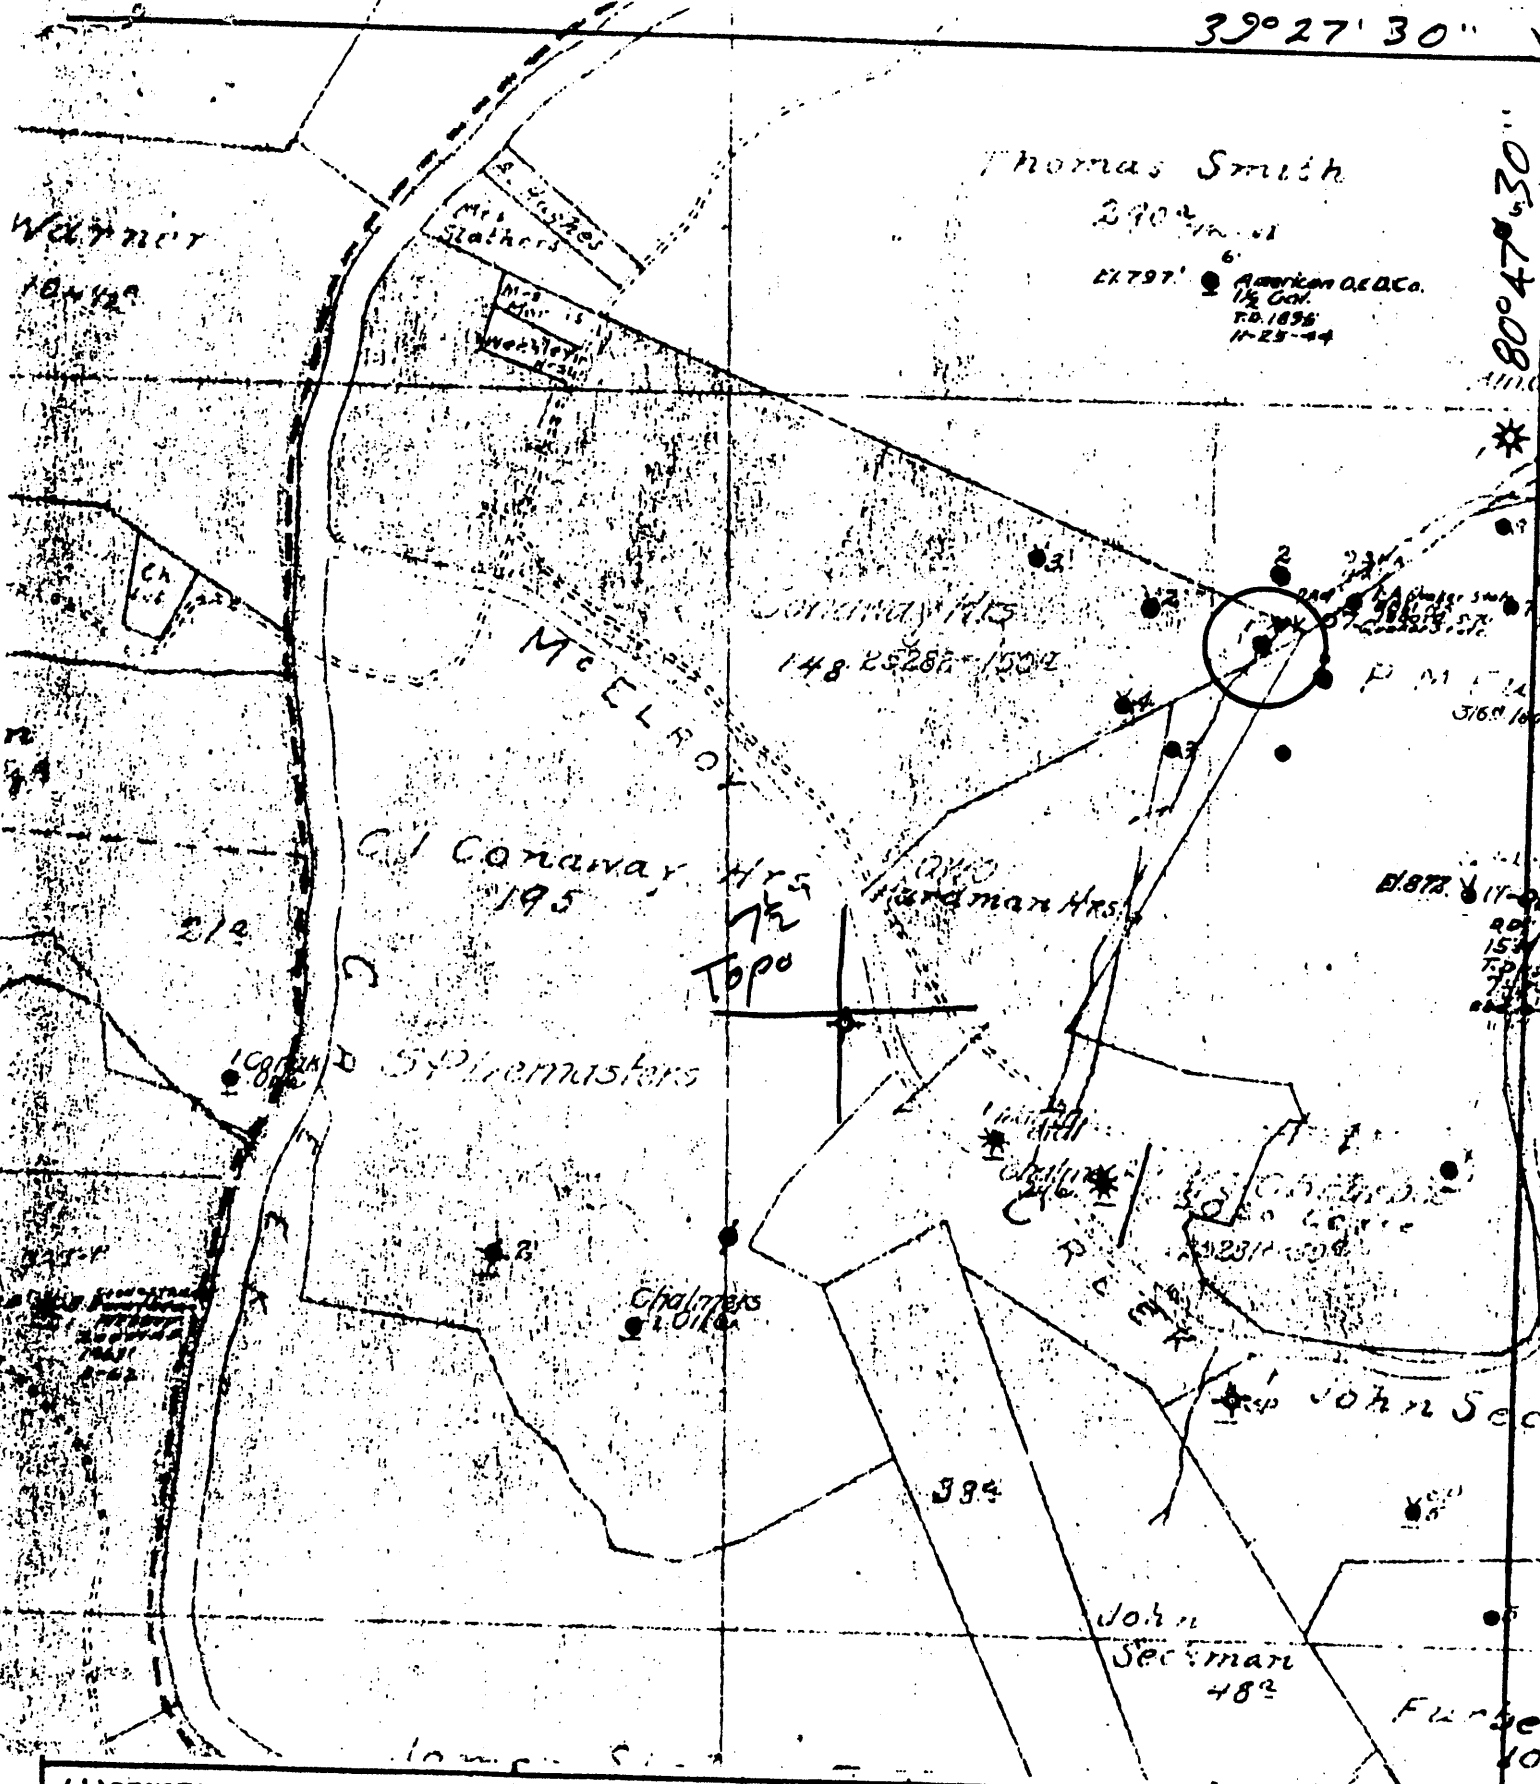

Thomas Smith
 390th m. 1
 21797' ● American O&G Co.
 1/2 Cor.
 T.D. 1896
 11-25-44

McElroy
 Conaway Hrs
 195

Hardman Hrs

Splennisters

Chalmers

John Secman
 48²

(+) DENOTES LOCATION OF WELL ON UNITED STATES TOPOGRAPHIC MAPS

FORM IV-6
 (8-78)
 N46 S1 W14



DATE 1-26, 1979
 OPERATOR'S WELL NO. 1
 API WELL NO. 47-095-0550
 STATE COUNTY PERMIT

STATE OF WEST VIRGINIA
 DEPARTMENT OF MINES
 OIL AND GAS DIVISION

WELL TYPE: OIL GAS LIQUID INJECTION WASTE DISPOSAL
 (IF "GAS", PRODUCTION STORAGE DEEP SHALLOW
 LOCATION: ELEVATION _____ WATER SHED McElroy Creek
 DISTRICT McElroy COUNTY Tyler
 QUADRANGLE Shilley 7^{1/2}

SURFACE OWNER _____ ACREAGE _____
 OIL & GAS ROYALTY OWNER _____ LEASE NO. _____ LEASE ACREAGE _____

PROPOSED WORK: DRILL CONVERT DRILL DEEPER REDRILL FRACTURE OR STIMULATE PLUS OFF OLD FORMATION PERFORATE NEW FORMATION OTHER PHYSICAL CHANGE IN WELL (SPECIFY) _____

PLUS AND ABANDON CLEAN OUT AND REPLUG
 TARGET FORMATION _____ ESTIMATED DEPTH _____
 WELL OPERATOR Pennzoil Company DESIGNATED AGENT James A. Crews
 ADDRESS P. O. Box 1588 ADDRESS P. O. Box 1588
Parkersburg, WV 26101 Parkersburg, WV 26101

CONAWAY HELLS - 1

CONAWAY HEIRS

McElroy

COUNTY

Tyler

WELL 1

ACRES 150

LEASE NO. 25282

STATE West Va.

N.

S1-2 E. W10-1

COMMENCED

19

COMPLETED

COMMENCED

19

COMPLETED July - 1898

CONTRACTOR

COMMENCED

19

COMPLETED

19

CONTRACTOR

FORMATION

CASING RECORD

KIND

TOP BOTTOM

STEEL LINE MEASUREMENT

REMARKS

SIZE

BOTTOM CASING (STEEL LINE)

PUT IN WELL (TALLY MEAS.)

PULLED (TALLY MEAS.)

LEFT IN WHEN ABN

Big Injun pay

1766
1803 1/2

6 1/4"
5 1/8"

1719

1715'
1735'

PACKERS

KIND

SIZE

DEPTH SET

DATE

TORPEDO RECORD

DATE SHOT	NO. QTS.	SIZE SHELL	TOP SHOT	BOTTOM	RESULT
8-12-98	16		?		
11-29-99	40		1853'		Total depth
10-22-03	30		1828'		
6-12-05	50		1843'		

ABANDONMENT RECORD

FILLED WITH	FROM	TO	SIZE	PLUG KIND	DEPTH

REMARKS

Cleaned Out 10-3-58 to 2-3-57
Sl. after C.C. 11-58

1848' measured 8/21-4)
1823'

PRODUCTION RECORD

HOURS BEFORE SHOT
HOURS AFTER SHOT
TEST

Injun

SAND NO REC. BLS.
SAND BLS.

APPROVED BY

095-550