


LATITUDE 39° 32' 30"

09, 05, 08 LONGITUDE

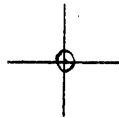

7'5 OGIS topo location

| | | | |
|----------|---------------|---------|---------------|
| 7.5' loc | <u>1.62 S</u> | 15' loc | <u>4.50 S</u> |
| | <u>1.62 W</u> | (calc.) | <u>1.62 W</u> |

Company _____

Farm _____

New Martinsville SC


Quad PORTERS FALLS 7 1/2'

County TYLER

District ELLSWORTH

WELL LOCATION MAP

File No. 095 3559

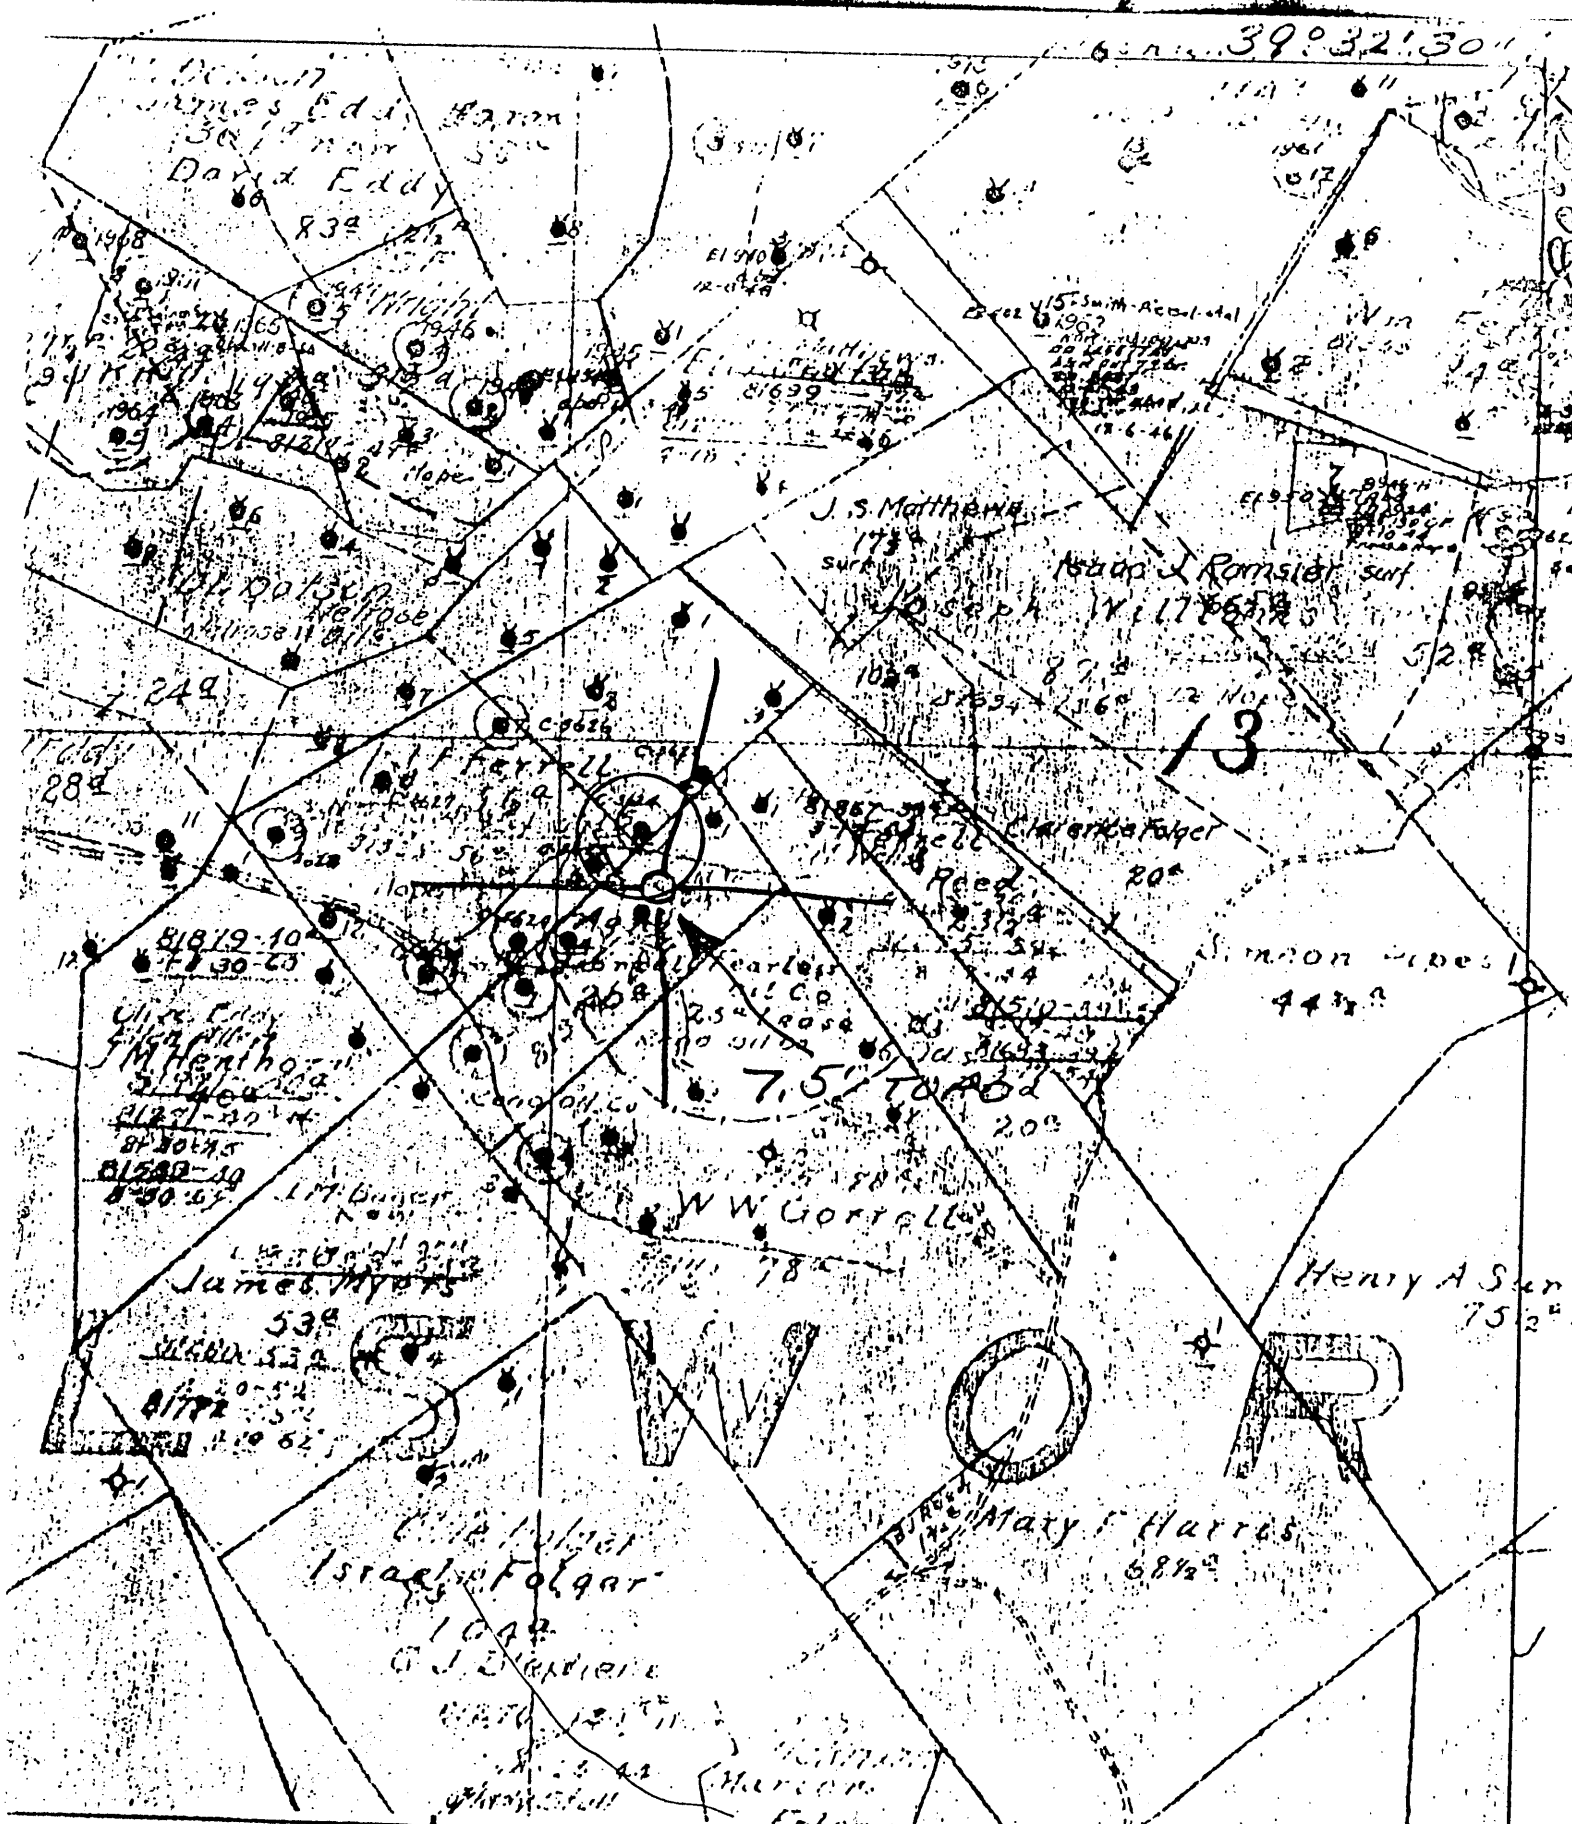

○ DENOTES LOCATION OF WELL ON UNITED STATES TOPOGRAPHIC MAPS



DATE Jan 2 1972
 OPERATOR'S WELL NO. 5
 API WELL NO. 47-095-0559
 STATE COUNTY PERMIT

STATE OF WEST VIRGINIA
 DEPARTMENT OF MINES
 OIL AND GAS DIVISION

WELL TYPE: OIL GAS _____ LIQUID INJECTION _____ WASTE DISPOSAL _____
 (IF "GAS", PRODUCTION _____ STORAGE _____ DEEP _____ SHALLOW
 LOCATION: ELEVATION 945 WATER SHED HILLS RUN
 DISTRICT ELLSWORTH COUNTY Tyler
 QUADRANGLE PORTERS FALLS 7.5'

LEASE OWNER _____ ACREAGE _____
 SURFACE OWNER _____ ACREAGE _____
 LEASE NO. _____ LEASE ACREAGE _____
 PROPOSED WORK: DRILL _____ CONVERT _____ DRILL DEEPER _____ REDRILL _____ FRACTURE OR
 STIMULATE _____ PLUS OFF OLD FORMATION _____ PERFORATE NEW
 FORMATION _____ OTHER PHYSICAL CHANGE IN WELL (SPECIFY) _____

PLUG AND ABANDON _____ CLEAN OUT AND REPLUS _____
 PROPOSED FORMATION _____ ESTIMATED DEPTH _____
 WELL OPERATOR Pennzoil Company DESIGNATED AGENT James A. Crews
 ADDRESS P. O. Box 1588 ADDRESS P. O. Box 1588
Parkersburg, WV 26101 Parkersburg, WV 26101

NO. 1

SOUTH PENN OIL COMPANY—COMPLETION

SERIAL NO. _____ FARM J. F. FARRELL WELL NO. # 5

ELEVATION _____ N. 5-6 S. _____ E. _____ W. 14-15

LEASE NO. _____ ACRES _____

WATERS OF Elk Fork Creek

DISTRICT Ellsworth COUNTY Tyler STATE West Va.

DRILLING COMMENCED NO RECORD COMPLETED NO RECORD DEPTH 1863

| SANDS | TOP | BOTTOM | ELEV. TOP | CASING |
|--|--------------|--------|-----------|--------------------|
| PCH. COAL OR BIG LIME <u>Keener sand.</u> | <u>1832'</u> | | | <u>6 5/8" 1767</u> |
| | | | | |
| | | | | |
PACKERS AND DEPTH SET

INITIAL PROD. NO RECORD SAND NO RECORD DEPTH 1840

GAS TEST _____

SHOT No Shot Record.

REMARKS _____

REPORTED BY Shirley Dist.

ABANDONED _____

095-559