



West Virginia Department of Environmental Protection
Office of Oil and Gas
WELL LOCATION FORM: GPS

API: 47-095-00565 WELL NO.: 3

FARM NAME: WM. FERRELL

RESPONSIBLE PARTY NAME: Triad Hunter, LLC

COUNTY: TYLER DISTRICT: ELLSWORTH

QUADRANGLE: Porters Falls

SURFACE OWNER: FRIEND, CHARLES E. & LAURA L.

ROYALTY OWNER: _____

UTM GPS NORTHING: 4374946.7594

UTM GPS EASTING: 513010.1560 GPS ELEVATION: 796'

The Responsible Party named above has chosen to submit GPS coordinates in lieu of preparing a new well location plat for a plugging permit or assigned API number on the above well. The Office of Oil and Gas will not accept GPS coordinates that do not meet the following requirements:

1. Datum: NAD 1983, Zone: 17 North, Coordinate Units: meters, Altitude: height above mean sea level (MSL) – meters.
2. Accuracy to Datum – 3.05 meters
3. Data Collection Method:
Survey grade GPS ____; Post Processed Differential ____

Real-Time Differential ____

Mapping Grade GPS ____; Post Processed Differential ____

Real-Time Differential ____

4. Letter size copy of the topography map showing the well location.


I the undersigned, hereby certify this data is correct to the best of my knowledge and belief and shows all the information required by law and the regulations issued and prescribed by the Office of Oil and Gas.

Signature *Mark Hunter*

SUPERVISOR FIELD
Title

2/15/19
Date

RECEIVED
Office of Oil and Gas
FEB 25 2019
West Virginia Department of Environmental Protection

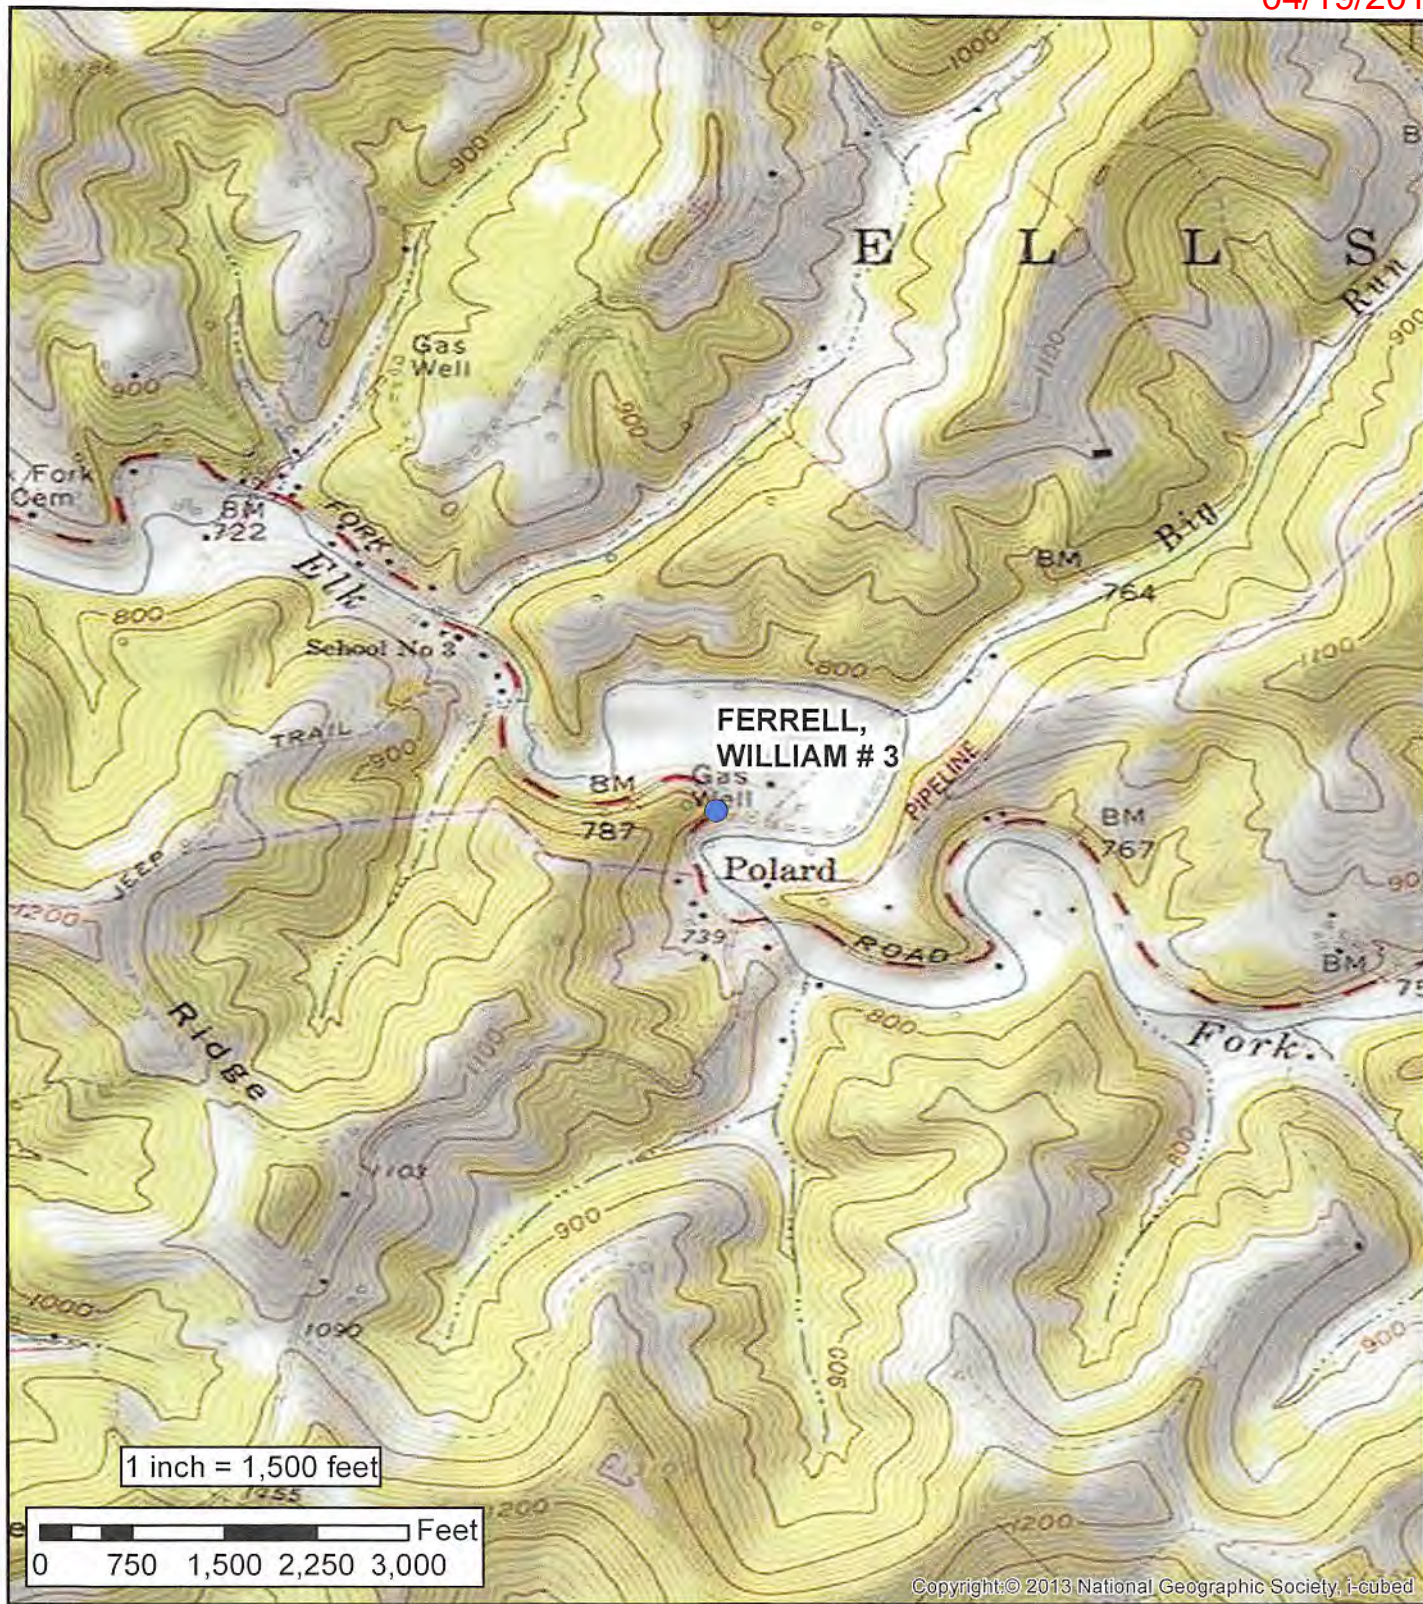

Well Name: Ferrell, W.M. #3

Triad Hunter, LLC
A subsidiary of Blue Ridge Mountain Resources, Inc.

Tyler County - Ellsworth District - West Virginia

RECEIVED
DEPT OF LAND AND GAS
FEB 25 2019
WV Department of
Environmental Protection