

LATITUDE 39° 32' 30"

00,05,08 LONGITUDE



7'5 OGIS topo location

7.5' loc	<u>1.885</u>	15' loc	<u>4.765</u>
	<u>1.80W</u>	(calc.)	<u>1.80W</u>

Company _____

Farm _____

New Martinsville SC

Quad PORTERS FALLS 7 1/2'


County TYLER

District ELLSWORTH

WELL LOCATION MAP

File No. 095-2573

39° 32' 30"

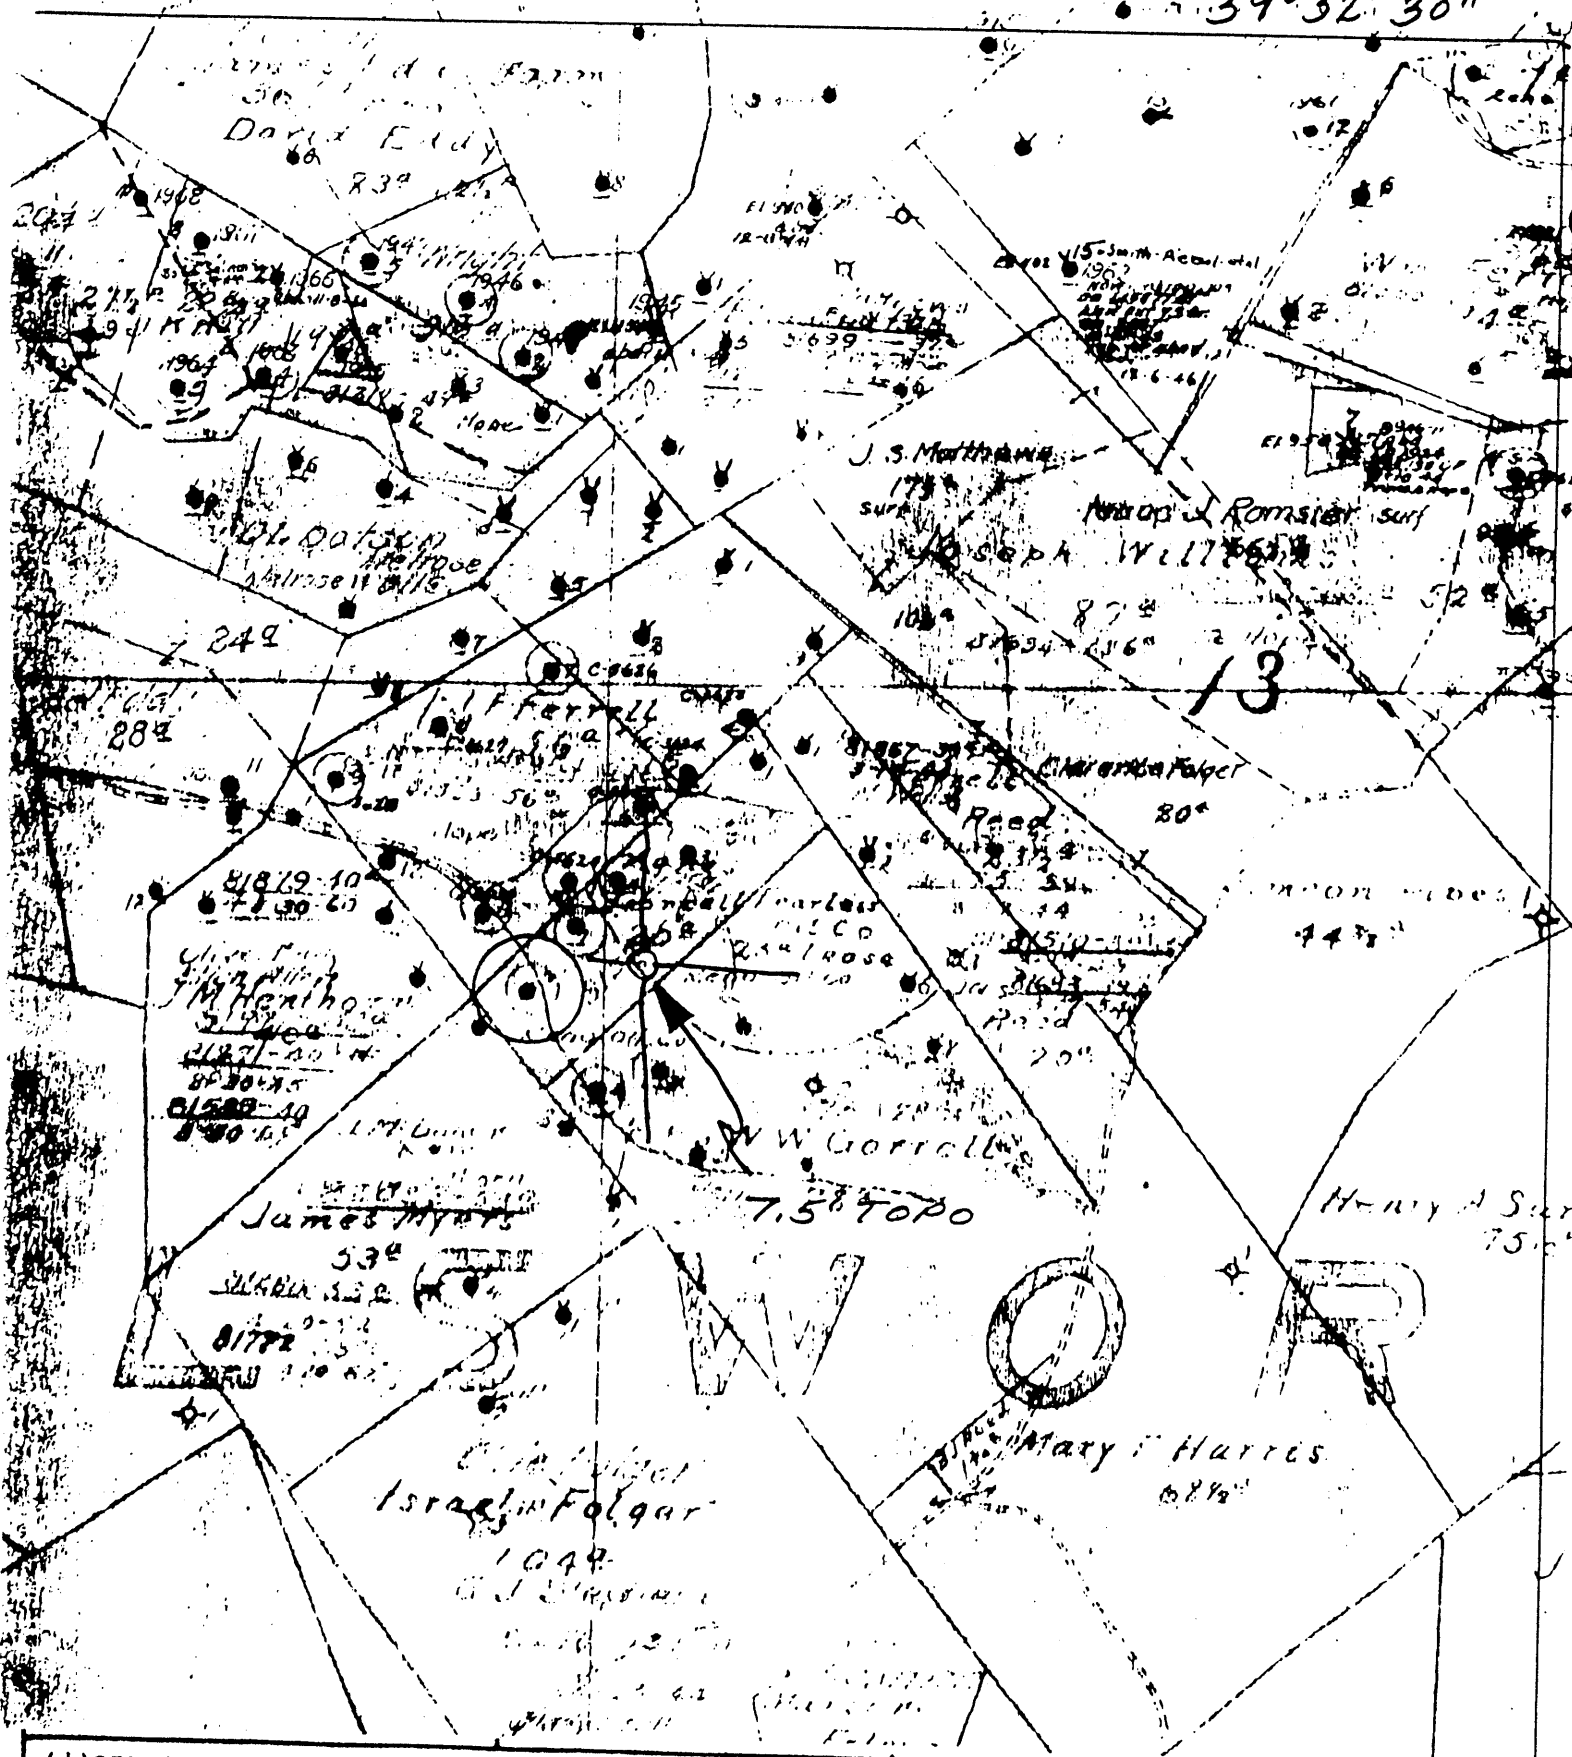

(+) DENOTES LOCATION OF WELL ON UNITED STATES TOPOGRAPHIC MAPS



DATE Jan 2, 1979
 OPERATOR'S WELL NO 2
 API WELL NO. 47
 STATE COUNTY PERMIT 573

FORM IV-6
 (8-78)
 N56 N5W13

STATE OF WEST VIRGINIA
 DEPARTMENT OF MINES
 OIL AND GAS DIVISION

WELL TYPE: OIL GAS LIQUID INJECTION WASTE DISPOSAL
 (IF "GAS", PRODUCTION STORAGE DEEP SHALLOW
 LOCATION: ELEVATION NH WATER SHED HILLS RUN
 DISTRICT Ellsworth COUNTY Tyler
 QUADRANGLE PORTERS FALLS 7.5'
 SURFACE OWNER _____ ACREAGE _____
 OIL & GAS ROYALTY OWNER _____ LEASE NO. _____ LEASE ACREAGE _____
 PROPOSED WORK: DRILL CONVERT DRILL DEEPER REDRILL FRACTURE OR STIMULATE PLUS OFF OLD FORMATION PERFORATE NEW FORMATION OTHER PHYSICAL CHANGE IN WELL (SPECIFY) _____

PLUG AND ABANDON CLEAN OUT AND REPLUG
 TARGET FORMATION _____ ESTIMATED DEPTH _____
 WELL OPERATOR Pennzoil Company DESIGNATED AGENT James A. Green
 ADDRESS P. O. Box 1588 ADDRESS P. O. Box 1588
Parkersburg, WV 26101 Parkersburg, WV 26101

AGNES CORCELL-2

5 S. E. W. 13-14 Location Made
 Ellsworth Rig Completed Purchased From **Barron**
 Tyler Date Purchased **4/1/60**
 W.Va. Dr'g Commenced
 Dr'g Completed **Nov. 29, 1897** Sold to
 Rights Owned By Dr'g Contractor Date Sold
 Date Abandoned

FORMATION

CASING RECORD

Kind	Top	Bottom	Steel Line Meas.	Tests	Size	Bottom Casing Steel Line	Put in Well Tally Meas.	Pulled Tally Meas.	
Keener Sand	1833								
First Pay	1833	gas			10		100	100	Date
Second Pay	1843				8 1/2		950	950	Size C
					6-5/8		1738	V	Top C
									Bot. C

PACKERS AND SHOES

Kind	Size	Depth Set	

TORPEDO RECORD

Date	No. Qts.	Size Shell	Top Shot	Bottom
12/24/1897	5			
1/8/1898	10			
1/27/1898	15			
2/25/1898	25			
8/26/1898	60			
8/26/1898	20	(1st pay)		
8/26/1898	40	(2nd pay)		

RECEIVED
 OCT 3 1960

OIL & GAS DIVISION
 DEPT. OF MINES

TOTAL DEPTH 1862

Initial Prod.	Sand	* At Completion	* 30 Days After	*

APPROVED

Oil in Barrels
 Gas in M. Cu. Ft.

TESTS, REPORTS AND REMARKS ON REVERSE SIDE

095-573

