
WW-7 8-30-06



West Virginia Department of Environmental Protection Office of Oil and Gas

WELL LOCATION FORM: GPS

_{API} : 47-095-00581	WELL NO.: 6	
FARM NAME: HILL, J. K.		
RESPONSIBLE PARTY NAME: Triad Hunter, LLC		
	DISTRICT: ELL	SWORTH
QUADRANGLE: Porters Falls		
SURFACE OWNER: DANIEL R DEETZ		
ROYALTY OWNER: Unknown		
UTM GPS NORTHING: 4375546.0000		
UTM GPS EASTING: 512659.0000 GPS ELEVATION: 948		
The Responsible Party named above has chosen to submit GPS coordinates in lieu of preparing a new well location plat for a plugging permit or assigned API number on the above well. The Office of Oil and Gas will not accept GPS coordinates that do not meet the following requirements: 1. Datum: NAD 1983, Zone: 17 North, Coordinate Units: meters, Altitude: height above mean sea level (MSL) – meters. 2. Accuracy to Datum – 3.05 meters 3. Data Collection Method: Survey grade GPS × : Post Processed Differential		
Real-Time Differential X		
Mapping Grade GPS: Post Processed Differential Real-Time Differential FCD Office of Oil and Gas		
4. Letter size copy of the topography map showing the well location. I the undersigned, hereby certify this data is correct to the best of my knowledge and belief and shows all the information required by law and the regulations issued and prescribed by the Office of Oil and Gas.		
M/Hm Operations Manager Z151/8		
Signature	Title	Date

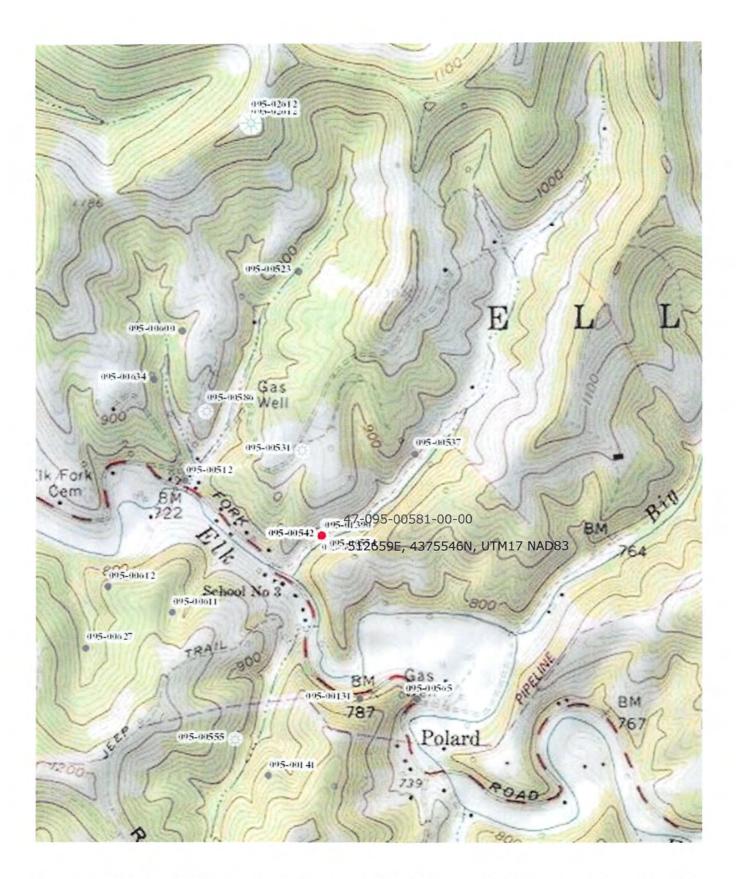

 $http://deparcgis1/ooggis/index.html?x = 512659 \& y = 4375546 \& datum = NAD83 \& pntlabel = 4... \\ \hspace*{0.2cm} 4/17/2019 = 4/17/2019 + 4/17/2019 = 4/17/2019 + 4/17/2019 = 4/17/2019 + 4/17/2019 = 4/17/$