

LATITUDE 39° 27' 30"



LONGITUDE 89° 40' 00"

7.5 OGIS topo location

7.5' 10C	<u>0.59 S</u>	15' 10C	<u>3,475</u>
	<u>1.56 W</u>	(calc.)	<u>1.56 W</u>

Company \_\_\_\_\_

Farm \_\_\_\_\_

Quad CENTER POINT 7 1/2' + 15' NW


County TYLER

District McELROY

WELL LOCATION MAP

File No. 095 - 596

(095)

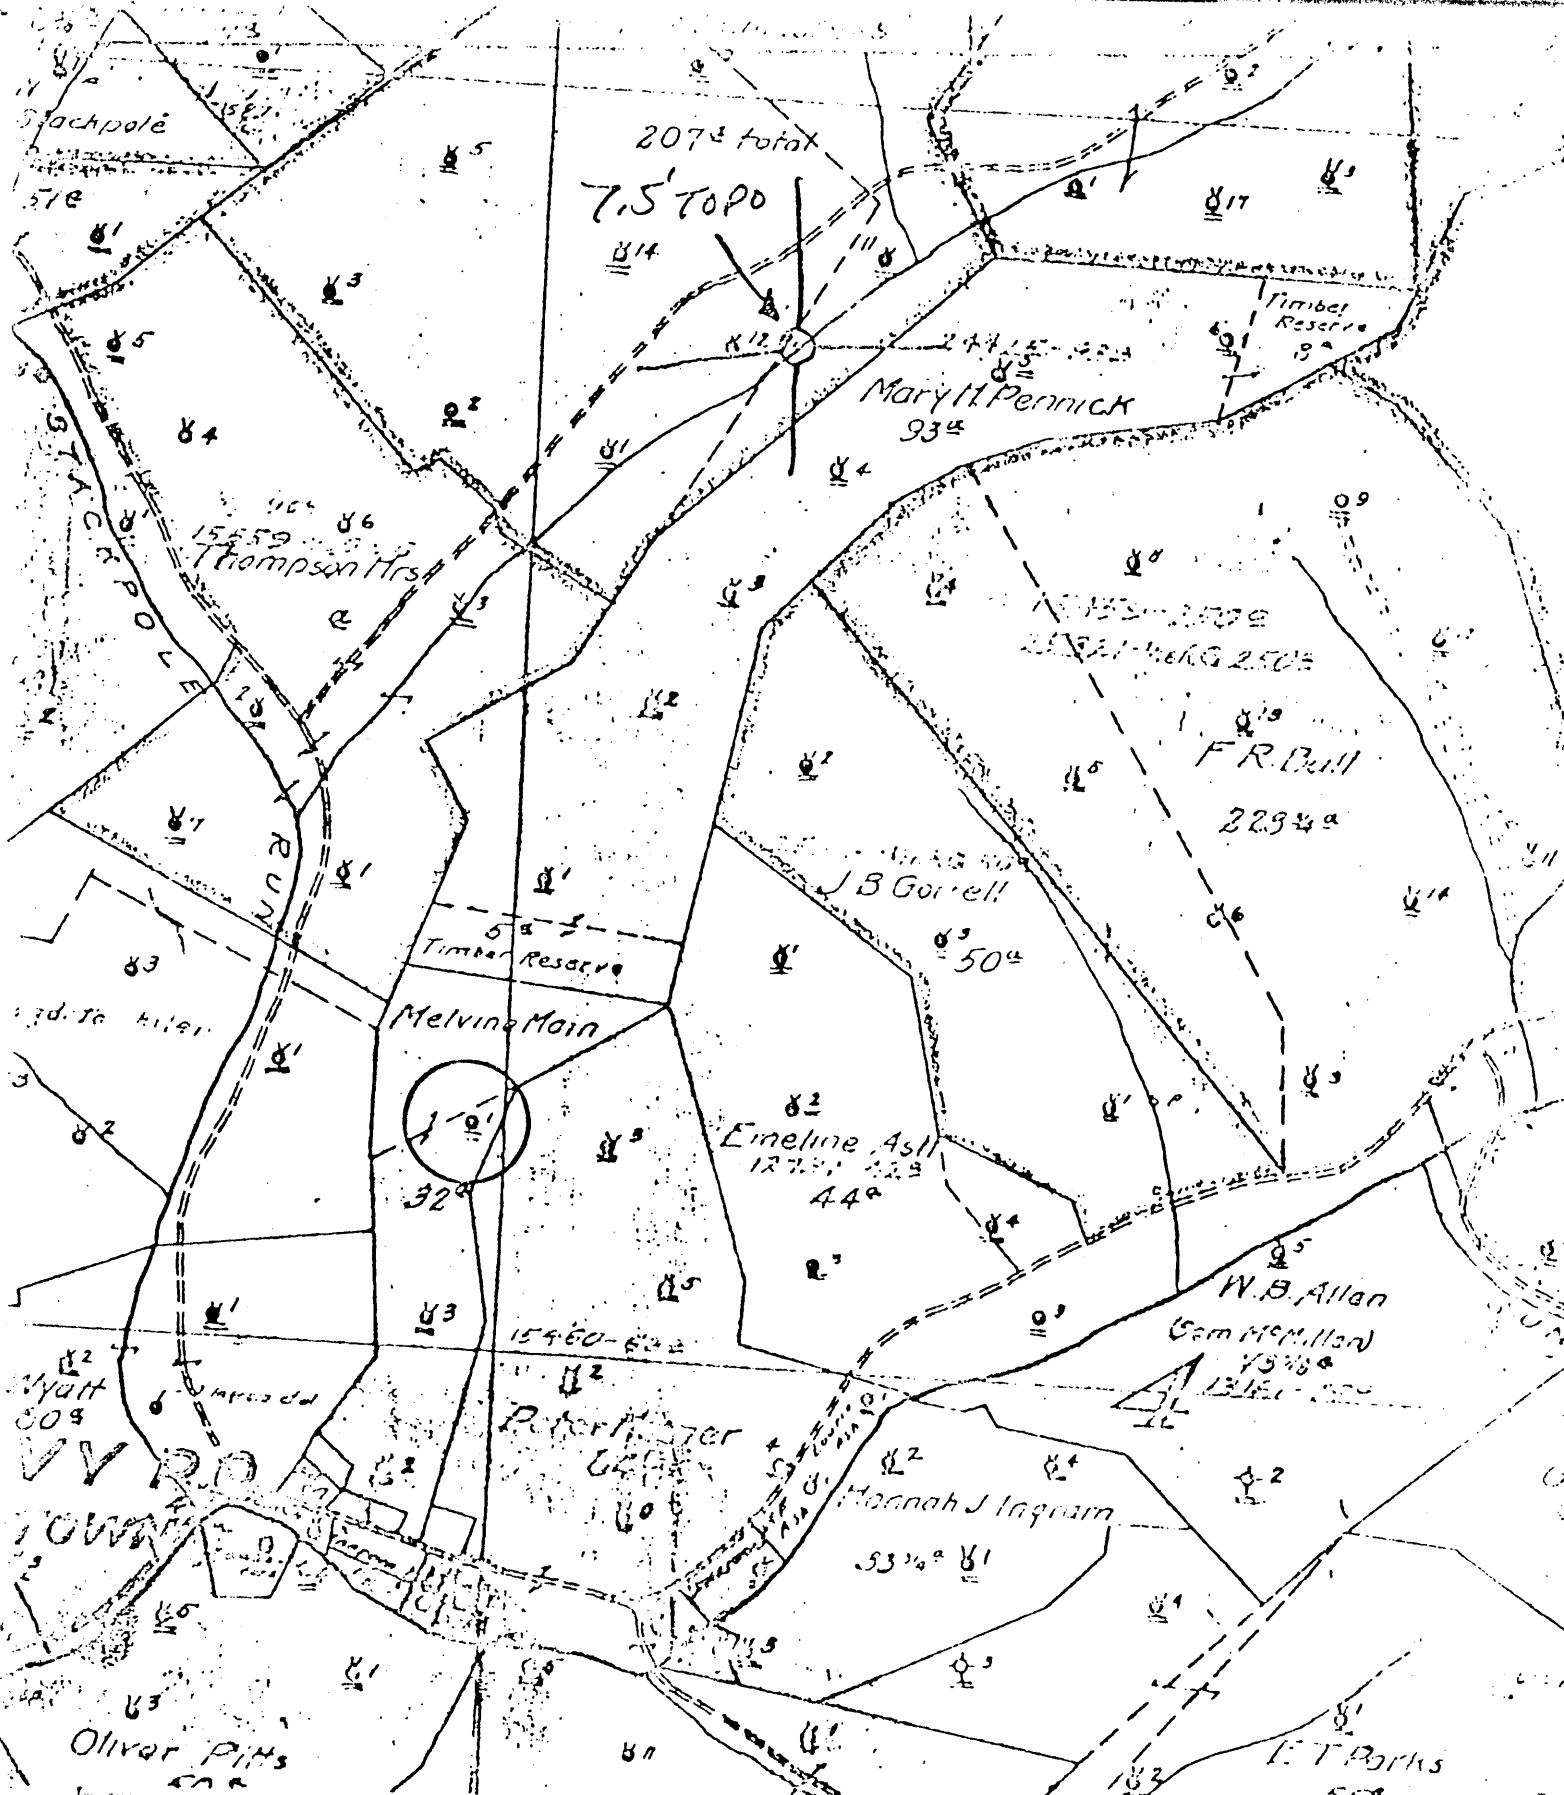

(+) DENOTES LOCATION OF WELL ON UNITED STATES TOPOGRAPHIC MAPS

FORM IV-6  
(8-78)  
**N47 S1W5**



DATE 1-23-  
OPERATOR'S WELL NO. 47-095-0596  
WELL NO. 47-095-0596  
STATE COUNTY TYLER

STATE OF WEST VIRGINIA  
DEPARTMENT OF MINES  
OIL AND GAS DIVISION

WELL TYPE:  OIL & GAS  LIQUID INJECTION  WASTE DISPOSAL  
(IF "GAS", PRODUCTION  STORAGE  DEEP  SHALLOW  
LOCATION: ELEVATION 1142.47 WATER SHED INDIAN CK  
DISTRICT MCKEY COUNTY TYLER  
QUADRANGLE CENTER POINT 7.5  
SURFACE OWNER \_\_\_\_\_ ACREAGE \_\_\_\_\_  
OIL & GAS ROYALTY OWNER \_\_\_\_\_ ACREAGE \_\_\_\_\_  
LEASE NO. \_\_\_\_\_ LEASE ACREAGE \_\_\_\_\_  
PROPOSED WORK: DRILL  CONVERT  DRILL DEEPER  REDRILL  FRACTURE OR STIMULATE  PLUS OFF OLD FORMATION  PERFORATE NEW FORMATION  OTHER PHYSICAL CHANGE IN WELL (SPECIFY) \_\_\_\_\_

PLUG AND ABANDON  CLEAN OUT AND REPLUG   
TARGET FORMATION \_\_\_\_\_ ESTIMATED DEPTH \_\_\_\_\_  
WELL OPERATOR Pennzoil Company DESIGNATED AGENT James A. Crews  
ADDRESS P. O. Box 1588 ADDRESS P. O. Box 1588  
Parkersburg, WV 26101 Parkersburg, WV 26101

Melvina Main

NO. 1

SOUTH PENN OIL COMPANY--COMPLETION

SERIAL NO. \_\_\_\_\_ FARM Melvina Main. WELL NO. 1.  
 ELEVATION 1142 N. 1. S. \_\_\_\_\_ E. \_\_\_\_\_ W. 5.  
 LEASE NO. \_\_\_\_\_ ACRES 32.  
 WATERS OF Indian Creek.  
 DISTRICT McElroy, COUNTY Taylor, STATE W. Va.  
 DRILLING COMMENCED 12/14-1896 COMPLETED 4/14-1897 DEPTH 3038'

SANDS	TOP	BOTTOM	ELEV. TOP	CASING
<del>PCH. COAL</del>	245'			10" 514'
Big Injun Sand	2260'	2395'		8 1/2" 1546'
Stray Sand.	3008'	3023'		6-5/8" 1868'
Gordon Sand.	3023'	3036'		5-3/16" 2434'
				4" 273'

INITIAL PROD. 50 Bbls. SAND Stray & Gordon, DEPTH 3093'

GAS TEST  
 SHOT 9/21-1899 QUARTS 30. 10/29-1901--20qts, 12/27-1912--  
 REMARKS 100qts.

Oil in Stray Sand at 3013' Oil in Gordon Sand at 3026'  
 REPORTED BY Piney District. ABANDONED.

47-095-0596