

STATE OF WEST VIRGINIA
DEPARTMENT OF ENVIRONMENTAL PROTECTION
OFFICE OF OIL AND GAS

AFFIDAVIT OF PLUGGING AND FILLING WELL

AFFIDAVIT SHOULD BE IN TRIPPLICATE, one copy mailed to the Department, one copy to be retained by the Well Operator and the third copy (and extra copies if required) should be mailed to each coal operator at their respective addresses.

Farm name: Betty Marie Moore Operator Well No.: #2

LOCATION: Elevation: 873 1/4 Quadrangle: Middlebourne, West Union 15'

District: Meade County: Tyler

Latitude: _____ Feet South of 39 Deg. 25 Min. 00 Sec.

Longitude: _____ Feet West of 39 Deg. 24 Min. 19.40 Sec.

Well Type: OIL GAS

Company Sancho Oil & Gas Coal Operator _____
P.O Box 179 or Owner _____
St. Mary's, WV 26170 _____
Agent Loren Bagley Coal Operator _____
Permit Issued Date 10/22/2013 or Owner _____

AFFIDAVIT

STATE OF WEST VIRGINIA,
County of Wood ss:

Patchwork Oil & Gas, LLC and Roger L. Whited being first duly sworn according to law depose and say that they are experienced in the work of plugging and filling oil and gas wells and were employed by the above named well operator, and participated in the work of plugging and filling the above well say that said work was commenced on the 12 day of November, 2013, and the well was plugged and filled in the following manner:

TYPE	FROM	TO	PIPE REMOVED	LEFT
13"	Surface to	250	NONE	250'
8 5/8	Surface to	896	NONE	896'
4 1/2	Surface to	2970'	696	696'

Received

JAN 21 2014

Description of monument: Name, API, Company, and date plugged
said well was completed on the 6 day of December, 2013.


Office of Oil and Gas
and the work of plugging and filling

And further deponents saith not. Patchwork Oil & Gas, LLC

Roger L. Whited

Sworn and subscribe before me this 2 day of January, 2014

[Signature]
1-13-14

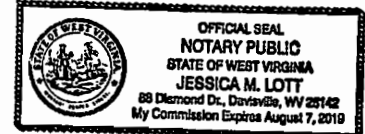

My commission expires: Aug. 7, 2019

J. M. Lott
Notary Public

01/24/2014

Affidavit reviewed by the Office of Oil and Gas: _____ Title: _____


8 5/8 Casing*
4 1/2 Tubing

B. Moore #2
API: 47-095-0693

Cement Gel is mixed to state standards
10.5 bags of gel 135 bags of cement

NOT TO SCALE

Surface

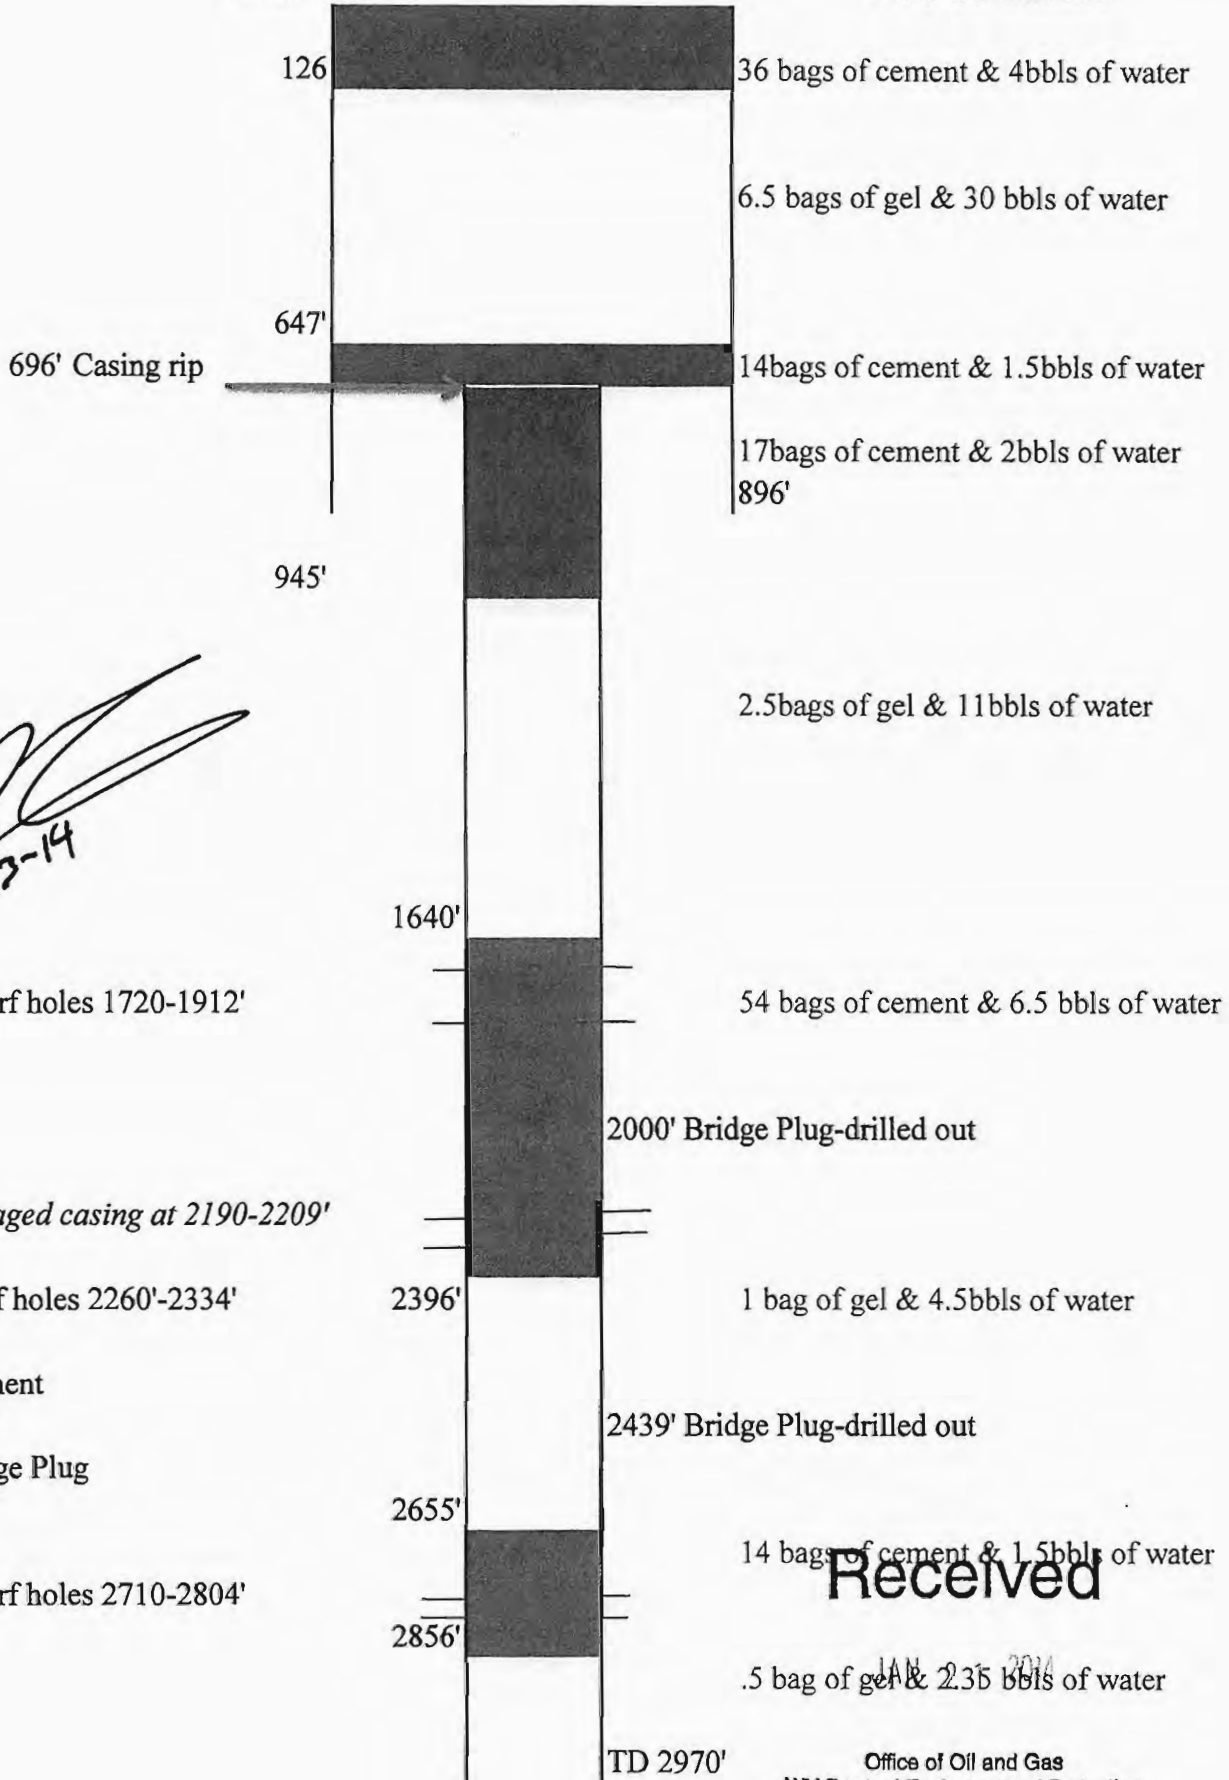

[Handwritten signature]
1-13-14

13 perf holes 1720-1912'

Damaged casing at 2190-2209'

9 Perf holes 2260'-2334'

26 perf holes 2710-2804'

█ : Cement
○ : Gel
— : Bridge Plug

Received

Office of Oil and Gas
WV Dept. of Environmental Protection

01/24/2014