


Note: This plot is redrawn from the original plat (Tyl-125-A) by J. S. Hought, Tyler County Surveyor, dated 1-12-37.

FILE NO. _____
 DRAWING NO. _____
 SCALE 1" = 800'
 MINIMUM DEGREE OF ACCURACY _____
 PROVEN SOURCE OF ELEVATION _____

I THE UNDERSIGNED, HEREBY CERTIFY THAT THIS PLAT IS CORRECT TO THE BEST OF MY KNOWLEDGE AND BELIEF AND SHOWS ALL THE INFORMATION REQUIRED BY LAW AND THE REGULATIONS ISSUED AND PRESCRIBED BY THE DEPARTMENT OF MINES.

(SIGNED) Curtis A. Lucas
 R.P.E. _____ L.L.S. 275

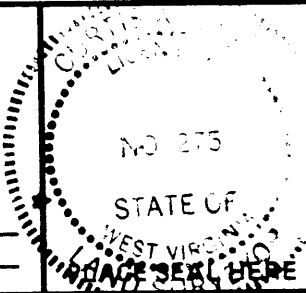

STATE OF WEST VIRGINIA
 DEPARTMENT OF MINES
 OIL AND GAS DIVISION



DATE Mar. 27, 1984
 OPERATOR'S WELL NO. 2-A
 API WELL NO. _____
47 - 095 - 1037-R-P
 STATE COUNTY PERMIT

(+) DENOTES LOCATION OF WELL ON UNITED STATES TOPOGRAPHIC MAPS
 WELL TYPE: OIL ___ GAS ___ LIQUID INJECTION ___ WASTE DISPOSAL ___
 (IF "GAS,") PRODUCTION ___ STORAGE ___ DEEP ___ SHALLOW ___
 LOCATION: ELEVATION 867 WATER SHED Cranenest Run
 DISTRICT Ellsworth COUNTY Tyler
 QUADRANGLE New Martinsville 15' 415' SE

WVDEP database -
 comp. 05/19/1912

Kla 8/2/195

SURFACE OWNER Dallas Huggins ACREAGE _____
 OIL & GAS ROYALTY OWNER _____ LEASE ACREAGE _____
 LEASE NO. _____

PROPOSED WORK: DRILL ___ CONVERT ___ DRILL DEEPER ___ REDRILL ___ FRACTURE OR
 STIMULATE ___ PLUG OFF OLD FORMATION ___ PERFORATE NEW
 FORMATION ___ OTHER PHYSICAL CHANGE IN WELL (SPECIFY) _____

PLUG AND ABANDON ___ CLEAN OUT AND REPLUG X
 TARGET FORMATION _____ ESTIMATED DEPTH 1800'
 WELL OPERATOR PERKINS OIL & GAS INC DESIGNATED AGENT DARREL PERKINS
 ADDRESS RT. 2 0675 ADDRESS RT. 2
PENNSBORO, W. V. 26415 PENNSBORO, W. V. 26415

APR 9 1984

AFFIDAVIT OF PLUGGING AND FILLING WELL

AFFIDAVIT SHOULD BE MADE IN TRIPLICATE, one copy mailed to the Department, one copy to be retained by the Well Operator and the third copy (and extra copies if required) should be mailed to each coal operator at their respective addresses.

None
Coal Operator or Owner

None
Address

None
Coal Operator or Owner

Dallas Huggins
Address
Lease or Property Owner
110 Laboume, W
Address

Perkins Oil and Gas, Inc.
Name of Well Operator

Route 2, Tenneco, W 25173
Complete Address

19 84
WELL AND LOCATION

Ellsworth District

Tyler County

WELL NO. 2-1

Dallas Huggins Farm

STATE INSPECTOR SUPERVISING PLUGGING Robert Leuter

AFFIDAVIT

STATE OF WEST VIRGINIA,
County of Mitchell ss:

Donald Paul Kinney and Ray Ben Garner

being first duly sworn according to law depose and say that they are experienced in the work of plugging and filling oil and gas wells and were employed by Perkins Oil and Gas, Inc., well operator, and participated in the work of plugging and filling the above well, that said work was commenced on the 13th day of April, 19 84, and that the well was plugged and filled in the following manner:

| Sand or Zone Record | Filling Material | Plugs Used | Casing | |
|------------------------|--|---------------------------|------------|-------------|
| | | | CSG PULLED | CSG LEFT IN |
| Formation | | Size & Kind | | |
| Line and sand | Cement 1500-1600 | | 25.8 | 0 |
| Inside pipe | Aqua Gel 1075-1075 Cement 1175-1075 | | 12 | 1519 |
| | Aqua Gel 1075-1070 | | | |
| No record of formation | Cement 875-370 Aqua Gel 370-170 Cement 175-10 Red Clay 40-10 Cement 10-0 | | | |
| | All plugs set with the approval of the State Inspector. | | | |
| Coal Seams | | Description of Monument | | |
| (Name) <u>None</u> | | 10" conductor pipe | | |
| (Name) | | with 5" pipe cemented in. | | |
| (Name) | | | | |
| (Name) | | | | |

RECEIVED
MAY 16 1984
OIL & GAS DIVISION
DEPT. OF MINES

and that the work of plugging and filling said well was completed on the 20th day of April, 19 84.

And further deponents saith not.

Sworn to and subscribed before me this 11th day of May, 19 84.

Donald P. Kinney

Ray Ben Garner

Daryl L. Perkins
Notary Public

My commission expires:

April 10, 1994

Permit No. 87-095-1037-P