

LATITUDE

39 27 30

80 4 230

LONGITUDE

\* 2.77  
0.75

7'5 OGIS topo location

7.5' loc \_\_\_\_\_ 15' loc 5.655  
\_\_\_\_\_ (calc.) 2.984

Company \_\_\_\_\_

Farm \_\_\_\_\_

Quad Centerpoint + 15' NW

County \_\_\_\_\_


District \_\_\_\_\_

WELL LOCATION MAP

File No. 095-1455

INSTRUCTIONS

- 1) Attach a photo copy of the location of the well on a 7.5 minute Quadrangle with the corresponding Longitude and Latitude.
- 2) Designate the location of the well with the symbol (+).

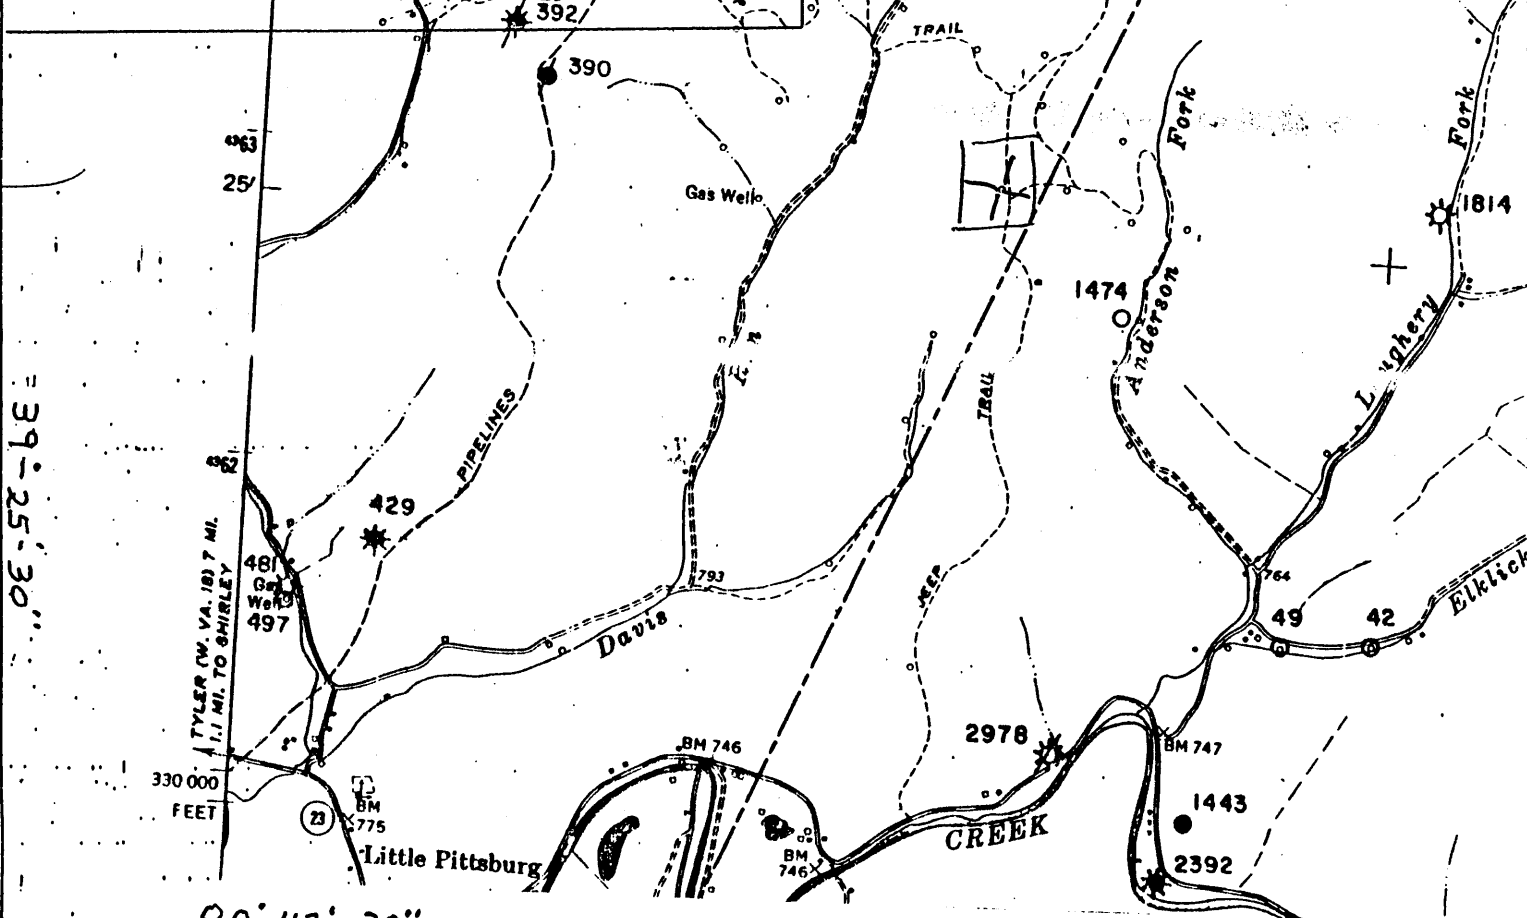

I, the undersigned, Hereby certify that this plat is correct to the best of my knowledge and belief.

SIGNED Charles E. Anderson

TITLE VICE PRESIDENT

DATE AUGUST 21, 1990

OPERATORS WELL NO. 1

API WELL NO. 095-1455

STATE OF WEST VIRGINIA  
DEPARTMENT OF ENERGY  
OIL AND GAS DIVISION

WELL TYPE: OIL  GAS  LIQUID INJECTION  WASTE DISPOSAL   
(i.e. "GAS" PRODUCTION  STORAGE  DEEP  SHALLOW

LOCATION: ELEVATION 1340 WATER SHED DAVIS RUN  
DISTRICT MCELORY COUNTY TYLER  
QUADRANGLE CENTERPOINT

SURFACE OWNER UNKNOWN ACREAGE 50

OIL & GAS ROYALTY OWNER ELISHA UNDERWOOD HEIRS LEASE ACREAGE 50  
LEASE NO. 5

PRODUCING FORMATION BIG INJUN TOTAL DEPTH 2000

WELL OPERATOR DILMUR OIL COMPANY DESIGNATED AGENT CHARLES E. ANDERSON  
CENTERPOINT STAR ROUTE BOX 165  
ADDRESS WEST UNION, W.Va. 26456 ADDRESS SAME

Elisha Underwood - Tyler