

MIDDLEBOURNE QUADRANGLE

WEST VIRGINIA

7.5 MINUTE SERIES (TOPOGRAPHIC)

NW 4 WEST UNION 15' QUADRANGLE

(PORTERS FALLS)

LATITUDE 39°30'00"


SISTERSVILLE 1W VA. 21 11 MI
KIDWELL 3.8 MI

5000

1 610 000 FEET

80°52'30"

39°30'

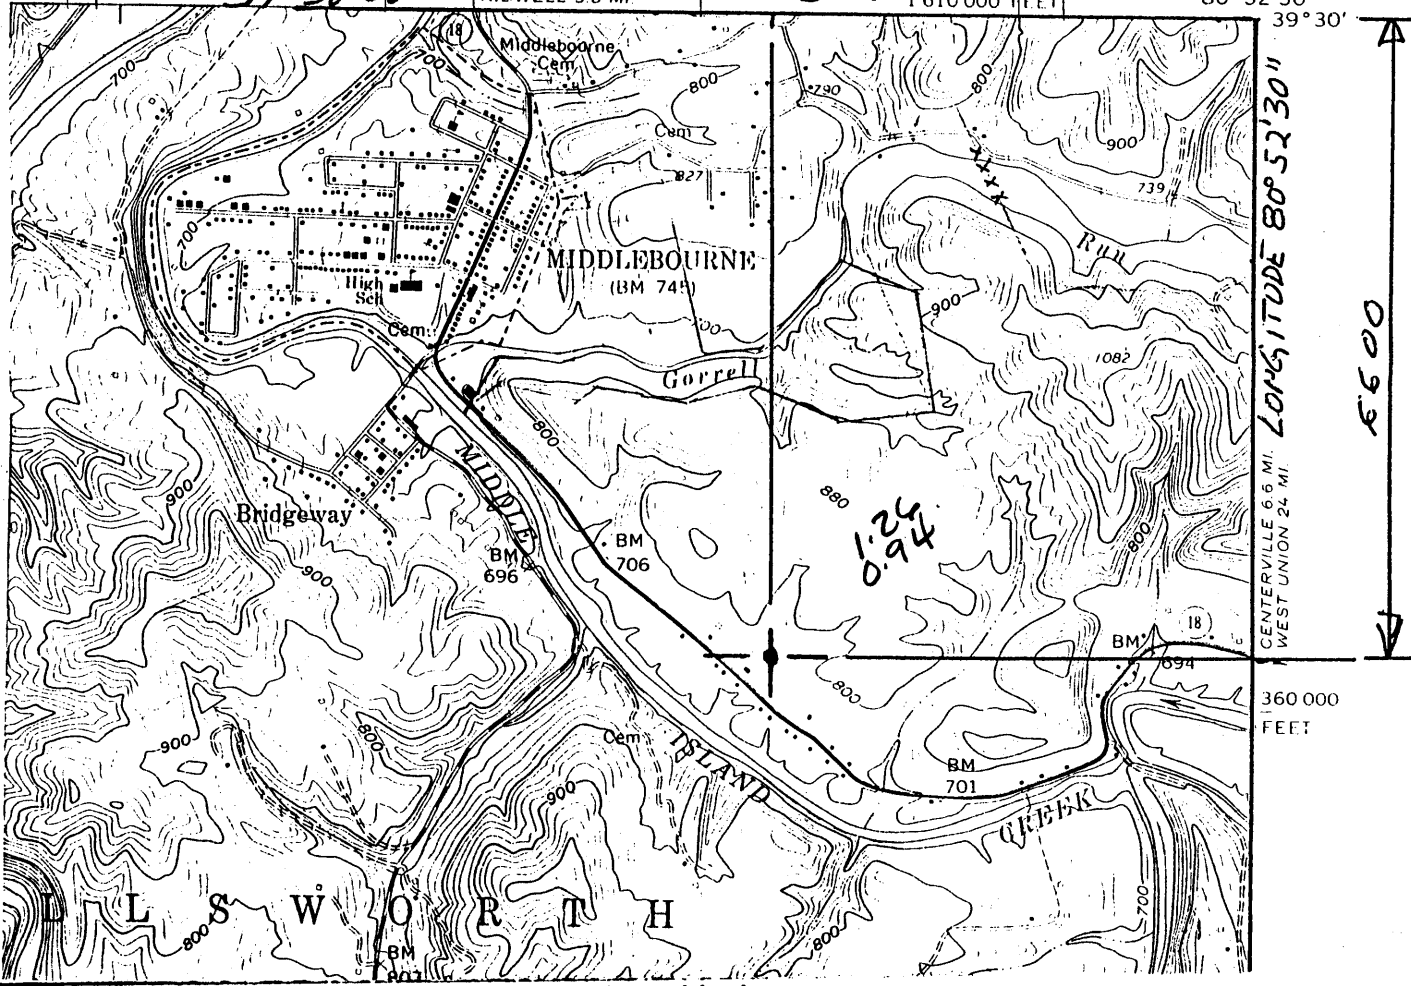

CENTERVILLE 6.6 MI.
WEST UNION 24 MI.

6600


360 000 FEET

I, the undersigned, hereby certify that this plat is correct to the best of my knowledge and belief.

calc 15 loc
1.265
3.17W

SIGNED James F. Heathorn
TITLE Owner

17834

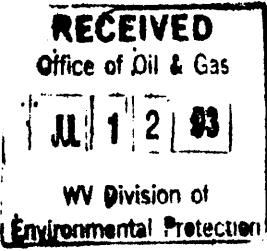

DATE July 6, 1993
OPERATORS WELL NO. 1
API WELL NO. 095-1552-N


STATE OF WEST VIRGINIA
DEPARTMENT OF ENERGY
OIL AND GAS DIVISION

WELL TYPE: OIL GAS LIQUID INJECTION WASTE DISPOSAL
TYPE "GAS" PRODUCTION STORAGE DEEP SHALLOW

LOCATION: ELEVATION 470 WATER SHED West Union nc
DISTRICT Ellsworth V COUNTY Tyler
QUADRANGLE Middlebourne

SURFACE OWNER _____ ACREAGE _____
OIL & GAS ROYALTY OWNER _____ LEASE ACREAGE _____
LEASE NO. _____

PRODUCING FORMATION Enginer TOTAL DEPTH 1600 Approx.
WELL OPERATOR James F. Heathorn DESIGNATED AGENT _____
ADDRESS Route 1, Box 326 ADDRESS _____
Middlebourne WV, 26149 _____
AUG 23 1993

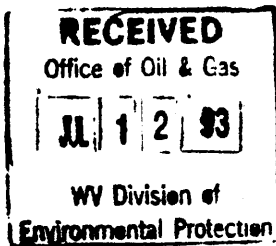

BF-1

BONA FIDE FUTURE USE

OPERATOR: James F. Heathorn ID NO. 21955 BONDED? No
API NO. 095-1552-N FARM NAME: Heathorn WELL NO. 1
DATE WELL FIRST PRODUCED? 1920 Approx. DATE WELL LAST PRODUCED? 1990

To avoid having a well deemed abandoned under West Virginia Code 22B-1-19 the Operator must file with the Director a designation of bona fide future use. To establish an inactive status through bona fide future use the operator, at a minimum, shall complete those questions below to assure the Director that said well is environmentally sound. Also, attach a cover letter detailing the bona fide future use and address any information which may be deemed appropriate under Title 38 Series 21 to support such bona fide future use. Attach a copy of the well record to this form.

What amount of pressure is on the production casing and its annulus?

15#

Presence of any leaks at or near the well?

No

What is the pressure rating of the wellhead valve(s) and when were they last tested?

How much oil and/or waste product is being stored on location? Are the holding facilities diked?

None, No Tank on Lease

Has money been escrowed for use to plug the well?

No

What is the schedule for putting the well into production?

Plans To Install Tank and start production By
End of 1993.

STATE OF WEST VIRGINIA
DIVISION OF ENVIRONMENTAL PROTECTION
SECTION OF OIL AND GAS

WELL REGISTER ASSIGNMENT

This API Number 47- 95-01552, issued to HENTHORN, JAMES F. is evidence of permission to operate the well that is referenced at the location described on the attached plat, subject to the provisions of Chapters 22 and 22B of the West Virginia Code of 1931, as amended, and all rules and regulations promulgated thereunder. The name and telephone number of the Oil and Gas Inspector for this well is MIKE UNDERWOOD - 304-782-1043.

Spills or emergency discharges must be reported to 1-800-654-3312.

Failure to abide by all statutory and regulatory provisions governing all duties and operations hereunder may result in suspension or revocation of your permits and in addition may result in civil and/or criminal penalties.

The enclosed WR-35 must be completed by you and returned to this office. In addition annual production reports must be submitted on this well and failure to do so may require you to plug the well.

Theodore M. Streit
Chief

By: 

Title: _____

Operator's Well No: HENTHORN #1

Farm Name: HENTHORN, JAMES F.

API Well Number : 47- 95-01552 N

Date Issued : 08/13/93