

I, the undersigned, hereby certify that this plat is correct to the best of my knowledge and belief.

SIGNED Lowell A Bee
 TITLE President

RECEIVED

WV Division of Environmental Protection

OCT 08 93

Permitting Office of Oil & Gas

DATE August 2, 1993
 OPERATORS WELL NO. FORRESTAL # 635
 API WELL NO. 095-1578-N

STATE OF WEST VIRGINIA
 DEPARTMENT OF ENERGY
 OIL AND GAS DIVISION

WAD: 70131

WELL TYPE: OIL GAS LIQUID INJECTION _____ WASTE DISPOSAL _____
 (IE "GAS" PRODUCTION _____ STORAGE _____ DEEP _____ SHALLOW

LOCATION: ELEVATION 1060 (S) WATER SHED Big Run
 DISTRICT McELROY COUNTY TYLER
 QUADRANGLE SHIRLEY 607 West Union NE

SURFACE OWNER HAROLD WARNER ACREAGE 32
 OIL & GAS ROYALTY OWNER _____ LEASE ACREAGE 32
 LEASE NO. 4-2669


PRODUCING FORMATION Big INJUN TOTAL DEPTH 2120

WELL OPERATOR BEECHLICK OIL, INC. DESIGNATED AGENT Lowell A BEE

ADDRESS RT 3 Box 26 ADDRESS RT 3 Box 62
SALEM, WV 26426 SALEM, WV 26426
304-782-3963

Section 6

18128

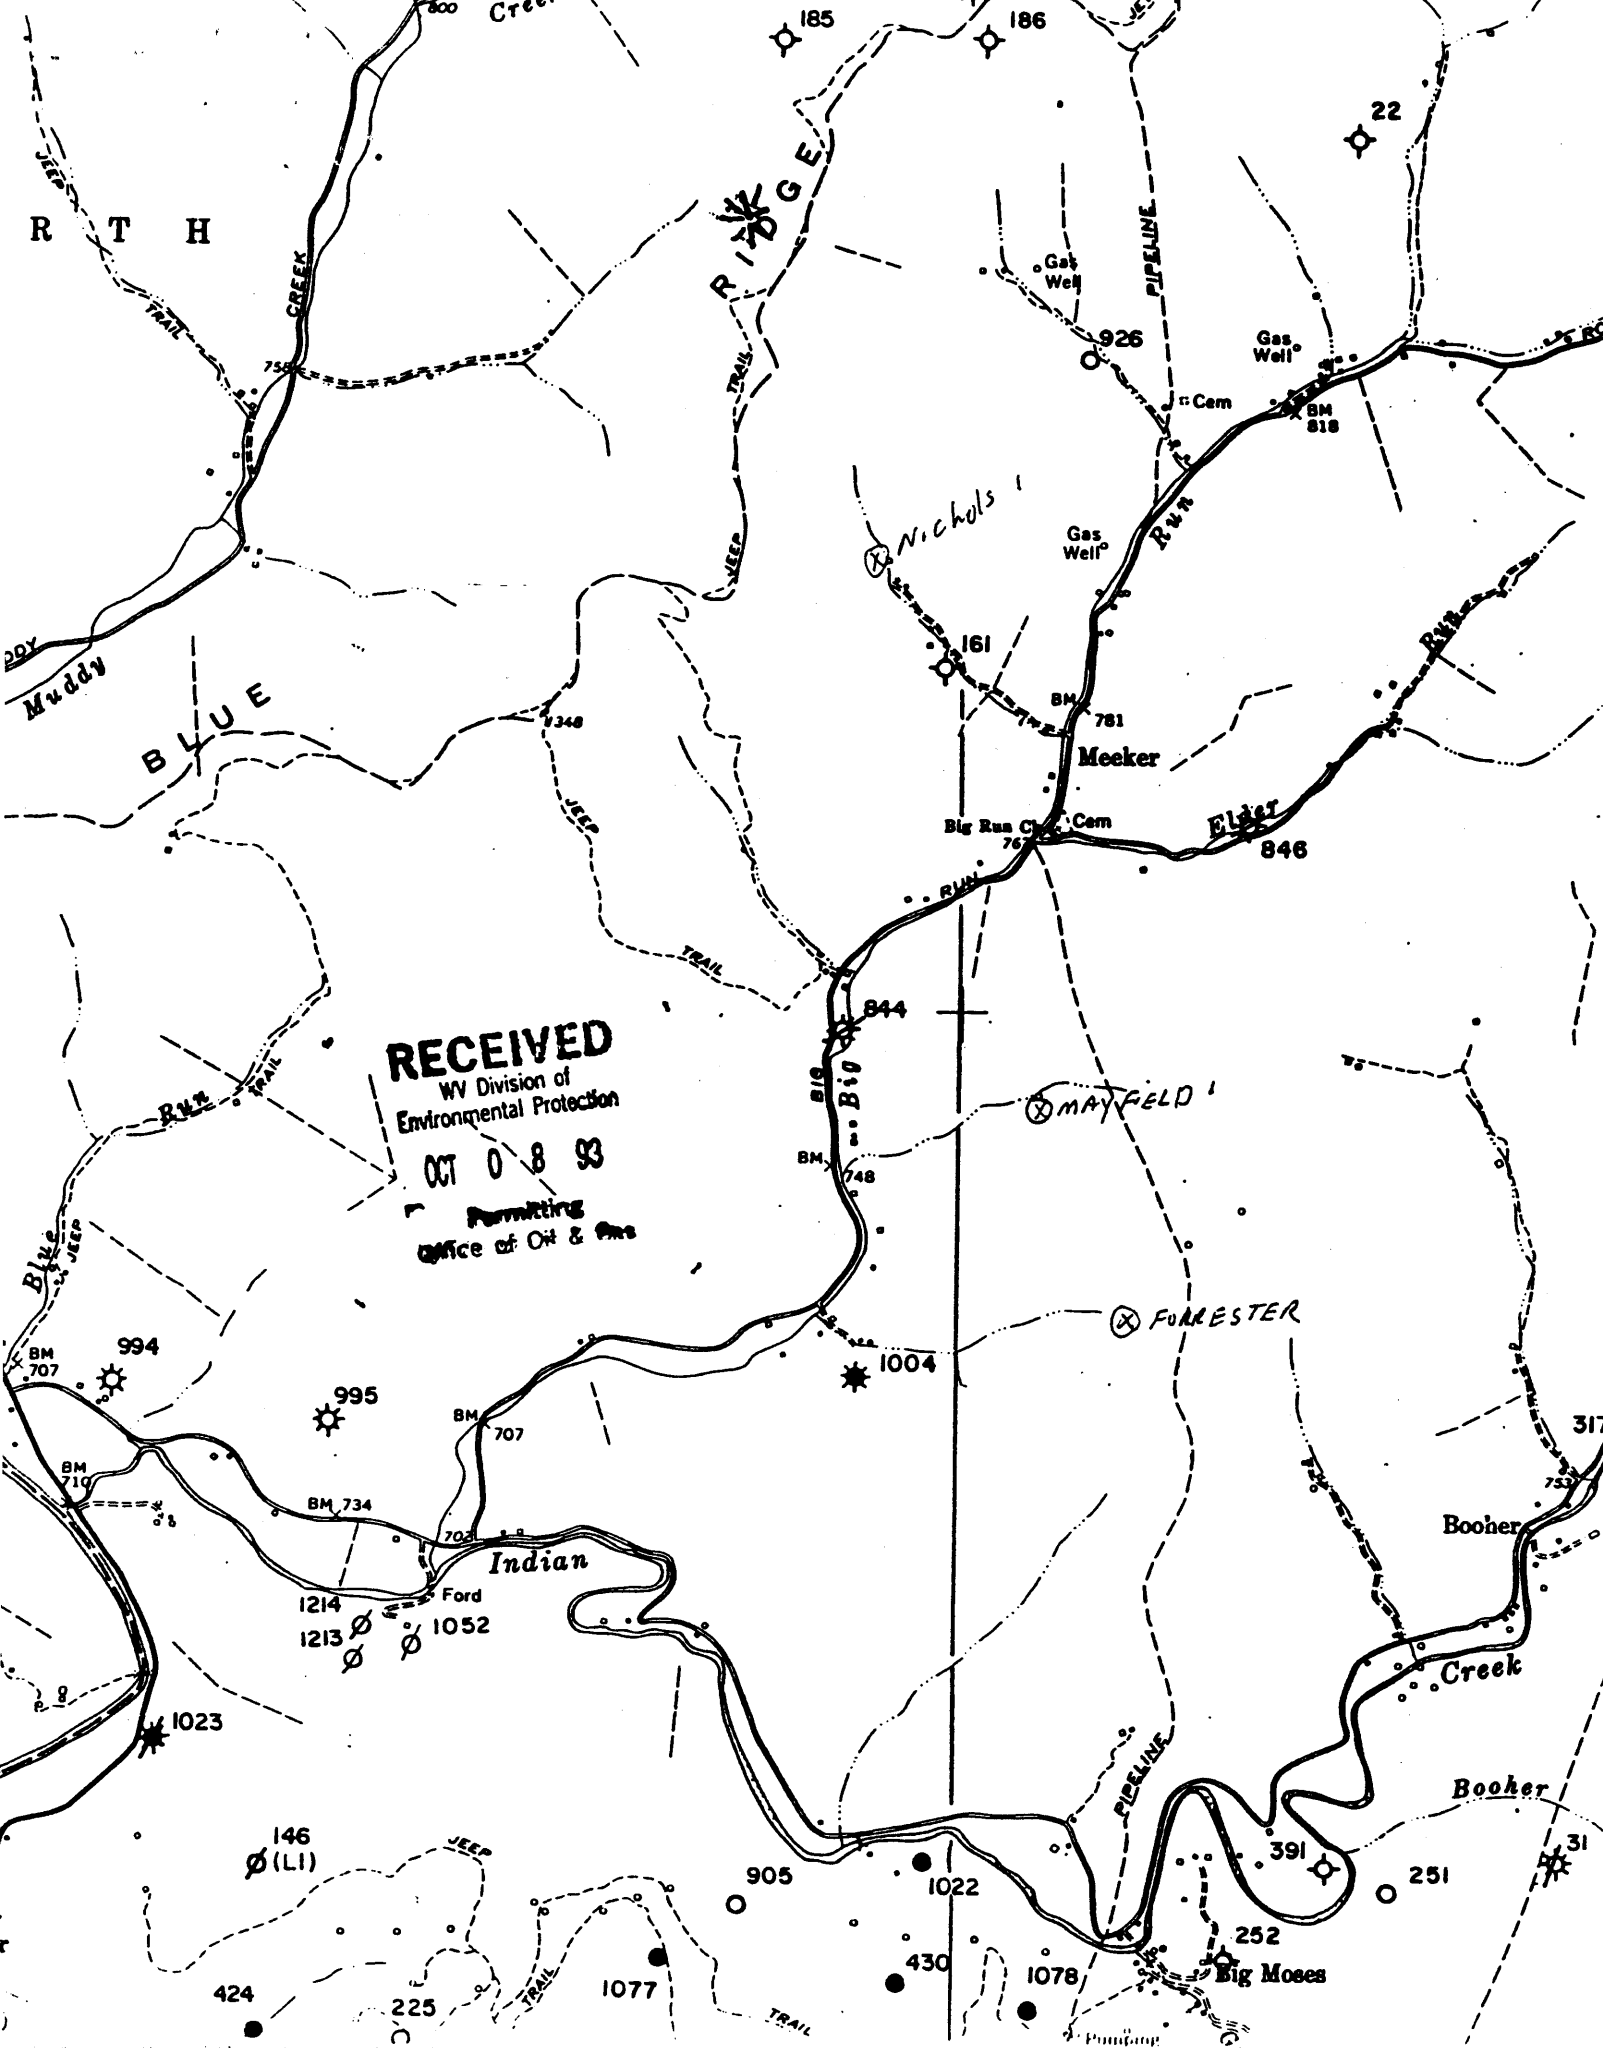

STATE OF WEST VIRGINIA
DIVISION OF ENVIRONMENTAL PROTECTION
SECTION OF OIL AND GAS

WELL REGISTER ASSIGNMENT

This API Number 47- 95-01578, issued to BEECHLICK OIL, INC. is evidence of permission to operate the well that is referenced at the location described on the attached plat, subject to the provisions of Chapters 22 and 22B of the West Virginia Code of 1931, as amended, and all rules and regulations promulgated thereunder. The name and telephone number of the Oil and Gas Inspector for this well is MIKE UNDERWOOD - 304-782-1043.

Spills or emergency discharges must be reported to 1-800-654-3312.

Failure to abide by all statutory and regulatory provisions governing all duties and operations hereunder may result in suspension or revocation of your permits and in addition may result in civil and/or criminal penalties.

The enclosed WR-35 must be completed by you and returned to this office. In addition annual production reports must be submitted on this well and failure to do so may require you to plug the well.

Theodore M. Streit
Chief

By: 

Title: _____

Operator's Well No: FORRESTER #635

Farm Name: WARNER, HAROLD

API Well Number : 47- 95-01578 N

Date Issued : 02/07/94

MARY FORESTER NO. 1 (635) (1850?) WELL.

Gal. No. 324 (173)

1578

McElroy District, Tyler County, W. Va.
 Manufacturers Light & Heat Co.
 Elevation, 1045' ±.
 Completed in 1915.
 Oil well.
 On Big Run.

location on
 Shirley 7 1/2'

7

	Top.	Bottom.
Pittsburgh Coal	680	681
Little Dunkard Sand	1206	1235
Big Dunkard Sand	1280	1339
Salt Sand	1495	1670
Little Lime	1892	1908
Pencil Cave	1908	1916
Big Lime	1916	1981
Big Injun Sand (gas, 2086-87'; oil and gas, 2089-2093')	1981	
Total depth		2099