

39° 27' 30"

Latitude ✓

80° 45' 00"

Longitude

Topo Location

7.5' Loc.	<u>1.555</u>	15' Loc.	<u>4.435</u>
	<u>1.36W</u>	(calc.)	<u>1.36W</u>

Company Quaker State Corp.
 Farm Amor Ash #1
 15' Quad West Union (NE)
 (sec.)
 7.5' Quad Shirley
 District Mc Elroy

WELL LOCATION PLAT


County 095 Permit 1585N

INSTRUCTIONS

LATITUDE 39° 27' 30"
(8,190' S)

LONGITUDE 80° 45'
(7,170' W)

- 1) Attach a photo copy of the location of the well on a 7.5 minute Quadrangle with the corresponding Longitude and Latitude.
- 2) Designate the location of the well with the symbol(+).

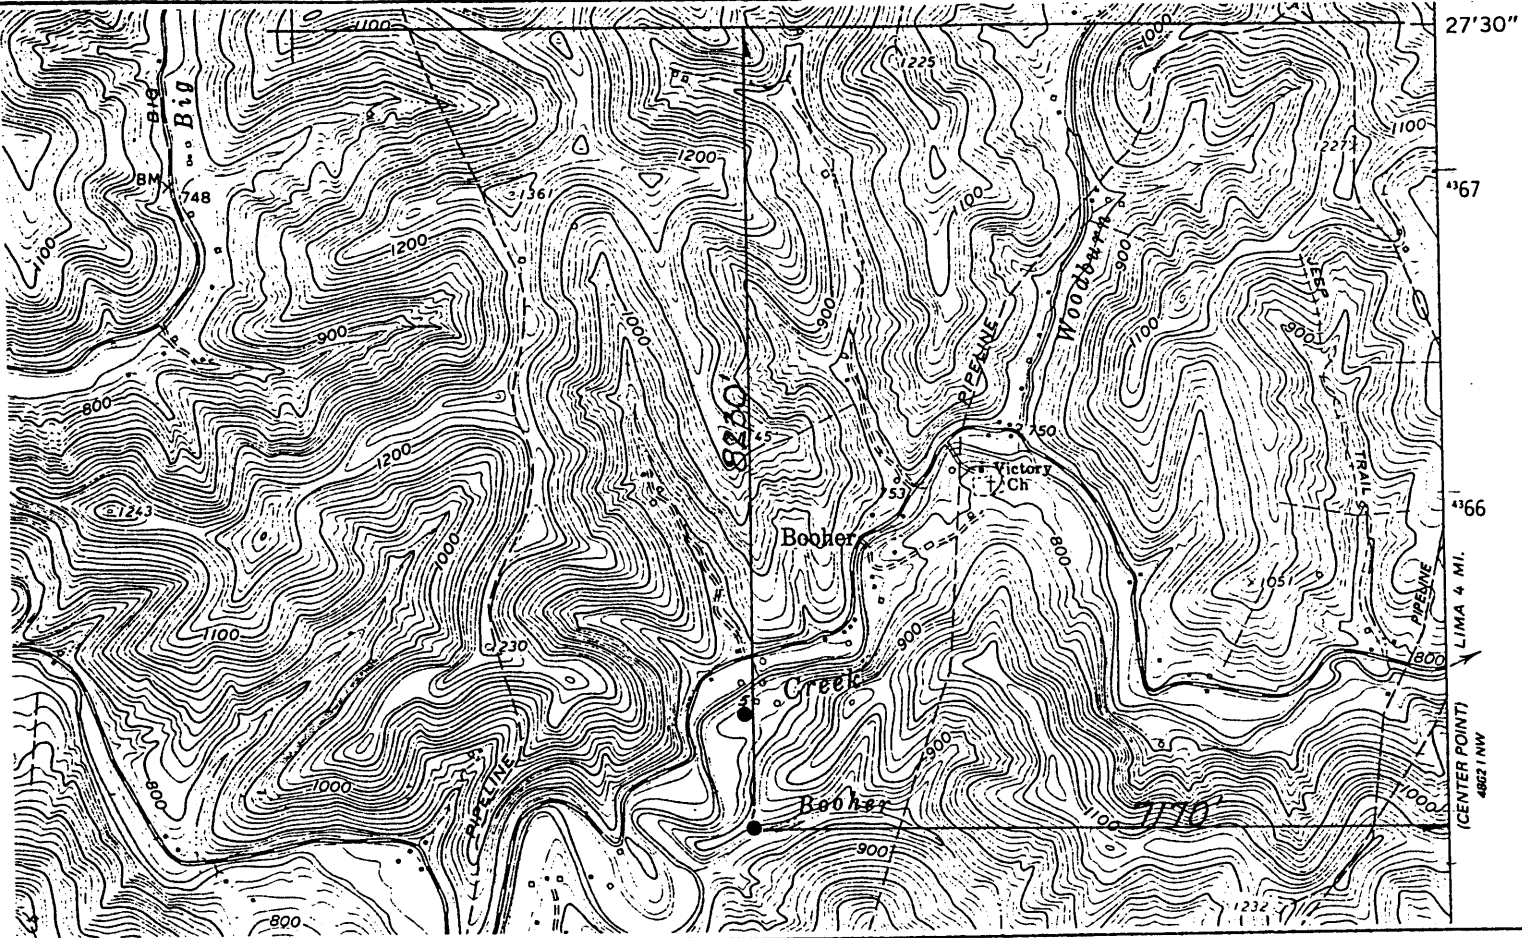

I, the undersigned, Hereby certify that this plat is correct to the best of my knowledge and belief.

SIGNED *Quaker*


TITLE District Manager

DATE December 1, 1993

OPERATORS WELL NO. Amos Ash #1

API WELL NO. 47-095-1585-N

18497

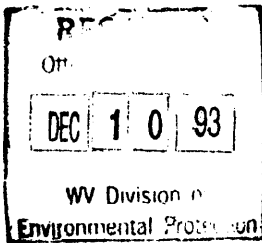

STATE OF WEST VIRGINIA
DEPARTMENT OF ENERGY
OIL AND GAS DIVISION

WELL TYPE: OIL GAS LIQUID INJECTION WASTE DISPOSAL
(IF "GAS" PRODUCTION STORAGE DEEP SHALLOW

LOCATION: ELEVATION 800 WATER SHED Booher Run of Indian Creek
DISTRICT McElroy COUNTY Tyler
QUADRANGLE Shirley 607

SURFACE OWNER Amos Ash ACREAGE 65

OIL & GAS ROYALTY OWNER N/A LEASE ACREAGE _____
LEASE NO. _____

PRODUCING FORMATION Big Injun Sand TOTAL DEPTH 1950'

WELL OPERATOR Quaker State Corporation DESIGNATED AGENT Frank Rotunda

ADDRESS 1226 Putnam Howe Drive ADDRESS P.O. Box 823
Belpre, OH 45714 Parkersburg, WV 26102

STATE OF WEST VIRGINIA
DIVISION OF ENVIRONMENTAL PROTECTION
SECTION OF OIL AND GAS

WELL REGISTER ASSIGNMENT

This API Number 47- 95-01585, issued to QUAKER STATE CORPORATION is evidence of permission to operate the well that is referenced at the location described on the attached plat, subject to the provisions of Chapters 22 and 22B of the West Virginia Code of 1931, as amended, and all rules and regulations promulgated thereunder. The name and telephone number of the Oil and Gas Inspector for this well is MIKE UNDERWOOD -
304-782-1043.

Spills or emergency discharges must be reported to 1-800-654-3312.

Failure to abide by all statutory and regulatory provisions governing all duties and operations hereunder may result in suspension or revocation of your permits and in addition may result in civil and/or criminal penalties.

The enclosed WR-35 must be completed by you and returned to this office. In addition annual production reports must be submitted on this well and failure to do so may require you to plug the well.

Theodore M. Streit
Chief

By: 

Title: _____

Operator's Well No: AMOS ASH #1

Farm Name: ASH, AMOS

API Well Number : 47- 95-01585 N

Date Issued : 03/10/94