

West Virginia Department of Environmental Protection  
Office of Oil & Gas

**WELL LOCATION FORM: GPS**

API: 47- 095 -01656 WELL NO: No.11

FARM NAME: Enoch McIntyre

RESPONSIBLE PARTY NAME: HG Energy, LLC

COUNTY: Tyler DISTRICT: McElroy

QUADRANGLE: Centerpoint 7.5'

SURFACE OWNER: Forrest Glover Jr.

ROYALTY OWNER: American Energy Partners LLC, et al.

UTM GPS NORTHING: 4,364,153

UTM GPS EASTING: 526,294 GPS ELEVATION: 426 m. (1397)

The Responsible Party named above has chosen to submit GPS coordinates in lieu of preparing a new well location plat for a plugging permit on the above well. The Office of Oil & Gas will not accept GPS coordinates that do not meet the following requirements:

1. Datum: NAD 1983, Zone:17 North, Coordinate Units: meters, Altitude: height above mean sea level (MSL) - meters.
2. Accuracy to Datum - 3.05 meters
3. Data Collection Method:

Survey Grade GPS	<input type="checkbox"/>	Post Processed Differential	<input type="checkbox"/>
		Real-Time Differential	<input type="checkbox"/>
Mapping Grade GPS	<input checked="" type="checkbox"/>	Post Processed Differential	<input checked="" type="checkbox"/>
		Real-Time Differential	<input type="checkbox"/>

I the undersigned, hereby certify this data is correct to the best of my knowledge and belief and shows all the information required by law and the regulations issued and prescribed by the Office of Oil and Gas.


Diane White Diane White  
Signature

February 19, 2015  
Date

Received  
Office of Oil & Gas  
Designated Agent  
Title

APR 29 2015

SUBJECT WELL  
Enoch McIntyre No. 11  
47-095-1656

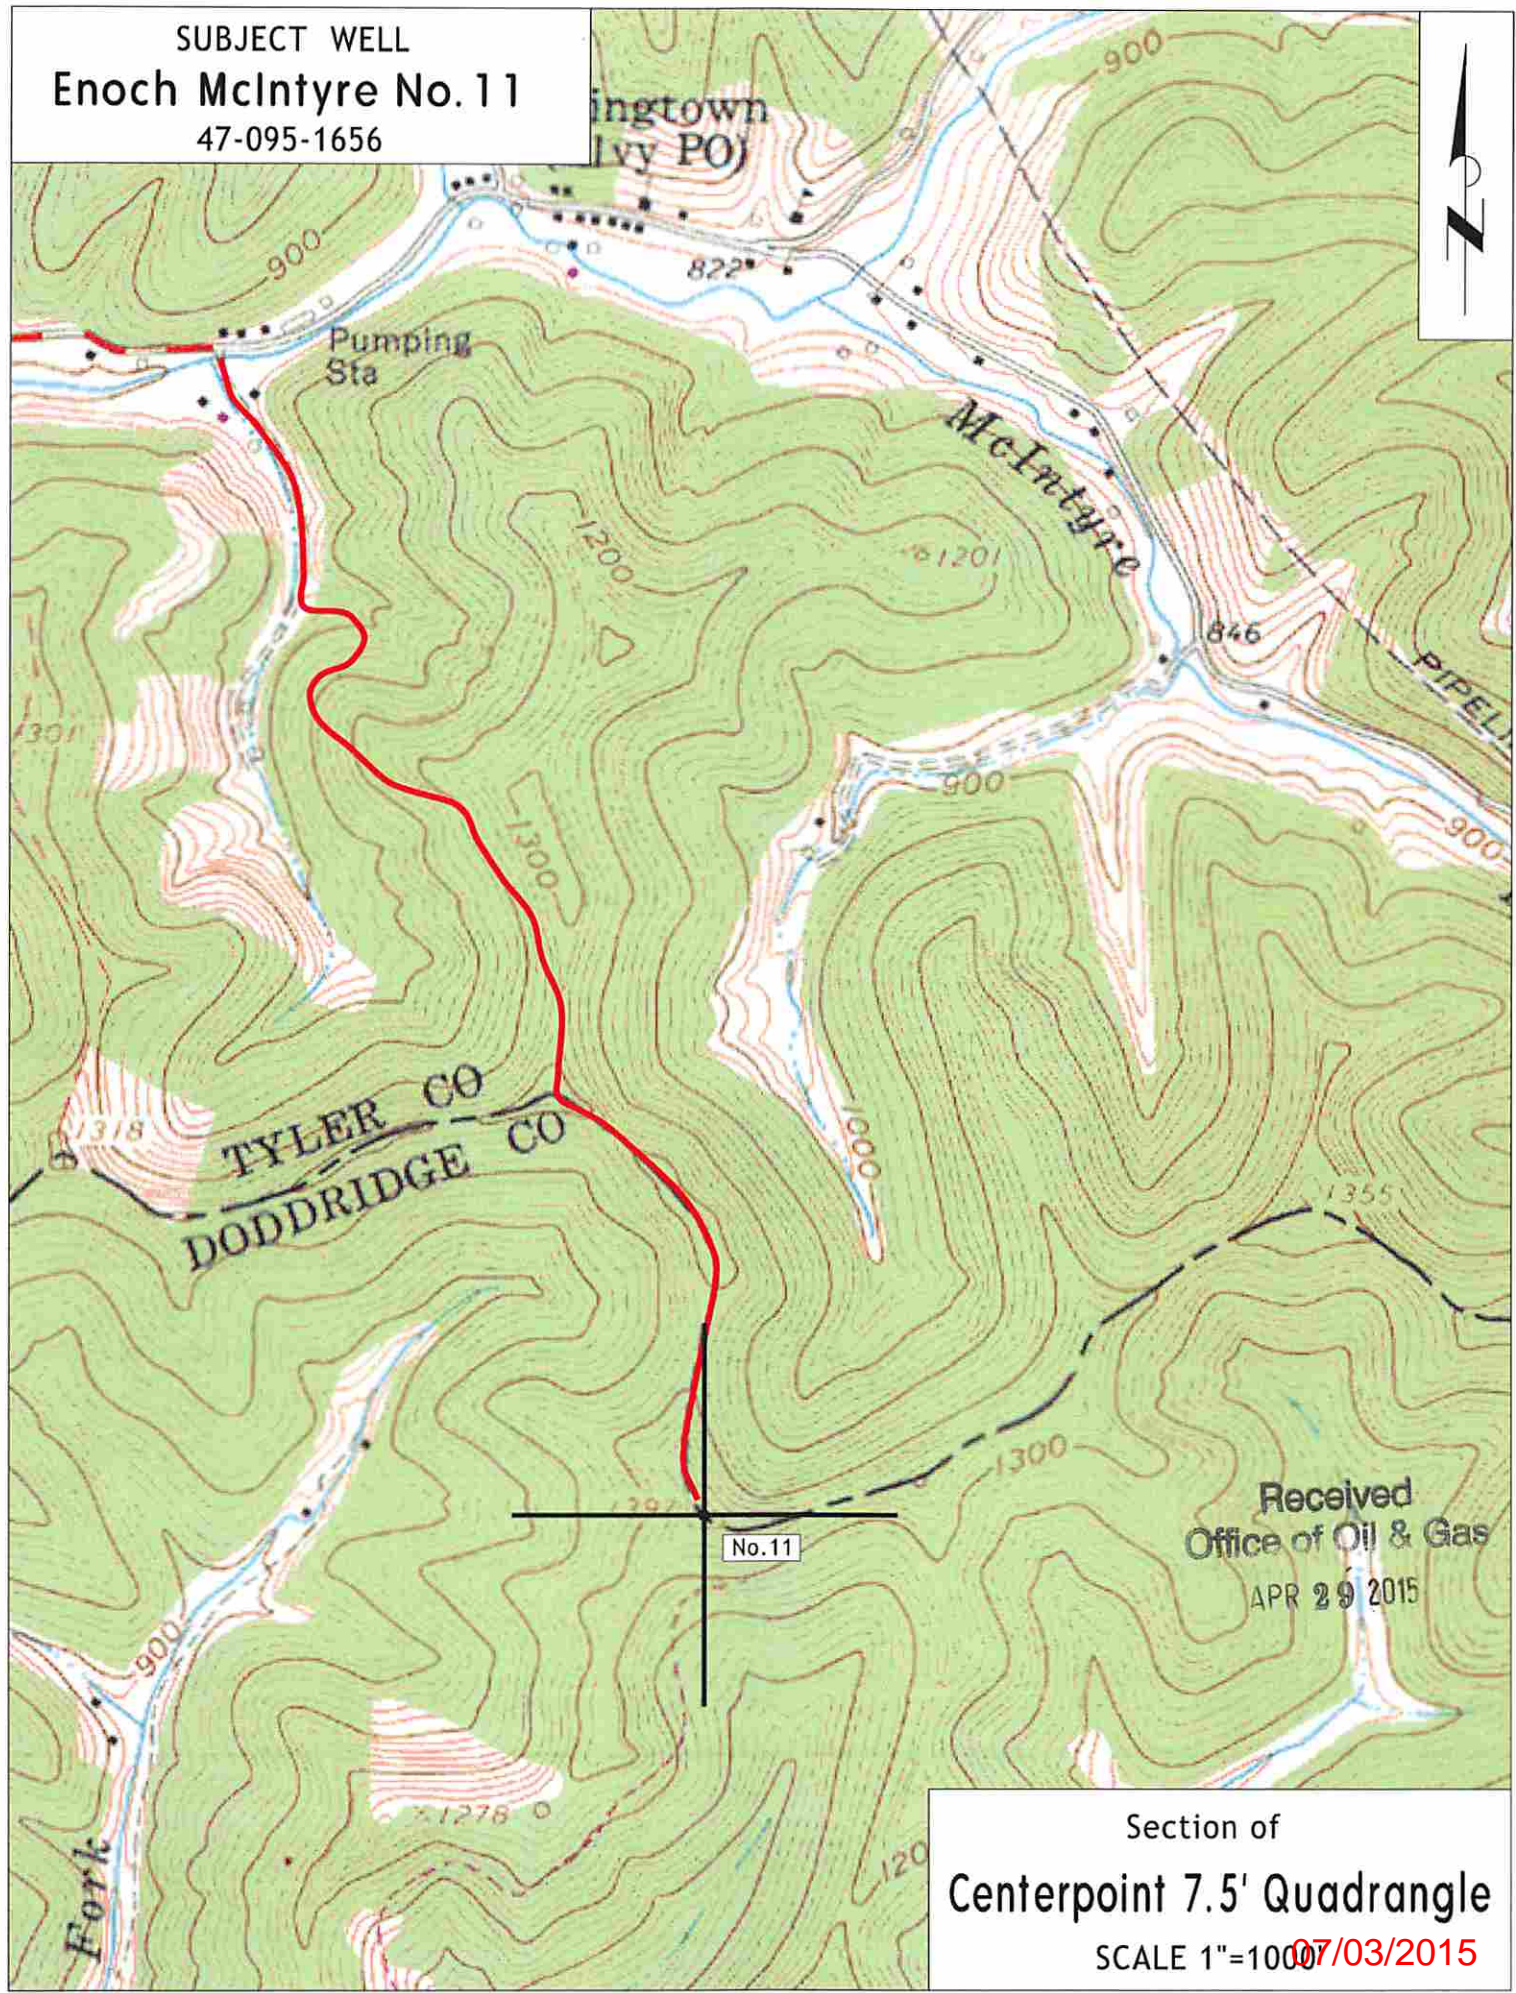

Received  
Office of Oil & Gas  
APR 29 2015

Section of  
Centerpoint 7.5' Quadrangle  
SCALE 1"=1000' 07/03/2015