


(+) DENOTES LOCATION OF WELL ON UNITED STATES TOPOGRAPHIC MAPS

FILE NO. \_\_\_\_\_  
 DRAWING NO. \_\_\_\_\_  
 SCALE 1" = 500'  
 MINIMUM DEGREE OF ACCURACY 1:200  
 PROVEN SOURCE OF ELEVATION G.P.S. SURVEY

I THE UNDERSIGNED, HEREBY CERTIFY THAT THIS PLAT IS CORRECT TO THE BEST OF MY KNOWLEDGE AND BELIEF AND SHOWS ALL THE INFORMATION REQUIRED BY LAW AND THE REGULATIONS ISSUED AND PRESCRIBED BY THE DEPARTMENT OF ENERGY.

(SIGNED) [Signature]  
 R.P.E. \_\_\_\_\_ P.S. 551

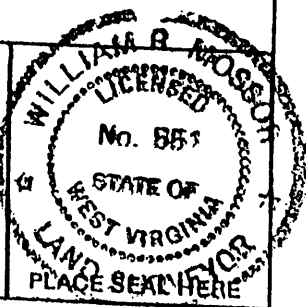

STATE OF WEST VIRGINIA  
 DEPARTMENT OF ENERGY  
 DIVISION OF OIL AND GAS



DATE 17 JUNE 2003  
 OPERATOR'S WELL NO. #10  
 API WELL NO. 47-095-01755  
 STATE COUNTY PERMIT

WELL TYPE: OIL  GAS  LIQUID INJECTION \_\_\_\_\_ WASTE DISPOSAL \_\_\_\_\_  
 (IF "GAS,") PRODUCTION  STORAGE \_\_\_\_\_ DEEP \_\_\_\_\_ SHALLOW   
 LOCATION: ELEVATION 1065 WATERSHED PURGATORY RUN  
 DISTRICT CENTERVILLE COUNTY TYLER  
 QUADRANGLE SHIRLEY  
 SURFACE OWNER RUTH MEREDITH  
 OIL & GAS ROYALTY OWNER RUTH MEREDITH ACREAGE 113  
 PROPOSED WORK: DRILL  CONVERT \_\_\_\_\_ DRILL DEEPER \_\_\_\_\_ REDRILL \_\_\_\_\_ FRACTURE OR STIMULATE \_\_\_\_\_ PLUG OFF OLD FORMATION \_\_\_\_\_ PERFORATE NEW FORMATION \_\_\_\_\_ OTHER PHYSICAL CHANGE IN WELL (SPECIFY) \_\_\_\_\_

PLUG AND ABANDON \_\_\_\_\_ CLEAN OUT AND REPLUG \_\_\_\_\_  
 TARGET FORMATION BENSON  
 WELL OPERATOR SANCHO OEG CORP. ESTIMATED DEPTH 5500'  
 ADDRESS BOX 179 DESIGNATED AGENT LOREN BAGLEY  
ST. MARYS, WV 26170 ADDRESS BOX 179  
ST. MARYS, WV 26170

FORM WW-6

COUNTY NAME TYLER

PERMIT 1755

(Beausiello 366)

State of West Virginia  
Department of Environmental Protection  
Office of Oil and Gas


*Handwritten initials*

Well Operator's Report of Well Work

Farm name: Ruth Meredith Operator Well No.: 10

LOCATION: Elevation: 1065' Quadrangle: Middlebourne

District: Centerville County: Tyler  
Latitude: Feet South of 39 Deg. 24 Min. 37.4 Sec.  
Longitude: Feet West of 80 Deg. 51 Min. 51.5 Sec.

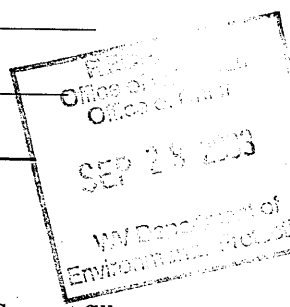

Company: Sancho O & G Corp

	Casing & Tubing	Used in drilling	Left in well	Cement fill up Cu. Ft.
Address: Box 179 St Mary's, WV 23170				
Agent: Loren E. Bagley	13 3/8"	43'	43'	
Inspector: Mike Underwood				
Date Permit Issued: 8/16/2003	9 5/8"	323'	323'	115 SKS
Date Well Work Commenced: 8/22/03				
Date Well Work Completed: 8/14/03 ?	7"	2243'	2243'	310 SKS
Verbal Plugging:				
Date Permission granted on: N/A	4 1/2"	5135'	5135'	50 SKS
Rotary X Cable Rig				
Total Depth (feet): 5200				
Fresh Water Depth (ft.):				
Salt Water Depth (ft.):				
Is coal being mined in area (N/Y)? N				
Coal Depths (ft.):				

OPEN FLOW DATA

Producing formation Benson Pay zone depth (ft) 5022'  
Gas: Initial open flow 1275 MCF/d Oil: Initial open flow NA Bbl/d  
Final open flow \_\_\_\_\_ MCF/d Final open flow \_\_\_\_\_ Bbl/d  
Time of open flow between initial and final tests \_\_\_\_\_ Hours  
Static rock Pressure 375 psig (surface pressure) after 48 Hours

Second producing formation \_\_\_\_\_ Pay zone depth (ft) \_\_\_\_\_  
Gas: Initial open flow \_\_\_\_\_ MCF/d Oil: Initial open flow \_\_\_\_\_ Bbl/d  
Final open flow \_\_\_\_\_ MCF/d Final open flow \_\_\_\_\_ Bbl/d  
Time of open flow between initial and final tests \_\_\_\_\_ Hours  
Static rock Pressure \_\_\_\_\_ psig (surface pressure) after \_\_\_\_\_ Hours

NOTE: ON BACK OF THIS FORM PUT THE FOLLOWING: 1). DETAILS OF PERFORATED INTERVALS, FRACTURING OR STIMULATING, PHYSICAL CHANGE, ETC. 2). THE WELL LOG WHICH IS A SYSTEMATIC DETAILED GEOLOGICAL RECORD OF ALL FORMATIONS, INCLUDING COAL ENCOUNTERED BY THE WELLBORE.

Signed: *Neil M. Sullivan*  
By: Neil M. Sullivan  
Date: 9-20-03

14 2003

TYL 1755

8/27/2003

Perf stage 1 (Benson) 5020'-5024' (16 shots). 50 sks 80/100 & 250 sks 20/40.

ROCK DESCRIPTION	DEPTH
REDCLAY	7
SAND	13
RED SHALE	16
RED SAND	21
SAND	35
RED ROCKY SHALE	52
SAND	70
SANDY SHALE	155
SAND	200
SANDY SHALE	260
SAND	295
RED ROCK	365
SAND	390
RED ROCK	395
SAND	420
RED ROCK	550
SAND	610
RED ROCK	750
SAND	790
RED ROCK	970
SAND	995
RED ROCK	1070
SAND	1075
RED ROCK	1080
SANDY SHALE	1085
SAND	1200
SANDY SHALE	1230
SAND	1260
SANDY SHALE	1290
SAND	1320
SANDY SHALE	1350
SAND	1440
SANDY SHALE	1680
SAND	1740
SANDY SHALE	1770
SAND	1830
BIG LIME	1925
SAND	2035
SANDY SHALE	2175
SANDY SHALE	2370
SAND	2400
SANDY SHALE	2430
SAND	2490
SANDY SHALE	2320
SHALE	2610
SANDY SHALE	2640
SHALE	2790
SAND	2820
SANDY SHALE	2850
SHALE	2880
SANDY SHALE	2970
SHALE	3000
SAND	3030
SANDY SHALE	3060
SAND	3090
SANDY SHALE	3120
SAND	3210
SHALY	3240
SAND	3290
SHALE	3400
SAND	3450
SANDY SHALE	3630
SHALE	3700
SAND	3880
SANDY SHALE	4200
SAND	4310
SHALE	4490
SAND	4550
SANDY SHALE	4650
SAND	4710
SANDY SHALE	4720
SAND	5030
SANDY SHALE	5130
TD	5200