

WW-7
8-30-06



West Virginia Department of Environmental Protection
Office of Oil and Gas
WELL LOCATION FORM: GPS

API: 47-095-01779 WELL NO.: 20

FARM NAME: Baker, MV

RESPONSIBLE PARTY NAME: Harman Brown

COUNTY: Tyler DISTRICT: McElroy

QUADRANGLE: Centerpoint 7.5'

SURFACE OWNER: Glover and Watts

ROYALTY OWNER: Stringtown Unit 3

UTM GPS NORTHING: 4364899.44

UTM GPS EASTING: 526710.07 GPS ELEVATION: 1278

The Responsible Party named above has chosen to submit GPS coordinates in lieu of preparing a new well location plat for a plugging permit or assigned API number on the above well. The Office of Oil and Gas will not accept GPS coordinates that do not meet the following requirements:

1. Datum: NAD 1983, Zone: 17 North, Coordinate Units: meters, Altitude: height above mean sea level (MSL) – meters.

2. Accuracy to Datum – 3.05 meters

3. Data Collection Method:

Survey grade GPS : Post Processed Differential

Real-Time Differential

Mapping Grade GPS : Post Processed Differential

Real-Time Differential

4. Letter size copy of the topography map showing the well location.

I the undersigned, hereby certify this data is correct to the best of my knowledge and belief and shows all the information required by law and the regulations issued and prescribed by the Office of Oil and Gas.

David Oliver
Digitally signed by David Oliver
Date: 2024.02.29 11:34:01
-05'00'

Facilities/Pipeline Engineer

2/29/24

Signature

Title

Date


RECEIVED
Office of Oil and Gas


MAR 22 2024

WV Department of
Environmental Protection

04/26/2024

RECEIVED
Office of Oil and Gas
MAR 22 2024
WV Department of
Environmental Protection

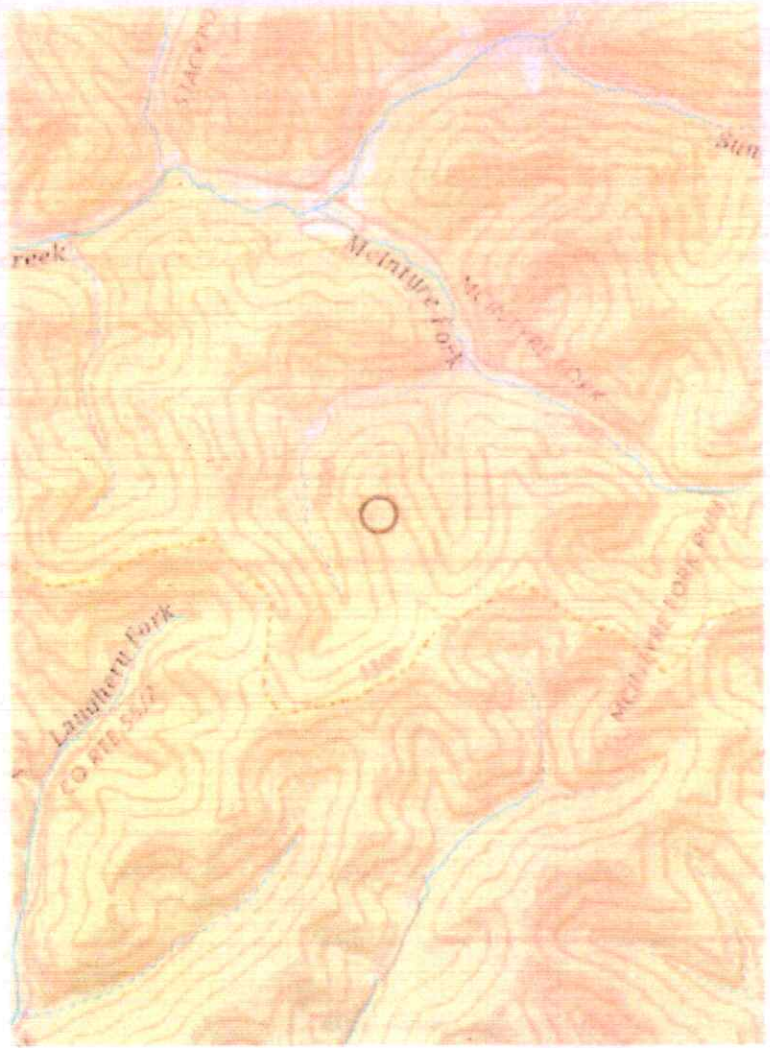

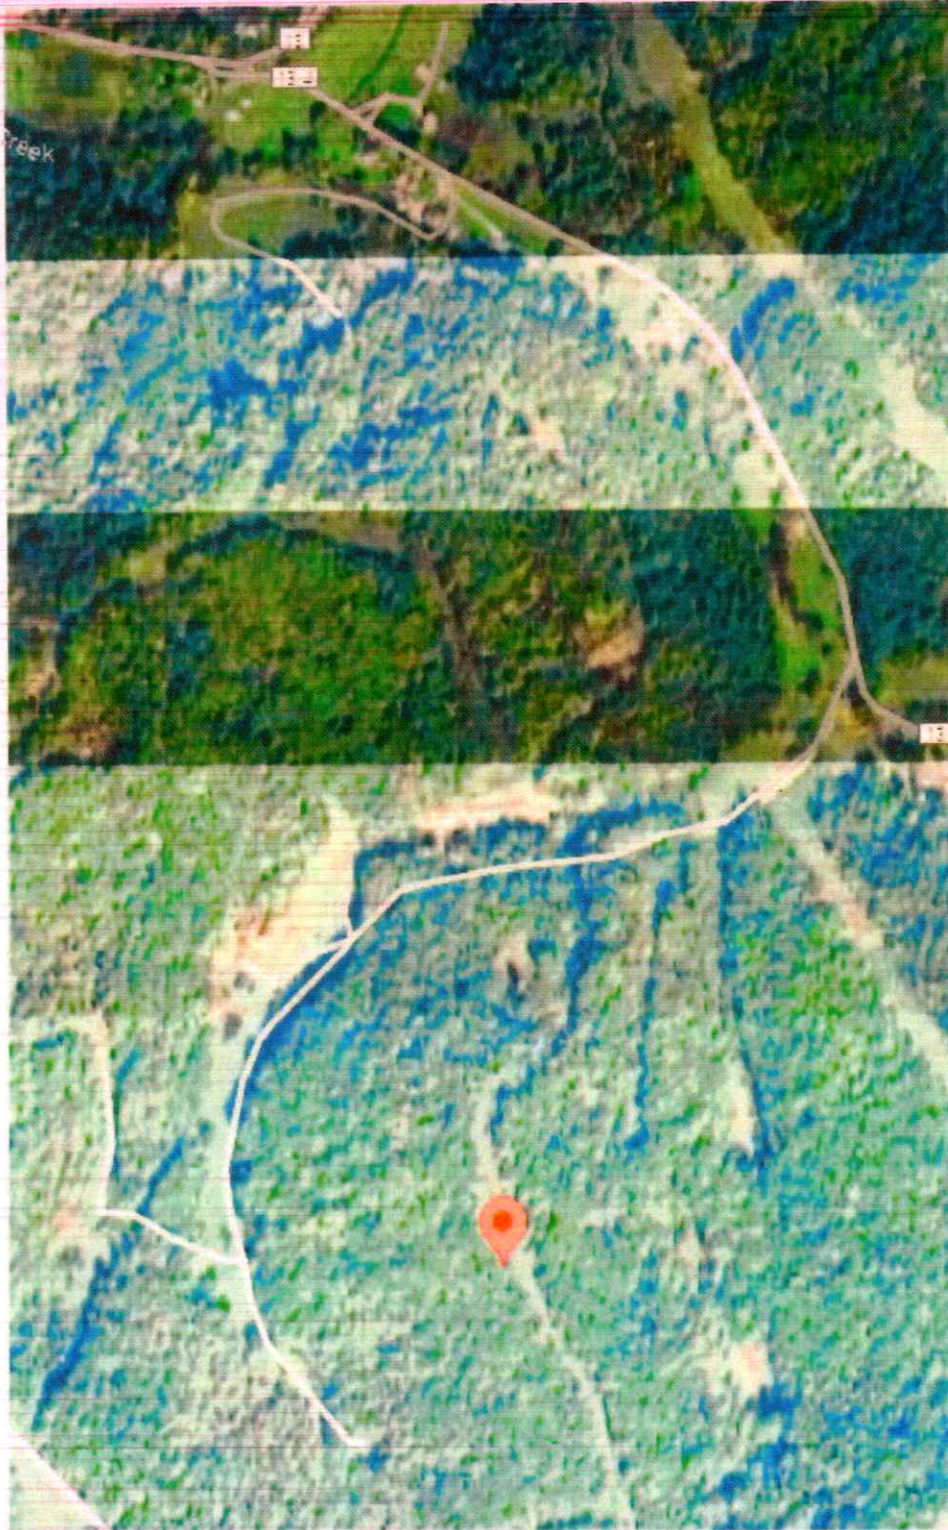

RECEIVED
Office of Oil and Gas
MAR 22 2024
WV Department of
Environmental Protection

04/26/2024