

WW-7
8-30-06



West Virginia Department of Environmental Protection
Office of Oil and Gas
WELL LOCATION FORM: GPS

API: 47-095-01846 WELL NO.: 15

FARM NAME: McIntyre, Enoch

RESPONSIBLE PARTY NAME: Harman Brown

COUNTY: Tyler DISTRICT: McElroy

QUADRANGLE: Centerpoint 7.5'

SURFACE OWNER: Fred & Dottie Glover

ROYALTY OWNER: Stringtown Unit 1

UTM GPS NORTHING: 4364412.76

UTM GPS EASTING: ~~80.688250~~ 526831.30 GPS ELEVATION: 1311'

RECEIVED
Office of Oil and Gas
MAR 22 2024
WV Department of
Environmental Protection

The Responsible Party named above has chosen to submit GPS coordinates in lieu of preparing a new well location plat for a plugging permit or assigned API number on the above well. The Office of Oil and Gas will not accept GPS coordinates that do not meet the following requirements:

- Datum: NAD 1983, Zone: 17 North, Coordinate Units: meters, Altitude: height above mean sea level (MSL) – meters.
- Accuracy to Datum – 3.05 meters
- Data Collection Method:
Survey grade GPS ____ : Post Processed Differential ____
Real-Time Differential ____
Mapping Grade GPS : Post Processed Differential ____
Real-Time Differential ____

4. Letter size copy of the topography map showing the well location.

I the undersigned, hereby certify this data is correct to the best of my knowledge and belief and shows all the information required by law and the regulations issued and prescribed by the Office of Oil and Gas.

David Oliver Digitally signed by David Oliver
Date: 2024.02.29 13:40:54
-05'00'

Facilities/Pipeline Engineer


2/29/24

Signature

Title

Date

06/14/2024

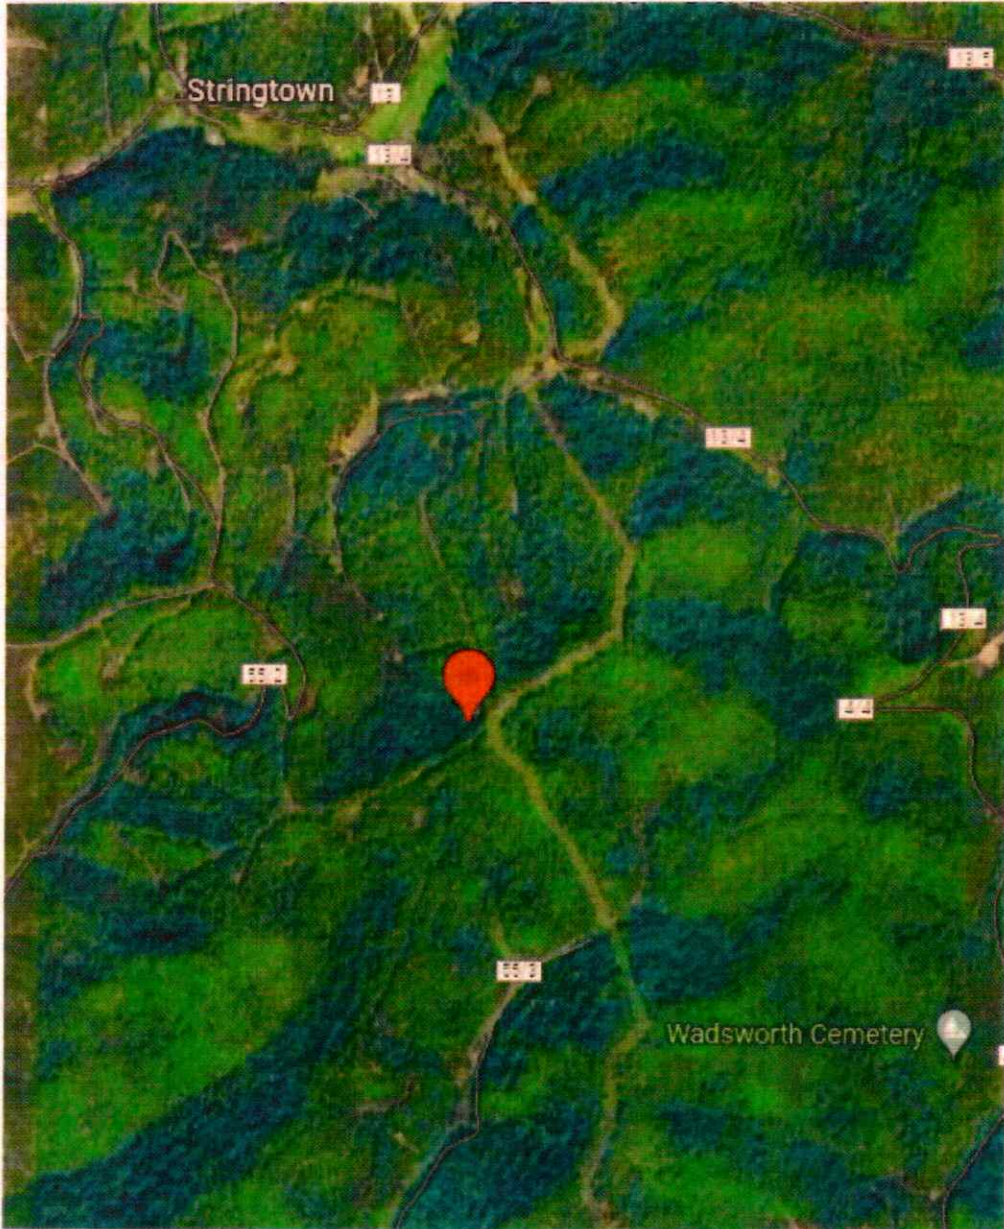

RECEIVED
Office of Oil and Gas

MAR 22 2024

WV Department of
Environmental Protection

06/14/2024