

West Virginia Department of Environmental Protection  
Office of Oil & Gas  
**WELL LOCATION FORM: GPS**

API: 47- 095 - 1905 P WELL NO: 27  
FARM NAME: A.D. Lemasters  
RESPONSIBLE PARTY NAME: East Resources, Inc.  
COUNTY: Tyler DISTRICT: McElroy  
QUADRANGLE: Centerpoint 7.5'  
SURFACE OWNER: James & Betty McCoy  
ROYALTY OWNER: East Resources, Inc. et al.  
UTM GPS NORTHING: 4,368,473 (NAD 27)  
UTM GPS EASTING: 527,000 (NAD 27) GPS ELEVATION: 407 m.


The Responsible Party named above has chosen to submit GPS coordinates in lieu of preparing a new well location plat for a plugging permit on the above well. The Office of Oil & Gas will not accept GPS coordinates that do not meet the following requirements:

1. Datum: NAD 1983, Zone:17 North, Coordinate Units: meters, Altitude: height above mean sea level (MSL) - meters.
2. Accuracy to Datum - 3.05 meters
3. Data Collection Method:

Survey Grade GPS  Post Processed Differential   
Real-Time Differential   
Mapping Grade GPS  Post Processed Differential   
Real-Time Differential

RECEIVED  
Office of Oil & Gas  
SEP 22 2011  
WV Department of  
Environmental Protection

I the undersigned, hereby certify this data is correct to the best of my knowledge and belief and shows all the information required by law and the regulations issued and prescribed by the Office of Oil and Gas.

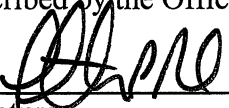
 Timothy P. Roush  
Signature

Professional Surveyor  
Title

September 19, 2011  
Date

95-01905P

SUBJECT WELL  
A.D. Lemasters No.27  
47-095-1905

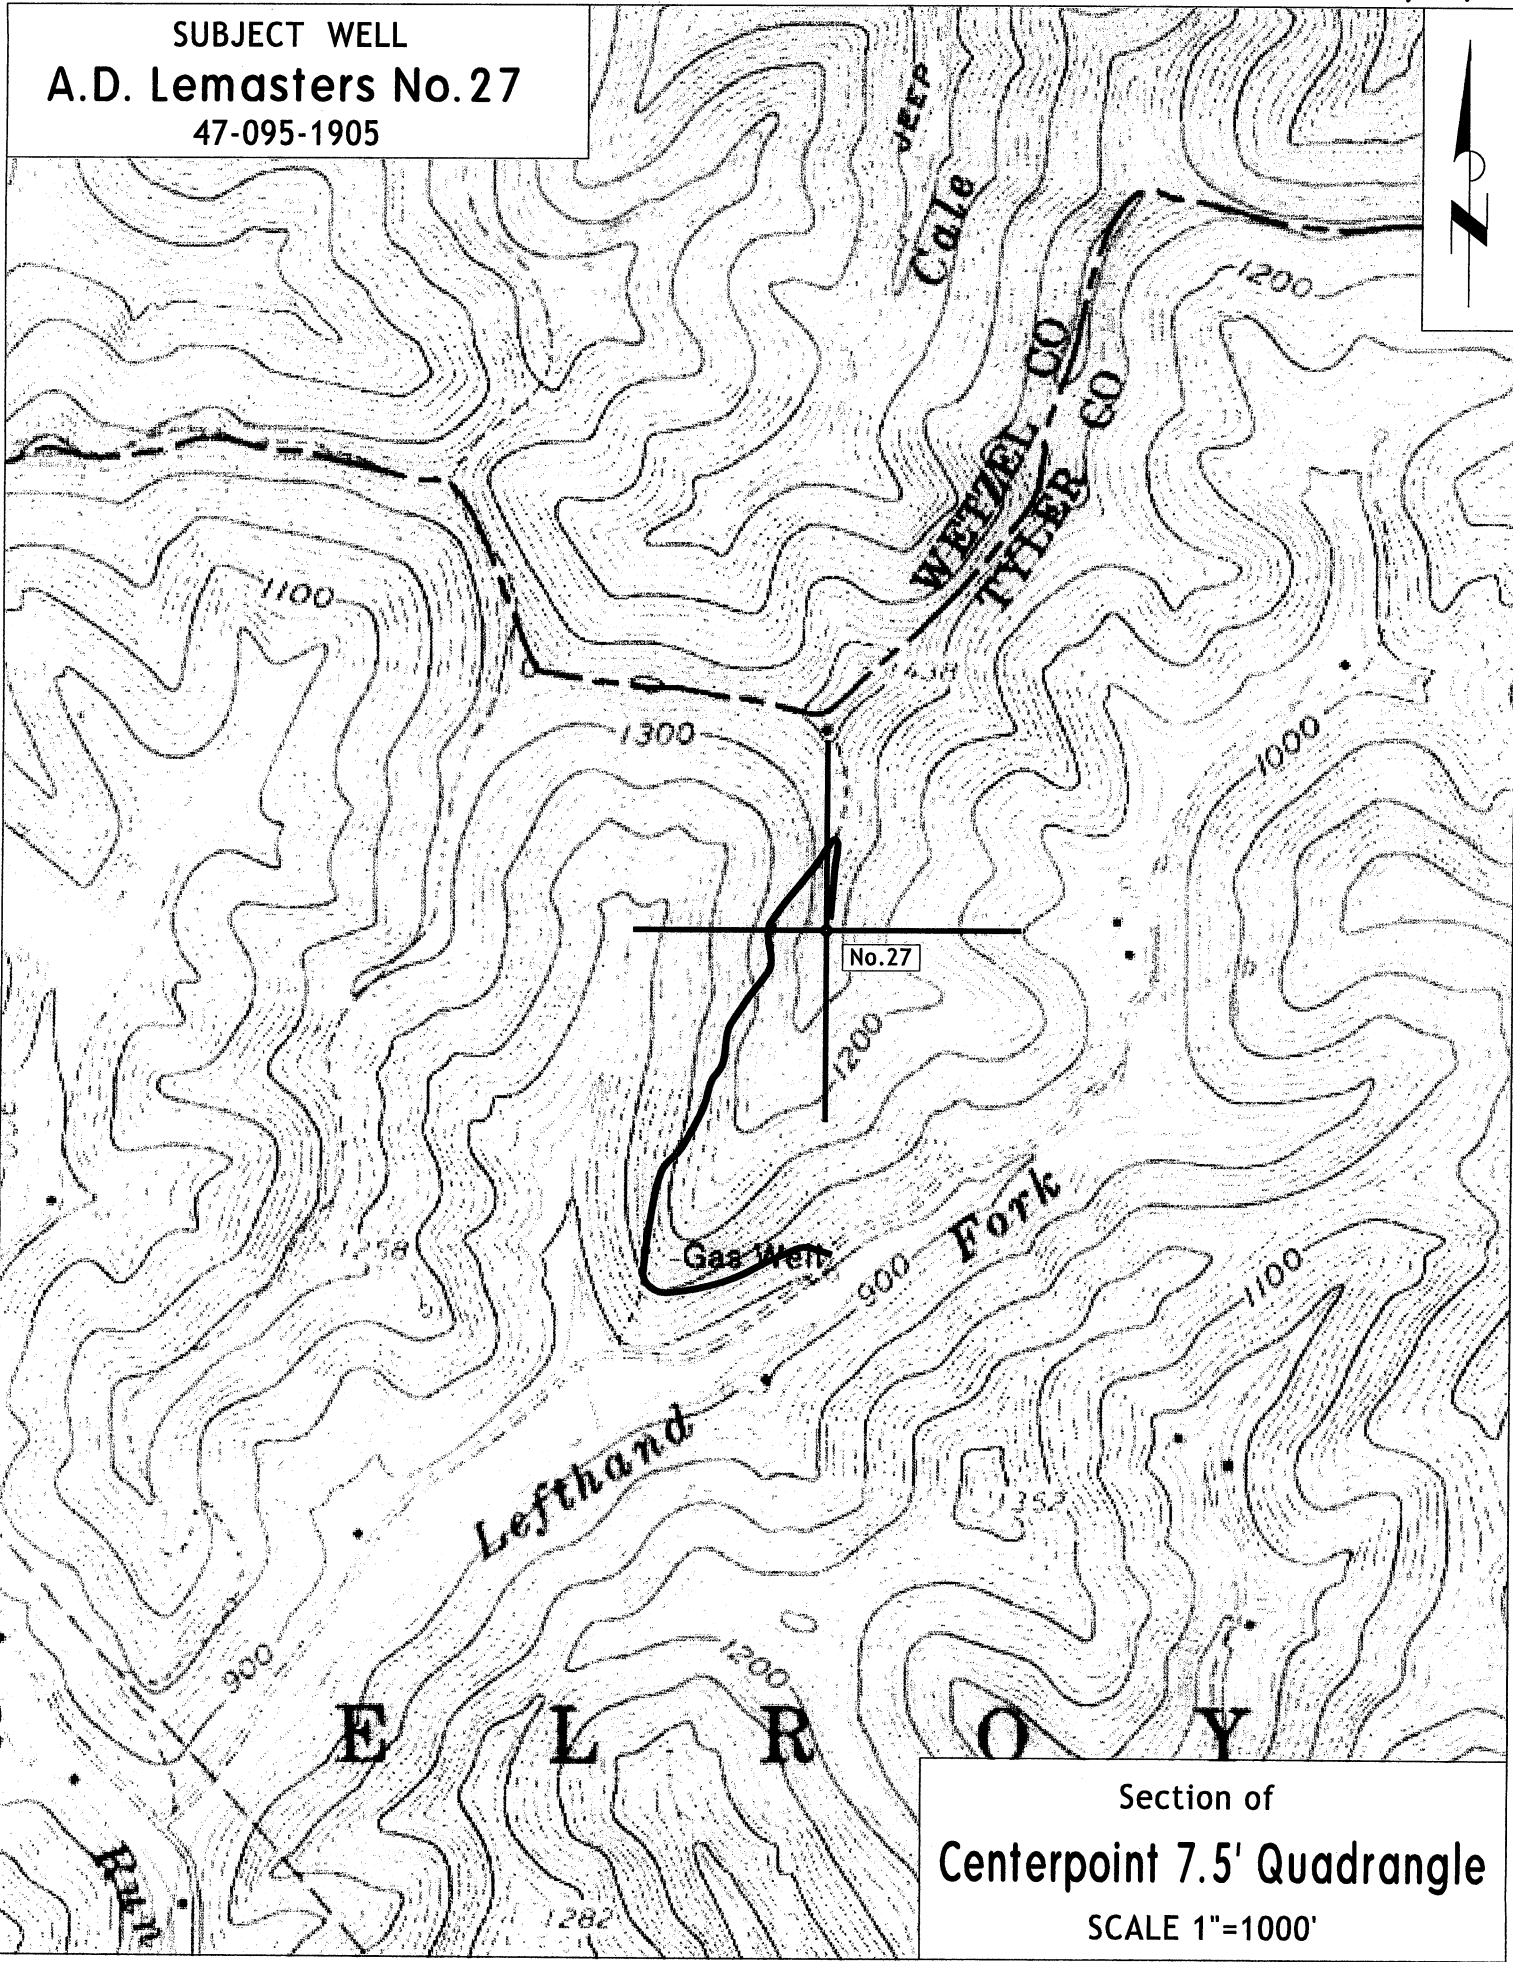

Section of  
Centerpoint 7.5' Quadrangle  
SCALE 1"=1000'