



4709501912

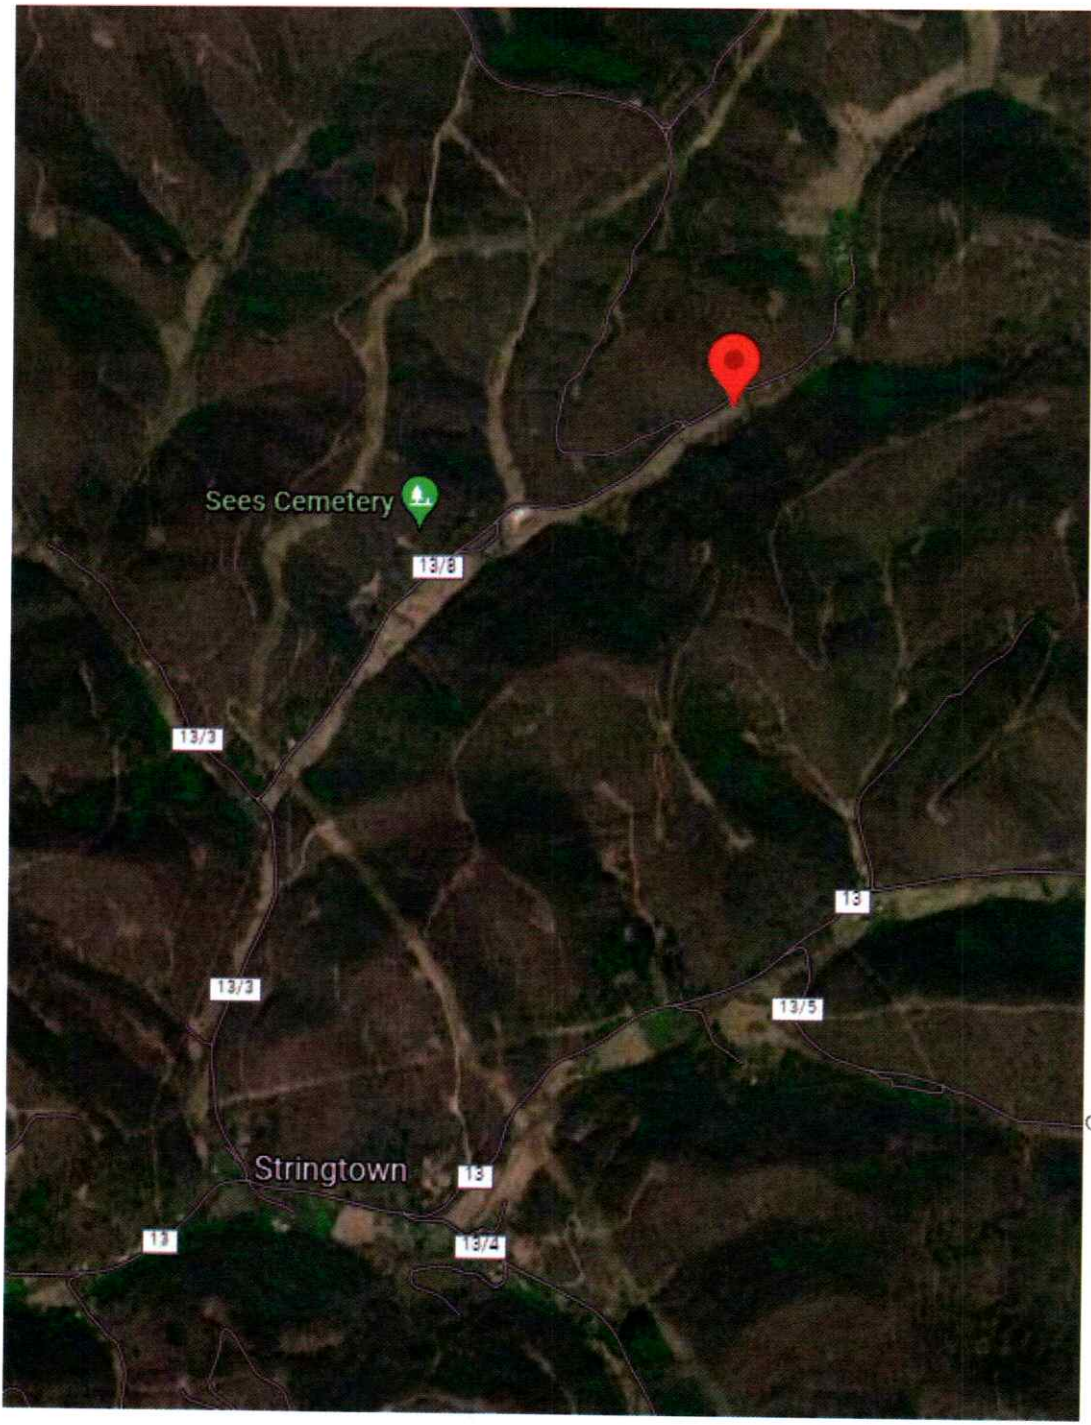

RECEIVED  
Office of Oil and Gr  
MAY 18 2020  
WV Departmen  
Environmental Pr...

06/16/2023

4709501912

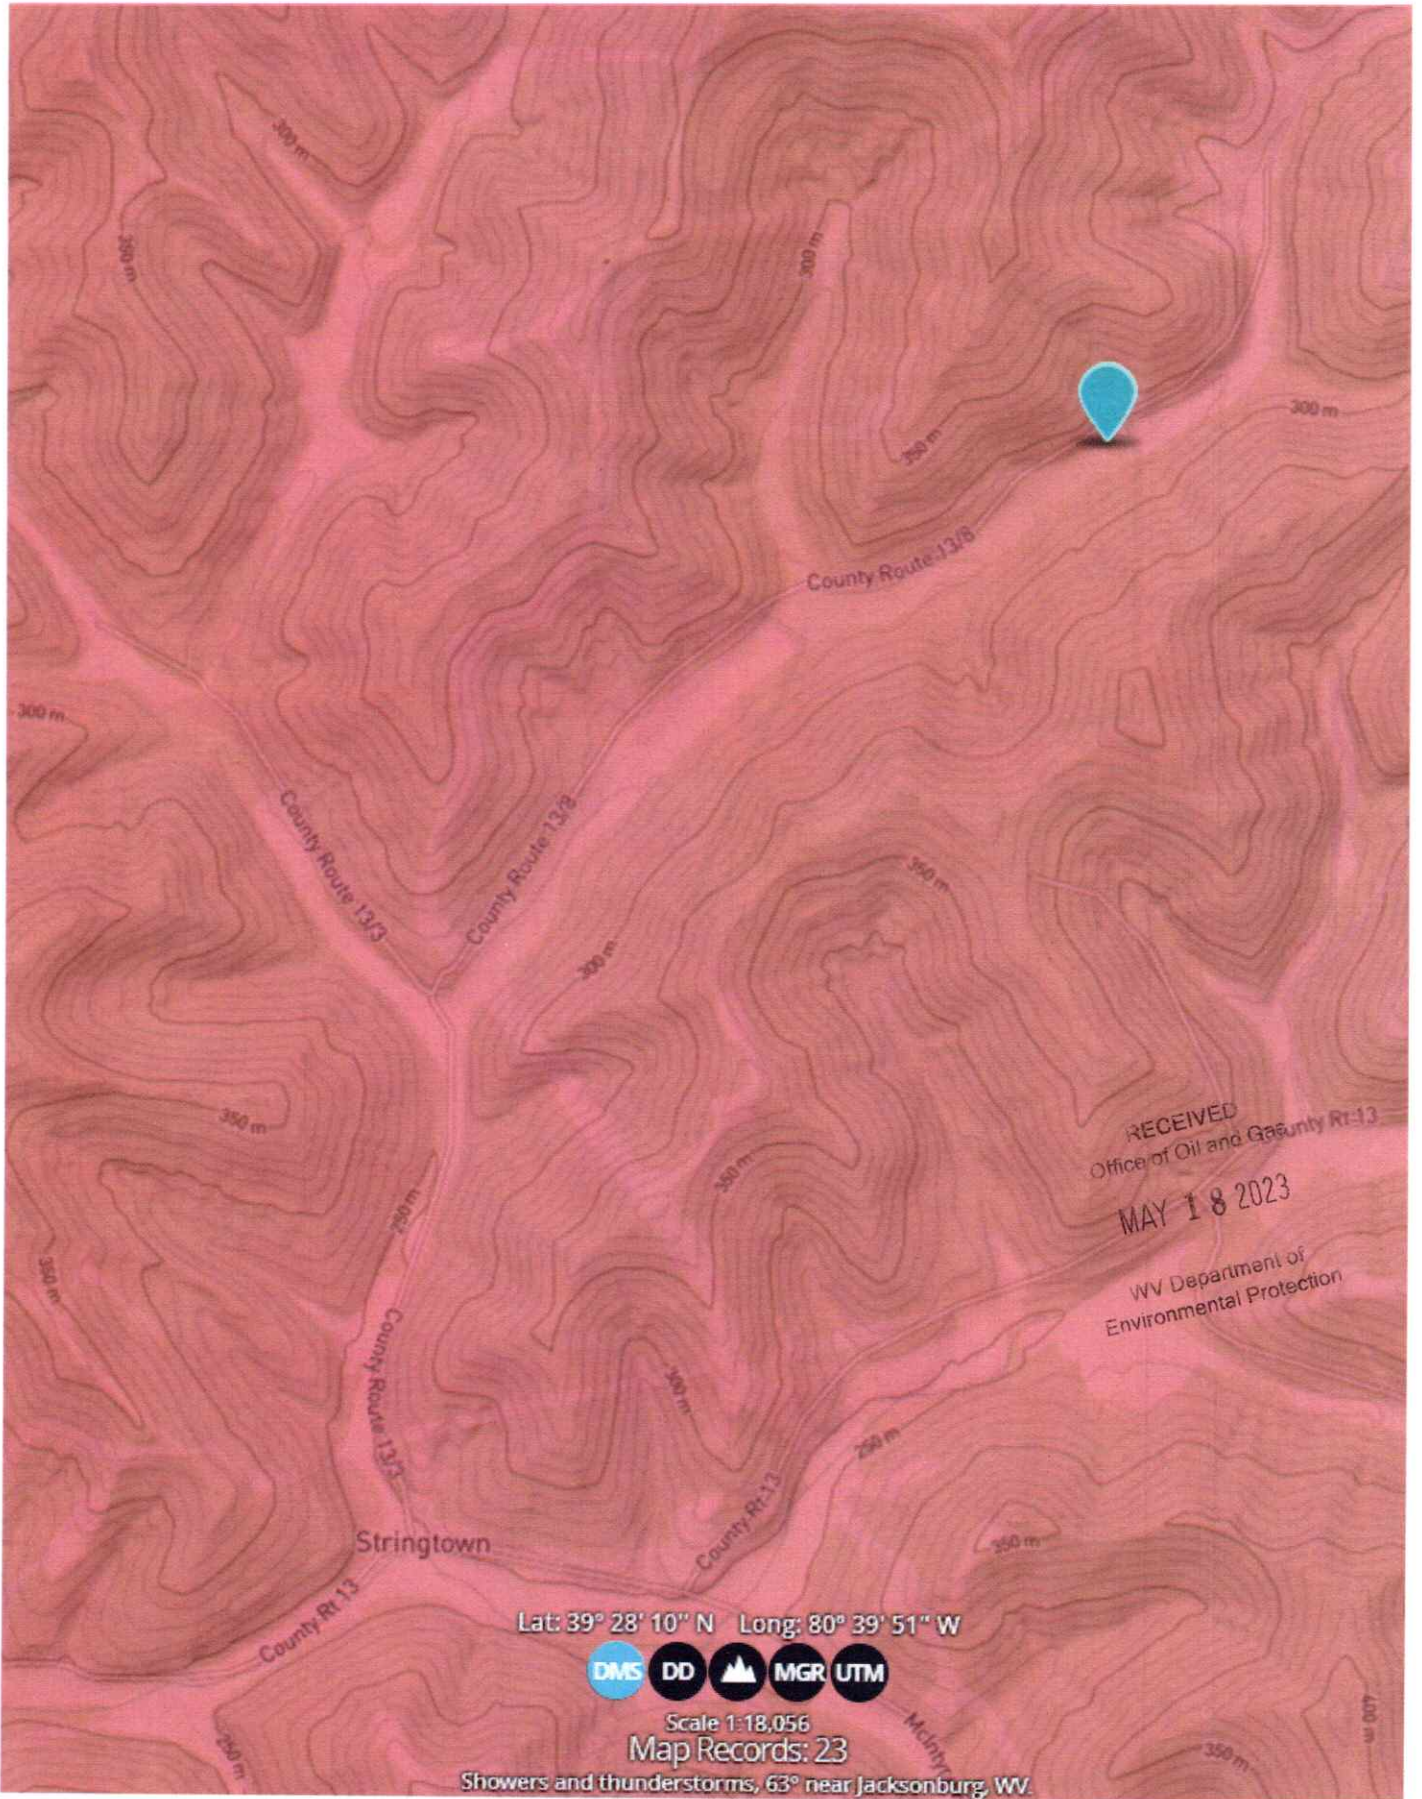

06/16/2023

WW-7  
8-30-06



West Virginia Department of Environmental Protection  
Office of Oil and Gas  
**WELL LOCATION FORM: GPS**

API: 47-095-01912 WELL NO.: 13

FARM NAME: Lemasters, S. P.

RESPONSIBLE PARTY NAME: Harman Brown

COUNTY: Tyler DISTRICT: McElroy

QUADRANGLE: Centerpoint 7.5'

SURFACE OWNER: WV Public Lands Corp, Mark E. Talkington

ROYALTY OWNER: Stringtown Unit No. 1

UTM GPS NORTHING: 4368276.93

UTM GPS EASTING: 527219.42 GPS ELEVATION: 914'

The Responsible Party named above has chosen to submit GPS coordinates in lieu of preparing a new well location plat for a plugging permit or assigned API number on the above well. The Office of Oil and Gas will not accept GPS coordinates that do not meet the following requirements:

- Datum: NAD 1983, Zone: 17 North, Coordinate Units: meters, Altitude: height above mean sea level (MSL) – meters.
- Accuracy to Datum – 3.05 meters
- Data Collection Method:  
Survey grade GPS \_\_\_\_: Post Processed Differential \_\_\_\_  
Real-Time Differential \_\_\_\_  
Mapping Grade GPS X: Post Processed Differential \_\_\_\_  
Real-Time Differential \_\_\_\_

RECEIVED  
Office of Oil and Gas

MAY 18 2023

WV Department of  
Environmental Protection

4. **Letter size copy of the topography map showing the well location.**

I the undersigned, hereby certify this data is correct to the best of my knowledge and belief and shows all the information required by law and the regulations issued and prescribed by the Office of Oil and Gas.

David R. Oliver Digitally signed by David R. Oliver  
Date: 2023.04.23 08:44:22 -04'00'

Pipeline/Facilities Engineer

4/23/2023

Signature

Title

Date

06/16/2023