

No. 6  
 UTM Coordinates  
 (NAD83)  
 Meters  
 N - 4366,401  
 E - 527,321

**Location References**  
 (Magnetic Bearing - Slope Dist.)  
 S 13° E 117' 14" American Beech  
 N 67° W 94.5' 12" Double Maple


**NOTES ON SURVEY**  
 1 - Well ties and Latitude and Longitude were measured by DGPS (Sub-meter Mapping Grade). Bearings are referenced to UTM Grid North (Zone 17 North - NAD 1927).  
 2 - Surface owners and adjoiners information obtained from the Tyler County Assessor's tax records.

⬠ - DENOTES A POSSIBLE WATER SUPPLY SOURCE LOCATED FROM CIRCA 2003 AERIAL PHOTOGRAPHY - NOT BY SURVEY. OTHER SOURCES MAY BE PRESENT.  
 + - DENOTES LOCATION OF WELL ON UNITED STATES TOPOGRAPHIC MAPS.

FILE NO. 1046-22  
 MAP NO.        N        S        E        W  
 SCALE 1" = 1000'  
 MINIMUM DEGREE OF ACCURACY Sub-Meter  
 PROVEN SOURCE OF ELEVATION DGPS Survey  
 (Sub-Meter Mapping Grade)

I THE UNDERSIGNED, HEREBY CERTIFY THAT THIS PLAT IS CORRECT TO THE BEST OF MY KNOWLEDGE AND BELIEF AND SHOWS ALL THE INFORMATION REQUIRED BY LAW AND THE REGULATIONS ISSUED AND PRESCRIBED BY THE DEPARTMENT OF MINES.

(SIGNED) *[Signature]*  
 TIMOTHY P. ROUSH PS 793

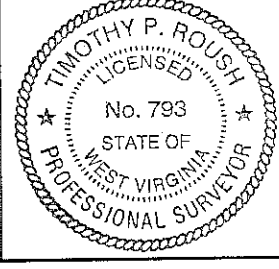


**WEST VIRGINIA**  
 Division of Environmental Protection  
 Office of Oil and Gas  
 601 57th Street  
 Charleston, West Virginia 25301



DATE January 31, 2012  
 FARM Samuel McMillen No.6  
 API WELL NO. 47-095-02055

WELL TYPE: OIL  GAS  LIQUID INJECTION  WASTE DISPOSAL   
 (IF "GAS") PRODUCTION  STORAGE  DEEP  SHALLOW   
 LOCATION: ELEVATION 1046' WATERSHED Indian Creek  
 DISTRICT McElroy COUNTY Tyler  
 QUADRANGLE Centerpoint 7.5'  
 SURFACE OWNER Kenneth & Genieva Glover ACREAGE 32.68 Ac.  
 OIL & GAS ROYALTY OWNER HG Energy LLC., et al. LEASE ACREAGE 75 Ac.  
 LEASE NO. 13181-50  
 PROPOSED WORK: DRILL  CONVERT  DRILL DEEPER  REDRILL  FRACTURE OR STIMULATE  PLUG OFF OLD FORMATION  PERFORATE NEW FORMATION  OTHER PHYSICAL CHANGE IN WELL (SPECIFY)         
 PLUG AND ABANDON  CLEAN OUT AND REPLUG   
 TARGET FORMATION Gordon ESTIMATED DEPTH 3050'  
 WELL OPERATOR HG Energy LLC. DESIGNATED AGENT Mike Kirsch  
 ADDRESS P. O. Box 5519 ADDRESS P. O. Box 5519  
Vienna, W.Va. 26105 Vienna, W.Va. 26105

SUBJECT WELL  
Samuel McMillen No.6

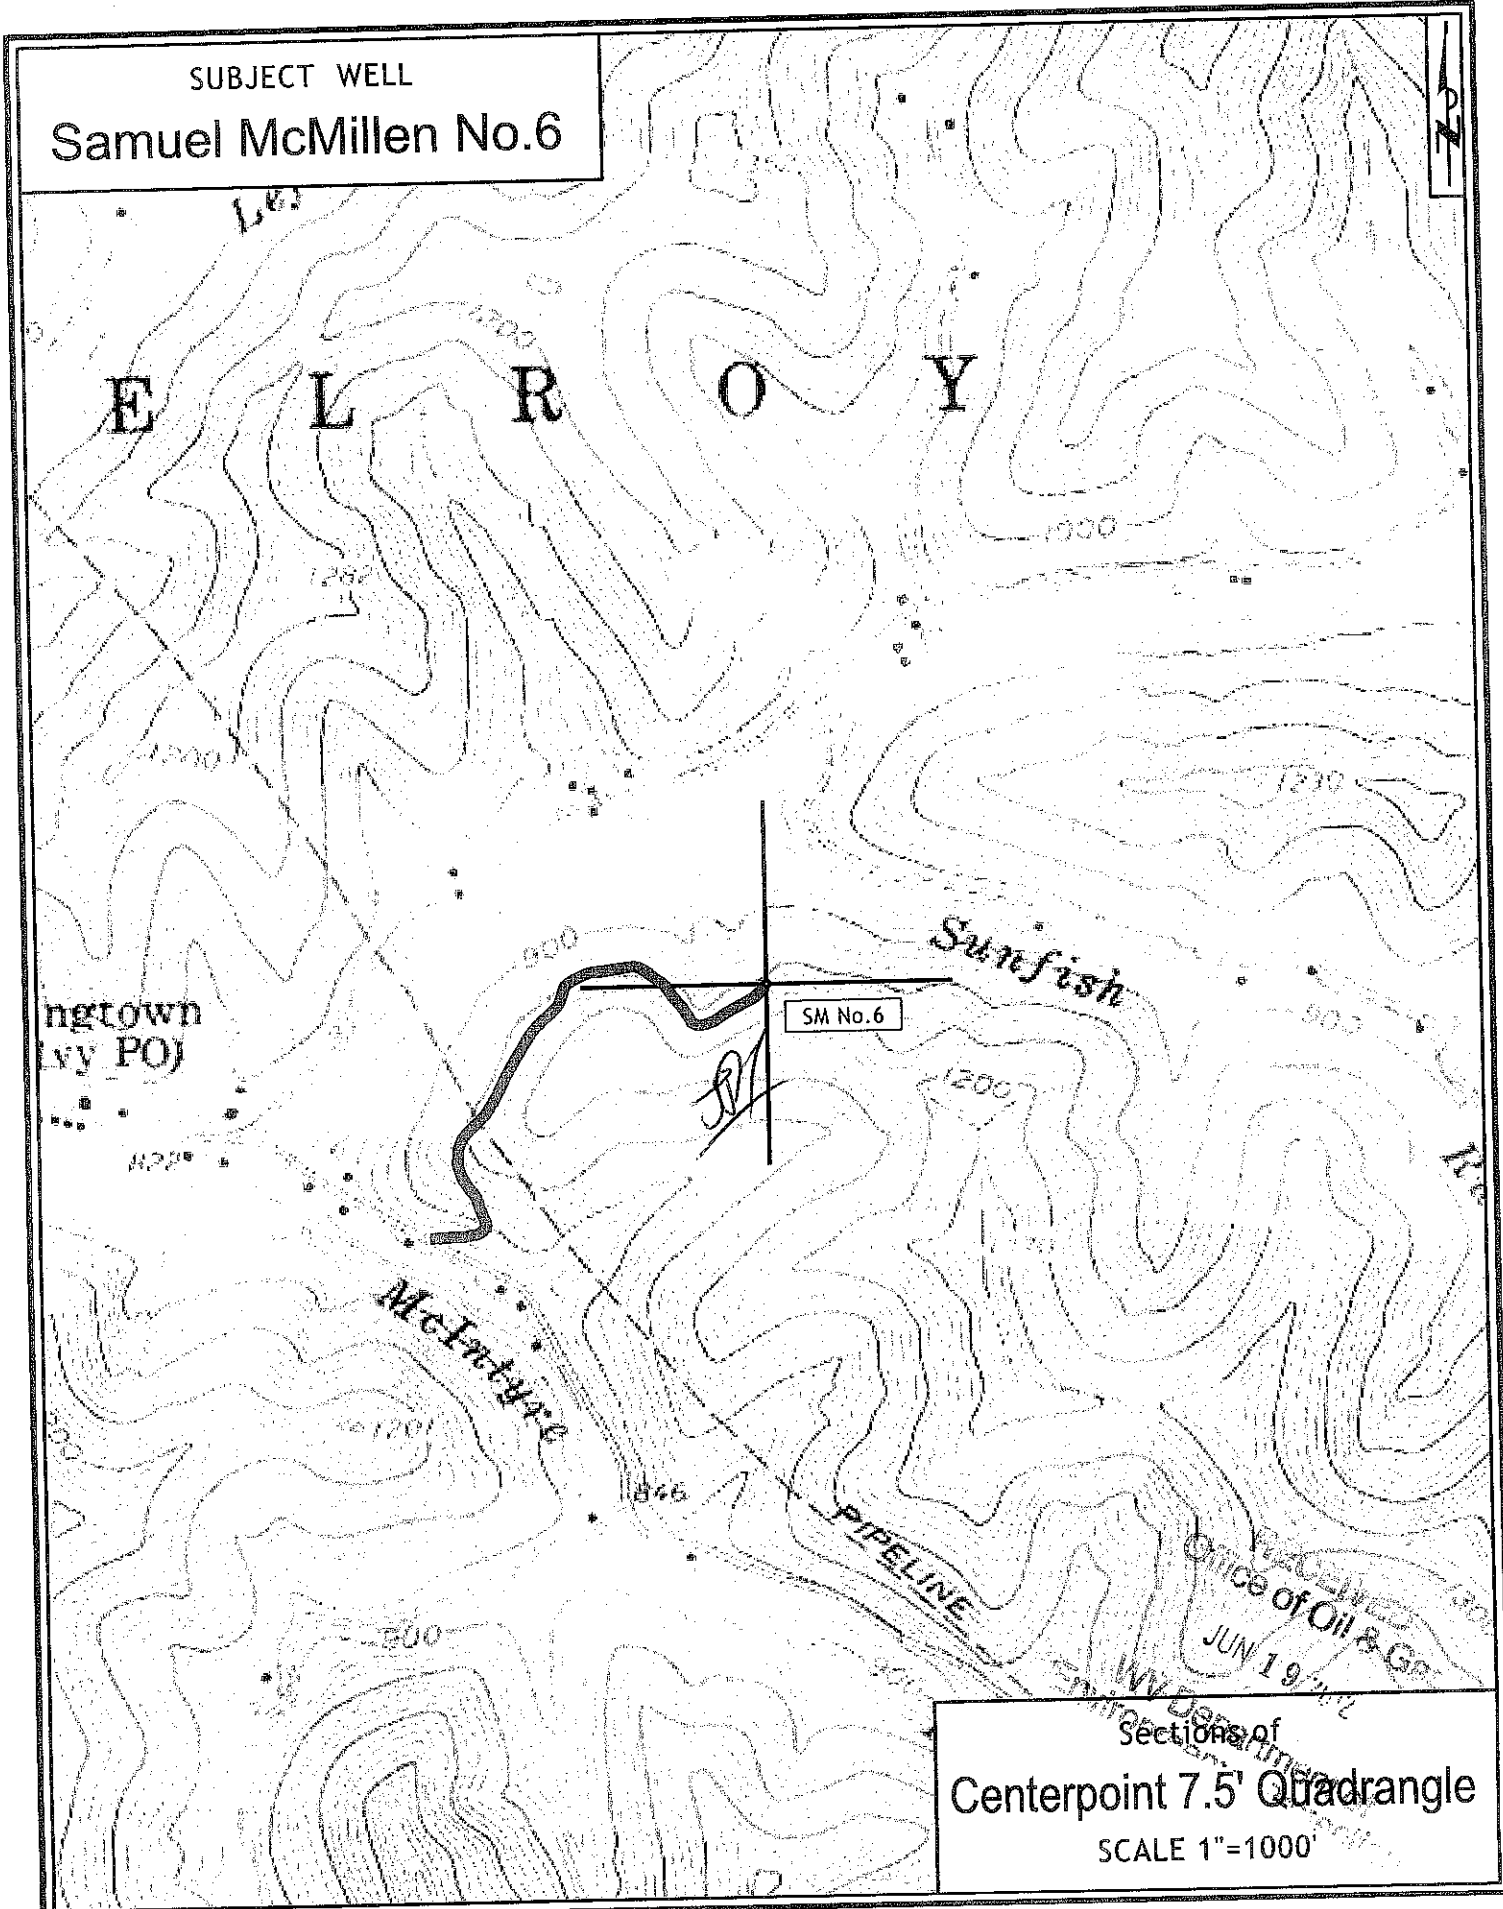

Sections of  
Centerpoint 7.5' Quadrangle  
SCALE 1"=1000'