


NOTES:
 1. CORNER TIES, REFERENCES, PROPERTY LINE INFORMATION, 2400' CIRCLE AND SURFACE OWNERSHIPS WERE TAKEN FROM ERNEST J. BENCHEK III PLAT DATED JUNE 2, 2014. FILE NO. 201366.
 2. WELL HEAD WAS FIELD LOCATED BY JACKSON SURVEYING USING RTK GPS AND IS BASED UPON AN OPUS SOLUTION.
 3. LEG AND BH LOCATIONS ARE BASED UPON DRILLING REPORT BY PANTHER DRILLING SYSTEMS DATED OCTOBER 2, 2014 WITH JOB NUMBER NE140027H.

Line	Bearing	Distance
L1	S49°37'55"W	1005.80'
L2	N62°28'15"W	1147.69'


Point	Geo NAD 83	UTM NAD83 (meter)	UTM NAD83 (feet)
Top Hole	83-39.475482 N, 80.738840 W	4369576.01 N, 522462.22 E	14335850.64 N, 1714111.46 E
Landing Point 1	83-39.473664 N, 80.741522 W	4369373.65 N, 522232.07 E	14335186.72 N, 1713356.38 E
Landing Point 2	83-39.475082 N, 80.745153 W	4369530.08 N, 521919.31 E	14335699.94 N, 1712330.28 E
Bottom Hole	83-39.486816 N, 80.751550 W	4370830.81 N, 521365.56 E	14339967.41 N, 1710513.51 E

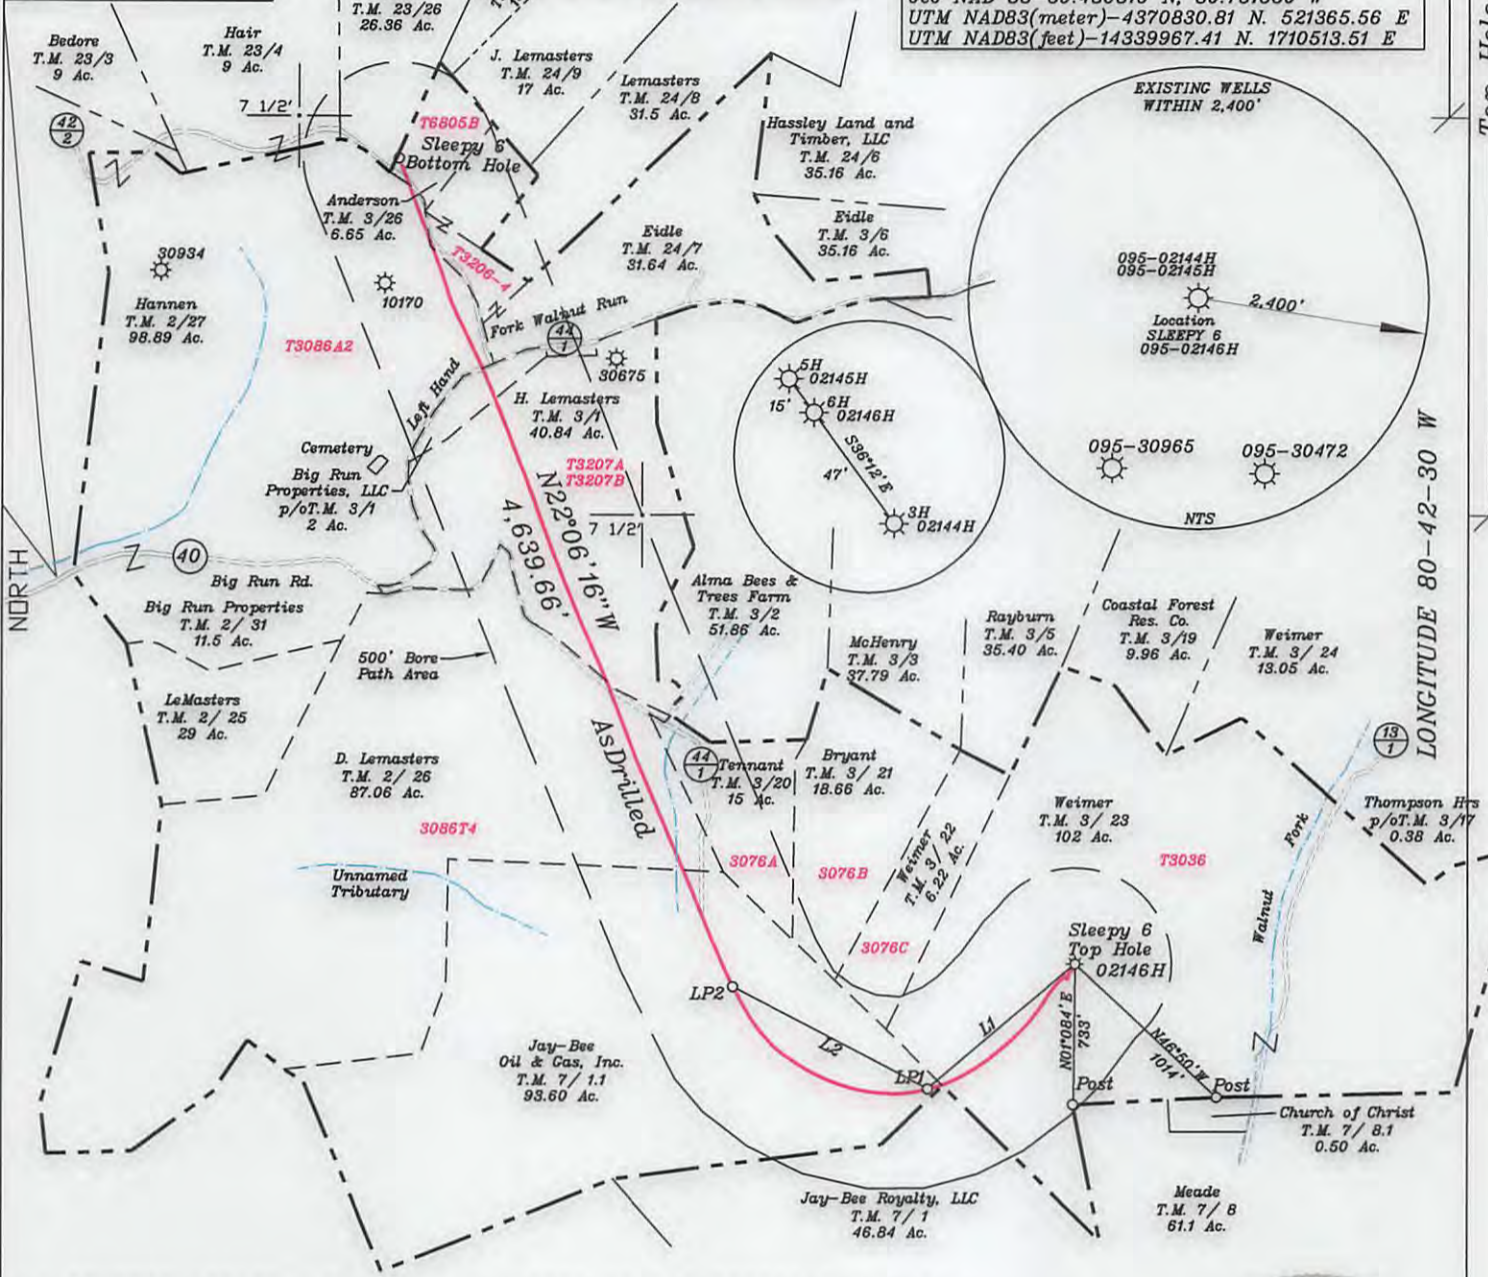

(+) DENOTES LOCATION OF WELL ON UNITED STATES TOPOGRAPHIC MAPS

FILE NO. _____
 DRAWING NO. 1
 SCALE 1" = 1000'
 MINIMUM DEGREE OF ACCURACY 1 in 200
 PROVEN SOURCE OF ELEVATION GPS
submeter unit

I THE UNDERSIGNED, HEREBY CERTIFY THAT THIS PLAT IS CORRECT TO THE BEST OF MY KNOWLEDGE AND BELIEF AND SHOWS ALL THE INFORMATION REQUIRED BY LAW AND THE RULES ISSUED AND PRESCRIBED BY THE DEPARTMENT OF ENVIRONMENTAL PROTECTION.
 (SIGNED) David L. Jackson
 R.P.E. _____ P.L.S. 708

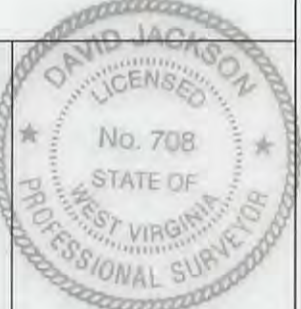

STATE OF WEST VIRGINIA
 Division of Environmental Protection
 OFFICE OF OIL AND GAS

DATE March 23, 2016
 OPERATOR'S WELL NO. Sleepy 6
 API WELL NO. As Drilled
47 - 095 - 02146H MDD

WELL TYPE: OIL X GAS X LIQUID INJECTION WASTE DISPOSAL STATE COUNTY PERMIT
 (IF "GAS") PRODUCTION X STORAGE DEEP SHALLOW X

LOCATION: ELEVATION 1111.4' WATER SHED Walnut Fork of Indian Creek
 DISTRICT McElroy COUNTY Tyler
 QUADRANGLE Center Point 7 1/2'

SURFACE OWNER Brent A. & Emma Weimer ACREAGE 102.00
 ROYALTY OWNER Mary Gwen Tustin ACREAGE 102.00
 LEASE NO. "See ownership list above for lease numbers"

PROPOSED WORK: DRILL X CONVERT DRILL DEEPER REDRILL FRACTURE OR STIMULATE X PLUG OFF OLD FORMATION PERFORATE NEW FORMATION X OTHER PHYSICAL CHANGE IN WELL (SPECIFY) As Drilled
 PLUG AND ABANDON CLEAN OUT AND REPLUG

TARGET FORMATION Marcellus ESTIMATED DEPTH TVD = 6,919'; TMD = 13,395'
 WELL OPERATOR Jay Bee Oil & Gas, Inc. DESIGNATED AGENT Randy Broda
 ADDRESS 1720 Rt. 22, East Union, NJ 07083 ADDRESS 3570 Shields Hill Road, Cairo, WV 26337