




BLUE RIDGE MOUNTAIN RESOURCES

Location: Tyler County, WV Slot: Slot #08
 Field: Tyler Well: Wells Meckley 1405MH
 Facility: Meckley Pad Wellbore: Wells Meckley 1405MH PWB



API: 47-095-02155-0000
BHI Job #: 8935154
Rig: H&P 371
Duration: 12.23.2017 - 12.29.2017

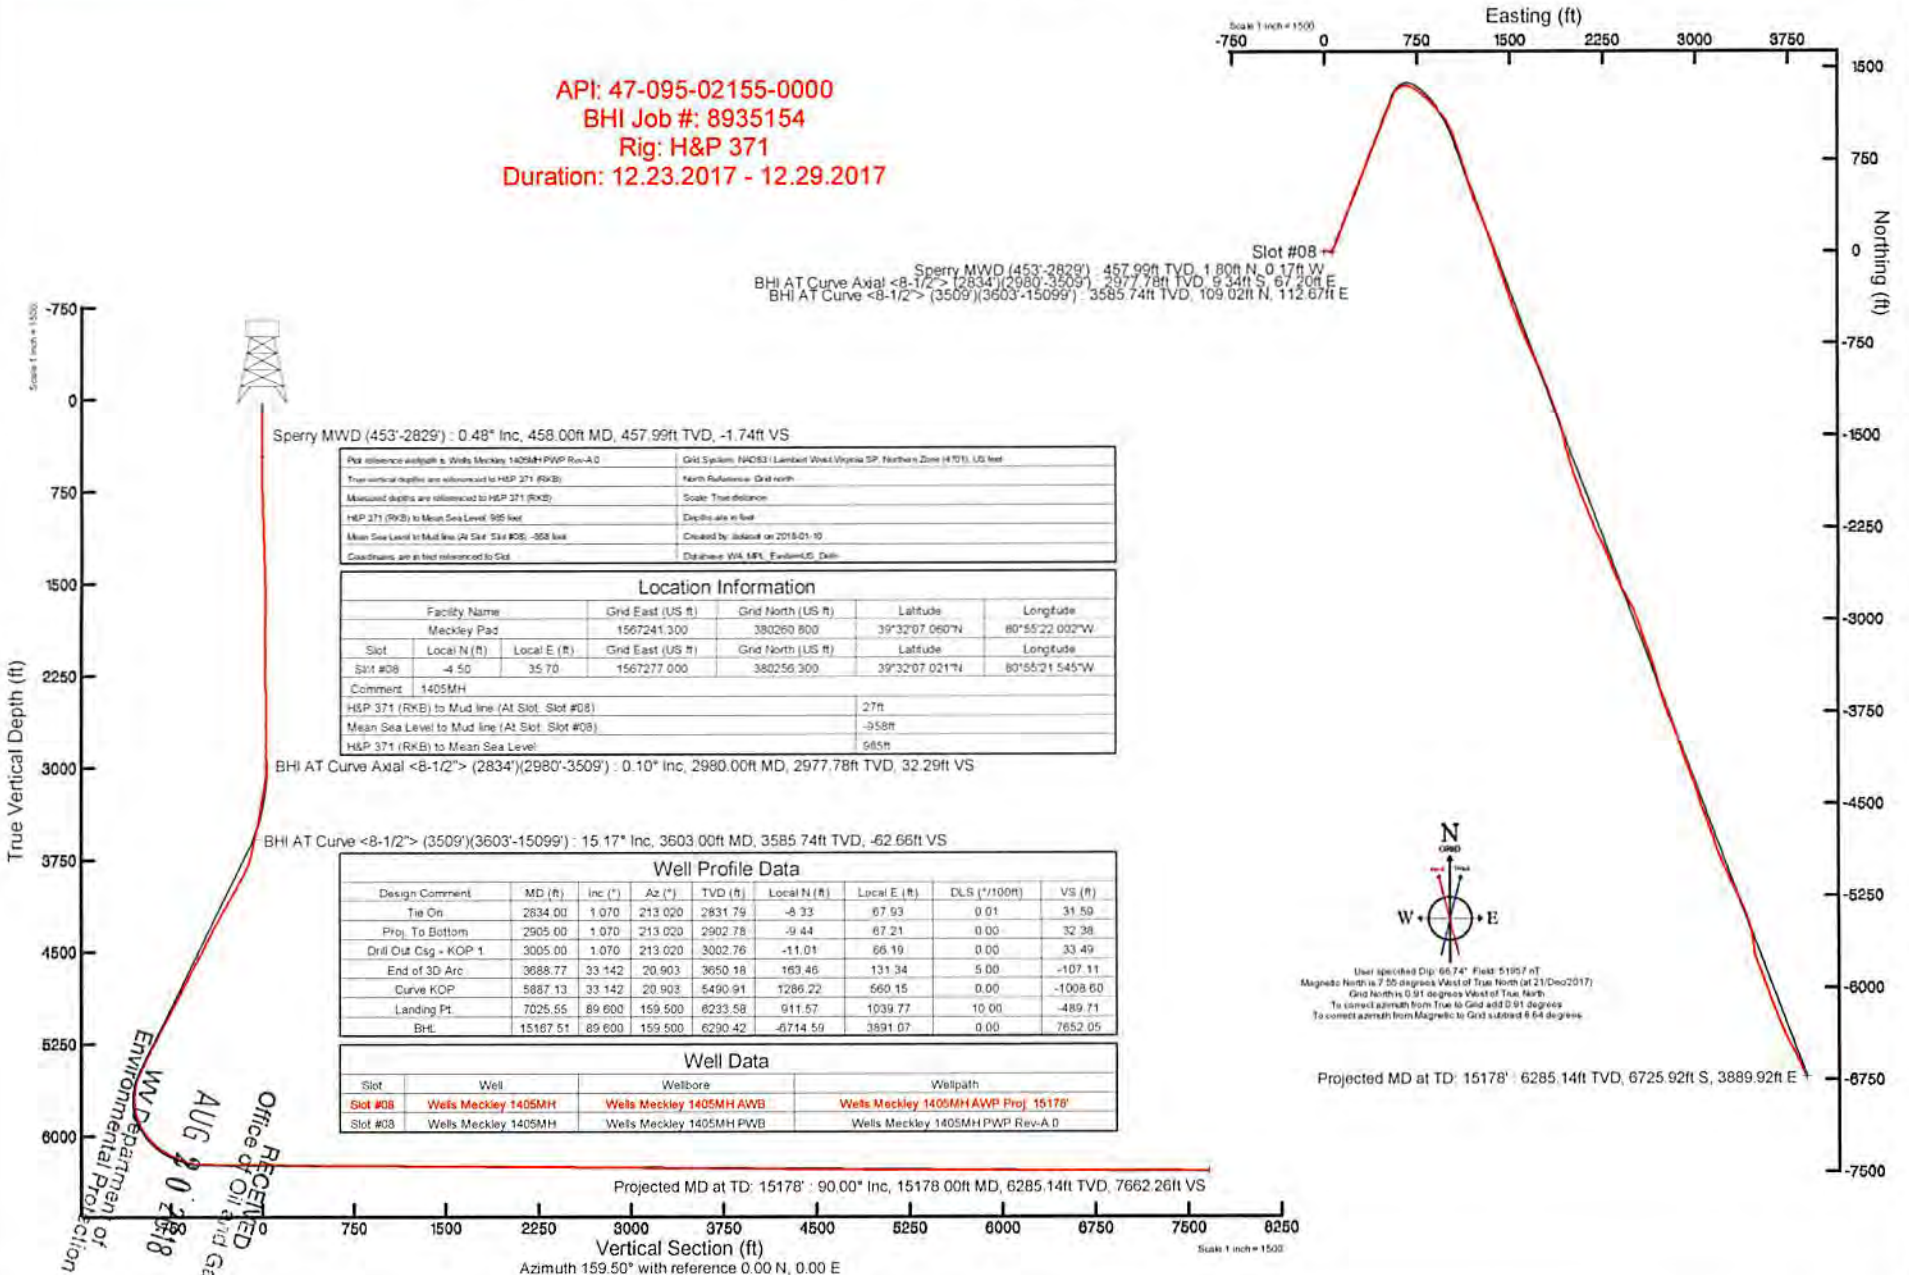

Slot #08
 Sperry MWD (453'-2829') : 0.48° Inc, 458.00ft MD, 457.99ft TVD, -1.74ft VS
 BHI AT Curve Axial <8-1/2> (2834')(2980'-3509') : 0.10° Inc, 2980.00ft MD, 2977.78ft TVD, 32.29ft VS
 BHI AT Curve <8-1/2> (3509')(3603'-15099') : 15.17° Inc, 3603.00ft MD, 3585.74ft TVD, -62.66ft VS

Sperry MWD (453'-2829') : 0.48° Inc, 458.00ft MD, 457.99ft TVD, -1.74ft VS

Plot reference wellpath is Wells Meckley 1405MH PWB Rev-A-D	Grid System: NAD83 / Lambert West Virginia SP Northern Zone (470), US feet
True vertical depths are referenced to H&P 371 (RKB)	North Reference: Grid north
Measured depths are referenced to H&P 371 (RKB)	Scale: True distance
H&P 371 (RKB) to Mean Sea Level: 995 feet	Depths are in feet
Mean Sea Level to Mud line (At Slot #08) : -958 feet	Created by: Jdotson on 2018-01-10
Coordinates are in feet referenced to Grid	Database: WIA.MPL_EvalmUS.Dat

Location Information

Facility Name	Grid East (US ft)	Grid North (US ft)	Latitude	Longitude		
Meckley Pad	1567241.300	380260.800	39°32'07.060"N	80°55'22.002"W		
Slot	Local N (ft)	Local E (ft)	Grid East (US ft)	Grid North (US ft)	Latitude	Longitude
Slot #08	-4.50	35.70	1567277.000	380256.300	39°32'07.021"N	80°55'21.545"W

BHI AT Curve Axial <8-1/2> (2834')(2980'-3509') : 0.10° Inc, 2980.00ft MD, 2977.78ft TVD, 32.29ft VS

BHI AT Curve <8-1/2> (3509')(3603'-15099') : 15.17° Inc, 3603.00ft MD, 3585.74ft TVD, -62.66ft VS


Design Comment	MD (ft)	Inc (")	Az (°)	TVD (ft)	Local N (ft)	Local E (ft)	DLS (°/100ft)	VS (ft)
Tie On	2834.00	1.070	213.020	2831.79	-8.33	67.93	0.01	31.59
Proj. To Bottom	2905.00	1.070	213.020	2902.78	-9.44	67.21	0.00	32.38
Drill Out Csg - KOP 1	3005.00	1.070	213.020	3002.76	-11.04	66.19	0.00	33.49
End of 3D Arc	3688.77	33.142	20.903	3650.18	163.46	131.34	5.00	-107.11
Curve KOP	5887.13	33.142	20.903	5490.91	1286.22	660.15	0.00	-1008.60
Landing Pt.	7025.55	89.600	159.500	6233.58	911.57	1039.77	10.00	-489.71
BHL	15187.51	89.600	159.500	6290.42	-6714.59	3891.07	0.00	7652.05

Well Data

Slot	Well	Wellbore	Wellpath
Slot #08	Wells Meckley 1405MH	Wells Meckley 1405MH AWP	Wells Meckley 1405MH AWP Proj 15178'
Slot #08	Wells Meckley 1405MH	Wells Meckley 1405MH PWB	Wells Meckley 1405MH PWB Rev-A-D

Projected MD at TD: 15178' : 90.00° Inc, 15178.00ft MD, 6285.14ft TVD, 7662.26ft VS

Vertical Section (ft)
 Azimuth 159.50° with reference 0.00 N, 0.00 E

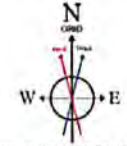

Use specified Dip: 66.74° Field: 5195.7 mT
 Magnetic North is 7.55 degrees West of True North at 21 Dec 2017
 Grid North is 0.91 degrees West of True North
 To correct azimuth from True to Grid add 0.91 degrees
 To correct azimuth from Magnetic to Grid subtract 8.64 degrees

Projected MD at TD: 15178' : 6285.14ft TVD, 6725.92ft S, 3899.92ft E

RECEIVED
 Office of Oil and Gas
 AUG 20 2018
 WV Department of Environmental Protection

ACTUAL WELLPATH REPORT (CSV version)

Prepared by Baker Hughes
Software System: WellArchitect® 5.1

REFERENCE WELLPATH IDENTIFICATION

Operator BLUE RIDGE MOUNTAIN RESOURCES
Area Tyler County, WV
Field Tyler
Facility Meckley Pad
Slot Slot #03
Well Wells Meckley 1405AH
Wellbore Wells Meckley 1405AH AHB
Wellpath Wells Meckley 1405AH AWP Proj: 15178
Sidetrack (none)

REPORT SETUP INFORMATION

Projection NAD83 / Lambert West Virginia SP, Northern Zone (4701), US feet
North Refo Grid
Scale 0.999942
Convergen 0.91 West
Software WellArchitect® 5.1
User Delaset
Report Gen 10/Jan/2018 at 11:46
DataBase: WA_MPL_EasternUS_Defn/ev1120.csv

Table with columns: WELLPATH Local North, Local East, Easting [US Ft], Northing [US Ft], Latitude, Longitude. Includes Slot Locs, Facility Ref, and Field Refer.

WELLPATH DATUM

Calculation Minimum curvature
Horizontal Slot
Vertical Ro M&P 371 (RKB)
MD Refero M&P 371 (RKB)
Field Verce Mean Sea Level
M&P 371 (F 27.00ft)
M&P 371 (F 985.00ft)
M&P 371 (F 27.00ft)
Section Ori N 0.00, E 0.00 ft
Section Azi 159.50°

WELLPATH DATA * = interpolated/extrapolated station

Main data table with columns: MD, Inclination, Azimuth, TVD, Vert Sect, North, East, Grid East, Grid North, Latitude, Longitude, Closure Dir, Closure Dir OLS, Build Rate, Turn Rate, Comments. Contains well path coordinates and measurements.

RECEIVED
Office of Oil and Gas
AUG 20 2018
WV Department of Environmental Protection

13.275in C	27	400	373	27	400	0	0	1.35	-0.13
12.25in Op	400	2882.22	2482.22	400	2880.01	1.35	-0.13	-8.95	67.52
9.625in Cas	27	2882.22	2855.22	27	2880.01	0	0	-8.95	67.52
8.5in Open	2882.22	15177	12294.78	2850.01	6285.14	-8.95	67.52	-67.25	3889.53
5.5in Casing	27	15177	15150	27	6285.14	0	0	67.25	3889.53

TARGETS

Name	TVD	North	East	Grid East	Grid North	Latitude	Longitude	Shape	Comment
	[ft]	[ft]	[ft]	[ft]	[US ft]	[US ft]			
1405AMH U	6233.58	911.57	1039.77	1568317	281167.8	33°32'16.1	80°55'08.4	point	
1405AMH B	6290.42	-6714.59	3891.07	1571168	373542.1	33°31'01.2	80°54'10.5	point	

WELLPATH COMPOSITION Ref Wellbore: Wells Meckley 1405AMH AWD Ref Wellpath: Wells Meckley 1405AMH AWP Proj: 15178

Log Name	Start MD	End MD	Pos Unc	Model
	[ft]	[ft]	[ft]	
Q1_Sperry	27	2834	ISCHUSA MWD, Rev. 4 (Standard)	
Q2_BH AT 1	2834	3509	BH AutoTrak Curve (Aval)	
Q3_BH AT 1	3509	15099	BH AutoTrak Curve (Short)	
Projection	15099	15178	8-rod Drilling (std)	

COMMENTS

Wellpath general comments
 API: 47 095-02155-0000
 BH Job #: 8935154
 Rig: HSP 371
 Duration: 12.23.2017 - 12.29.2017
 Sperry MWD (453'-2829')
 BH AT Curve Aval <S 1/2> (2834'-(2980'-3509'))
 BH AT Curve <B 1/2> (3509'-(15099'))
 Projected MD at TD: 15178

RECEIVED
 Office of Oil and Gas
 AUG 20 2018
 WV Department of
 Environmental Protection