


- A—Straight TM. 11-15 0.88 Ac.
- B—Dotson TM. 11-5.2 1 Ac.
- C—Victory Cemetery TM. 11-30.5 2.7 Ac.
- D—Victory Cemetery TM. 11-30.4 3.76 Ac.
- E—Wilson TM. 11-17.1 0.65 Ac.
- F—Hoover TM. 11-17.2 0.25 Ac. T3048A
- G—Lancaster TM. 11-17.3 0.6 Ac. T3048A1
- H—Hoover TM. 11-17.4 1.12 Ac. T3048A

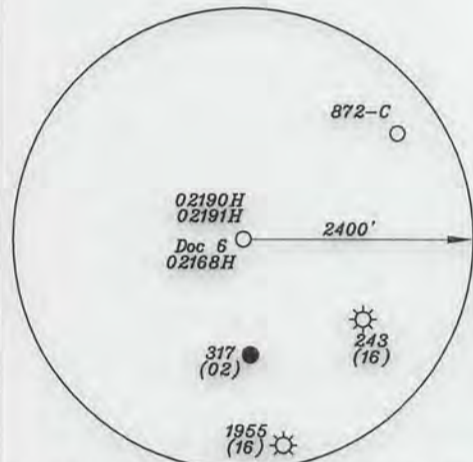

NOTES:
1. CORNER TIES, REFERENCES, PROPERTY LINE INFORMATION, 2400' CIRCLE AND SURFACE OWNERSHIPS WERE TAKEN FROM ERNEST J. BENCHEK III PLAT DATED FEBRUARY 21, 2014. FILE NO. 201369.
2. WELL HEAD WAS FIELD LOCATED BY JACKSON SURVEYING USING RTK GPS AND IS BASED UPON AN OPUS SOLUTION.
3. LEC AND BH LOCATIONS ARE BASED UPON A DRILLING REPORT BY PANTHER DRILLING SYSTEMS DATED 12-11-14 WITH JOB NUMBER NE140039H.

Top Hole	
Geo NAD 83-39.449196 N, 80.768249 W	
UTM NAD83(meter)-4366651.94 N, 519940.20 E	
UTM NAD83(feet)-14326257.22 N, 1705837.13 E	
Landing Point	
Geo NAD 83-39.451682 N, 80.768143 W	
UTM NAD83(meter)-4366927.76 N, 519948.68 E	
UTM NAD83(feet)-14327162.17 N, 1705864.96 E	
Bottom Hole	
Geo NAD 83-39.463153 N, 80.771910 W	
UTM NAD83(meter)-4368200.02 N, 519621.28 E	
UTM NAD83(feet)-14331336.24 N, 1704790.81 E	

Lease No.	
T.M. 6/31	T3136A
T.M. 6/32	T3136B
T.M. 6/33	T3136C
T.M. 6/35.1	T3050C
T.M. 11/8	T3142
T.M. 11/52	T3050B

NORTH

LONGITUDE 80-45-00 W Bottom Hole 1,756' Top Hole 3,328'

(+) DENOTES LOCATION OF WELL ON UNITED STATES TOPOGRAPHIC MAPS

FILE NO. _____
DRAWING NO. 1
SCALE 1" = 2000'
MINIMUM DEGREE OF ACCURACY 1 in 200
PROVEN SOURCE OF ELEVATION GPS
submeter unit

I THE UNDERSIGNED, HEREBY CERTIFY THAT THIS PLAT IS CORRECT TO THE BEST OF MY KNOWLEDGE AND BELIEF AND SHOWS ALL THE INFORMATION REQUIRED BY LAW AND THE RULES ISSUED AND PRESCRIBED BY THE DEPARTMENT OF ENVIRONMENTAL PROTECTION.

(SIGNED) David L Jackson
R.P.E. _____ L.L.S. 708



STATE OF WEST VIRGINIA
Division of Environmental Protection
OFFICE OF OIL AND GAS

DATE January 5, 2016
OPERATOR'S WELL NO. Doc 6
API WELL NO. As Drilled

WELL TYPE: OIL GAS LIQUID INJECTION WASTE DISPOSAL STATE COUNTY PERMIT
(IF "GAS") PRODUCTION X STORAGE DEEP SHALLOW
LOCATION: ELEVATION 1,036.6' WATER SHED Indian Creek of Middle Island Creek
DISTRICT McElroy COUNTY Tyler
QUADRANGLE Shirley 7 1/2'

SURFACE OWNER W.A. & Ida Gaston (1/2) & Stanley H. Tustin (1/2) ACREAGE 46.51± ac.
OIL & GAS ROYALTY OWNER _____ LEASE ACREAGE _____

LEASE NO. _____
PROPOSED WORK: DRILL CONVERT DRILL DEEPER REDRILL FRACTURE DR
STIMULATE PLUG OFF OLD FORMATION PERFORATE NEW
FORMATION X OTHER PHYSICAL CHANGE IN WELL (SPECIFY) As Drilled

PLUG AND ABANDON CLEAN OUT AND REPLUG
TARGET FORMATION Marcellus ESTIMATED DEPTH TVD=6,805' TMD=11,551'
WELL OPERATOR Jay-Bee Oil & Gas, Inc. DESIGNATED AGENT Randy Broda
ADDRESS 1720 Route 22 E, Union, NJ 07083 ADDRESS 3570 Shields Hill Rd., Cairo, WV 26337

06/17/2016