



**west virginia** department of environmental protection

Office of Oil and Gas  
601 57th Street SE  
Charleston, WV 25304  
(304) 926-0450  
(304) 926-0452 fax

Earl Ray Tomblin, Governor  
Randy C. Huffman, Cabinet Secretary  
www.dep.wv.gov

May 28, 2015

**WELL WORK PERMIT**

**Horizontal 6A Well**

This permit, API Well Number: 47-9502248, issued to ANTERO RESOURCES CORPORATION, is evidence of permission granted to perform the specified well work at the location described on the attached pages and located on the attached plat, subject to the provisions of Chapter 22 of the West Virginia Code of 1931, as amended, and all rules and regulations promulgated thereunder, and to all conditions and provisions outlined in the pages attached hereto. Notification shall be given by the operator to the Oil and Gas Inspector at least 24 hours prior to the construction of roads, locations, and/or pits for any permitted work. In addition, the well operator shall notify the same inspector 24 hours before any actual well work is commenced and prior to running and cementing casing. Spills or emergency discharges must be promptly reported by the operator to 1-800-642-3074 and to the Oil and Gas inspector.

Please be advised that form WR-35, Well Operators Report of Well Work is to be submitted to this office within 90 days completion of permitted well work, as should form WR-34 Discharge Monitoring Report within 30 days of discharge of pits, if applicable. Failure to abide by all statutory and regulatory provisions governing all duties and operations hereunder may result in suspension or revocation of this permit and, in addition, may result in civil and/or criminal penalties being imposed upon the operators.

In addition to the applicable requirements of this permit, and the statutes and rules governing oil and gas activity in WV, this permit may contain specific conditions which must be followed. Permit conditions are attached to this cover letter.

Per 35CSR-4-5.2.g this permit will expire in two (2) years from the issue date unless permitted well work is commenced. If there are any questions, please feel free to contact me at (304) 926-0499 ext. 1654.

James Martin

Chief

Operator's Well No: PLUM RUN UNIT 3H

Farm Name: HARTLEY, DAVID M.

**API Well Number: 47-9502248**

**Permit Type: Horizontal 6A Well**

Date Issued: 05/28/2015

**Promoting a healthy environment.**

**05/29/2015**

## PERMIT CONDITIONS

West Virginia Code § 22-6A-8(d) allows the Office of Oil and Gas to place specific conditions upon this permit. Permit conditions have the same effect as law. Failure to adhere to the specified permit conditions may result in enforcement action.

---

### CONDITIONS

---

1. This proposed activity may require permit coverage from the United States Army Corps of Engineers (USACE). Through this permit, you are hereby being advised to consult with USACE regarding this proposed activity.
2. If the operator encounters an unanticipated void, or an anticipated void at an unanticipated depth, the operator shall notify the inspector within 24 hours. Modifications to the casing program may be necessary to comply with W. Va. Code § 22-6A-5a (12), which requires drilling to a minimum depth of thirty feet below the bottom of the void, and installing a minimum of twenty (20) feet of casing. Under no circumstance should the operator drill more than fifty (50) feet below the bottom of the void or install less than twenty (20) feet of casing below the bottom of the void.
3. When compacting fills, each lift before compaction shall not be more than 12 inches in height, and the moisture content of the fill material shall be within limits as determined by the Standard Proctor Density test of the actual soils used in specific engineered fill, ASTM D698, Standard Test Method for Laboratory Compaction Characteristics of Soil Using Standard Effort, to achieve 95 % compaction of the optimum density. Each lift shall be tested for compaction, with a minimum of two tests per lift per acre of fill. All test results shall be maintained on site and available for review.
4. Operator shall install signage per § 22-6A-8g (6) (B) at all source water locations included in their approved water management plan within 24 hours of water management plan activation.
5. Oil and gas water supply wells will be registered with the Office of Oil and Gas and all such wells will be constructed and plugged in accordance with the standards of the Bureau for Public Health set forth in its Legislative rule entitled *Water Well Regulations*, 64 C.S.R. 19. Operator is to contact the Bureau of Public Health regarding permit requirements. In lieu of plugging, the operator may transfer the well to the surface owner upon agreement of the parties. All drinking water wells within fifteen hundred feet of the water supply well shall be flow tested by the operator upon request of the drinking well owner prior to operating the water supply well.
6. Pursuant to the requirements pertaining to the sampling of domestic water supply wells/springs the operator shall, no later than thirty (30) days after receipt of analytical data provide a written copy to the Chief and any of the users who may have requested such analyses.
7. If any explosion or other accident causing loss of life or serious personal injury occurs in or about a well or well work on a well, the well operator or its contractor shall give notice, stating the particulars of the explosion or accident, to the oil and gas inspector and the Chief, within 24 hours of said accident.
8. During the casing and cementing process, in the event cement does not return to the surface, the oil and gas inspector shall be notified within 24 hours.
9. Operator shall provide the Office of Oil & Gas notification of the date that drilling commenced on this well. Such notice shall be provided by sending an email to [DEPOOGNotify@wv.gov](mailto:DEPOOGNotify@wv.gov) within 30 days of commencement of drilling.



STATE OF WEST VIRGINIA  
DEPARTMENT OF ENVIRONMENTAL PROTECTION, OFFICE OF OIL AND GAS  
WELL WORK PERMIT APPLICATION

1) Well Operator: Antero Resources Corporation 494488557 095 - Tyler Meade Pennsboro 7.5'  
Operator ID County District Quadrangle

2) Operator's Well Number: Plum Run Unit 3H Well Pad Name: Existing Hartley East Pad

3) Farm Name/Surface Owner: Hartley, David M. Public Road Access: CR 6/8

4) Elevation, current ground: 1021' Elevation, proposed post-construction: 1021'

5) Well Type (a) Gas  Oil  Underground Storage   
Other

(b) If Gas Shallow  Deep   
Horizontal

6) Existing Pad: Yes or No Yes

*Michael Hoff*  
*3/26/15*

7) Proposed Target Formation(s), Depth(s), Anticipated Thickness and Associated Pressure(s):  
Marcellus Shale: 6500' TVD, Anticipated Thickness- 75 feet, Associated Pressure- 2800#

8) Proposed Total Vertical Depth: 6500' TVD

9) Formation at Total Vertical Depth: Marcellus Shale

10) Proposed Total Measured Depth: 18,000' MD

11) Proposed Horizontal Leg Length: 10,744'

12) Approximate Fresh Water Strata Depths: 180'

13) Method to Determine Fresh Water Depths: Freeland Unit 2H (API# 47-095-02127) on same pad.

14) Approximate Saltwater Depths: 577', 730', 1753'

15) Approximate Coal Seam Depths: None reported

16) Approximate Depth to Possible Void (coal mine, karst, other): None anticipated

17) Does Proposed well location contain coal seams directly overlying or adjacent to an active mine? Yes  No

(a) If Yes, provide Mine Info: Name: \_\_\_\_\_  
Depth: \_\_\_\_\_  
Seam: \_\_\_\_\_  
Owner: \_\_\_\_\_

Received  
Office of Oil & Gas  
MAR 27 2015

WW-6B  
(9/13)

18)

**CASING AND TUBING PROGRAM**

<b>TYPE</b>	<b>Size</b>	<b>New or Used</b>	<b>Grade</b>	<b>Weight per ft. (lb/ft)</b>	<b>FOOTAGE: For Drilling</b>	<b>INTERVALS: Left in Well</b>	<b>CEMENT: Fill-up (Cu. Ft.)</b>
Conductor	20"	New	H-40	94#	40'	40'	CTS, 38 Cu. Ft.
Fresh Water	13-3/8"	New	J-55/H-40	54.5#/48#	300'	300'	CTS, 417 Cu. Ft.
Coal	9-5/8"	New	J-55	36#	2455'	2455'	CTS, 1000 Cu. Ft.
Intermediate							
Production	5-1/2"	New	P-110	20#	18,000'	18,000'	4556 Cu. Ft.
Tubing	2-3/8"	New	N-80	4.7#		7,100'	
Liners							

*MDC  
3/26/15*

<b>TYPE</b>	<b>Size</b>	<b>Wellbore Diameter</b>	<b>Wall Thickness</b>	<b>Burst Pressure</b>	<b>Cement Type</b>	<b>Cement Yield (cu. ft./k)</b>
Conductor	20"	24"	0.438"	1530	Class A	1.18
Fresh Water	13-3/8"	17-1/2"	0.38"/0.33"	2730/1730	Class A	1.18
Coal	9-5/8"	12-1/4"	0.352"	3520	Class A	1.18
Intermediate						
Production	5-1/2"	8-3/4" & 8-1/2"	0.361"	12630	Lead-H/POZ & Tail - H	H/POZ-1.44 & H-1.8
Tubing	2-3/8"	4.778"	0.19"	11200		
Liners						

**PACKERS**

Kind:	N/A			
Sizes:	N/A			
Depths Set:	N/A			

Received  
Office of Oil & Gas  
MAR 27 2015

WW-6B  
(9/13)

19) Describe proposed well work, including the drilling and plugging back of any pilot hole:

Drill, perforate, fracture a new horizontal shallow well and complete Marcellus Shale.

20) Describe fracturing/stimulating methods in detail, including anticipated max pressure and max rate:

Antero plans to pump Slickwater into the Marcellus Shale formation in order to ready the well for production. The fluid will be comprised of approximately 99 percent water and sand, with less than 1 percent special-purpose additives as shown in the attached "List of Anticipated Additives Used for Fracturing or Stimulating Well."

Anticipated Max Pressure - 9300 lbs  
Anticipated Max Rate - 80 bpm

21) Total Area to be disturbed, including roads, stockpile area, pits, etc., (acres): 13.08 existing acres

22) Area to be disturbed for well pad only, less access road (acres): 2.68 existing acres

23) Describe centralizer placement for each casing string:

Conductor: no centralizers

Surface Casing: one centralizer 10' above the float shoe, one on the insert float collar and one every 4th joint spaced up the hole to surface.

Intermediate Casing: one centralizer above float joint, one centralizer 5' above float collar and one every 4th collar to surface.

Production Casing: one centralizer at shoe joint and one every 3 joints to top of cement in intermediate casing.

24) Describe all cement additives associated with each cement type:

Conductor: no additives, Class A cement.

Surface: Class A cement with 2-3% calcium chloride and 1/4 lb of flake

Intermediate: Class A cement with 1/4 lb of flake, 5 gallons of clay treat

Production: Lead cement- 50/50 Class H/Poz + 1.5% salt + 1% C-45 + 0.5% C-16a + 0.2% C-12 + 0.45% C-20 + 0.05% C-51

Production: Tail cement- Class H + 45 PPS Calcium Carbonate + 1.0% FL-160 + 0.2% ACGB-47 + 0.05% ACSA-51 + 0.2% ACR-20

25) Proposed borehole conditioning procedures:

Conductor: blowhole clean with air, run casing, 10 bbls fresh water.

Surface: blowhole clean with air, trip to conductor shoe, trip to bottom, blowhole clean with air, trip out, run casing, circulate pipe capacity + 40 bbls fresh water followed by 25 bbls bentonite mud, 10 bbls fresh water spacer.

Intermediate: blowhole clean with air, trip to surface casing shoe, trip to bottom, blowhole clean with air, trip out, run casing, circulate 40 bbls brine water followed by 10 bbls fresh water and 25 bbls bentonite mud, pump 10 bbls fresh water.

Production: circulate with 14 lb/gal NaCl mud, trip to middle of lateral, circulate, pump high viscosity sweep, trip to base of curve, pump high viscosity sweep, trip to top of curve, trip to bottom, circulate, pump high viscosity sweep, trip out, run casing, circulate 10 bbls fresh water, pump 48 bbls barite pill, pump 10 bbls fresh water followed by 48 bbls mud flush and 10 bbls water.

\*Note: Attach additional sheets as needed.



API Number 47 - 095 - \_\_\_\_\_  
Operator's Well No. Plum Run Unit 3H

STATE OF WEST VIRGINIA  
DEPARTMENT OF ENVIRONMENTAL PROTECTION  
OFFICE OF OIL AND GAS

FLUIDS/ CUTTINGS DISPOSAL & RECLAMATION PLAN

Operator Name Antero Resources Corporation OP Code 494488557

Watershed (HUC 10) Outlet Middle Island Creek Quadrangle Pennsboro 7.5'

Do you anticipate using more than 5,000 bbls of water to complete the proposed well work? Yes  No

Will a pit be used? Yes  No

If so, please describe anticipated pit waste: No pit will be used at this site (Drilling and Flowback Fluids will be stored in tanks. Cuttings will be tanked and hauled off site)

Will a synthetic liner be used in the pit? Yes  No  If so, what ml.? N/A

Proposed Disposal Method For Treated Pit Wastes:

- Land Application
- Underground Injection ( UIC Permit Number \_\_\_\_\_ )
- Reuse (at API Number Future permitted well locations when applicable. API# will be provided on Form WR-34 )
- Off Site Disposal (Supply form WW-9 for disposal location) (Meadowfill Landfill Permit #SWF-1032-98)
- Other (Explain \_\_\_\_\_)

*MAG  
3/26/15*

Will closed loop system be used? If so, describe: Yes

Drilling medium anticipated for this well (vertical and horizontal)? Air, freshwater, oil based, etc. Surface - Air/Freshwater, Intermediate - Dust/Stiff Foam, Production - Water Based Mud

-If oil based, what type? Synthetic, petroleum, etc. N/A

Additives to be used in drilling medium? Please See Attachment

Drill cuttings disposal method? Leave in pit, landfill, removed offsite, etc. Stored in tanks, removed offsite and taken to landfill.

-If left in pit and plan to solidify what medium will be used? (cement, lime, sawdust) N/A

-Landfill or offsite name/permit number? Meadowfill Landfill (Permit #SWF-1032-98)

Permittee shall provide written notice to the Office of Oil and Gas of any load of drill cuttings or associated waste rejected at any West Virginia solid waste facility. The notice shall be provided within 24 hours of rejection and the permittee shall also disclose where it was properly disposed.

I certify that I understand and agree to the terms and conditions of the GENERAL WATER POLLUTION PERMIT issued on August 1, 2005, by the Office of Oil and Gas of the West Virginia Department of Environmental Protection. I understand that the provisions of the permit are enforceable by law. Violations of any term or condition of the general permit and/or other applicable law or regulation can lead to enforcement action.

I certify under penalty of law that I have personally examined and am familiar with the information submitted on this application form and all attachments thereto and that, based on my inquiry of those individuals immediately responsible for obtaining the information, I believe that the information is true, accurate, and complete. I am aware that there are significant penalties for submitting false information, including the possibility of fine or imprisonment.

Company Official Signature *[Signature]*  
Company Official (Typed Name) Amanda Fernley  
Company Official Title Environmental Manager

NATALIE KOMP  
NOTARY PUBLIC  
STATE OF COLORADO  
NOTARY ID # 2014028170  
MY COMMISSION EXPIRES JULY 18, 2018

Received  
Office of Oil & Gas

MAR 27 2015

Subscribed and sworn before me this 20<sup>th</sup> day of March, 20 15

*Natalie K* Notary Public

My commission expires July 18, 2018



Antero Resources Corporation

Proposed Revegetation Treatment: Acres Disturbed 13.08 Prevegetation pH

Lime 2-3 Tons/acre or to correct to pH 6.5

Fertilizer type Hay or straw or Wood Fiber (will be used where needed)

Fertilizer amount 500 lbs/acre

Mulch 2-3 Tons/acre

Existing Entrance Road A (1.70) + Existing Water Containment Pad B (0.53) + Existing Access Road A (3.80) + Existing Access Road B (0.09) + Existing Access Road C (0.28) + Existing Excess Material Stockpile B (0.73) + Existing Production Equipment Pad (0.63) + Existing Well Pad (2.68) + Existing Water Containment Pad A (1.33) + Existing Excess Material Stockpile A (1.31) = 13.08 Existing Acres

Seed Mixtures

Temporary		Permanent	
Seed Type	lbs/acre	Seed Type	lbs/acre
Tall Fescue	45	Tall Fescue	45
Perennial Rye Grass	20	Perennial Rye Grass	20
*or type of grass seed requested by surface owner		*or type of grass seed requested by surface owner	

Attach:

Drawing(s) of road, location, pit and proposed area for land application (unless engineered plans including this info have been provided)

Photocopied section of involved 7.5' topographic sheet.

Plan Approved by: Michael Gaff

Comments: Preseed & mulch any disturbed areas per WVDEP regulations. Maintain & upgrade E-n-s as necessary.

Received Office of Oil & Gas

Title: Oil & Gas Inspector

Date: 3/26/15

MAR 27 2015

Field Reviewed? (X) Yes ( ) No

***Form WW-9 Additives Attachment*****SURFACE INTERVAL**

1. Fresh Water
2. Soap –Foamer AC
3. Air

**INTERMEDIATE INTERVAL*****STIFF FOAM RECIPE:***

- 1) 1 ppb Soda Ash / Sodium Carbonate-Alkalinity Control Agent
- 2) 1 ppb Conqor 404 ( 11.76 ppg) / Corrosion Inhibitor
- 3) 4 ppb KLA-Gard ( 9.17 ppg) / Amine Acid Complex-Shale Stabilizer
- 4) 1ppb Mil Pac R / Sodium Carboxymethylcellulose-Filtration Control Agent
- 5) 12 ppb KCL / Potassium Chloride-inorganic Salt
- 6) Fresh Water 80 bbls
- 7) Air

**PRODUCTION INTERVAL**

1. Alpha 1655  
Salt Inhibitor
2. Mil-Carb  
Calcium Carbonate
3. Cottonseed Hulls  
Cellulose-Cottonseed Pellets – LCM
4. Mil-Seal  
Vegetable, Cotton & Cellulose-Based Fiber Blend – LCM
5. Clay-Trol  
Amine Acid Complex – Shale Stabilizer
6. Xan-Plex  
Viscosifier For Water Based Muds
7. Mil-Pac (All Grades)  
Sodium Carboxymethylcellulose – Filtration Control Agent
8. New Drill  
Anionic Polyacrylamide Copolymer Emulsion – Shale Stabilizer
9. Caustic Soda  
Sodium Hydroxide – Alkalinity Control
10. Mil-Lime  
Calcium Hydroxide – Lime
11. LD-9  
Polyether Polyol – Drilling Fluid Defoamer
12. Mil Mica  
Hydro-Biotite Mica – LCM

Received  
Office of Oil & Gas  
MAR 27 2015



13. Escaid 110  
Drilling Fluid Solvent – Aliphatic Hydrocarbon
14. Ligco  
Highly Oxidized Leonardite – Filtration Control Agent
15. Super Sweep  
Polypropylene – Hole Cleaning Agent
16. Sulfatrol K  
Drilling Fluid Additive – Sulfonated Asphalt Residuum
17. Sodium Chloride, Anhydrous  
Inorganic Salt
18. D-D  
Drilling Detergent – Surfactant
19. Terra-Rate  
Organic Surfactant Blend
20. W.O. Defoam  
Alcohol-Based Defoamer
21. Perma-Lose HT  
Fluid Loss Reducer For Water-Based Muds
22. Xan-Plex D  
Polysaccharide Polymer – Drilling Fluid Viscosifier
23. Walnut Shells  
Ground Cellulosic Material – Ground Walnut Shells – LCM
24. Mil-Graphite  
Natural Graphite – LCM
25. Mil Bar  
Barite – Weighting Agent
26. X-Cide 102  
Biocide
27. Soda Ash  
Sodium Carbonate – Alkalinity Control Agent
28. Clay Trol  
Amine Acid complex – Shale Stabilizer
29. Sulfatrol  
Sulfonated Asphalt – Shale Control Additive
30. Xanvis  
Viscosifier For Water-Based Muds
31. Milstarch  
Starch – Fluid Loss Reducer For Water Based Muds
32. Mil-Lube  
Drilling Fluid Lubricant

Received  
Office of Oil & Gas  
MAR 27 2015



## Well Site Safety Plan Antero Resources

**Well Name:** Woodward Unit 1H, Woodward Unit 2H,  
Woodworth Unit 3H, Freeland Unit 1H,  
Freeland Unit 2H, Plum Run Unit 1H, Plum Run  
Unit 2H, Plum Run Unit 3H

*Michael Loff*  
*3/26/15*

**Pad Location:** HARTLEY EAST PAD  
Tyler County/ Meade District

**GPS Coordinates:** Lat 39°21'55.16"/Long 80°59'35.07" (NAD83)


### Driving Directions:

From the intersection of Main Street and US 50 near Ellenboro, head North 0.2 miles toward Ritchie County School Road. Take the second right onto County Road 50/39/Old US 50W/Washington Street for 1.4 miles. Turn left on County Road 1/Hitchcock Run and follow for approximately 5.7 miles. Continue on County Route 5/Freeland-Hebron Road and follow for approximately 1.1 miles. Turn right onto County Route 3/2 and follow for approximately 0.4 miles. Continue on County Road 32/Plum Run Road for about 0.3 miles. Turn right onto Brush Run Road/County Road 6/5/Plum Run Road and follow for about 0.4 miles. Take a slight left onto Ricky Run and follow for approximately 0.4 miles. Access Road will be on left.

Received  
Office of Oil & Gas  
MAR 27 2015

**EMERGENCY (24 HOUR) CONTACT 1-800-878-1373**



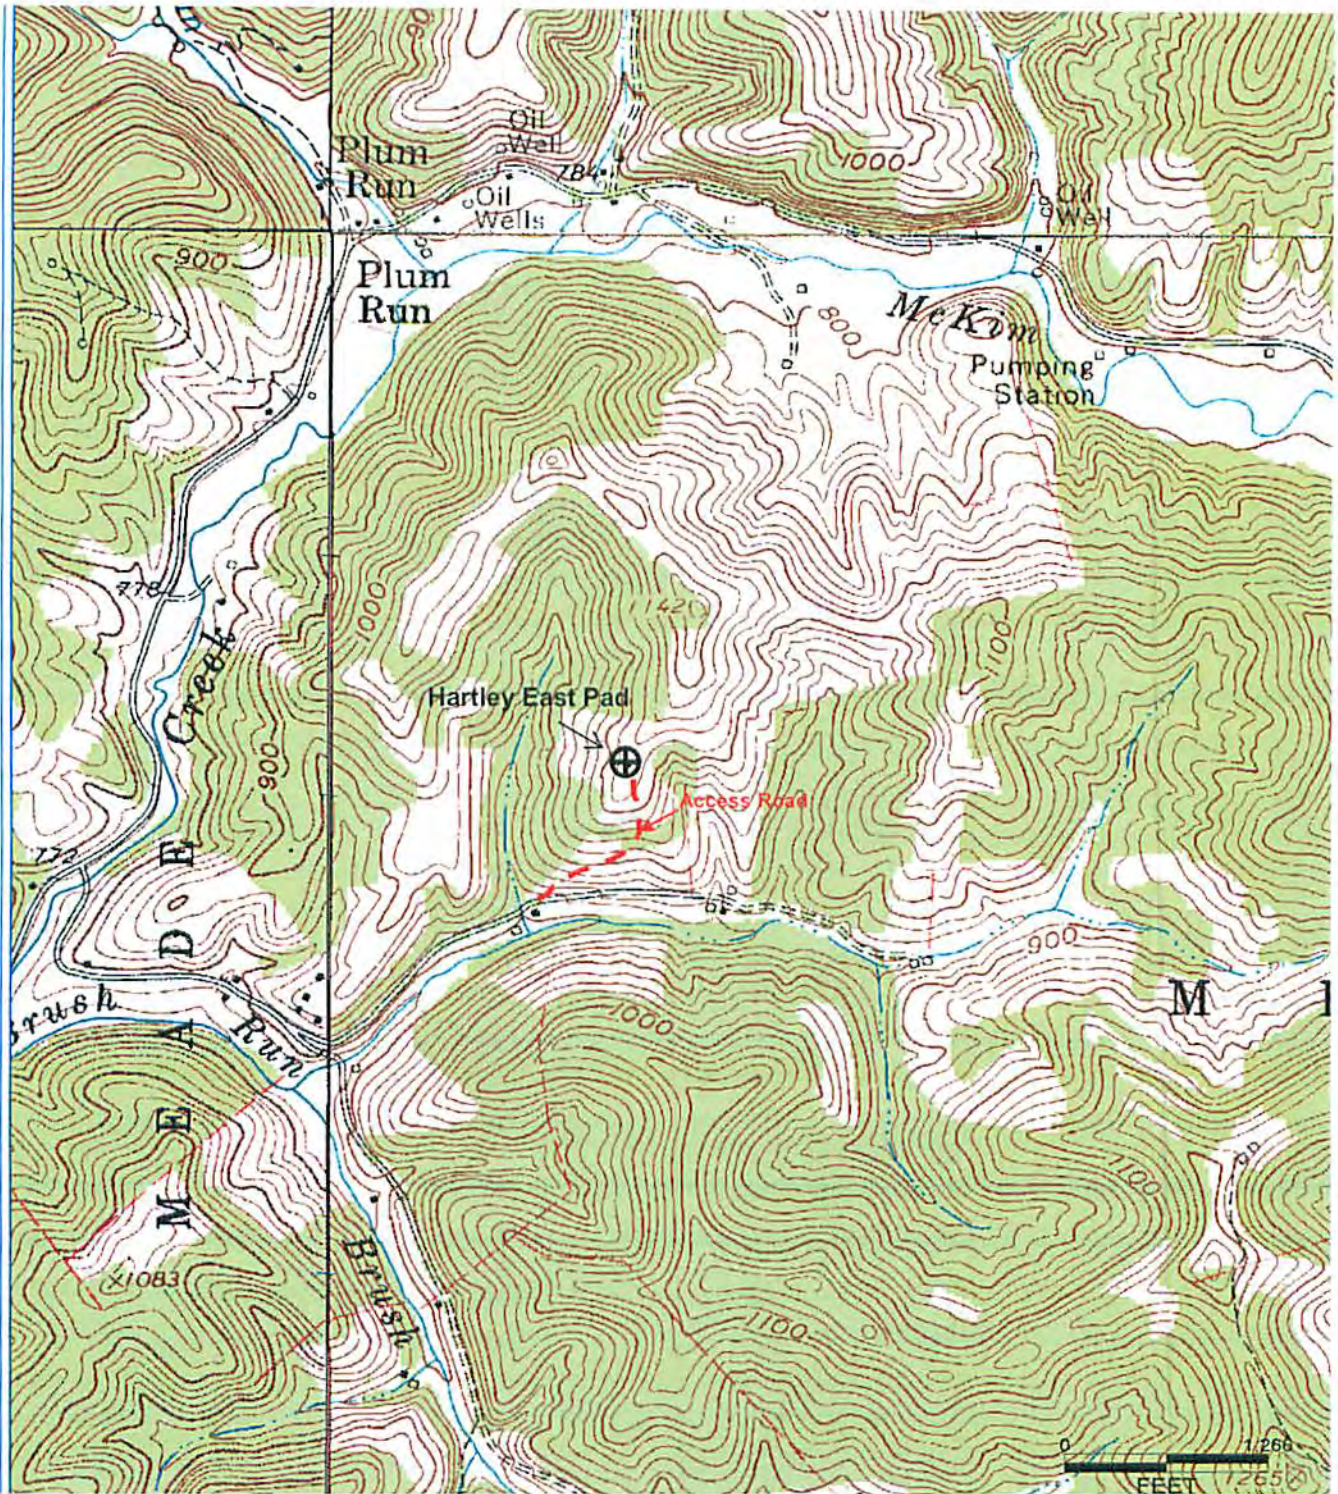

Received  
Office of Oil & Gas  
MAR 27 2015

**Antero Resources Corporation**

Appalachian Basin  
Plum Run Unit 3H  
Tyler County

Quadrangle: Ellenboro & Pennsboro  
Watershed: Middle Island Creek  
District: Meade  
Date: 7-26-2013




LATITUDE 39°22'30"

9,873'

LATITUDE 39°22'30"


LONGITUDE 80°57'30"

LONGITUDE 80°57'30"

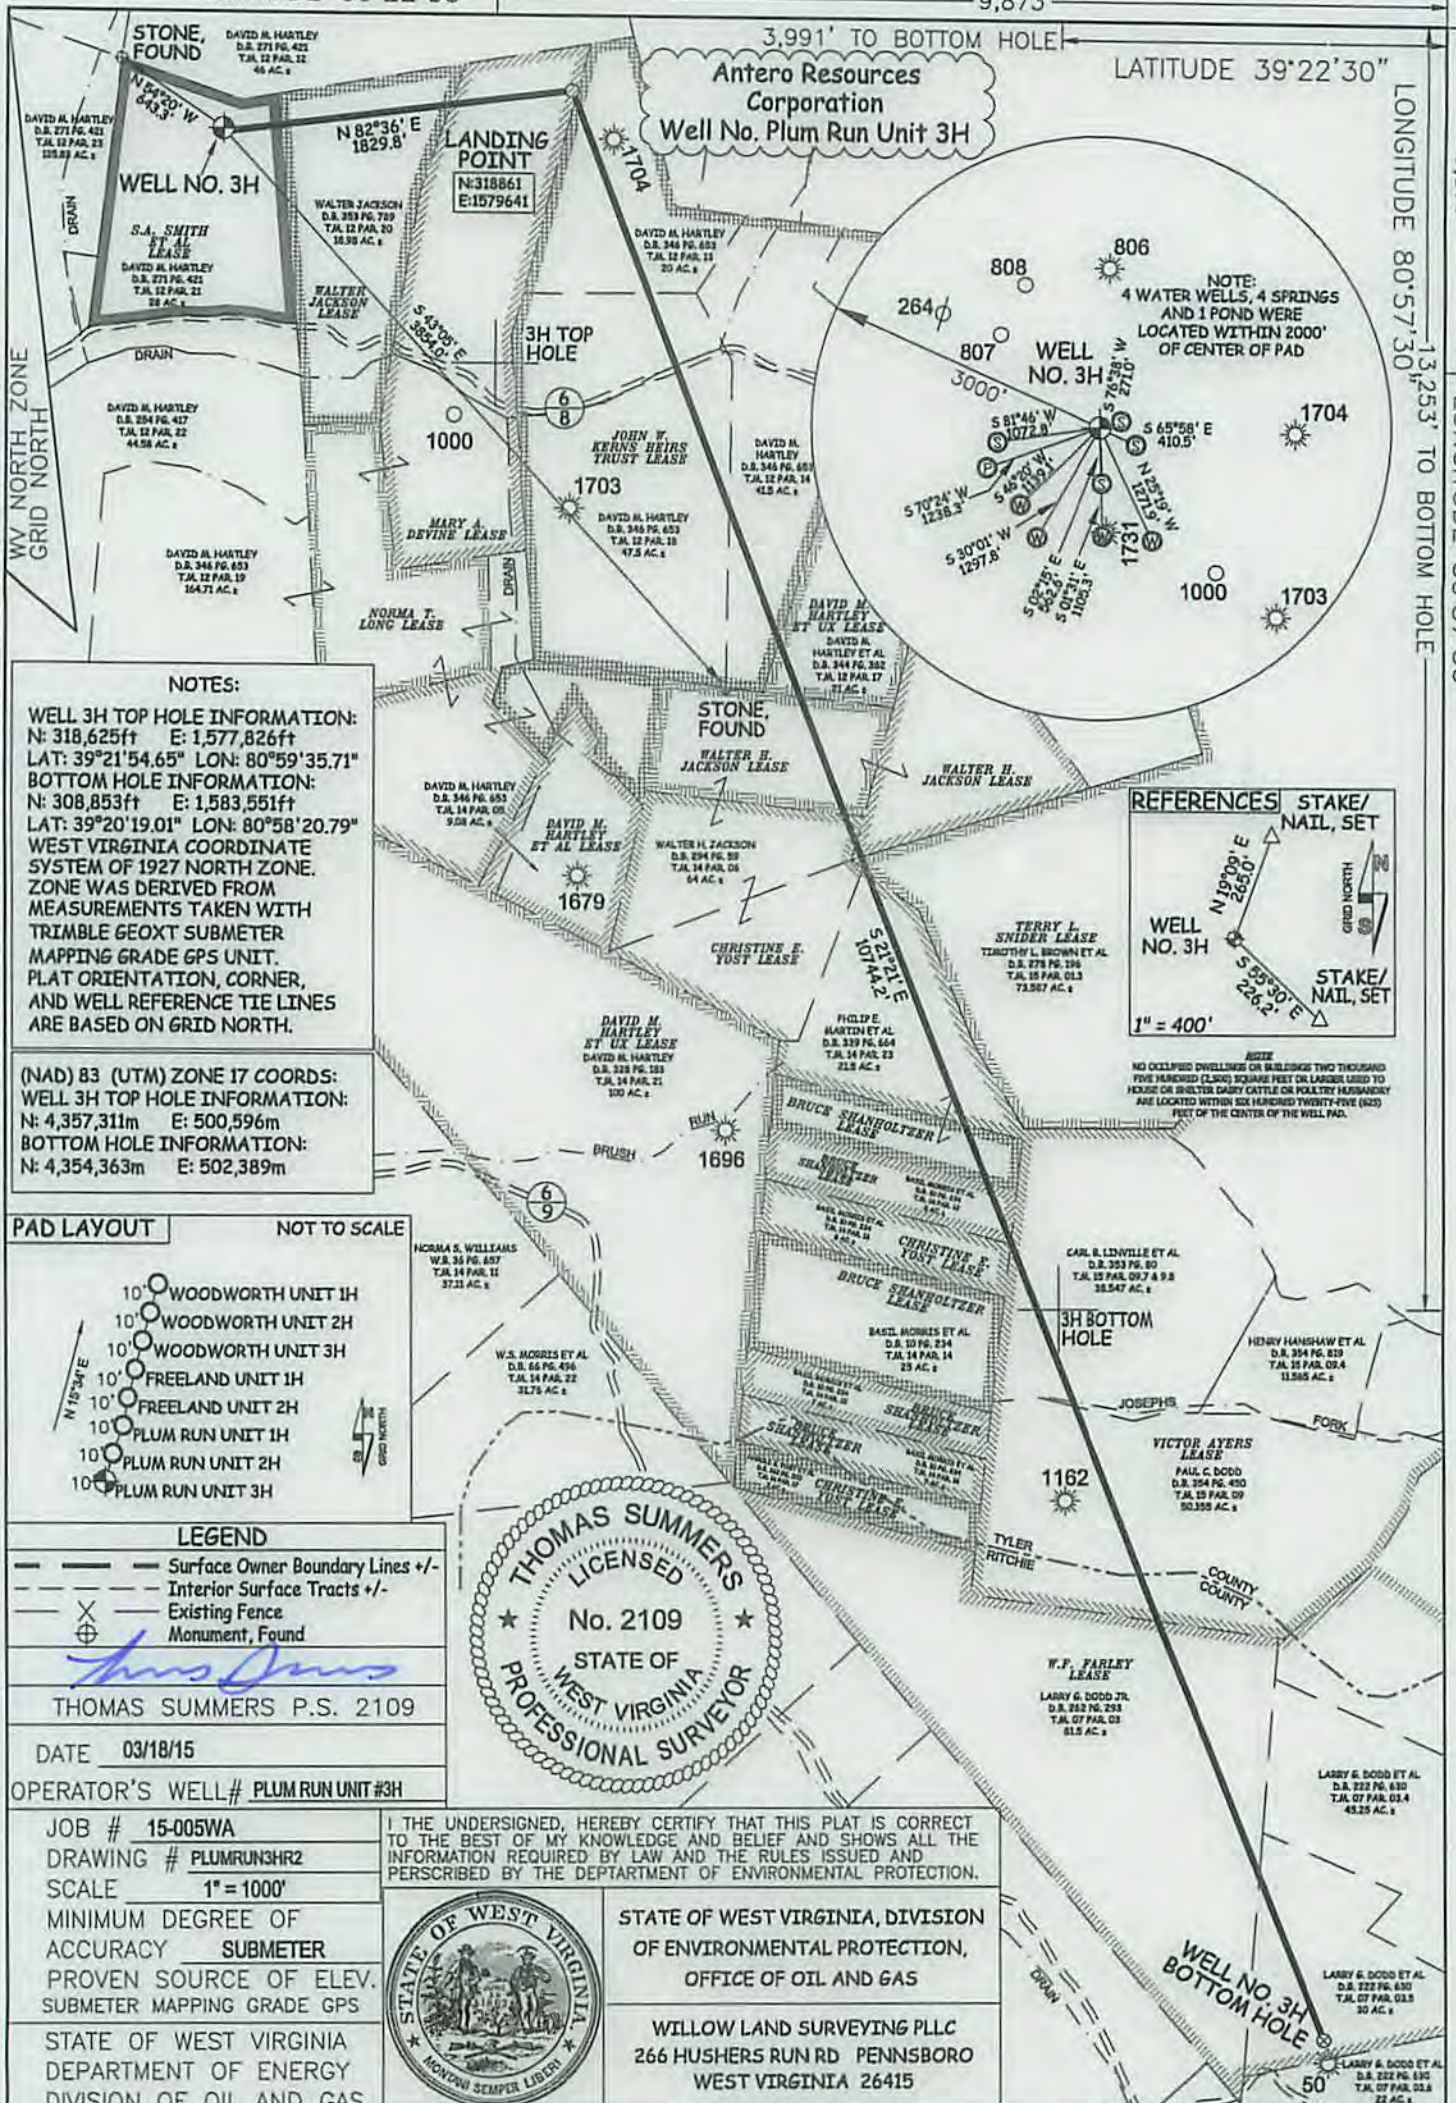

**NOTES:**  
 WELL 3H TOP HOLE INFORMATION:  
 N: 318,625ft E: 1,577,826ft  
 LAT: 39°21'54.65" LON: 80°59'35.71"  
 BOTTOM HOLE INFORMATION:  
 N: 308,853ft E: 1,583,551ft  
 LAT: 39°20'19.01" LON: 80°58'20.79"  
 WEST VIRGINIA COORDINATE SYSTEM OF 1927 NORTH ZONE. ZONE WAS DERIVED FROM MEASUREMENTS TAKEN WITH TRIMBLE GEOXT SUBMETER MAPPING GRADE GPS UNIT. PLAT ORIENTATION, CORNER, AND WELL REFERENCE TIE LINES ARE BASED ON GRID NORTH.

(NAD) 83 (UTM) ZONE 17 COORDS:  
 WELL 3H TOP HOLE INFORMATION:  
 N: 4,357,311m E: 500,596m  
 BOTTOM HOLE INFORMATION:  
 N: 4,354,363m E: 502,389m

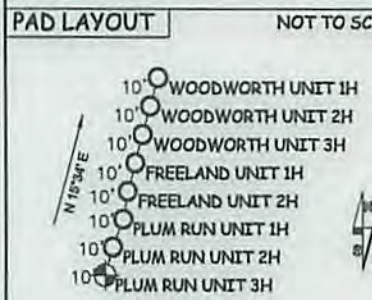

**LEGEND**  
 - - - Surface Owner Boundary Lines +/-  
 - - - Interior Surface Tracts +/-  
 X Existing Fence  
 ⊕ Monument, Found

THOMAS SUMMERS P.S. 2109  
 DATE 03/18/15  
 OPERATOR'S WELL# PLUM RUN UNIT #3H

JOB # 15-005WA  
 DRAWING # PLUMRUN3HR2  
 SCALE 1" = 1000'  
 MINIMUM DEGREE OF ACCURACY SUBMETER  
 PROVEN SOURCE OF ELEV. SUBMETER MAPPING GRADE GPS

I THE UNDERSIGNED, HEREBY CERTIFY THAT THIS PLAT IS CORRECT TO THE BEST OF MY KNOWLEDGE AND BELIEF AND SHOWS ALL THE INFORMATION REQUIRED BY LAW AND THE RULES ISSUED AND PERSCRIBED BY THE DEPARTMENT OF ENVIRONMENTAL PROTECTION.



STATE OF WEST VIRGINIA, DIVISION OF ENVIRONMENTAL PROTECTION, OFFICE OF OIL AND GAS  
 WILLOW LAND SURVEYING PLLC  
 266 HUSHERS RUN RD PENNSBORO WEST VIRGINIA 26415

STATE OF WEST VIRGINIA DEPARTMENT OF ENERGY DIVISION OF OIL AND GAS

WELL TYPE: OIL GAS  LIQUID INJECTION \_\_\_\_\_ WASTE DISPOSAL \_\_\_\_\_ API WELL # 47 - 095 - 02248

(IF "GAS") PRODUCTION  STORAGE \_\_\_\_\_ DEEP \_\_\_\_\_ SHALLOW

LOCATION: ELEVATION ORIGINAL 1,031' - PROPOSED 1,021' WATERSHED OUTLET MIDDLE ISLAND CREEK STATE COUNTY TYLER PERMIT 05/29/2015

QUADRANGLE PENNSBORO 7.5' DISTRICT MEADE COUNTY TYLER

SURFACE OWNER DAVID M. HARTLEY ACREAGE 28 ACRES +/-

OIL & GAS ROYALTY OWNER S.A. SMITH ET AL; WALTER JACKSON; MARY A. DEVINE; JOHN W. KERNS HEIRS TRUST; LEASE ACREAGE 28 AC +/-; 24.0125 AC +/-; 40 AC +/-; 109 AC +/-; DAVID M. HARTLEY ET AL; WALTER H. JACKSON; CHRISTINE E. YOST; WALTER H. JACKSON; TERRY L. SNIDER; BRUCE SHANHOLTZER; BRUCE SHANHOLTZER; VICTOR AYERS; W.F. FARLEY 21 AC +/-; 14.5 AC +/-; 52.125 AC +/-; 19.38 AC +/-; 221.24 AC +/-; 8 AC +/-; 8 AC +/-; 167.5 AC +/-; 192 AC +/-

PROPOSED WORK: DRILL  CONVERT \_\_\_\_\_ DRILL DEEPER \_\_\_\_\_ REDRILL \_\_\_\_\_ FRACTURE OR STIMULATE  PLUG OFF OLD FORMATION \_\_\_\_\_ PERFORATE NEW FORMATION  OTHER PHYSICAL CHANGE IN WELL (SPECIFY) \_\_\_\_\_ PLUG & ABANDON CLEAN OUT & REPLUG

TARGET FORMATION MARCELLUS ESTIMATED DEPTH 6,500' TVD 18,000' MD

WELL OPERATOR ANTERO RESOURCES CORP. DESIGNATED AGENT DIANNA STAMPER  
 ADDRESS 1615 WYNKOOP STREET ADDRESS 5400 D BIG TYLER ROAD  
 DENVER, CO 80202 CHARLESTON, WV 25313



WW-6A1

Operator's Well Number Plum Run Unit 3H

INFORMATION SUPPLIED UNDER WEST VIRGINIA CODE  
Chapter 22, Article 6A, Section 5(a)(5)  
IN LIEU OF FILING LEASE(S) AND OTHER CONTINUING CONTRACT(S)

Under the oath required to make the verification on page 1 of this Notice and Application, I depose and say that I am the person who signed the Notice and Application for the Applicant, and that –

(1) the tract of land is the same tract described in this Application, partly or wholly depicted in the accompanying plat, and described in the Construction and Reclamation Plan;

(2) the parties and recordation data (if recorded) for lease(s) or other continuing contract(s) by which the Applicant claims the right to extract, produce or market the oil or gas are as follows:

Grantor, lessor, etc.	Grantee, lessee, etc.	Royalty	Book/Page
<u>S.A. Smith, et al Lease</u> S.A. Smith, et al	Antero Resources Corporation	1/8+	0434/0609
<u>Walter Jackson Lease</u> Walter Jackson	Antero Resources Corporation	1/8+	0442/0385
<u>Mary A. Devine Lease</u> Mary Ann Devine	Antero Resources Corporation	1/8+	0471/0609
<u>John W. Kerns Heirs Trust Lease</u> John W. Kerns Heirs Trust Alliance Petroleum Corporation Antero Resources Appalachian Corporation	Alliance Petroleum Corporation Antero Resources Appalachian Corporation Antero Resources Corporation	1/8 Assignment Name Change	0333/0035 0390/0568 Exhibit 1
<u>David M. Hartley, et ux Lease</u> David M. Hartley Antero Resources Appalachian Corporation	Antero Resources Corporation Antero Resources Corporation	1/8+ Name Change	0458/0036 Exhibit 1
<u>Walter H. Jackson Lease</u> Walter Jackson	Antero Resources Corporation	1/8+	0476/0228
<u>Walter H. Jackson Lease</u> Walter Jackson Antero Resources Appalachian Corporation	Antero Resources Appalachian Corporation Antero Resources Corporation	1/8+ Name Change	0440/0269 Exhibit 1
<u>Christine E. Yost Lease</u> Christine E. Yost Rockford Energy, LLC	Rockford Energy, LLC Antero Resources Corporation	1/8+ Assignment	0405/0305 0438/0019
<u>Terry L. Snider Lease</u> Terry L. Snider	Antero Resources Corporation	1/8+	0430/0824
<u>Bruce Shanholtzer Lease</u> Bruce Shanholtzer	Antero Resources Corporation	1/8+	0471/0625

\*Partial Assignments to Antero Resources Corporation include 100% rights to extract, produce and market the oil and gas from the Marcellus and any other formations completed with this well.

Received  
Office of Oil & Gas  
MAR 27 2015  
\*\*CONTINUED ON NEXT PAGE\*\*

05/29/2015

Operator's Well Number Plum Run Unit 3H

INFORMATION SUPPLIED UNDER WEST VIRGINIA CODE  
 Chapter 22, Article 6A, Section 5(a)(5)  
 IN LIEU OF FILING LEASE(S) AND OTHER CONTINUING CONTRACT(S)

Under the oath required to make the verification on page 1 of this Notice and Application, I depose and say that I am the person who signed the Notice and Application for the Applicant, and that –

- (1) the tract of land is the same tract described in this Application, partly or wholly depicted in the accompanying plat, and described in the Construction and Reclamation Plan;
- (2) the parties and recordation data (if recorded) for lease(s) or other continuing contract(s) by which the Applicant claims the right to extract, produce or market the oil or gas are as follows:

Grantor, lessor, etc.	Grantee, lessee, etc.	Royalty	Book/Page
<u>Victor Ayers Lease</u>			
Victor Ayers	Consolidated Gas Supply Corporation	1/8	0182/0175
Consolidated Gas Supply Corporation	Consolidated Gas Transmission Corporation	Assignment	0249/0287
Consolidated Gas Transmission Corporation	CNG Development Company	Name Change	0253/0057
CNG Development Company	CNG Producing Company	Name Change	Exhibit 2
CNG Producing Company	Dominion Exploration & Production, Inc.	Name Change	Harrison County AOI 0058/0366
Dominion Exploration & Production, Inc.	Consol Gas Company	Certificate of Amendment to the Certificate of Authority	Doddridge County DB 0286/0144
Consol Gas Company	CNX Gas Company, LLC	Notice of Name Changes and Mergers	Doddridge County DB 0292/0469
CNX Gas Company, LLC	Antero Resources Corporation	*Partial Term Assignment of Oil & Gas Leases	0468/0496

\*Partial Assignments to Antero Resources Corporation include 100% rights to extract, produce and market the oil and gas from the Marcellus and any other formations completed with this well.

**\*\*CONTINUED ON NEXT PAGE\*\***

Received  
 Office of Oil & Gas  
 MAR 27 2015



WW-6A1  
(5/13)

Operator's Well No. Plum Run Unit 3H

**INFORMATION SUPPLIED UNDER WEST VIRGINIA CODE  
Chapter 22, Article 6A, Section 5(a)(5)  
IN LIEU OF FILING LEASE(S) AND OTHER CONTINUING CONTRACT(S)**

Under the oath required to make the verification on page 1 of this Notice and Application, I depose and say that I am the person who signed the Notice and Application for the Applicant, and that –

- (1) the tract of land is the same tract described in this Application, partly or wholly depicted in the accompanying plat, and described in the Construction and Reclamation Plan;
- (2) the parties and recordation data (if recorded) for lease(s) or other continuing contract(s) by which the Applicant claims the right to extract, produce or market the oil or gas are as follows:

Lease Name or Number	Grantor, Lessor, etc.	Grantee, Lessee, etc.	Royalty	Book/Page
<u>W.F. Farley Lease</u>				
	W.F. Farley, et al	Ruth A. McBurney	1/8+	0068/0226
	Ruth A. McBurney	Carl Perkins	Assignment	0086/0514
	Carl D. Perkins	Perkins Oil & Gas, Inc.	Assignment	0232/0060
	Perkins Oil & Gas, Inc., a West Virginia Corp.	Antero Resources Corporation	Assignment	0264/1045

\*Partial Assignments to Antero Resources Corporation include 100% rights to extract, produce and market the oil and gas from the Marcellus and any other formations completed with this well.

**Acknowledgement of Possible Permitting/Approval  
In Addition to the Office of Oil and Gas**


The permit applicant for the proposed well work addressed in this application hereby acknowledges the possibility of the need for permits and/or approvals from local, state, or federal entities in addition to the DEP, Office of Oil and Gas, including but not limited to the following:

- WV Division of Water and Waste Management
- WV Division of Natural Resources WV Division of Highways
- U.S. Army Corps of Engineers
- U.S. Fish and Wildlife Service
- County Floodplain Coordinator

Received  
Office of Oil & Gas

MAR 27 2015

The applicant further acknowledges that any Office of Oil and Gas permit in no way overrides, replaces, or nullifies the need for other permits/approvals that may be necessary and further affirms that all needed permits/approvals should be acquired from the appropriate authority before the affected activity is initiated.

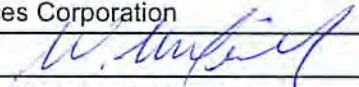Well Operator: Antero Resources Corporation  
 By: Ward McNeilly   
 Its: VP of Reserves, Planning & Midstream

FORM WW-6A1  
EXHIBIT 1

FILED

JUN 10 2013

Natalie E. Tennant  
Secretary of State  
1900 Kanawha Blvd E  
Bldg 1, Suite 157-K  
Charleston, WV 25305



Penney Barker, Manager  
Corporations Division  
Tel: (304)558-8000  
Fax: (304)558-8381  
Website: [www.wvros.com](http://www.wvros.com)  
E-mail: [business@wvros.com](mailto:business@wvros.com)

APPLICATION FOR  
AMENDED CERTIFICATE  
OF AUTHORITY

Office Hours: Monday - Friday  
8:30 a.m. - 5:00 p.m. ET

FILE ONE ORIGINAL  
(Two if you want a filed  
stamped copy returned to you)  
FEE: \$25.00

\*\*\*\* In accordance with the provisions of the West Virginia Code, the undersigned corporation hereby \*\*\*\*  
applies for an Amended Certificate of Authority and submits the following statement:

- Name under which the corporation was authorized to transact business in WV: Antero Resources Appalachian Corporation
- Date Certificate of Authority was issued in West Virginia: 6/25/2008
- Corporate name has been changed to: Antero Resources Corporation  
(Attach one **Certified Copy of Name Change** as filed in home State of incorporation.)
- Name the corporation elects to use in WV: Antero Resources Corporation  
(due to home state name not being available)
- Other amendments: \_\_\_\_\_  
(attach additional pages if necessary)
- Name and phone number of contact person. (This is optional; however, if there is a problem with the filing, listing a contact person and phone number may avoid having to return or reject the document.)  
Alvyn A. Schopp (303) 367-7310  
Contact Name Phone Number
- Signature Information (See below **\*Important Legal Notice Regarding Signatures**):  
Print Name of Signer: Alvyn A. Schopp Title/Capacity: Authorized Person  
Signature: [Handwritten Signature] Date: June 10, 2013

**\*Important Legal Notice Regarding Signatures:** Per West Virginia Code §31D-1-129. Penalty for signing false document. Any person who signs a document he or she knows is false in any material respect and knows that the document is to be delivered to the secretary of state for filing is guilty of a misdemeanor and, upon conviction thereof, shall be fined not more than one thousand dollars or confined in the county or regional jail not more than one year, or both.

Received  
Office of Oil & Gas





**CERTIFICATE**

*J. Ken Flechler, Secretary of State of the  
State of West Virginia, hereby certify that*  
originals of a Notice of Intention to Withdraw with the application of

**CRS DEVELOPMENT COMPANY**

for a Certificate of Withdrawal from West Virginia, signed and verified, as required  
by the provisions of Chapter 31, Article 1, Section 60 of the West Virginia Code  
are filed in my office and conform to law. Therefore, I issue this

**CERTIFICATE OF WITHDRAWAL**

and I attach to this certificate a duplicate original of the application.

*Given under my hand and the  
Great Seal of the State of  
West Virginia, on this*



           **TENTH**            day of  
           **JULY**            19 91

*Ken Flechler*

*Secretary of State.*

Received  
Office of Oil & Gas

MAR 27 2015



KEN HECHLER  
FEE \$5.00



TO BE FILED IN DUPLICATE  
ORIGINALS

FILED  
JUL 10 1991  
OFFICE OF  
SECRETARY OF STATE  
WEST VIRGINIA

APPLICATION FOR  
CERTIFICATE OF WITHDRAWAL  
OF  
CNG Development Company

In accordance with Chapter 31, Article 1, Section 60 of the Code of West Virginia, the undersigned corporation hereby applies for a certificate of withdrawal from West Virginia, and submits the following statement:

The name of the corporation is CNG Development Company

It is incorporated under the laws of Delaware

IT IS NOT TRANSACTING BUSINESS IN WEST VIRGINIA.

It hereby surrenders its authority to transact business in West Virginia. It revokes the authority of its registered agent in West Virginia to accept service of process, and consents that service of process in any action, suit or proceeding based upon any course of action arising in West Virginia during the time the corporation was authorized to transact business in West Virginia may thereafter be made on the corporation by service thereof on the Secretary of State of West Virginia.

The post office address to which the Secretary of State may mail a copy of any process against the corporation is CNG Producing Company, CNG Tower, 1450 Poydras Street, New Orleans, LA 70112-6000 Attn: Corporate Secretary

The aggregate number of shares which it has authority to issue, itemized by classes, par value of shares, shares without par, and series, if any, within a class, as of this date is

NUMBER OF SHARES	CLASS	SERIES	PAR VALUE/NO PAR
1,400,000	Common		\$100

The aggregate number of its issued shares, itemized by classes, par value of shares, shares without par, and series, if any, within a class, as of this date is

NUMBER OF SHARES	CLASS	SERIES	PAR VALUE/NO PAR
1,168,410	Common		\$100

The amount of its state capital as of this date is \$118,410.00

Received  
Office of Oil & Gas  
MAR 27 2015

CHG Development Company (Through CHG Producing Company)

corporate name

President/Vice President

*D. Malcolm Johns, Jr.*  
Secretary

State of Louisiana  
Parish Orleans

I James E. Wright, Jr. a Notary Public, do  
hereby certify that D. Malcolm Johns, Jr.

the Secretary  
office  
of CHG Producing Company  
corporate name  
office

appeared before me and they signed the foregoing as the act and deed of the corporation.

*[Signature]*  
Notary Public

(notary seal)

My commission expires at death

Received  
Office of Oil & Gas  
MAR 27 2015



4709502248



Antero Resources  
1615 Wynkoop Street  
Denver, CO 80202  
Office 303.357.7310  
Fax 303.357.7315

March 20, 2015


West Virginia Department of Environmental Protection  
Chief, Office of Oil and Gas  
Attn: Mr. James Martin  
601 57<sup>th</sup> Street SE  
Charleston, WV 25304

RE: Plum Run Unit 3H  
Quadrangle: Pennsboro 7.5'  
Tyler County/Meade District, West Virginia

Mr. Martin:

Antero Resources Corporation (Antero) is submitting the following application for a new well work permit for the Plum Run Unit 3H horizontal shallow well. As an authorized representative, I certify that Antero has the right to extract, produce or market the oil or gas for all leases through which the Plum Run Unit 3H horizontal lateral will drill through including any and all roads crossed under as identified on the attached survey plat.

Sincerely,

  
Spencer Booth  
Senior Landman

Received  
Office of Oil & Gas  
MAR 27 2015

05/29/2015

**STATE OF WEST VIRGINIA  
DEPARTMENT OF ENVIRONMENTAL PROTECTION, OFFICE OF OIL AND GAS  
NOTICE CERTIFICATION**

Date of Notice Certification: 03/20/2015

API No. 47- 095 -  
Operator's Well No. Plum Run Unit 3H  
Well Pad Name: Existing Hartley East Pad

**Notice has been given:**

Pursuant to the provisions in West Virginia Code § 22-6A, the Operator has provided the required parties with the Notice Forms listed below for the tract of land as follows:

State: <u>West Virginia</u>	UTM NAD 83	Easting: <u>500,596m</u>
County: <u>Tyler</u>		Northing: <u>4,357,311m</u>
District: <u>Meade</u>	Public Road Access: <u>CR 6/8</u>	
Quadrangle: <u>Pennsboro 7.5'</u>	Generally used farm name: <u>Hartley, David M.</u>	
Watershed: <u>Outlet Middle Island Creek</u>		

Pursuant to West Virginia Code § 22-6A-7(b), every permit application filed under this section shall be on a form as may be prescribed by the secretary, shall be verified and shall contain the following information: (14) A certification from the operator that (i) it has provided the owners of the surface described in subdivisions (1), (2) and (4), subsection (b), section ten of this article, the information required by subsections (b) and (c), section sixteen of this article; (ii) that the requirement was deemed satisfied as a result of giving the surface owner notice of entry to survey pursuant to subsection (a), section ten of this article six-a; or (iii) the notice requirements of subsection (b), section sixteen of this article were waived in writing by the surface owner; and Pursuant to West Virginia Code § 22-6A-11(b), the applicant shall tender proof of and certify to the secretary that the notice requirements of section ten of this article have been completed by the applicant.

<p>Pursuant to West Virginia Code § 22-6A, the Operator has attached proof to this Notice Certification that the Operator has properly served the required parties with the following:</p> <p>*PLEASE CHECK ALL THAT APPLY</p> <p><input type="checkbox"/> 1. NOTICE OF SEISMIC ACTIVITY or <input checked="" type="checkbox"/> NOTICE NOT REQUIRED BECAUSE NO SEISMIC ACTIVITY WAS CONDUCTED</p> <p><input checked="" type="checkbox"/> 2. NOTICE OF ENTRY FOR PLAT SURVEY or <input type="checkbox"/> NO PLAT SURVEY WAS CONDUCTED</p> <p><input type="checkbox"/> 3. NOTICE OF INTENT TO DRILL or <input checked="" type="checkbox"/> NOTICE NOT REQUIRED BECAUSE NOTICE OF ENTRY FOR PLAT SURVEY WAS CONDUCTED or</p> <p style="padding-left: 100px;"><input type="checkbox"/> WRITTEN WAIVER BY SURFACE OWNER (PLEASE ATTACH)</p> <p><input checked="" type="checkbox"/> 4. NOTICE OF PLANNED OPERATION</p> <p><input checked="" type="checkbox"/> 5. PUBLIC NOTICE</p> <p><input checked="" type="checkbox"/> 6. NOTICE OF APPLICATION</p>	<p><b>OOG OFFICE USE ONLY</b></p> <p><input checked="" type="checkbox"/> RECEIVED/ NOT REQUIRED</p> <p><input checked="" type="checkbox"/> RECEIVED</p> <p><input checked="" type="checkbox"/> RECEIVED/ NOT REQUIRED</p> <p><input checked="" type="checkbox"/> RECEIVED</p> <p><input checked="" type="checkbox"/> RECEIVED</p> <p><input checked="" type="checkbox"/> RECEIVED</p>
--	---

**Required Attachments:**


The Operator shall attach to this Notice Certification Form all Notice Forms and Certifications of Notice that have been provided to the required parties and/or any associated written waivers. For the Public Notice, the operator shall attach a copy of the <sup>Classified</sup> Advertisement with publication date verification or the associated Affidavit of Publication. The attached Notice Forms and Certifications of Notice shall serve as proof that the required parties have been noticed as required under West Virginia Code § 22-6A. Pursuant to West Virginia Code § 22-6A-11(b), the Certification of Notice to the person may be made by affidavit of personal service, the return receipt card or other postal receipt for certified mailing.


MAR 27 2015  
**05/29/2015**



**Certification of Notice is hereby given:**

THEREFORE, I Kevin Kilstrom, have read and understand the notice requirements within West Virginia Code § 22-6A. I certify that as required under West Virginia Code § 22-6A, I have served the attached copies of the Notice Forms, identified above, to the required parties through personal service, by registered mail or by any method of delivery that requires a receipt or signature confirmation. I certify under penalty of law that I have personally examined and am familiar with the information submitted in this Notice Certification and all attachments, and that based on my inquiry of those individuals immediately responsible for obtaining the information, I believe that the information is true, accurate and complete. I am aware that there are significant penalties for submitting false information, including the possibility of fine and imprisonment.

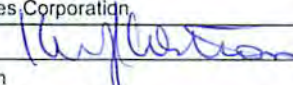Well Operator:	<u>Antero Resources Corporation</u>	Address:	<u>1615 Wynkoop Street</u>
By:	<u>Kevin Kilstrom</u> 		<u>Denver, CO 80202</u>
Its:	<u>VP of Production</u>	Facsimile:	<u>303-357-7315</u>
Telephone:	<u>303-357-7310</u>	Email:	<u>asteede@anteroresources.com</u>

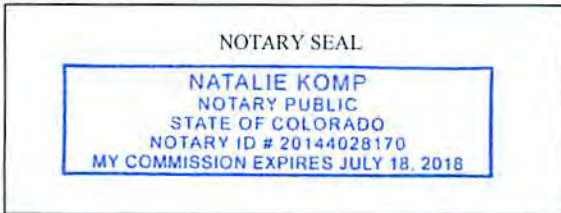

Subscribed and sworn before me this 20<sup>th</sup> day of March 2015  
Natalie Komp Notary Public  
 My Commission Expires July 18, 2018

**Oil and Gas Privacy Notice:**

The Office of Oil and Gas processes your personal information, such as name, address and telephone number, as part of our regulatory duties. Your personal information may be disclosed to other State agencies or third parties in the normal course of business or as needed to comply with statutory or regulatory requirements, including Freedom of Information Act requests. Our office will appropriately secure your personal information. If you have any questions about our use or your personal information, please contact DEP's Chief Privacy Officer at [deprivacyofficer@wv.gov](mailto:deprivacyofficer@wv.gov).

Received  
Office of Oil & Gas  
MAR 27 2015



**STATE OF WEST VIRGINIA  
DEPARTMENT OF ENVIRONMENTAL PROTECTION, OFFICE OF OIL AND GAS  
NOTICE OF APPLICATION**

**Notice Time Requirement:** notice shall be provided no later than the filing date of permit application.

**Date of Notice:** 3/23/2015 **Date Permit Application Filed:** 3/23/2015

Notice of:

- PERMIT FOR ANY WELL WORK
- CERTIFICATE OF APPROVAL FOR THE CONSTRUCTION OF AN IMPOUNDMENT OR PIT

**Delivery method pursuant to West Virginia Code § 22-6A-10(b)**

- PERSONAL SERVICE
- REGISTERED MAIL
- METHOD OF DELIVERY THAT REQUIRES A RECEIPT OR SIGNATURE CONFIRMATION

Pursuant to W. Va. Code § 22-6A-10(b) no later than the filing date of the application, the applicant for a permit for any well work or for a certificate of approval for the construction of an impoundment or pit as required by this article shall deliver, by personal service or by registered mail or by any method of delivery that requires a receipt or signature confirmation, copies of the application, the erosion and sediment control plan required by section seven of this article, and the well plat to each of the following persons: (1) The owners of record of the surface of the tract on which the well is or is proposed to be located; (2) The owners of record of the surface tract or tracts overlying the oil and gas leasehold being developed by the proposed well work, if the surface tract is to be used for roads or other land disturbance as described in the erosion and sediment control plan submitted pursuant to subsection (c), section seven of this article; (3) The coal owner, operator or lessee, in the event the tract of land on which the well proposed to be drilled is located [sic] is known to be underlain by one or more coal seams; (4) The owners of record of the surface tract or tracts overlying the oil and gas leasehold being developed by the proposed well work, if the surface tract is to be used for the placement, construction, enlargement, alteration, repair, removal or abandonment of any impoundment or pit as described in section nine of this article; (5) Any surface owner or water purveyor who is known to the applicant to have a water well, spring or water supply source located within one thousand five hundred feet of the center of the well pad which is used to provide water for consumption by humans or domestic animals; and (6) The operator of any natural gas storage field within which the proposed well work activity is to take place. (c)(1) If more than three tenants in common or other co-owners of interests described in subsection (b) of this section hold interests in the lands, the applicant may serve the documents required upon the person described in the records of the sheriff required to be maintained pursuant to section eight, article one, chapter eleven-a of this code. (2) Notwithstanding any provision of this article to the contrary, notice to a lien holder is not notice to a landowner, unless the lien holder is the landowner. W. Va. Code R. § 35-8-5.7.a requires, in part, that the operator shall also provide the Well Site Safety Plan ("WSSP") to the surface owner and any water purveyor or surface owner subject to notice and water testing as provided in section 15 of this rule.

Application Notice  WSSP Notice  E&S Plan Notice  Well Plat Notice is hereby provided to:

SURFACE OWNER(s)

Name: David M. Hartley  
Address: 354 Brush Run Road  
Ellenboro, WV 26346

Name: \_\_\_\_\_  
Address: \_\_\_\_\_

SURFACE OWNER(s) (Road and/or Other Disturbance)

Name: Jason Hartley  
Address: 354 Brush Run Road  
Ellenboro, WV 26346

Name: \_\_\_\_\_  
Address: \_\_\_\_\_

SURFACE OWNER(s) (Impoundments or Pits)

Name: \_\_\_\_\_  
Address: \_\_\_\_\_

COAL OWNER OR LESSEE

Name: NO DECLARATIONS ON RECORD WITH COUNTY  
Address: \_\_\_\_\_

COAL OPERATOR

Name: \_\_\_\_\_  
Address: \_\_\_\_\_

WATER PURVEYOR(s)/OWNER(s) OF WATER WELL, SPRING OR OTHER WATER SUPPLY SOURCE

Name: PLEASE SEE ATTACHMENT  
Address: \_\_\_\_\_

OPERATOR OF ANY NATURAL GAS STORAGE FIELD

Name: \_\_\_\_\_  
Address: \_\_\_\_\_

\*Please attach additional forms if necessary

Received  
Office of Oil & Gas  
MAR 27 2015

WW-6A  
(8-13)

API NO. 47- 095 -  
OPERATOR WELL NO. Plum Run Unit 3H  
Well Pad Name: Existing Hartley East Pad

**Notice is hereby given:**

Pursuant to West Virginia Code § 22-6A-10(b), notice is hereby given that the undersigned well operator has applied for a permit for well work or for a certificate of approval for the construction of an impoundment or pit.

**This Notice Shall Include:**

Pursuant to W. Va. Code § 22-6A-10(b), this notice shall include: (1) copies of the application; (2) the erosion and sediment control plan required by section seven of this article; and (3) the well plat.

Pursuant to W. Va. Code § 22-6A-10(f), this notice shall include: (1) a statement of the time limits for filing written comments; (2) who may file written comments; (3) the name and address of the secretary for the purpose of filing the comments and obtaining additional information; and (4) a statement that the persons may request, at the time of submitting written comments, notice of the permit decision and a list of persons qualified to test water.

Pursuant to W. Va. Code R. § 35-8-5.7.a, the operator shall provide the Well Site Safety Plan to the surface owner and any water purveyor or surface owner subject to notice and water testing as provided in section 15 of this rule.

Pursuant to W. Va. Code R. § 35-8-15.2.c, this notice shall: (1) contain a statement of the surface owner's and water purveyor's right to request sampling and analysis; (2) advise the surface owner and water purveyor of the rebuttable presumption for contamination or deprivation of a fresh water source or supply; advise the surface owner and water purveyor that refusal to allow the operator to conduct a pre-drilling water well test constitutes a method to rebut the presumption of liability; (3) advise the surface owner and water purveyor of his or her independent right to sample and analyze any water supply at his or her own expense; advise the surface owner and water purveyor whether or not the operator will utilize an independent laboratory to analyze any sample; and (4) advise the surface owner and or water purveyor that he or she can obtain from the Chief a list of water testing laboratories in the subject area capable of and qualified to test water supplies in accordance with standard acceptable methods.

Additional information related to horizontal drilling may be obtained from the Secretary, at the WV Department of Environmental Protection headquarters, located at 601 57<sup>th</sup> Street, SE, Charleston, WV 25304 (304-926-0450) or by visiting [www.dep.wv.gov/oil-and-gas/pages/default.aspx](http://www.dep.wv.gov/oil-and-gas/pages/default.aspx).

**Well Location Restrictions**

Pursuant to W. Va. Code § 22-6A-12, Wells may not be drilled within two hundred fifty feet measured horizontally from any existing water well or developed spring used for human or domestic animal consumption. The center of well pads may not be located within six hundred twenty-five feet of an occupied dwelling structure, or a building two thousand five hundred square feet or larger used to house or shelter dairy cattle or poultry husbandry. This limitation is applicable to those wells, developed springs, dwellings or agricultural buildings that existed on the date a notice to the surface owner of planned entry for surveying or staking as provided in section ten of this article or a notice of intent to drill a horizontal well as provided in subsection (b), section sixteen of this article was provided, whichever occurs first, and to any dwelling under construction prior to that date. This limitation may be waived by written consent of the surface owner transmitted to the department and recorded in the real property records maintained by the clerk of the county commission for the county in which such property is located. Furthermore, the well operator may be granted a variance by the secretary from these distance restrictions upon submission of a plan which identifies the sufficient measures, facilities or practices to be employed during well site construction, drilling and operations. The variance, if granted, shall include terms and conditions the department requires to ensure the safety and protection of affected persons and property. The terms and conditions may include insurance, bonding and indemnification, as well as technical requirements. (b) No well pad may be prepared or well drilled within one hundred feet measured horizontally from any perennial stream, natural or artificial lake, pond or reservoir, or a wetland, or within three hundred feet of a naturally reproducing trout stream. No well pad may be located within one thousand feet of a surface or ground water intake of a public water supply. The distance from the public water supply as identified by the department shall be measured as follows: (1) For a surface water intake on a lake or reservoir, the distance shall be measured from the boundary of the lake or reservoir. (2) For a surface water intake on a flowing stream, the distance shall be measured from a semicircular radius extending upstream of the surface water intake. (3) For a groundwater source, the distance shall be measured from the wellhead or spring. The department may, in its discretion, waive these distance restrictions upon submission of a plan identifying sufficient measures, facilities or practices to be employed during well site construction, drilling and operations to protect the waters of the state. A waiver, if granted, shall impose any permit conditions as the secretary considers necessary. (c) Notwithstanding the foregoing provisions of this section, nothing contained in this section prevents an operator from conducting the activities permitted or authorized by a Clean Water Act Section 404 permit or other approval from the United States Army Corps of Engineers within any waters of the state or within the restricted areas referenced in this section. (d) The well location restrictions set forth in this section shall not apply to any well on a multiple well pad if at least one of the wells was permitted prior to the effective date of this article. (e) The secretary shall, by December 31, 2012, report to the Legislature on the noise, light, dust and volatile organic compounds generated by the drilling of horizontal wells as they relate to the well location restrictions regarding occupied dwelling structures pursuant to this section. Upon a finding, if any, by the secretary that the well location restrictions regarding occupied dwelling structures are inadequate or otherwise require alteration to address the items

05/29/2015

WW-6A  
(8-13)

API NO. 47-095 -  
OPERATOR WELL NO. Plum Run Unit 3H  
Well Pad Name: Existing Hartley East Pad

examined in the study required by this subsection, the secretary shall have the authority to propose for promulgation legislative rules establishing guidelines and procedures regarding reasonable levels of noise, light, dust and volatile organic compounds relating to drilling horizontal wells, including reasonable means of mitigating such factors, if necessary.

**Water Well Testing:**

Pursuant to West Virginia Code § 22-6A-10(d), notification shall be made, with respect to surface landowners identified in subsection (b) or water purveyors identified in subdivision (5), subsection (b) of this section, of the opportunity for testing their water well. The operator shall provide an analysis to such surface landowner or water purveyor at their request.

**Water Testing Laboratories:**

Pursuant to West Virginia Code § 22-6A-10(i), persons entitled to notice pursuant to subsection (b) of this section may contact the department to ascertain the names and locations of water testing laboratories in the subject area capable and qualified to test water supplies in accordance with standard accepted methods. In compiling that list of names the department shall consult with the state Bureau for Public Health and local health departments. A surface owner and water purveyor has an independent right to sample and analyze any water supply at his or her own expense. The laboratory utilized by the operator shall be approved by the agency as being certified and capable of performing sample analyses in accordance with this section.

**Rebuttable Presumption for Contamination or Deprivation of a Fresh Water Source or Supply:**

W. Va. Code § 22-6A-18 requires that (b) unless rebutted by one of the defenses established in subsection (c) of this section, in any action for contamination or deprivation of a fresh water source or supply within one thousand five hundred feet of the center of the well pad for horizontal well, there is a rebuttable presumption that the drilling and the oil or gas well or either was the proximate cause of the contamination or deprivation of the fresh water source or supply. (c) In order to rebut the presumption of liability established in subsection (b) of this section, the operator must prove by a preponderance of the evidence one of the following defenses: (1) The pollution existed prior to the drilling or alteration activity as determined by a predrilling or prealteration water well test. (2) The landowner or water purveyor refused to allow the operator access to the property to conduct a predrilling or prealteration water well test. (3) The water supply is not within one thousand five hundred feet of the well. (4) The pollution occurred more than six months after completion of drilling or alteration activities. (5) The pollution occurred as the result of some cause other than the drilling or alteration activity. (d) Any operator electing to preserve its defenses under subdivision (1), subsection (c) of this section shall retain the services of an independent certified laboratory to conduct the predrilling or prealteration water well test. A copy of the results of the test shall be submitted to the department and the surface owner or water purveyor in a manner prescribed by the secretary. (e) Any operator shall replace the water supply of an owner of interest in real property who obtains all or part of that owner's supply of water for domestic, agricultural, industrial or other legitimate use from an underground or surface source with a comparable water supply where the secretary determines that the water supply has been affected by contamination, diminution or interruption proximately caused by the oil or gas operation, unless waived in writing by that owner. (f) The secretary may order the operator conducting the oil or gas operation to: (1) Provide an emergency drinking water supply within twenty-four hours; (2) Provide temporary water supply within seventy-two hours; (3) Within thirty days begin activities to establish a permanent water supply or submit a proposal to the secretary outlining the measures and timetables to be used in establishing a permanent supply. The total time in providing a permanent water supply may not exceed two years. If the operator demonstrates that providing a permanent replacement water supply cannot be completed within two years, the secretary may extend the time frame on case-by-case basis; and (4) Pay all reasonable costs incurred by the real property owner in securing a water supply. (g) A person as described in subsection (b) of this section aggrieved under the provisions of subsections (b), (e) or (f) of this section may seek relief in court... (i) Notwithstanding the denial of the operator of responsibility for the damage to the real property owner's water supply or the status of any appeal on determination of liability for the damage to the real property owner's water supply, the operator may not discontinue providing the required water service until authorized to do so by the secretary or a court of competent jurisdiction.

**Written Comment:**

Pursuant to West Virginia Code § 22-6A-11(a), all persons described in subsection (b), section ten of this article may file written comments with the secretary as to the location or construction of the applicant's proposed well work within thirty days after the application is filed with the secretary. All persons described in West Virginia Code § 22-6A-10(b) may file written comments as to the location or construction of the applicant's proposed well work to the Secretary at:

Chief, Office of Oil and Gas  
Department of Environmental Protection  
601 57<sup>th</sup> St. SE  
Charleston, WV 25304  
(304) 926-0450

Received  
Office of Oil & Gas  
MAR 27 2015

Such persons may request, at the time of submitting written comments, notice of the permit decision and a list of persons qualified to test water. **NOTE: YOU ARE NOT REQUIRED TO FILE ANY COMMENT.**

05/29/2015



**Time Limits and Methods for Filing Comments.**

The law requires these materials to be served on or before the date the operator files its Application. You have **THIRTY (30) DAYS** after the filing date to file your comments. Comments must be filed in person or received in the mail by the Chief's office by the time stated above. You may call the Chief's office to be sure of the date. Check with your postmaster to ensure adequate delivery time or to arrange special expedited handling. If you have been contacted by the well operator and you have signed a "voluntary statement of no objection" to the planned work described in these materials, then the permit may be issued at any time.

Pursuant to West Virginia Code § 22-6A-11(c)(2), Any objections of the affected coal operators and coal seam owners and lessees shall be addressed through the processes and procedures that exist under sections fifteen, seventeen and forty, article six of this chapter, as applicable and as incorporated into this article by section five of this article. The written comments filed by the parties entitled to notice under subdivisions (1), (2), (4), (5) and (6), subsection (b), section ten of this article shall be considered by the secretary in the permit issuance process, but the parties are not entitled to participate in the processes and proceedings that exist under sections fifteen, seventeen or forty, article six of this chapter, as applicable and as incorporated into this article by section five of this article.

**Comment Requirements**

Your comments must be in writing and include your name, address and telephone number, the well operator's name and well number and the approximate location of the proposed well site including district and county from the application. You may add other documents, such as sketches, maps or photographs to support your comments.

Disclaimer: All comments received will be placed on our web site <http://www.dep.wv.gov/oil-and-gas/Horizontal-Permits/Pages/default.aspx> and the applicant will automatically be forwarded an email notice that such comments have been submitted. The applicant will be expected to provide a response to comments submitted by any surface owner, water purveyor or natural gas storage operator noticed within the application.

**Permit Denial or Condition**

The Chief has the power to deny or condition a well work permit. Pursuant to West Virginia Code § 22-6A-8(d), the permit may not be issued or be conditioned, including conditions with respect to the location of the well and access roads prior to issuance if the director determines that:

- (1) The proposed well work will constitute a hazard to the safety of persons;
- (2) The plan for soil erosion and sediment control is not adequate or effective;
- (3) Damage would occur to publicly owned lands or resources; or
- (4) The proposed well work fails to protect fresh water sources or supplies.

A permit may also be denied under West Virginia Code § 22-6A-7(k), the secretary shall deny the issuance of a permit if the secretary determines that the applicant has committed a substantial violation of a previously issued permit for a horizontal well, including the applicable erosion and sediment control plan associated with the previously issued permit, or a substantial violation of one or more of the rules promulgated under this article, and in each instance has failed to abate or seek review of the violation within the time prescribed by the secretary pursuant to the provisions of subdivisions (1) and (2), subsection (a), section five of this article and the rules promulgated hereunder, which time may not be unreasonable.

Pursuant to West Virginia Code § 22-6A-10(g), any person entitled to submit written comments to the secretary pursuant to subsection (a), section eleven of this article, shall also be entitled to receive from the secretary a copy of the permit as issued or a copy of the order modifying or denying the permit if the person requests receipt of them as a part of the written comments submitted concerning the permit application. Such persons may request, at the time of submitting written comments, notice of the permit decision and a list of persons qualified to test water.

Received  
Office of Oil & Gas  
MAR 27 2015

4709502248

WW-6A  
(8-13)

API NO. 47-095 -  
OPERATOR WELL NO. Plum Run Unit 3H  
Well Pad Name: Existing Hartley East Pad

**Notice is hereby given by:**

Well Operator: Antero Resources Corporation  
Telephone: (303) 357-7310 [Signature]  
Email: asteele@anteroresources.com

Address: 1615 Wynkoop Street  
Denver, CO 80202  
Facsimile: 303-357-7315

**Oil and Gas Privacy Notice:**

The Office of Oil and Gas processes your personal information, such as name, address and telephone number, as part of our regulatory duties. Your personal information may be disclosed to other State agencies or third parties in the normal course of business or as needed to comply with statutory or regulatory requirements, including Freedom of Information Act requests. Our office will appropriately secure your personal information. If you have any questions about our use or your personal information, please contact DEP's Chief Privacy Officer at [deprivacyofficer@owg.gov](mailto:deprivacyofficer@owg.gov).




Subscribed and sworn before me this 20<sup>th</sup> day of March 2015  
Natalie Komp Notary Public  
My Commission Expires July 18, 2018

Received  
Office of Oil & Gas  
MAR 27 2015

05/29/2015



# HARTLEY EAST PAD ANTERO RESOURCES CORPORATION

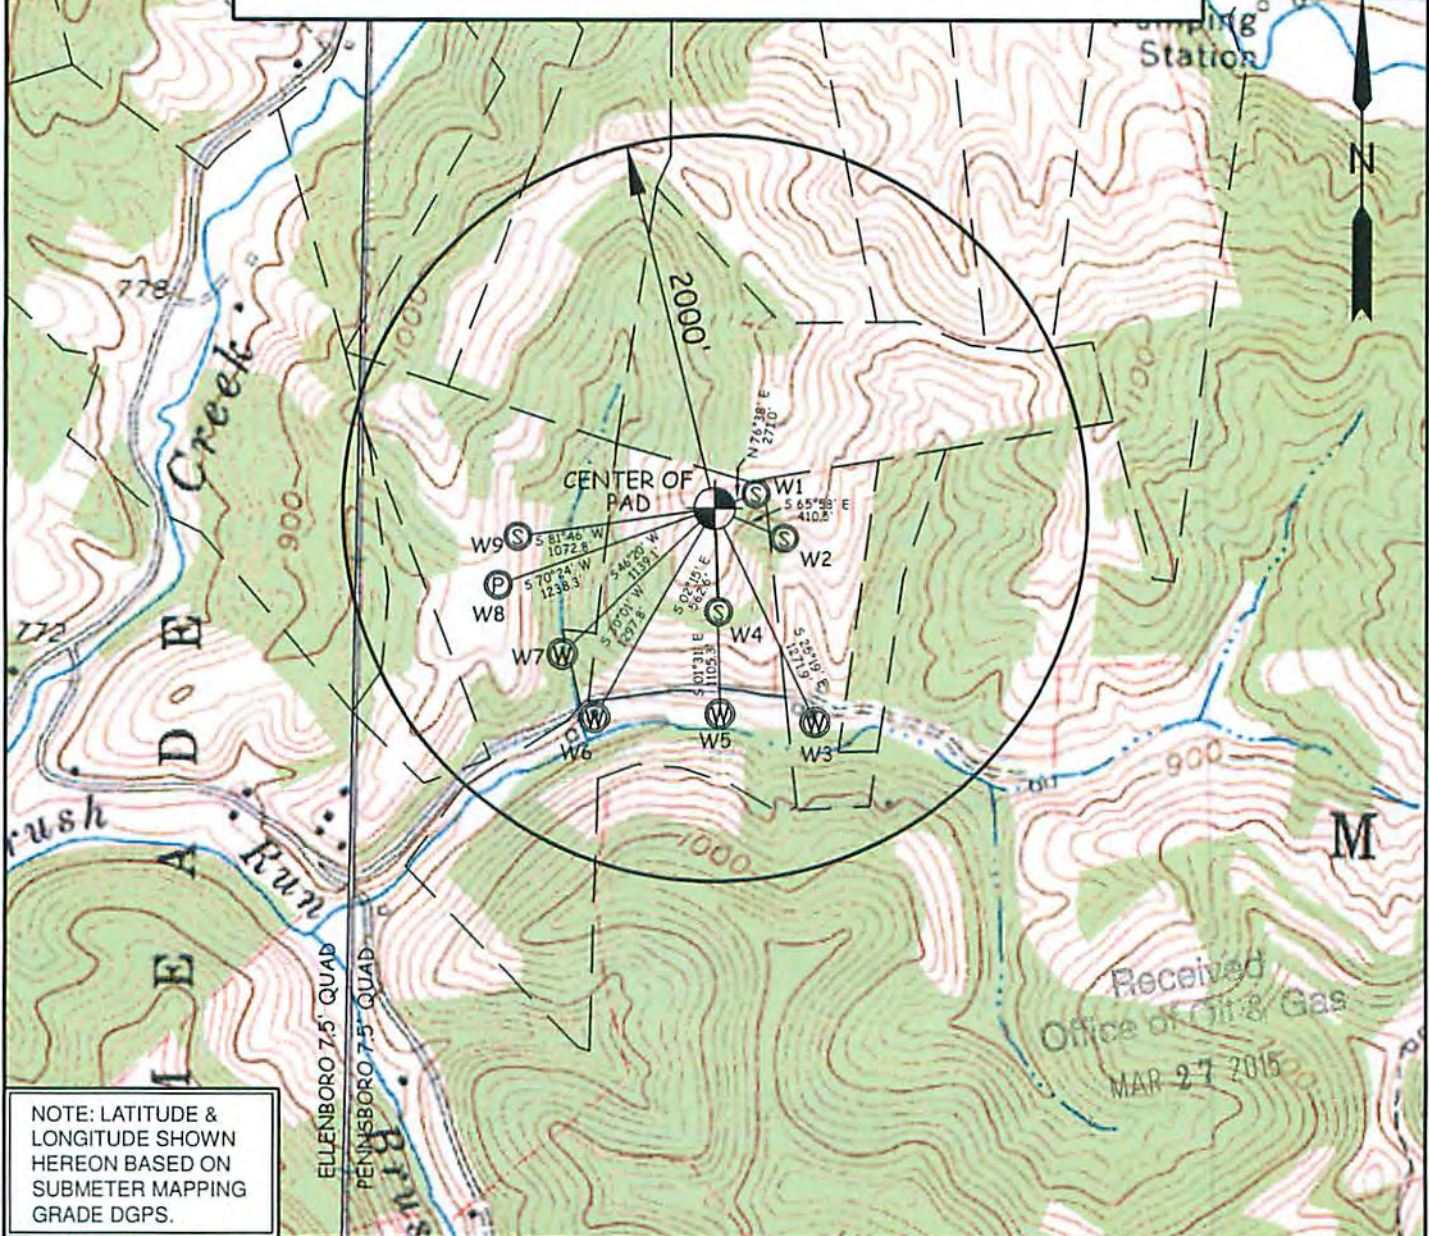

NOTE: LATITUDE & LONGITUDE SHOWN HEREON BASED ON SUBMETER MAPPING GRADE DGPS.

WELL	SURFACE OWNER	ADDRESS	WELL LATITUDE	WELL LONGITUDE
W1	DAVID M. HARTLEY	354 BRUSH RUN RD., ELLENBORO, WV 26346	39° 21' 55.74"	80° 59' 32.78"
W2	WALTER JACKSON	3991 ST. RT. 213 STEUBENVILLE, OH 43952	39° 21' 53.39"	80° 59' 30.79"
W3	WALTER JACKSON	3991 ST. RT. 213 STEUBENVILLE, OH 43952	39° 21' 43.71"	80° 59' 28.43"
W4	DAVID M. HARTLEY	354 BRUSH RUN RD., ELLENBORO, WV 26346	39° 21' 49.43"	80° 59' 35.20"
W5	DAVID M. HARTLEY	354 BRUSH RUN RD., ELLENBORO, WV 26346	39° 21' 44.07"	80° 59' 34.99"
W6	DAVID M. HARTLEY	354 BRUSH RUN RD., ELLENBORO, WV 26346	39° 21' 43.77"	80° 59' 43.63"
W7	DAVID M. HARTLEY	354 BRUSH RUN RD., ELLENBORO, WV 26346	39° 21' 47.07"	80° 59' 45.92"
W8	DAVID M. HARTLEY	354 BRUSH RUN RD., ELLENBORO, WV 26346	39° 21' 53.24"	80° 59' 49.10"
W9	DAVID M. HARTLEY	354 BRUSH RUN RD., ELLENBORO, WV 26346	39° 21' 50.64"	80° 59' 50.38"

WILLOW LAND SURVEYING, PLLC P.O. BOX 17, PENNSBORO, WV 26415 (304) 659-1717	TOPO SECTION(S) OF ; PENNSBORO 7.5' QUAD. & ELLENBORO 7.5' QUAD.	SCALE : 1-INCH = 1000-FEET 0'      1000'      2000'      3000' 
	JOB #: 13-081WA	
DATE: 11/06/14	DRAWN BY: D.L.P.	FILE: HARTLEYEASTWATERMAP



4709502248

**WW-6A Notice of Application Attachment:**

**Water Well, Developed Spring & Pond Owners:**

**Owner:** David M. Hartley (3 Water Wells, 3 Developed Springs, 1 Pond)  
**Address:** 354 Brush Run Road  
Ellenboro, WV 26346

**Owner:** Walter Jackson (1 Water Well, 1 Developed Spring)  
**Address:** 3991 State Route 213  
Steubenville, OH 43952

Received  
Office of Oil & Gas  
MAR 27 2015

05/29/2015



WW-6A3  
(1/12)

Operator Well No. Plum Run Unit 3H  
Multiple Wells on the Hartley East Pad

**STATE OF WEST VIRGINIA**  
**DEPARTMENT OF ENVIRONMENTAL PROTECTION, OFFICE OF OIL AND GAS**  
**NOTICE OF ENTRY FOR PLAT SURVEY**

**Notice Time Requirement:** Notice shall be provided at least **SEVEN (7)** days but no more than **FORTY-FIVE (45)** days prior to entry

**Date of Notice:** 6/21/2013      **Date of Planned Entry:** 7/2/2013

**Delivery method pursuant to West Virginia Code § 22-6A-10a**

PERSONAL SERVICE       REGISTERED MAIL       METHOD OF DELIVERY THAT REQUIRES A RECEIPT OR SIGNATURE CONFIRMATION

Pursuant to West Virginia Code § 22-6A-10(a), Prior to filing a permit application, the operator shall provide notice of planned entry on to the surface tract to conduct any plat surveys required pursuant to this article. Such notice shall be provided at least seven days but no more than forty-five days prior to such entry to: (1) The surface owner of such tract; (2) to any owner or lessee of coal seams beneath such tract that has filed a declaration pursuant to section thirty-six, article six, chapter twenty-two of this code; and (3) any owner of minerals underlying such tract in the county tax records. The notice shall include a statement that copies of the state Erosion and Sediment Control Manual and the statutes and rules related to oil and gas exploration and production may be obtained from the Secretary, which statement shall include contact information, including the address for a web page on the Secretary's web site, to enable the surface owner to obtain copies from the secretary.

**Notice is hereby provided to:**

SURFACE OWNER(s)

Name: David Hartley  
Address: HC 83 Box 207  
Ellenboro, WV 26345

Name: \_\_\_\_\_  
Address: \_\_\_\_\_

Name: \_\_\_\_\_  
Address: \_\_\_\_\_

COAL OWNER OR LESSEE

Name: NO DECLARATIONS ON RECORD WITH COUNTY  
Address: \_\_\_\_\_

MINERAL OWNER(s)

Name: PLEASE SEE ATTACHMENT  
Address: \_\_\_\_\_

\*please attach additional forms if necessary

**Notice is hereby given:**

Pursuant to West Virginia Code § 22-6A-10(a), notice is hereby given that the undersigned well operator is planning entry to conduct a plat survey on the tract of land as follows:

State:	<u>West Virginia</u>	Approx. Latitude & Longitude:	<u>39.365283, -80.993061</u>
County:	<u>Tyler</u>	Public Road Access:	<u>CR 6/8</u>
District:	<u>Meade</u>	Watershed:	<u>Tributary of Brush Run</u>
Quadrangle:	<u>Pennsboro 7.5'</u>	Generally used farm name:	<u>Hartley, David M.</u>

Copies of the state Erosion and Sediment Control Manual and the statutes and rules related to oil and gas exploration and production may be obtained from the Secretary, at the WV Department of Environmental Protection headquarters, located at 601 57<sup>th</sup> Street, SE, Charleston, WV 25304 (304-926-0450). Copies of such documents or additional information related to horizontal drilling may be obtained from the Secretary by visiting [www.dep.wv.gov/oil-and-gas/pages/default.aspx](http://www.dep.wv.gov/oil-and-gas/pages/default.aspx).

**Notice is hereby given by:**

Well Operator: Antero Resources Corporation  
Telephone: (303) 357-7310  
Email: asteele@anteroresources.com

Address: 1615 Wynkoop Street  
Denver, CO 80202  
Facsimile: 303-357-7315

Received  
Office of Oil & Gas  
MAR 27 2015

**Oil and Gas Privacy Notice:**

The Office of Oil and Gas processes your personal information, such as name, address and telephone number, as part of our regulatory duties. Your personal information may be disclosed to other State agencies or third parties in the normal course of business or as needed to comply with statutory or regulatory requirements, including Freedom of Information Act requests. Our office will appropriately secure your personal information. If you have any questions about our use or your personal information, please contact DEP's Chief Privacy Officer at [depprivacyofficer@wv.gov](mailto:depprivacyofficer@wv.gov).

05/29/2015

**WW-6A3 Notice of Entry For Plat Survey Attachment:****Mineral Owners:**

**Owner:** Union National bank Trustee (S.A. Smith & C.B. Smith) /  
**Address:** PO Box 659  
Wichita Falls, TX 76307

**Owner:** John W. Kerns Trust c/o Industry Consulting Group; Union National  
Bank Trustee (S.A. Smith & C.B. Smith) /  
**Address:** PO Box 659  
Wichita Falls, TX 76307

**Owner:** David N. and Barbara E. Hartley /  
**Address:** HC 83 Box 207  
Ellenboro, WV 26345

**Owner:** Wanda Hartley /  
**Address:** HC 83 Box 207  
Ellenboro, WV 26345

Received  
Office of Oil & Gas  
MAR 27 2015

05/29/2015



WW-6A5  
(1/12)

**STATE OF WEST VIRGINIA**  
**DEPARTMENT OF ENVIRONMENTAL PROTECTION, OFFICE OF OIL AND GAS**  
**NOTICE OF PLANNED OPERATION**

**Notice Time Requirement:** notice shall be provided no later than the **filing date of permit application.**

**Date of Notice:** 03/23/2015      **Date Permit Application Filed:** 03/23/2015

**Delivery method pursuant to West Virginia Code § 22-6A-16(c)**

CERTIFIED MAIL                                       HAND  
RETURN RECEIPT REQUESTED                                      DELIVERY

Pursuant to W. Va. Code § 22-6A-16(c), no later than the date for filing the permit application, an operator shall, by certified mail return receipt requested or hand delivery, give the surface owner whose land will be used for the drilling of a horizontal well notice of the planned operation. The notice required by this subsection shall include: (1) A copy of this code section; (2) The information required to be provided by subsection (b), section ten of this article to a surface owner whose land will be used in conjunction with the drilling of a horizontal well; and (3) A proposed surface use and compensation agreement containing an offer of compensation for damages to the surface affected by oil and gas operations to the extent the damages are compensable under article six-b of this chapter. (d) The notices required by this section shall be given to the surface owner at the address listed in the records of the sheriff at the time of notice.

**Notice is hereby provided to the SURFACE OWNER(s)**

(at the address listed in the records of the sheriff at the time of notice):

Name: David M. Hartley                                      Name: \_\_\_\_\_  
Address: 354 Brush Run Road                                      Address: \_\_\_\_\_  
Ellenboro, WV 26346                                      \_\_\_\_\_

**Notice is hereby given:**

Pursuant to West Virginia Code § 22-6A-16(c), notice is hereby given that the undersigned well operator has developed a planned operation on the surface owner's land for the purpose of drilling a horizontal well on the tract of land as follows:

State:	<u>West Virginia</u>	UTM NAD 83	Eastings:	<u>500,596m</u>
County:	<u>Tyler</u>		Northing:	<u>4,357,311m</u>
District:	<u>Meade</u>	Public Road Access:		<u>CR 6/8</u>
Quadrangle:	<u>Pennsboro 7.5'</u>	Generally used farm name:		<u>Hartley, David M.</u>
Watershed:	<u>Outlet Middle Island Creek</u>			

**This Notice Shall Include:**

Pursuant to West Virginia Code § 22-6A-16(c), this notice shall include: (1) A copy of this code section; (2) The information required to be provided by **W. Va. Code § 22-6A-10(b)** to a surface owner whose land will be used in conjunction with the drilling of a horizontal well; and (3) A proposed surface use and compensation agreement containing an offer of compensation for damages to the surface affected by oil and gas operations to the extent the damages are compensable under article six-b of this chapter. Additional information related to horizontal drilling may be obtained from the Secretary, at the WV Department of Environmental Protection headquarters, located at 601 57<sup>th</sup> Street, SE, Charleston, WV 25304 (304-926-0450) or by visiting [www.dep.wv.gov/oil-and-gas/pages/default.aspx](http://www.dep.wv.gov/oil-and-gas/pages/default.aspx).

Well Operator:	<u>Antero Resources Corporation</u>	Address:	<u>1615 Wynkoop Street</u>
Telephone:	<u>(303) 357-7310</u>		<u>Denver, CO 80202</u>
Email:	<u>asteela@anteroresources.com</u>	Facsimile:	<u>303-357-7315</u>

**Oil and Gas Privacy Notice:**

The Office of Oil and Gas processes your personal information, such as name, address and telephone number, as part of our regulatory duties. Your personal information may be disclosed to other State agencies or third parties in the normal course of business or as needed to comply with statutory or regulatory requirements, including Freedom of Information Act requests. Our office will appropriately secure your personal information. If you have any questions about our use or your personal information, please contact DEP's Chief Privacy Officer at [depprivacyofficer@wv.gov](mailto:depprivacyofficer@wv.gov).

Office of Oil & Gas  
MAR 27 2015

05/29/2015



## WEST VIRGINIA DEPARTMENT OF TRANSPORTATION

## Division of Highways

1900 Kanawha Boulevard East • Building Five • Room 110  
Charleston, West Virginia 25305-0430 • (304) 558-3505

Earl Ray Tomblin  
Governor

Paul A. Mattox, Jr., P. E.  
Secretary of Transportation/  
Commissioner of Highways

February 10, 2015

James A. Martin, Chief  
Office of Oil and Gas  
Department of Environmental Protection  
601 57<sup>th</sup> Street, SE  
Charleston, WV 25304

Subject: DOH Permit for the Hartley East Pad, Tyler County  
Plum Run Unit 3H Well site

Dear Mr. Martin,

This well site will be accessed from a DOH permit 06-2013-0407 issued to Antero Resources Corporation for access to the State Road for a well site located off of Tyler County Route 6/8 SLS.

The operator has signed a STATEWIDE OIL AND GAS ROAD MAINTENANCE BONDING AGREEMENT and provided the required Bond. This operator is currently in compliance with the DOH OIL AND GAS POLICY dated January 3, 2012.

Very Truly Yours,

Gary K. Clayton, P.E.  
Regional Maintenance Engineer  
Central Office O&G Coordinator

Cc: Ashlie Steele  
Antero Resources Corporation  
CH, OM, D-6  
File

Received  
Office of Oil & Gas  
MAR 27 2015

05/29/2015



**List of Anticipated Additives Used for Fracturing or  
Stimulating Well**


<b>Additives</b>	<b>Chemical Abstract Service Number (CAS #)</b>
Fresh Water	7732-18-5
2 Phosphobutane 1,2,4 tricarboxylic acid	37971-36-1
Ammonium Persulfate	7727-54-0
Anionic copolymer	proprietary
Anionic polymer	proprietary
BTEX Free Hydrotreated Heavy Naphtha	64742-48-9
Cellulase enzyme	(Proprietary)
Demulsifier Base	(Proprietary)
Ethoxylated alcohol blend	Mixture
Ethoxylated Nonylphenol	68412-54-4
Ethoxylated oleylamine	26635-93-8
Ethylene Glycol	107-21-1
Glycol Ethers	111-76-2
guar gum	9000-30-0
Hydrogen Chloride	7647-01-0
Hydrotreated light distillates, non-aromatic, BTEX free	64742-47-8
Isopropyl alcohol	67-63-0
liquid, 2,2-dibromo-3-nitropropionamide	10222-01-2
Microparticle	proprietary
Petroleum Distillates (BTEX Below Detect)	64742-47-8
Polyacrylamide	57-55-6
Propargyl Alcohol	107-19-7
Propylene Glycol	57-55-6
Quartz	14808-60-7
Silica, crystalline quartz	7631-86-9
Sodium Chloride	7647-14-5
Sodium Hydroxide	1310-73-2
Sugar	57-50-1
Surfactant	68439-51-0
Suspending agent (solid)	14808-60-7
Tar bases, quinoline derivs, benzyl chloride-quaternized	72480-70-7

Received  
Office of Oil & Gas  
MAR 27 2015



West Virginia State Plane Coordinate System  
North Zone, NAD83  
Elevations Based on NAVD83  
Established by Survey Grade GPS & CPUS  
Point Processing

# HARTLEY EAST PAD SITE DESIGN, CONSTRUCTION PLAN, & EROSION & SEDIMENT CONTROL PLANS ANTERO RESOURCES CORPORATION

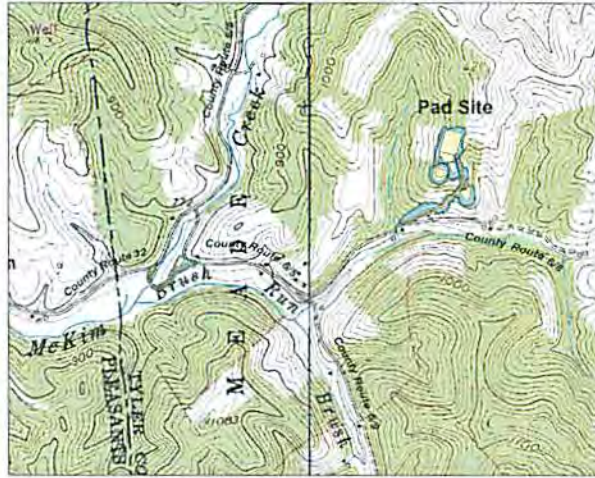

Ellenboro and Pennsboro Quadrangles



**AFFECTED TAX PARCELS:  
MEADE DISTRICT**

- TM 12 - PCL 21  
DAVID HARTLEY  
08/27/01  
08 ACRES
- (Affected area West Proposed Access Road # + 2.98 Acres, 1.50 Acres, 1.01 Acres of Parcel A)  
(Affected area West Proposed Access Road # + 2.98 Acres, 1.01 Acres, 1.01 Acres of Parcel B)  
(Affected area West Proposed Access Road # + 2.98 Acres, 1.01 Acres, 1.01 Acres of Parcel C)  
(Affected area West Proposed Access Road # + 2.98 Acres, 1.01 Acres, 1.01 Acres of Parcel D)  
(Affected area West Proposed Access Road # + 2.98 Acres, 1.01 Acres, 1.01 Acres of Parcel E)
- TM 12 - PCL 12  
DAVID HARTLEY  
08/27/01  
08 ACRES
- (Affected area West Proposed Access Road # + 2.98 Acres)
- TM 12 - PCL 21  
DAVID HARTLEY  
08/27/01  
08 ACRES
- (Affected area West Proposed Access Road # + 2.98 Acres, 1.01 Acres, 1.01 Acres of Parcel B)
- TM 12 - PCL 20  
DAVID HARTLEY  
08/27/01  
08 ACRES
- (Affected area West Proposed Access Road # + 2.98 Acres, 1.01 Acres, 1.01 Acres of Parcel B)
- TM 12 - PCL 26  
DAVID HARTLEY  
08/27/01  
08 ACRES
- (Affected area West Proposed Access Road # + 2.98 Acres, 1.01 Acres, 1.01 Acres of Parcel B)
- TM 12 - PCL 26  
DAVID HARTLEY  
08/27/01  
08 ACRES
- (Affected area West Proposed Access Road # + 2.98 Acres, 1.01 Acres, 1.01 Acres of Parcel B)



THIS DOCUMENT  
PREPARED FOR  
ANTERO RESOURCES CORP.

**APPROVED  
WVDEP OOG**  
*(Signature)*  
**3/25/2015**

API# 5902127  
API# 9502185  
API# 9502222  
API# 9502246  
API# 9502247  
API# 9502248

### Project Contacts

**Antero Resources**  
Tom Wilcox - Contributor  
304-869-3405 - Cell 304-483-0933 - Cell

John Wagner, Environmental Engineer  
304-622-3942 ext 311 - Cell 304-476-0770 - Cell

John Kucita, Construction Supervisor  
405-227-6344

Reggie Daniels, Survey Coordinator  
304-622-3942 - Cell 304-601-5558 - Cell

DeWayne H. Hannah, P.E. PE  
Hannah Engineering  
304-646-7171 - Cell 304-842-9333 - Cell

Midwest Ecrecivety  
Timothy R. Ferguson, M.S.  
Waters & Associates, Inc.  
304-343-1900 - Cell 304-363-9217 - Cell

Well Name & Number	API Number	NADEP	NADE27	UTM Zone 17	LAT & LONG - NAD83
Woodworth Unit 1N		N 318 728.58 E 1 548 434.28	N 318 802.59 E 1 577 945.28	N 4 357 231.541 E 500 501 547	LAT 39 07 55.681 LONG -80 59 34.921
Woodworth Unit 2N		N 318 716.29 E 1 548 401.63	N 318 802.48 E 1 577 945.28	N 4 357 230.833 E 500 500 279	LAT 39 07 55.450 LONG -80 59 35.922
Woodworth Unit 3N		N 318 708.63 E 1 548 378.91	N 318 872.63 E 1 577 950.91	N 4 357 228.648 E 500 500 509	LAT 39 07 55.400 LONG -80 59 34.880
Freedwell Unit 1N		N 318 898.69 E 1 548 366.23	N 318 905.19 E 1 577 937.31	N 4 357 222.725 E 500 504 741	LAT 39 07 55.304 LONG -80 59 35 014
Freedwell Unit 2N	06542127	N 318 687.36 E 1 548 383.54	N 318 933.55 E 1 577 854.54	N 4 357 218 728 E 500 507 871	LAT 39 07 55.209 LONG -80 59 35 067
Plym Run Unit 1N		N 318 677.73 E 1 548 360.86	N 318 843.93 E 1 577 832.88	N 4 357 216.641 E 500 507 203	LAT 39 07 55 111 LONG -80 59 35 082
Plym Run Unit 2N		N 318 668 10 E 1 548 388 48	N 318 834 30 E 1 577 828 17	N 4 357 213 893 E 500 506 882	LAT 39 07 55 017 LONG -80 59 35 114
Plym Run Unit 3N		N 318 658 48 E 1 548 388 48	N 318 828 66 E 1 577 828 48	N 4 357 213 843 E 500 506 882	LAT 39 07 54 922 LONG -80 59 35 140
Empty		N 318 648 93 E 1 548 382 93	N 318 818 05 E 1 577 823 82	N 4 357 212 398 E 500 504 922	LAT 39 07 54 837 LONG -80 59 35 130

### Well Location Restrictions:

- All Pad construction complies with the following restrictions:
- \*50' from an existing well or developed spring used for human or domestic animals
- \*50' from occupied dwelling or barn greater than 2500 SF used for poultry or dairy measured from the center of the pad
- \*100' from edge of disturbance to wetlands, perennial streams, natural or artificial lake, pond or reservoir
- \*300' from edge of disturbance to a naturally producing trout stream
- \*1000' of a surface or ground water intake to a public water supply
- \*FEMA Map Panel - \*\*54095C0279C. The selection site is not in any identified flood hazard area per WW Flood Tool


Center of Well Pad (UTM Meters)	N	E
Center of Well Pad (UTM Meters)	N = 4 357 318 115	E = 500 559 455
Center of Water Containment Pad A (UTM Meters)	N = 4 357 160 180	E = 500 554 894
Begin Access Road A (UTM Meters)	N = 4 355 999 851	E = 500 461 025
Begin Erosion Road A (UTM Meters)	N = 4 355 822 979	E = 495 391 283

LATITUDE	LONGITUDE
Center of Well Pad	N = 39 36 53.97 W = 80 59 30.97
Center of Water Containment Pad A	N = 39 36 54.92 W = 80 59 35.98
Begin Access Road A	N = 39 36 42.45 W = 80 59 50.21
Begin Erosion Road A	N = 39 36 05.88 W = 81 00 00.66

EOD Area (sq)					
Original Permitted LOD - 1/18/11	Revised Permitted LOD - 1/28/2014	Modified LOD	Change		
Description	Area	Description	Area	Description	Area
Erosion Road #1	1.70	Erosion Road #1	1.70	Erosion Road #1	1.70
Water Containment Pad #1	0.51	Water Containment Pad #1	0.51	Water Containment Pad #1	0.51
Access Road #1	3.93	Access Road #1	3.93	Access Road #1	3.93
Access Road #2	0.58	Access Road #2	0.58	Access Road #2	0.58
Access Road #3	0.90	Access Road #3	0.90	Access Road #3	0.90
Erosion Control Structure #1	0.73	Erosion Control Structure #1	0.73	Erosion Control Structure #1	0.73
Prototype Erosion Pad #1	0.43	Prototype Erosion Pad #1	0.43	Prototype Erosion Pad #1	0.43
Pad Area	2.90	Pad Area	2.90	Pad Area	2.90
Water Containment Pad #1	1.92	Water Containment Pad #1	1.92	Water Containment Pad #1	1.92
Erosion Control Structure #1	1.22	Erosion Control Structure #1	1.22	Erosion Control Structure #1	1.22
Water Storage	0.11	Water Storage	0.11	Water Storage	0.11
<b>Total</b>	<b>16.81</b>	<b>Total</b>	<b>16.81</b>	<b>Total</b>	<b>16.81</b>

Antero Resources will obtain an Encroachment Permit (Form MM-106) from the West Virginia Department of Transportation Division of Highways, prior to commencement of construction activities.

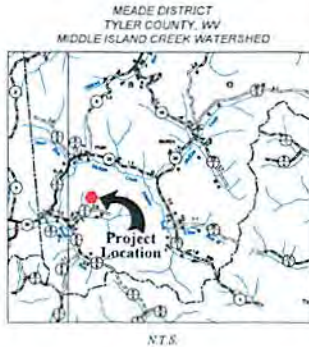

FLOODPLAIN CONDITIONS	NO
DO SITE CONSTRUCTION ACTIVITIES TAKE PLACE IN FLOODPLAIN	NO
PERMIT NEEDED FOR FLOODPLAIN COORDINATOR	NO
REG-RAS STUDY COMPLETED	N/A
DO SITE CONSTRUCTION ACTIVITIES TAKE PLACE IN FLOODPLAIN	N/A
FIRM MAP NUMBER(S) FOR SITE	54095C0279C
ACREAGE OF CONSTRUCTION IN FLOODPLAIN	N/A

Design Certification  
The drawings, construction notes, and reference diagrams attached hereto have been prepared in accordance with the West Virginia Code of State Rules, Division of Environmental Protection, Office of Oil and Gas, 25CSR18. The information reflects a temporary water containment pad. The computed above grade storage volume is 2,200 cubic meters or 2.84 acre ft. Siting method is pumped.

DATE	REVISIONS
10/25/2013	Design Development (Antero Resources)
11/14/2013	Final Design (Antero Resources)
12/11/2013	Final Design (Antero Resources)
*(Signature)*  
DEWAYNE H. HANNAH P.E. No. WV - 7233; P.S. No. WV - 1213  
**Hannah Engineering**  
PROJECT  
*(Signature)*  
DATE 11-4-2014

**AS BUILT**

**ANTERO RESOURCES**

**HARTLEY EAST PAD**  
**COVER SHEET**

MEADE DISTRICT  
DATE: 11/4/2014 SCALE: AS SHOWN JOB NO: 12 ARAC 01 DRAWN BY: JPH/MSH SHEET 1 OF 18 SHEETS  
TYLER COUNTY, WV


MISS Utility of West Virginia  
1-800-245-4848  
West Virginia State Law  
(Section XXV Chapter 24 - C)  
Requires that you call two business days before you dig in the state of West Virginia  
**IT'S THE LAW!!!**

**811**  
Know what's below.  
Call before you dig.

MISS Utility will be contacted prior to the start of the project. MISS Utility was notified for the locating of utilities for the project prior to the project design. The MISS Utility ticket number is 1234596656 - Notified 12/10/12



**APPROVED WVDEP OOG**  
 3/25/2015

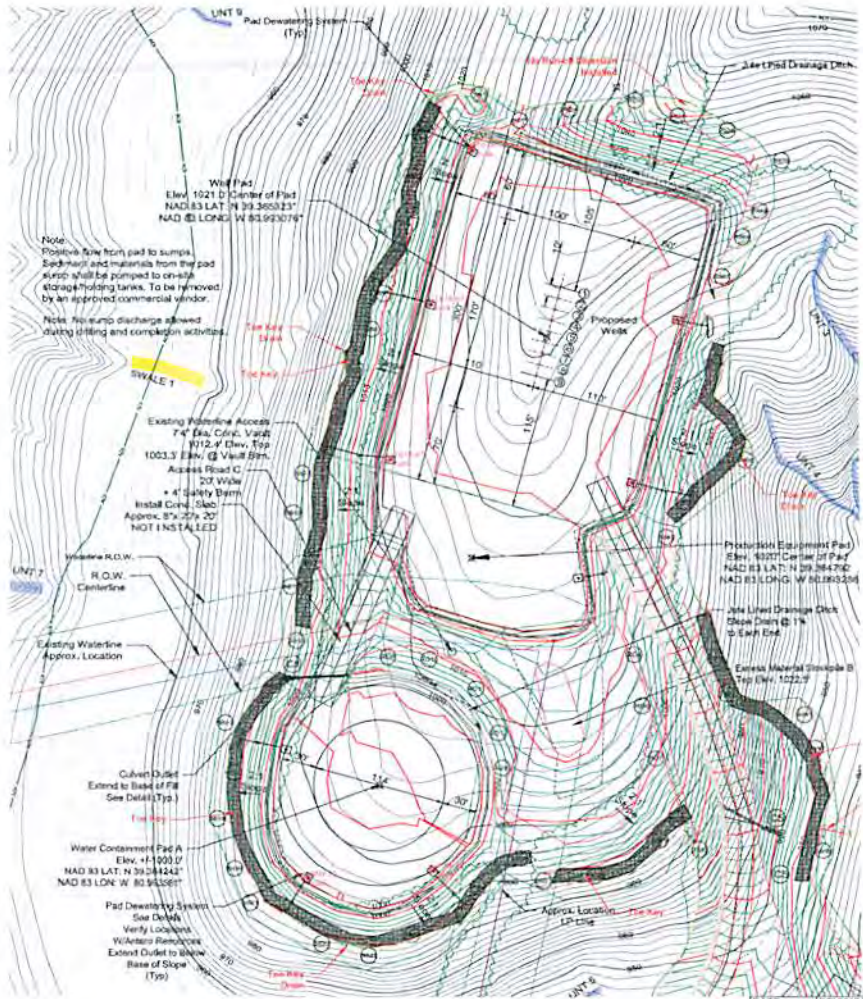

Note:  
 Positive flow from pad to sumps.  
 Backhaul and materials from the pad  
 must be pumped to on-site  
 storage/holding tanks. To be removed  
 by an approved commercial vendor.  
 Note: No pump discharge allowed  
 during drilling and completion activities.

SCALE 1"

Existing Pipeline Access  
 74" Dia. Concr. Vault  
 1012.4' Elev. Top  
 1003.3' Elev. @ Vault Btm.  
 Access Road C  
 12' Wide  
 4' Safety Berm  
 Install Concr. Slab  
 Approx. 8' x 27' x 20"  
 HOT IN PLACE LESC


Waterline R.O.W.  
 R.O.W.  
 Centerline  
 Existing Waterline  
 Approx. Location

Culvert Outlet  
 Extend to Base of Fill  
 See Detail (3 Typ.)

Water Containment Pad A  
 Elev. +1100.0'  
 NAD 83 LAT: N 39.244242°  
 NAD 83 LON: W 80.945861°

Pad Dewatering System  
 See Details  
 Verify Locations  
 Waterline Run-off  
 Extend Outlet to Below  
 Base of Slope  
 (Typ.)

**HARTLEY EAST PAD  
 SITE PLAN  
 PADS  
 ANTERO RESOURCES  
 CORPORATION**

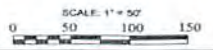

DATE	REVISIONS
FE 02 2013	Change Landowner to Jason M. Hartley
APR 22 2013	Update Elevation Impacts-Forested Area
MAY 23 2013	Revised Road Grade
MAY 20 2013	Standard Quantity Sheet Added
MAY 20 2013	Revised Burns & Details Sheet Added
MAY 20 2013	Various Minor Changes
June 28 2013	Wall Layout & QC Revisions
JUL 12 2013	Revised Foreland Units
Aug 1 2013	Minor Revisions
AUG 20 2013	Water Tank Pad
AUG 28 2013	Revised Quantities
AUG 29 2013	Structure Name Change
Oct 2 2013	Revised Structure Road A
NOV 18 2013	Per DEP Review
JAN 13 2014	Modifications to Prod S1 & Water Cont. Pads
JAN 30 2014	Modifications per DEP
APR 24 2014	Added Spoil Area
APR 24 2014	Revised Sheds
APR 28 2014	Revised Sheds
MAY 4 2014	As Built

Silt Socks Shown  
 As Built Locations

Culverts Shown  
 As Built Locations

Toe Keys and All Fill Material  
 Placed in 12" Lifts  
 @>95% Compaction  
 Based on a Standard Proctor

Toe Keys and All Fill Material  
 Placed in 12" Lifts  
 @>95% Compaction  
 Based on a Standard Proctor  
 Fill Keyways, Benches, and  
 Drainage As Built per PS&R  
 Drawing 14-###-b1 shown  
 following Reclamation Plan

Colluvial Material removed to  
 Spoil Area and reworked into  
 Spoil Pile.

Pad Dewatering System  
 Shown As Built

Well Pad & Water Containment Pad  
 1 1/2" - 2" of 1 1/2" Crusher Run on  
 8" - 12" of 3" - 5" Stone on  
 US200 Geotextile Fabric on  
 12" FDR Soil

- PROPOSED WELLS**
1. Woodworth Unit 1H
  2. Woodworth Unit 2H
  3. Woodworth Unit 3H
  4. Freeland Unit 1H
  5. Freeland Unit 2H
  6. Plum Run Unit 1H
  7. Plum Run Unit 2H
  8. Plum Run Unit 3H
  9. Empty



**ANTERO RESOURCES**  
**HARTLEY EAST PAD  
 SITE PLAN  
 PADS**

MEADE DISTRICT		TYLER COUNTY, WV			
DATE:	SCALE:	JOB NO.:	DRAWN BY:	SHEET #	
DEC.28.2012	1"=50'	12 ARAC 91	DAN GRIMM	OF 18 SHEETS	

Modified LOD Area (Acres)	
Description	Acres
Ent. Road A	1.70
Water Containment Pad B	0.53
Access Road A	3.60
Access Road B	0.09
Access Road C	0.28
Excav Material Stockpile B	0.73
Well Pad	2.88
Water Containment Pad A	1.53
Excav Material Stockpile A	1.31
Totals	13.08
Wooded	5.72
Non-Wooded	7.36
Totals	13.08

**LEGEND**

- Proposed Road 2' Contour
- Proposed Road 10' Contour
- Proposed Pad and/or Pit 2' Contour
- Proposed Pad and/or Pit 10' Contour
- Existing 2' Contour
- Existing 10' Contour
- LOD Limit of Disturbance
- AOI Area of Influence
- Guard Rail
- Rock Rip-rap Ditch
- TRM Lined Ditch
- Direction of Flow
- Sheet Piling
- Silt Sock
- Run-off Diversion
- Level Spreader
- Culvert w/ Riprap
- Existing Culvert
- Existing Overhead Electric (Single Phase)
- Existing Gaslines
- Ephemeral Stream
- Intermittent Stream
- Perennial Stream
- Single Gully
- Ditch
- Wetland/Pond
- Toe Key


**AS BUILT**



# ST PAD CTION PLAN, & CONTROL PLANS CORPORATION



THIS DOCUMENT  
PREPARED FOR  
ANTERO RESOURCES CORP

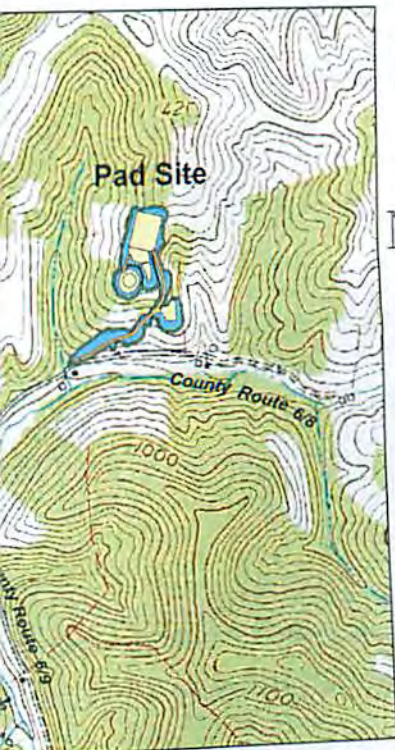

### AFFECTED TAX PARCELS: MEADE DISTRICT

TM 12 - PCL 21  
DAVID HARTLEY  
DB 271421  
29 ACRES

(Affected area from Proposed Access Road A = 3.60 Acres, 1,349 ft of Road A)  
(Affected area from Proposed Access Road B = 0.09 Acres, 101 ft of Road B)  
(Affected area from Proposed Access Road C = 0.26 Acres, 338 ft of Road C)  
(Affected area from Proposed Water Containment Pad A = 1.33 Acres)  
(Affected area from Proposed Well Pad = 2.42 Acres)  
(Affected area from Proposed Production Equipment Pad = 0.63 Acres)  
(Affected area from Proposed Excess Material Stockpile A = 1.31 Acres)  
(Affected area from Proposed Excess Material Stockpile B = 0.73 Acres)

TM 12 - PCL 12  
DAVID HARTLEY  
DB 271421  
46 ACRES

(Affected area from Proposed Well Pad = 0.26 Acre)

TM 12 - PCL 21.1  
JASON M. HARTLEY  
DB 404613  
1.0 ACRE

(Affected area from Proposed Access Road A = 0.12 Acres, 33 ft of Road A)

TM 12 - PCL 22  
DAVID HARTLEY  
DB 271421  
125 ACRES

(Affected area from Proposed Access Road A = 0.08 Acres, 0 ft of Road A)  
(Affected area from Proposed Entrance Road A = 0.02 Acres, 0 ft of Entrance Rd A)

TM 12 - PCL 26  
DAVID HARTLEY  
DB 271421  
110 ACRES

(Affected area from Proposed Entrance Road A = 1.58 Acres, 1024 ft of Entrance Rd A)  
(Affected area from Proposed Water Containment Pad B = 0.53 Acres)

*Michael Loff*  
3/26/15

### oro Quadrangles

Original Permitted LOD - 11/18/13		Revised Permitted LOD - 1/30/2014		Modified LOD		Changes
Description	Acres	Description	Acres	Description	Acres	Acres
Entrance Road A	1.70	Entrance Road A	1.70	Entrance Road A	1.70	Unchanged
Water Containment Pad B	0.53	Water Containment Pad B	0.53	Water Containment Pad B	0.53	Unchanged
Access Road A	3.83	Access Road A	3.80	Access Road A	3.80	Unchanged
Access Road B	0.09	Access Road B	0.09	Access Road B	0.09	Unchanged
Access Road C	0.09	Access Road C	0.28	Access Road C	0.28	Unchanged
Production Equipment Pad	0.91	Production Equipment Pad	0.63	Production Equipment Pad	0.73	Unchanged
Well Pad	2.66	Well Pad	2.68	Well Pad	2.68	Unchanged
Water Containment Pad A	1.65	Water Containment Pad A	1.33	Water Containment Pad A	1.33	Unchanged
Excess Material Stockpile	0.90	Excess Material Stockpile A	1.22	Excess Material Stockpile A	1.31	+0.09
Topsoil Stockpile	0.11					
<b>Totals</b>	<b>12.51</b>	<b>Totals</b>	<b>12.99</b>	<b>Totals</b>	<b>13.08</b>	<b>+0.09</b>
Wooded	5.15	Wooded	5.63	Wooded	5.72	+0.09
Non-Wooded	7.36	Non-Wooded	7.36	Non-Wooded	7.36	Unchanged
<b>Totals</b>	<b>12.51</b>	<b>Totals</b>	<b>12.99</b>	<b>Totals</b>	<b>13.08</b>	<b>+0.09</b>

### Design Certification

The drawings, construction notes, and reference diagrams attached hereto have been prepared in accordance with the West Virginia Code of State Rules, Division of Environmental Protection, Office of Oil and Gas 35CSR8. The information reflects a temporary water containment pad. The computed above grade storage volume is 22,000 barrels or 2.84 acre ft., filling method is pumped.

### DRAWING INDEX

- 1 COVER SHEET
- 2 SCHEDULE OF QUANTITIES
- 3 CONSTRUCTION, EROSION & SEDIMENT CONTROL NOTES
- 4 EXISTING CONDITIONS
- 5 OVERALL SITE PLAN INDEX
- 6-7 ROAD PLAN & PROFILES
- 8 SITE PLAN
- 9 ROAD SECTIONS
- 10-11 WELL PAD & WATER CONTAINMENT PAD PROFILE & SECTIONS
- 12 BRIDGE PLANS
- 13 TOPSOIL STORAGE AREA
- 14-17 DETAILS
- 18 RECLAMATION PLAN



DEWAYNE N. HANNAH P.E. No. WV - 7233; P.S. No. WV - 1213

*Hartley East Pad*  
PROJECT

11-4-2014  
DATE



Received  
Office of Oil & Gas  
MAR 27 2015

DATE:	REVISIONS:
FEB 21, 2013	Change Landowner to Jason M. Hartley
APR 22, 2013	Update Stream Impacts-Forested Area
MAY 20, 2013	Revised Road Grade
MAY 20, 2013	Standard Quantity Sheet Added
MAY 20, 2013	Revised Sump & Details Sheet Added
MAY 29, 2013	Various Minor Changes
JUNE 28, 2013	Well Layout & QC Revisions
JULY 29, 2013	Inverted Freeland Units
AUG 1, 2013	Misc. Revisions
AUG 20, 2013	Water Tank Pad
AUG 28, 2013	Revised Quantities
AUG 30, 2013	Structure Name Changes
OCT. 2, 2013	Relocated Entrance Road A
NOV. 18, 2013	Per DEP Review
JAN. 13, 2014	Modifications to Prod. Eq. & Water Cont. Pads
JAN. 30, 2014	Modified Per DEP
APRIL 9, 2014	ADD Topsoil Area
APRIL 24, 2014	Rename Wells
APRIL 28, 2014	Rename Wells
NOV. 4, 2014	As-Built

**HANNAH  
ENGINEERING**  
ELKINS, WV  
304-636-7777

**ANTERO RESOURCES**  
**HARTLEY EAST PAD**  
**COVER SHEET**

MEADE DISTRICT TYLER COUNTY, WV  
DATE: DEC 28, 2012 SCALE: AS SHOWN JOB NO: 12 ARAC01 DRAWN BY: JERRI REED SHEET 1 OF 18 SHEETS

AS BUILT

05/29/2015