



LATITUDE 39°27'30" LONGITUDE 80°57'30"

3,201' 8,141' TO BOTTOM HOLE

LATITUDE 39°30'00" LONGITUDE 80°57'30"

Antero Resources Corporation
Well No. Forrest Fenn Unit 1H

AS DRILLED DATA:
WELL 1H TOP HOLE INFORMATION:
N: 337,307ft E: 1,584,803ft
LAT: 39°25'00.42" N: 80°58'10.78"
BOTTOM HOLE INFORMATION:
N: 392,758ft E: 1,580,113ft
LAT: 39°27'32.35" N: 80°59'13.79"
WEST VIRGINIA COORDINATE SYSTEM OF 1927 NORTH ZONE. ZONE WAS DERIVED FROM MEASUREMENTS TAKEN WITH TRIANGLE GEOMX SUBMETER MAPPING GRADE GPS UNIT. PLAT ORIENTATION, CORNER, AND WELL REFERENCE TIE LINES ARE BASED ON GRID NORTH.
(NAD) 83 (UTM) ZONE 17 COORDS:
WELL 1H TOP HOLE INFORMATION:
N: 4,363,038m E: 502,626m
BOTTOM HOLE INFORMATION:
N: 4,367,721m E: 501,119m

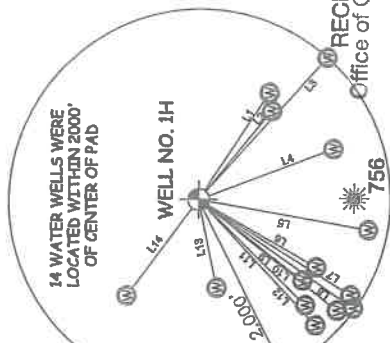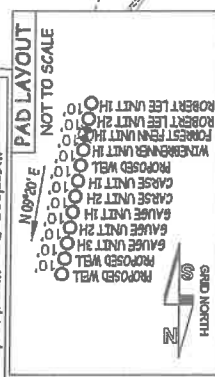

RECEIVED
Office of Oil and Gas
AUG 31 2020
WV Department of Environmental Protection

I, THE UNDERSIGNED, HEREBY CERTIFY THAT THIS PLAN IS CORRECT TO THE BEST OF MY KNOWLEDGE AND BELIEF AND SHOWS ALL THE INFORMATION REQUIRED BY LAW AND THE RULES ISSUED AND PRESCRIBED BY THE DEPARTMENT OF ENVIRONMENTAL PROTECTION.



STATE OF WEST VIRGINIA, DIVISION OF ENVIRONMENTAL PROTECTION, OFFICE OF OIL AND GAS
WILLOW LAND SURVEYING PLLC
220 MASONIC AVE. PENNSBORO WEST VIRGINIA 26415

Table with 3 columns: TYP, SURFACE OWNER, DB/P6, ACREAGE. Lists various landowners and their respective acreages.

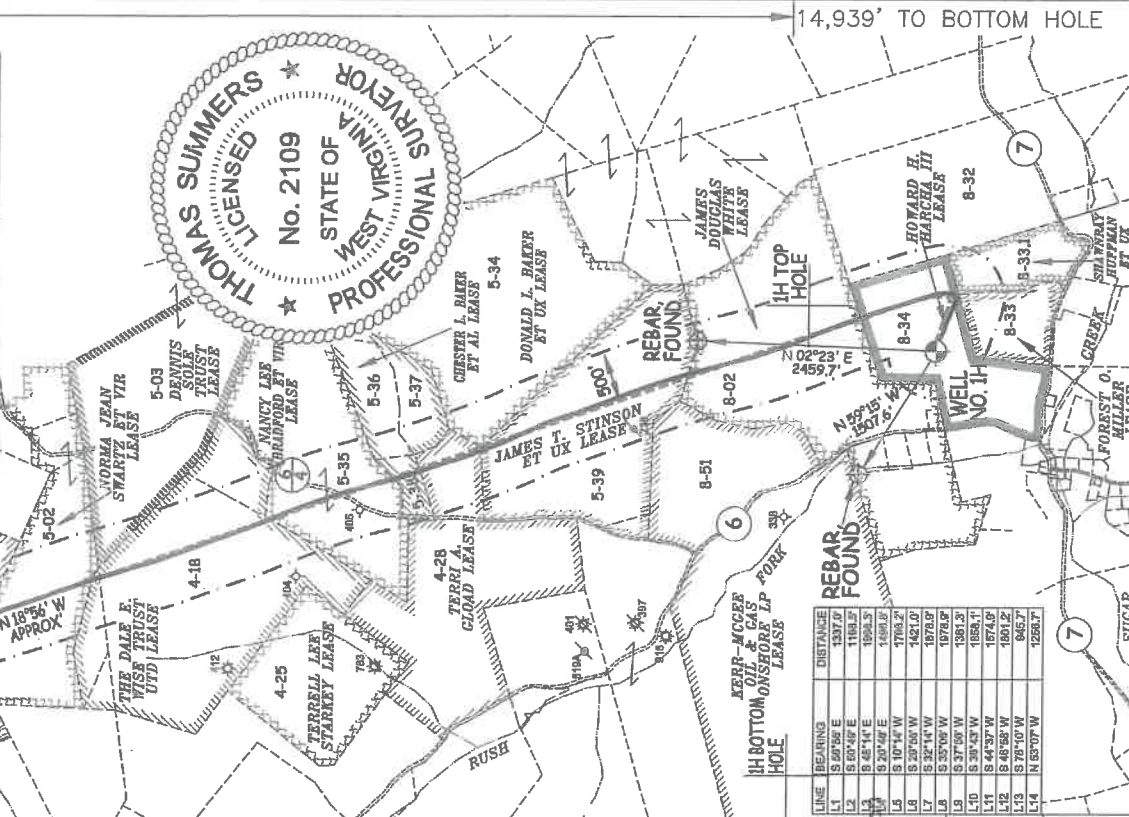


Table with 2 columns: LINE, BEARING, DISTANCE. Lists well path measurements.

Job # 18-028WA, Drawing # FORRESTFENN1H, Scale 1" = 2000', Accuracy Submeter, Proven Source of Elev. Submeter Mapping Grade GPS, State of West Virginia Department of Energy Division of Oil and Gas.

LEGEND: Surface Owner Boundary Lines +/-, Interior Surface Tracts +/-, Proposed Well Path, As Drilled Well Path. Includes notes about data accuracy and well hole information.

WELL TYPE: OIL, GAS, LIQUID INJECTION, WASTE DISPOSAL. LOCATION: ELEVATION 986' - AS BUILT. SURFACE OWNER: JOSEPH R. RYMER JR. OIL & GAS ROYALTY OWNER: HOWARD H. HARGCHA III.

DIANNA STAMPER - CT CORPORATION SYSTEM, 5400 D BIG TYLER ROAD, CHARLESTON, WV 25313