

west virginia department of environmental protection

Office of Oil and Gas 601 57th Street, S.E. Charleston, WV 25304 (304) 926-0450 fax: (304) 926-0452

Harold D. Ward, Cabinet Secretary www.dep.wv.gov

Monday, March 29, 2021 WELL WORK PERMIT Horizontal 6A / New Drill

ANTERO RESOURCES CORPORATION 1615 WYNKOOP STREET DENVER, CO 80202

Re: Permit approval for WADE 1H 47-095-02729-00-00

This well work permit is evidence of permission granted to perform the specified well work at the location described on the attached pages and located on the attached plat, subject to the provisions of Chapter 22 of the West Virginia Code of 1931, as amended, and all rules and regulations promulgated thereunder, and to any additional specific conditions and provisions outlined in the pages attached hereto. Notification shall be given by the operator to the Oil and Gas Inspector at least 24 hours prior to the construction of roads, locations, and/or pits for any permitted work. In addition, the well operator shall notify the same inspector 24 hours before any actual well work is commenced and prior to running and cementing casing. Spills or emergency discharges must be promptly reported by the operator to 1-800-642-3074 and to the Oil and Gas Inspector.

Please be advised that form WR-35, Well Operators Report of Well Work is to be submitted to this office within 90 days of completion of permitted well work, as should form WR-34 Discharge Monitoring Report within 30 days of discharge of pits, if applicable. Failure to abide by all statutory and regulatory provisions governing all duties and operations hereunder may result in suspension or revocation of this permit and, in addition, may result in civil and/or criminal penalties being imposed upon the operators.

Per 35 CSR 4-5.2.g this permit will expire in two (2) years from the issue date unless permitted well work is commenced. If there are any questions, please feel free to contact me at (304) 926-0450.

James A. Martin Chief

Operator's Well Number: WADE 1H

ROGER D. BLIZZARD & RUT

U.S. WELL NUMBER: 47-095-02729-00-00

Farm Name:

Horizontal 6A New Drill Date Issued: 3/29/2021

PERMIT CONDITIONS

West Virginia Code § 22-6A-8(d) allows the Office of Oil and Gas to place specific conditions upon this permit. Permit conditions have the same effect as law. Failure to adhere to the specified permit conditions may result in enforcement action.

CONDITIONS

- This proposed activity may require permit coverage from the United States Army Corps of Engineers
 (USACE). Through this permit, you are hereby being advised to consult with USACE regarding this proposed
 activity.
- 2. If the operator encounters an unanticipated void, or an anticipated void at an unanticipated depth, the operator shall notify the inspector within 24 hours. Modifications to the casing program may be necessary to comply with W. Va. Code § 22-6A-5a (12), which requires drilling to a minimum depth of thirty feet below the bottom of the void, and installing a minimum of twenty (20) feet of casing. Under no circumstance should the operator drill more than one hundred (100) feet below the bottom of the void or install less than twenty (20) feet of casing below the bottom of the void.
- 3. When compacting fills, each lift before compaction shall not be more than 12 inches in height, and the moisture content of the fill material shall be within limits as determined by the Standard Proctor Density test of the actual soils used in specific engineered fill, ASTM D698, Standard Test Method for Laboratory Compaction Characteristics of Soil Using Standard Effort, to achieve 95 % compaction of the optimum density. Each lift shall be tested for compaction, with a minimum of two tests per lift per acre of fill. All test results shall be maintained on site and available for review.
- 4. Operator shall install signage per § 22-6A-8g (6) (B) at all source water locations included in their approved water management plan within 24 hours of water management plan activation.
- 5. Oil and gas water supply wells will be registered with the Office of Oil and Gas and all such wells will be constructed and plugged in accordance with the standards of the Bureau for Public Health set forth in its Legislative rule entitled Water Well Regulations, 64 C.S.R. 19. Operator is to contact the Bureau of Public Health regarding permit requirements. In lieu of plugging, the operator may transfer the well to the surface owner upon agreement of the parties. All drinking water wells within fifteen hundred feet of the water supply well shall be flow tested by the operator upon request of the drinking well owner prior to operating the water supply well.
- 6. Pursuant to the requirements pertaining to the sampling of domestic water supply wells/springs the operator shall, no later than thirty (30) days after receipt of analytical data provide a written copy to the Chief and any of the users who may have requested such analyses.
- 7. 24 hours prior to the initiation of the completion process the operator shall notify the Chief or his designee.
- 8. During the completion process the operator shall monitor annular pressures and report any anomaly noticed to the chief or his designee immediately.
- 9. If any explosion or other accident causing loss of life or serious personal injury occurs in or about a well or well work on a well, the well operator or its contractor shall give notice, stating the particulars of the explosion or accident, to the oil and gas inspector and the Chief, within 24 hours of said accident.
- 10. During the casing and cementing process, in the event cement does not return to the surface, the oil and gas inspector shall be notified within 24 hours.

API Number:	

PERMIT CONDITIONS

11. The operator shall provide to the Office of Oil and Gas the dates of each of the following within 30 days of their occurrence: completion of construction of the well pad, commencement of drilling, cessation of drilling, completion of any other permitted well work, and completion of the well. Such notice shall be provided by sending an email to DEPOOGNotify@wv.gov.

4709502729

OPERATOR WELL NO. Wade Unit 1H

Well Pad Name: Blizzard Pad

STATE OF WEST VIRGINIA DEPARTMENT OF ENVIRONMENTAL PROTECTION, OFFICE OF OIL AND GAS WELL WORK PERMIT APPLICATION

1) Well Operator:	Antero Resources Corpora	494507062	095 - Tyler	Ellsworth	Shirley 7.5'
		Operator ID	County	District	Quadrangle
2) Operator's Well N	Number: Wade Unit 1H	Well Pad	Name: Blizza	rd Pad	
3) Farm Name/Surfa	Roger D. Blizzard & Ruth E.	Spencer Public Road	d Access: US	Route 34	
4) Elevation, current	ground: 1004' Ele	evation, proposed 1	post-construction	on:	
5) Well Type (a) O		Unde	rground Storag	e	
	f Gas Shallow X	Deep			
6) Existing Pad: Yes	Horizontal X		The second se	177	DmH 3-4-21
7) Proposed Target F	Formation(s), Depth(s), Anticigon (000' TVD, Anticipated Thicknes				3-4-21
8) Proposed Total Ve	ertical Depth: 7000' TVD				
9) Formation at Total	l Vertical Depth: Marcellus				
10) Proposed Total M	Measured Depth: 16600'				
11) Proposed Horizon	ntal Leg Length: 7265'				
12) Approximate Fre	esh Water Strata Depths:	16'			
13) Method to Determ	mine Fresh Water Depths: 4	7-095-02274			
14) Approximate Salt	twater Depths: 1430', 1813'				
15) Approximate Coa	al Seam Depths: None Identi	ified			
16) Approximate Dep	pth to Possible Void (coal min	ne, karst, other):	lone Anticipat	ed	
	vell location contain coal seam adjacent to an active mine?	Yes	No	X	
(a) If Yes, provide M	Mine Info: Name:				
-	Depth:				
	Seam:				
	Owner:				
	Qf	RECEIVED fice of Oil and Gas			

MAR 08 2021

Α	ΡI	N	O	47-	095

OPERATOR WELL NO. Wade Unit 1H
Well Pad Name: Blizzard Pad

18)

CASING AND TUBING PROGRAM

ТҮРЕ	Size (in)	New or Used	Grade	Weight per ft. (lb/ft)	FOOTAGE: For Drilling (ft)	INTERVALS: Left in Well (ft)	CEMENT: Fill-up (Cu. Ft.)/CTS
Conductor	20"	New	H-40	94#	80'	80'	CTS, 77 Cu. Ft.
Fresh Water	13-3/8"	New	J-55	54.5#	300'	300'	CTS, 417 Cu. Ft.
Coal	9-5/8"	New	J-55	36#	2500'	2500'	CTS, 1018 Cu. Ft.
Intermediate							
Production	5-1/2"	New	P-110	23#	16600'	16600'	4157 Cu. Ft
Tubing	2-3/8"	New	N-80	4.7#			
Liners					:		

DMH 3-4-21

ТҮРЕ	Size (in)	Wellbore Diameter (in)	Wall Thickness (in)	Burst Pressure (psi)	Anticipated Max. Internal Pressure (psi)	Cement Type	Cement Yield (cu. ft./k)
Conductor	20"	24"	0.438"	1530	50	Class A	
Fresh Water	13-3/8"	17-1/2"	0.38"	2730	1000	Class A	~1.18
Coal	9-5/8"	12-1/4"	0.352"	3520	1500	Class A	~1.18
Intermediate		:					
Production	5-1/2"	8-3/4" & 8-1/2"	0.415"	12,630	2500	Lead-H/POZ & Tail - H	H/POZ-1.44 & H-1.8
Tubing	2-3/8"	4.778"	0.19"	11,200			
Liners				3			

PACKERS

Kind:	N/A		
Sizes:	N/A		
Depths Set:	N/A		

RECEIVED
Office of Oil and Gas

MAR 08 2021

WW-6B
(10/14)

API NO. 47- <u>095 </u>		
OPERATOR WELL	NO.	Wade Unit 1H
Well Pad Name	Blizzar	rd Pad

Describe proposed well work, including the drilling an	and 1	plugging	back of	any pilot hole:
--	-------	----------	---------	-----------------

Drill a new vertical shallow well into the Marcellus Shale.

DMH 3-4-21

20) Describe fracturing/stimulating methods in detail, including anticipated max pressure and max rate:

Antero plans to pump Slickwater into the Marcellus Shale formation in order to ready the well for production. The fluid will be comprised of approximately 99 percent water and sand, with less than 1 percent special-purpose additives as shown in the attached "List of Anticipated Additives Used for Fracturing or Stimulating Well."

Anticipated Max Pressure - 9300 lbs Anticipated Max Rate - 80 bpm

- 21) Total Area to be disturbed, including roads, stockpile area, pits, etc., (acres): Existing 26.80 acres
- 22) Area to be disturbed for well pad only, less access road (acres): Existing 9.52 acres

23) Describe centralizer placement for each casing string:

Conductor: no centralizers

Surface Casing: one centralizer 10' above the float shoe, one on the insert float collar and one every 4th joint spaced up the hole to surface.

Intermediate Casing: one centralizer above float joint, one centralizer 5' above float collar and one every 4th collar to surface. Production Casing: one centralizer at shoe joint and one every 3 joints to top of cement in intermediate casing.

24) Describe all cement additives associated with each cement type:

Conductor: no additives, Class A cement.

Surface: Class A cement with 2-3% calcium chloride and 1/4 lb of flake Intermediate: Class A cement with 1/4 lb of flake, 5 gallons of clay treat

Production: Lead cement- 50/50 Class H/Poz + 1.5% salt + 1% C-45 + 0.5% C-16a + 0.2% C-12 + 0.45% C-20 + 0.05% C-51
Production: Tail cement- Class H + 45 PPS Calcium Carbonate + 1.0% FL-160 + 0.2% ACGB-47 + 0.05% ACSA-51 + 0.2% ACR-20

25) Proposed borehole conditioning procedures:

RECEIVED
Office of Oil and Gas

MAR 0 8 2021

WV Department of Environmental Protection

*Note: Attach additional sheets as needed.

WW-9 (4/16)

Δ	Ρī	Mu	mber	47 _	095
	ч.	TAIT	шосі	71-	

Operator's Well No. Wade Unit 1H

STATE OF WEST VIRGINIA DEPARTMENT OF ENVIRONMENTAL PROTECTION OFFICE OF OIL AND GAS

FLUIDS/ CUTTINGS DISPOSAL & RECLAMATION PLAN
Operator Name Antero Resources Corporation OP Code 494507062
Watershed (HUC 10) Outlet Middle Island Creek Quadrangle Shirley 7.5
Do you anticipate using more than 5,000 bbls of water to complete the proposed well work? Yes No
Will a pit be used? Yes No V
If so, please describe anticipated pit waste:
Will a synthetic liner be used in the pit? Yes No If so, what ml.? N/A
Proposed Disposal Method For Treated Pit Wastes:
Land Application
Underground Injection (UIC Permit Number *UIC Permit # will be provided on Form WR-34
Reuse (at API Number Future permitted well locations when applicable. API# will be provided on Form WR-34 Off Site Disposal (Supply form WW-9 for disposal location) (Meadowfill Landfill Permit #SWF-1032-98)
Other (Explain Northwestern Landfill Permit #SWF-1025/ WV0109410
Will closed loop system be used? If so, describe: Yes, fluids stored in tanks, cuttings removed offsite and taken to landfill.
Drilling medium anticipated for this well (vertical and horizontal)? Air, freshwater, oil based, etc. Surface - Alf freshwater, intermediate - Durd/SHH Fearm, Production - Water Based Mod
-If oil based, what type? Synthetic, petroleum, etc. Synthetic
Additives to be used in drilling medium? Please See Attachment
Drill cuttings disposal method? Leave in pit, landfill, removed offsite, etc. Drill cuttings stored in tanks, removed offsite and taken to landfill.
-If left in pit and plan to solidify what medium will be used? (cement, lime, sawdust)_N/A
-Landfill or offsite name/permit number? Mesdowfill Landfill (Permit #SWF-1032-98), Northwestern Landfill (Permit # SWF-1025/WV0109410)
Permittee shall provide written notice to the Office of Oil and Gas of any load of drill cuttings or associated waste rejected at any West Virginia solid waste facility. The notice shall be provided within 24 hours of rejection and the permittee shall also disclose where it was properly disposed.
I certify that I understand and agree to the terms and conditions of the GENERAL WATER POLLUTION PERMIT issued on August 1, 2005, by the Office of Oil and Gas of the West Virginia Department of Environmental Protection. I understand that the provisions of the permit are enforceable by law. Violations of any term or condition of the general permit and/or other applicable law or regulation can lead to enforcement action. I certify under penalty of law that I have personally examined and am familiar with the information submitted on this application form and all attachments thereto and that, based on my inquiry of those individuals immediately responsible for obtaining the information, I believe that the information is true, accurate, and complete. I am aware that there are significant penalties for submitting false information, including the possibility of fine or imprisonment. RECEIVED Office of Oil and Gas Company Official Signature Gretchen Kohler MAR 0 8 2021 Company Official Title Sentor Environmental & Regulatory Manager
O O W
Subscriber and sworn before me this day of 20
Notary Public MEGAN GRIFFITH
NOTARY PUBLIC
STATE OF COLORADO
My commission expires STATE OF COLORADO NOTARY ID 20184011666
IVIV COmmission Capites

Form WW-9

Proposed Revegetation Treatment: Acre	s Disturbed 26.80 ac	res Prevegetation	pH	
Lime 2-4 Tons/a	cre or to correct to pH			
	ood Fiber (will be used w	**		
Fertilizer amount 500		/acre		
Mulch 2-3				
	Tons/ac Road "A" (1.47 acres) + Access	Road "B" (1.84 acres) + Staring Area (1.02 acr	10s) + Well Pad (9,52 spres) +	
	Excess/Topsoil Stockpiles	<u>(9.19 acres) = 26,80 Acres</u> Mixtures		
Temporary		Perm	nanent	
Seed Type lbs/ac	re	Seed Type	lbs/acre	
Annual Ryegrass 4	0	Crownvetch	10-15	
Field Bromegrass 4	0	Tall Fescue	30	
See attached Table 3 for additional seed type (Bilzzard Pad	Design Sheet Page 4)	See attached Table 4A for additional seed type (Bitzzard Pad Design Sheet Page		
*or type of grass seed requested by surface owner		*or type of groce good requested by surface surror		
ttach: Iaps(s) of road, location, pit and propose rovided). If water from the pit will be lar	d area for land applicat	*or type of grass seed required ion (unless engineered plans incluensions (L x W x D) of the pit, and	uding this info have been	
ttach: laps(s) of road, location, pit and propose rovided). If water from the pit will be lar creage, of the land application area.	d area for land applicat d applied, include dime	ion (unless engineered plans inch	uding this info have been	
attach: flaps(s) of road, location, pit and propose rovided). If water from the pit will be lare creage, of the land application area. hotocopied section of involved 7.5' topogetical contents of the land application.	d area for land applicat d applied, include dime	ion (unless engineered plans inch	uding this info have been	
ttach: Iaps(s) of road, location, pit and propose rovided). If water from the pit will be lar creage, of the land application area. hotocopied section of involved 7.5' topogram and approved by:	d area for land applicat d applied, include dime	ion (unless engineered plans inch	uding this info have been	
ttach: Iaps(s) of road, location, pit and propose rovided). If water from the pit will be lar creage, of the land application area. hotocopied section of involved 7.5' topogram and approved by:	d area for land applicat d applied, include dime	ion (unless engineered plans inch	uding this info have been	
Attach: flaps(s) of road, location, pit and propose rovided). If water from the pit will be lar creage, of the land application area. hotocopied section of involved 7.5' topogram and the creage of the land application area.	d area for land applicat d applied, include dime	ion (unless engineered plans inch	uding this info have been	
Attach: Maps(s) of road, location, pit and propose rovided). If water from the pit will be lar creage, of the land application area. hotocopied section of involved 7.5' topogram and the section of the s	d area for land applicat d applied, include dime	ion (unless engineered plans inch	uding this info have been	
Attach: flaps(s) of road, location, pit and propose rovided). If water from the pit will be lar creage, of the land application area. hotocopied section of involved 7.5' topogram and the creage of the land application area.	d area for land applicat d applied, include dime	ion (unless engineered plans inch	uding this info have been	
ttach: Iaps(s) of road, location, pit and propose rovided). If water from the pit will be lar creage, of the land application area. hotocopied section of involved 7.5' topogram and approved by:	d area for land applicat d applied, include dime	ion (unless engineered plans inch	uding this info have been	
Attach: flaps(s) of road, location, pit and propose rovided). If water from the pit will be lar creage, of the land application area. hotocopied section of involved 7.5' topogram and the creage of the land application area.	d area for land applicat d applied, include dime	ion (unless engineered plans inch	ading this info have been ad dimensions (L x W), and area in the second	
Attach: Maps(s) of road, location, pit and propose rovided). If water from the pit will be lar creage, of the land application area. hotocopied section of involved 7.5' topogram and the section of the se	d area for land applicat d applied, include dime	ion (unless engineered plans inch	AECEIVED	
Attach: Maps(s) of road, location, pit and propose provided). If water from the pit will be lar creage, of the land application area. Photocopied section of involved 7.5' topogram Approved by: Comments: itle: Oil + Gar Taggetha	d area for land applicated applied, include dime	ion (unless engineered plans inch	ading this info have been ad dimensions (L x W), and area in the second	

Form WW-9 Additives Attachment

SURFACE INTERVAL

- 1. Fresh Water
- 2. Soap -Foamer AC
- 3. Air

INTERMEDIATE INTERVAL

STIFF FOAM RECIPE:

- 1) 1 ppb Soda Ash / Sodium Carbonate-Alkalinity Control Agent
- 2) 1 ppb Conqor 404 (11.76 ppg) / Corrosion Inhibitor
- 3) 4 ppb KLA-Gard (9.17 ppg) / Amine Acid Complex-Shale Stabilizer
- 4) 1ppb Mil Pac R / Sodium Carboxymethylcellulose-Filtration Control Agent
- 5) 12 ppb KCL / Potassium Chloride-inorganic Salt
- 6) Fresh Water 80 bbls
- 7) Air

PRODUCTION INTERVAL

1. Alpha 1655

Salt Inhibitor

2. Mil-Carb

Calcium Carbonate

3. Cottonseed Hulls

Cellulose-Cottonseed Pellets - LCM

4. Mil-Seal

Vegetable, Cotton & Cellulose-Based Fiber Blend – LCM

5. Clay-Trol

Amine Acid Complex - Shale Stabilizer

6. Xan-Plex

Viscosifier For Water Based Muds

7. Mil-Pac (All Grades)

Sodium Carboxymethylcellulose - Filtration Control Agent

8. New Drill

Anionic Polyacrylamide Copolymer Emulsion – Shale Stabilizer

9. Caustic Soda

Sodium Hydroxide - Alkalinity Control

10. Mil-Lime

Calcium Hydroxide - Lime

11. LD-9

Polyether Polyol – Drilling Fluid Defoamer

12. Mil Mica

Hydro-Biotite Mica – LCM

RECEIVED
Office of Oil and Gas

FFB 26 2021

13. Escaid 110

Drilling Fluild Solvent - Aliphatic Hydrocarbon

14. Ligco

Highly Oxidized Leonardite - Filteration Control Agent

15. Super Sweep

Polypropylene - Hole Cleaning Agent

16. Sulfatrol K

Drilling Fluid Additive - Sulfonated Asphalt Residuum

17. Sodium Chloride, Anhydrous

Inorganic Salt

18. D-D

Drilling Detergent – Surfactant

19. Terra-Rate

Organic Surfactant Blend

20. W.O. Defoam

Alcohol-Based Defoamer

21. Perma-Lose HT

Fluid Loss Reducer For Water-Based Muds

22. Xan-Plex D

Polysaccharide Polymer - Drilling Fluid Viscosifier

23. Walnut Shells

Ground Cellulosic Material - Ground Walnut Shells - LCM

24. Mil-Graphite

Natural Graphite - LCM

25. Mil Bar

Barite – Weighting Agent

26. X-Cide 102

Biocide

27. Soda Ash

Sodium Carbonate - Alkalinity Control Agent

28. Clay Trol

Amine Acid complex – Shale Stabilizer

29. Sulfatrol

Sulfonated Asphalt – Shale Control Additive

30. Xanvis

Viscosifier For Water-Based Muds

31. Milstarch

Starch – Fluid Loss Reducer For Water Based Muds

32. Mil-Lube

Drilling Fluid Lubricant

RECEIVED
Office of Oil and Gas

FEB 26 2021

December 16, 2020



Antero Resources 1615 Workson Street Denver, CO 80202 Office: 303.357.7310 Fax: 303.357.7315

West Virginia Department of Environmental Protection Division of Water and Waste Management 601 57th Street SE Charleston, WV 25304

RE: Water Management Plan Updates

Blizzard Pad (WMP #2125)

To Whom It May Concern:

Antero Resources (Antero) is submitting the enclosed updates to the Blizzard Pad Water Management Plan (WMP) to the WV Department of Environmental Protection (DEP) Division of Water and Waste Management (DWWM). This WMP is being submitted for your review and approval in order to replace Antero's previously approved WMP.

Below and highlighted in the WMP are the following changes to the Blizzard Pad WMP:

- · Add Hall Drilling Clarksburg Tap
- · Add Hall Drilling Salem Tap
- · Remove Antero Clearwater Facility
- · Remove the following Centralized Pits
 - oCoastal 1 North CWP
 - o Hamilton CWP
 - oMcGill CWP
 - oRichard Garry CWP
 - o Vogt CWP

Should you have questions or require additional information, please contact me directly at (303) 357-6893 or via email at sdonovan@anteroresources.com. Your assistance in this matter is appreciated.

Respectfully,

Shawn Donovan

Environmental & Regulatory Manager

Enclosures

Office of Oil and Gas

FEB 26 2021



911 Address 2993 Gorrells Run Road Middlebourne, WV 26149

Well Site Safety Plan Antero Resources

Well Name: Kerns Unit 1H-2H, Loraina Unit 1H-3H & Richmond

Unit 1H-2H, Pechora Unit 1H-2H, Whitmore Unit

1H-2H & Wade Unit 1H-2H

Pad Location: BLIZZARD PAD

Tyler County/Ellsworth District

GPS Coordinates:

Entrance - Lat 39°29'43.3"/Long -80°51'03.4" (NAD83)
Pad Center - Lat 39°29'55.5"/Long -80°51'02.4" (NAD83)

Dm H

Driving Directions:

34-21

From the Fire Department in Middlebourne: Head northeast on Main St toward Wilcox Ave for 0.2 miles, turn right onto Park Ave for 397 ft, turn left onto Gorrell Run Rd/Gorrells Run Rd for 0.4 miles, turn left onto Gorrell Run Rd for 0.2 miles, continue onto Gorrells Run Rd for 2.3 miles, lease road will be on your left.

RECEIVED

Office of Oil and Gas


MAR 0 8 2021


Alternate Route:


WV Department of

From the intersection of Klondike Ridge and Highway 18 in Centerville: Turn left onto WV-18 N for 9.0 miles, turn right onto Park Ave for 397 ft, turn left onto Gorrell Run Rd/Gorrells Run Rd for 0.4 miles, turn left onto Gorrell Run Rd for 0.2 miles, continue onto Gorrells Run Rd for 2.3 miles, lease road will be on your left

1

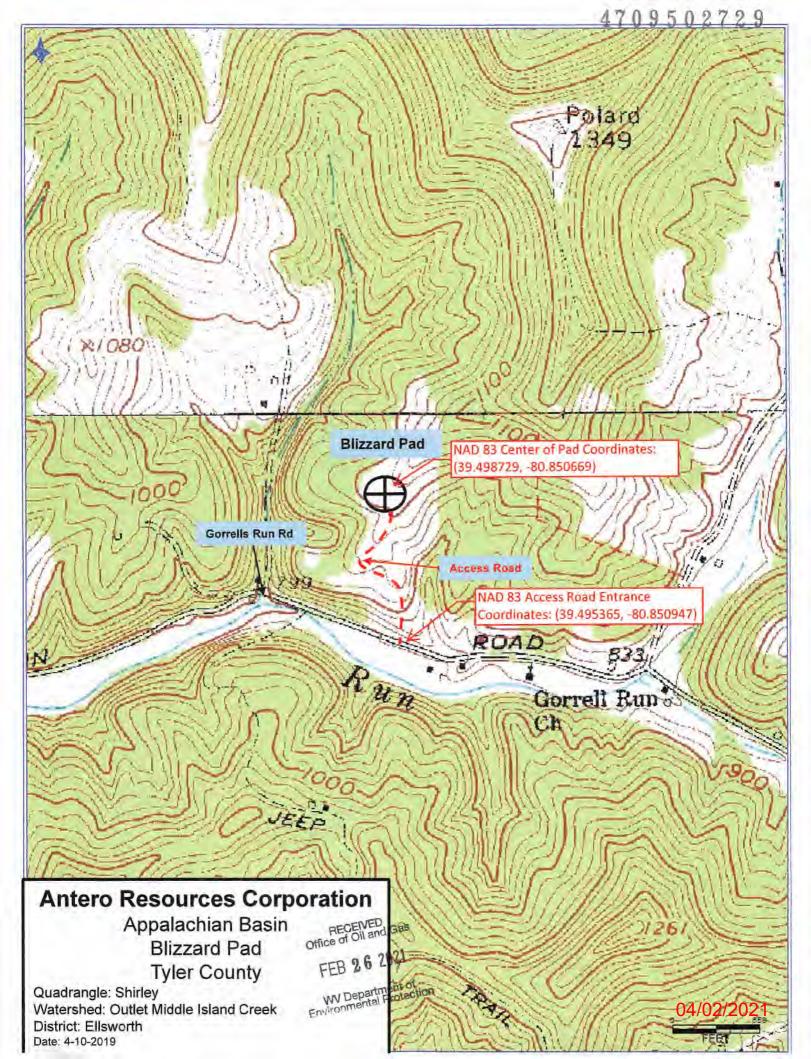

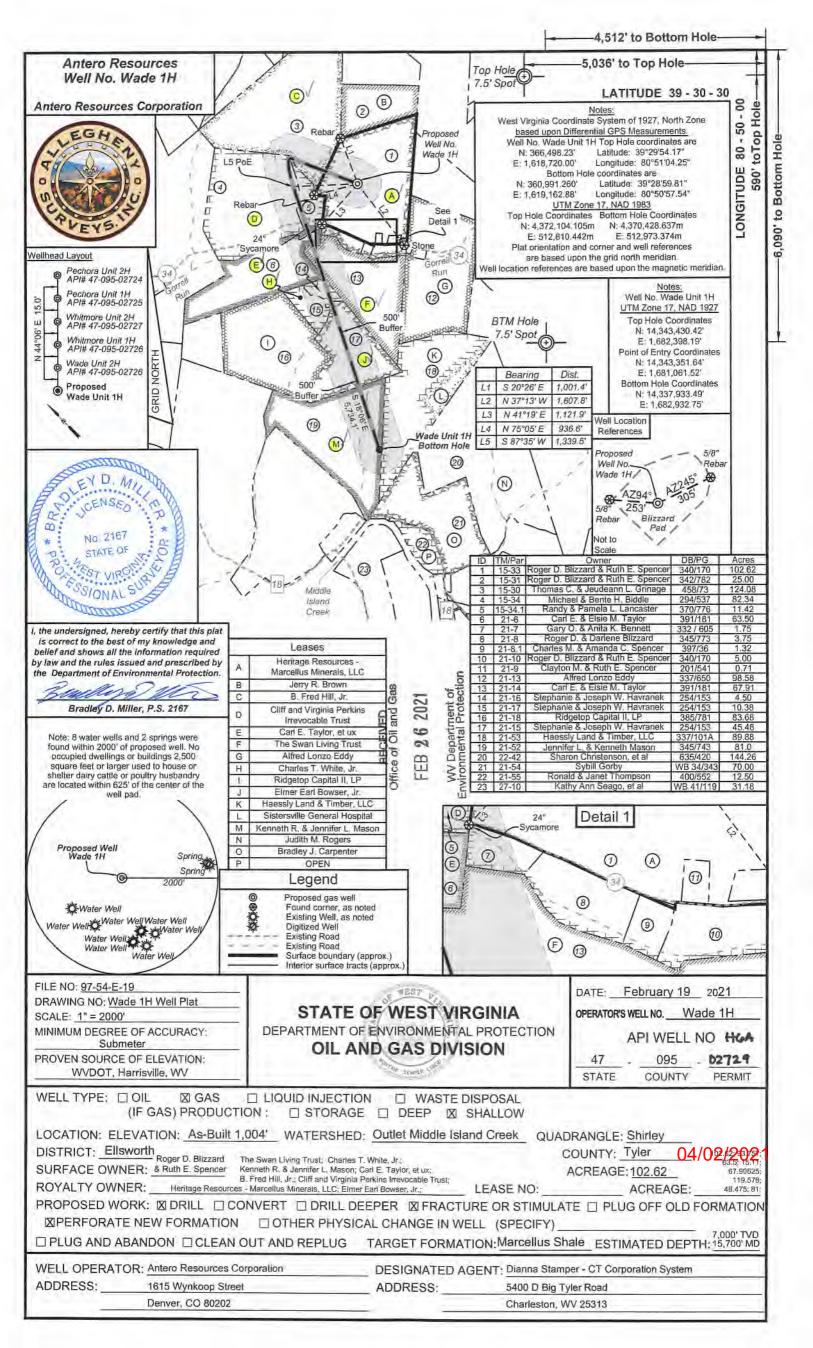

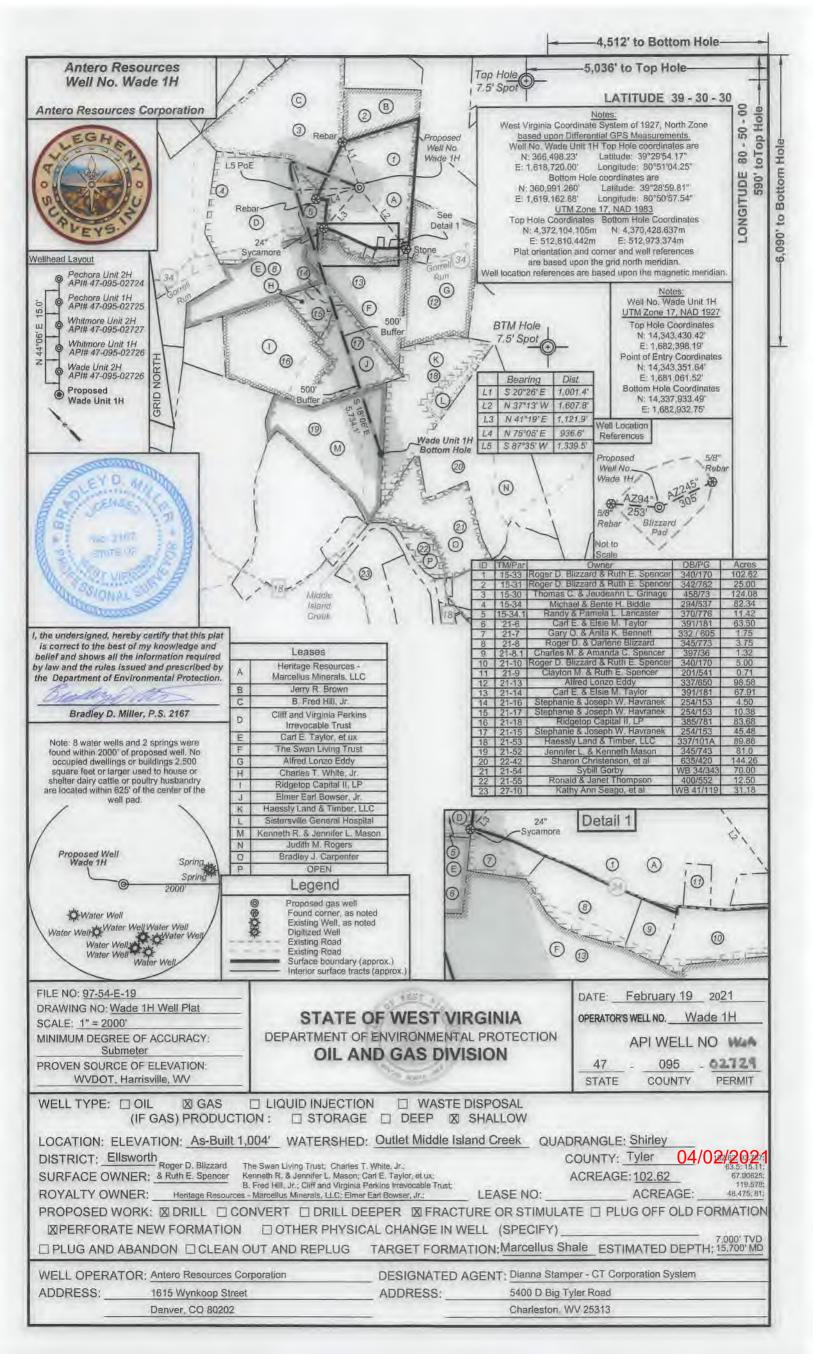

Operator's Well Number

Wade Unit 1H

INFORMATION SUPPLIED UNDER WEST VIRGINIA CODE Chapter 22, Article 6A, Section 5(a)(5) IN LIEU OF FILING LEASE(S) AND OTHER CONTINUING CONTRACT(S)

Under the oath required to make the verification on page 1 of this Notice and Application, I depose and say that I am the person who signed the Notice and Application for the Applicant, and that –

- (1) the tract of land is the same tract described in this Application, partly or wholly depicted in the accompanying plat, and described in the Construction and Reclamation Plan;
- (2) the parties and recordation data (if recorded) for lease(s) or other continuing contract(s) by which the Applicant claims the right to extract, produce or market the oil or gas are as follows:

	Grantor, lessor, etc.	Grantee, lessee, etc.	Royalty	Book/Page
Α.	Heritage Resources Marcellus Minerals Lease Heritage Resources Marcellus Minerals	Antero Resources Corporation	1/8+	0627/0134
С,	B. Fred Hill Jr. Lease B. Fred Hill Jr.	Antero Resources Corporation	1/8+	0531/0516
D	Cliff & Virginia Perkins Irrevocable Trust Lease Cliff & Virginia Perkins Irrevocable Trust	Antero Resources Corporation	1/8+	0480/0710
E.	Carl E. Taylor et ux Lease Carl E. Taylor et ux Statoil USA Onshore Properties EQT Production Company	Statoil USA Onshore Properties EQT Production Company Antero Resources Corporation	1/8 Assignment Assignment	0436/0001 0539/0239 0663/0001
F.	The Swan Living Trust Lease The Swan Living Trust	Antero Resources Corporation	1/8+	0400/0694
H.	Charles T. White Jr. Lease Charles T. White Jr. Statoil USA Onshore Properties EQT Production Company	Statoil USA Onshore Properties EQT Production Company Antero Resources Corporation	1/8+ Assignment Assignment	0397/0564 0539/0239 0663/0001
か .	Elmer Earl Bowser Jr. Lease Elmer Earl Bowser Jr.	Antero Resources Corporation	1/8	0559/0053

RECEIVED Office of Oil and Gas

MAR 2 4 2021

^{*}Partial Assignments to Antero Resources Corporation include 100% rights to extract, produce and market the oil and gas from the Marcellus and any other formations completed with this well.

WW-6A1 (5/13)

M.

Operator's W	ell No.	Wade Unit 1H

INFORMATION SUPPLIED UNDER WEST VIRGINIA CODE Chapter 22, Article 6A, Section 5(a)(5) IN LIEU OF FILING LEASE(S) AND OTHER CONTINUING CONTRACT(S)

Under the oath required to make the verification on page 1 of this Notice and Application, I depose and say that I am the person who signed the Notice and Application for the Applicant, and that —

- (1) the tract of land is the same tract described in this Application, partly or wholly depicted in the accompanying plat, and described in the Construction and Reclamation Plan;
- (2) the parties and recordation data (if recorded) for lease(s) or other continuing contract(s) by which the Applicant claims the right to extract, produce or market the oil or gas are as follows:

Kenneth R. & Jennifer L. Mason Leas			- 47	
Lease Name or Number	Grantor, Lessor, etc.	Grantee, Lessee, etc.	Royalty	Book/Page

*Partial Assignments to Antero Resources Corporation include 100% rights to extract, produce and market the oil and gas from the Marcellus and any other formations completed with this well.

RECEIVED
Office of Oil and Gas

FEB 26 2021

Acknowledgement of Possible Permitting/Approval In Addition to the Office of Oil and Gas

WV Department of Environmental Protection

The permit applicant for the proposed well work addressed in this application hereby acknowledges the possibility of the need for permits and/or approvals from local, state, or federal entities in addition to the DEP, Office of Oil and Gas, including but not limited to the following:

- WV Division of Water and Waste Management
- WV Division of Natural Resources WV Division of Highways
- U.S. Army Corps of Engineers
- U.S. Fish and Wildlife Service
- County Floodplain Coordinator

The applicant further acknowledges that any Office of Oil and Gas permit in no way overrides, replaces, or nullifies the need for other permits/approvals that may be necessary and further affirms that all needed permits/approvals should be acquired from the appropriate authority before the affected activity is initiated.

*Co-lenancy utilization - At least 7 mineral owners in tract. At least 75% of the royalty owners have executed a lease on the tract. The interests of the remaining co-tenants were acquired pursuant to the Co-tenancy Modernization and Majority Protection Act

Well Operator:	Antero Resources	Corporation
By:	Tim Rady	m- Tally
Its:	VP of Land	

VP of Land

West Virginia Department of Environmental Protection Chief, Office of Oil and Gas Attn: Mr. James Martin 601 57th Street SE Charleston, WV 25304

RE: Wade Unit 1H

Quadrangle: Shirley 7.5'

Tyler County/Ellsworth District, West Virginia

Mr. Martin:

Antero Resources Corporation (Antero) is submitting the following application for a new well work permit for the Wade Unit 1H horizontal shallow well. As an authorized representative, I certify that Antero has the right to extract, produce or market the oil or gas for all leases through which the Wade Unit 1H horizontal lateral will drill through including any and all roads crossed under as identified on the attached survey plat.

Sincerely,

Tyler Adams Landman

Tyler Adams

RECEIVED
Office of Oil and Gas

FEB 26 2021

Date of Notice Certification:

STATE OF WEST VIRGINIA DEPARTMENT OF ENVIRONMENTAL PROTECTION, OFFICE OF OIL AND GAS NOTICE CERTIFICATION

API No. 47- 095

		Ope	erator's Well No. V	Vade Unit 1H
		Wel	ll Pad Name: Blizz	zard Pad
	e provisions in West Virginia Code §	22-6A, the Operator has provided	I the required partic	es with the Notice Forms listed
	tract of land as follows: West Virginia	East	ting: 512810.442n	0
State:	Tyler		thing: 4372104.105	
County: District:	Ellsworth	Public Road Access:	US Route 34	
Quadrangle:	Shirley 7.5'	Generally used farm r		zard & Ruth E. Spencer
Watershed:	Outlet Middle Island Creek	Generally used failing	rame. Roger B. Bill	adia di Nati. El opolio.
prescribed by it has provid- information r of giving the requirements Virginia Code	West Virginia Code § 22-6A-7(b), the secretary, shall be verified and sled the owners of the surface describe equired by subsections (b) and (c), se surface owner notice of entry to su of subsection (b), section sixteen of e § 22-6A-11(b), the applicant shall thave been completed by the applicant	hall contain the following information of in subdivisions (1), (2) and (ction sixteen of this article; (ii) the rvey pursuant to subsection (a), so this article were waived in writtender proof of and certify to the second	tion: (14) A certific 4), subsection (b), at the requirement value section ten of this ting by the surface	cation from the operator that (i section ten of this article, the was deemed satisfied as a resul- article six-a; or (iii) the notice owner; and Pursuant to Wes
that the Ope	West Virginia Code § 22-6A, the Oprator has properly served the require ECK ALL THAT APPLY		Notice Certification	OOG OFFICE USE ONLY
☐ 1. NO	TICE OF SEISMIC ACTIVITY or	■ NOTICE NOT REQUIRED SEISMIC ACTIVITY WAS CO		☐ RECEIVED/ NOT REQUIRED
☐ 2. NO	TICE OF ENTRY FOR PLAT SURV	YEY or 🔳 NO PLAT SURVEY V	WAS CONDUCTE	D RECEIVED
■ 3. NO	TICE OF INTENT TO DRILL or	☐ NOTICE NOT REQUIRED NOTICE OF ENTRY FOR PLA WAS CONDUCTED or		☐ RECEIVED/ NOT REQUIRED
		☐ WRITTEN WAIVER BY S (PLEASE ATTACH)		R
■ 4. NO	TICE OF PLANNED OPERATION	REC Office of	EIVED Oil and Gas	☐ RECEIVED
			26 2021	- R <u>andrik e rindajena dijek</u> a
■ 5. PUI	BLIC NOTICE	FER ;	epartment of ental Protection	□ RECEIVED

Required Attachments:

The Operator shall attach to this Notice Certification Form all Notice Forms and Certifications of Notice that have been provided to the required parties and/or any associated written waivers. For the Public Notice, the operator shall attach a copy of the Class II Legal Advertisement with publication date verification or the associated Affidavit of Publication. The attached Notice Forms and Certifications of Notice shall serve as proof that the required parties have been noticed as required under West Virginia Code § 22-6A. Pursuant to West Virginia Code § 22-6A-11(b), the Certification of Notice to the person may be made by affidavit of personal service, the return receipt card or other postal receipt for certified mailing.

Certification of Notice is hereby given:

THEREFORE, 1 Diana Hoff , have read and understand the notice requirements within West Virginia Code § 22-6A. I certify that as required under West Virginia Code § 22-6A, I have served the attached copies of the Notice Forms, identified above, to the required parties through personal service, by registered mail or by any method of delivery that requires a receipt or signature confirmation. I certify under penalty of law that I have personally examined and am familiar with the information submitted in this Notice Certification and all attachments, and that based on my inquiry of those individuals immediately responsible for obtaining the information, I believe that the information is true, accurate and complete. I am aware that there are significant penalties for submitting false information, including the possibility of fine and imprisonment.

Well Operator: Antero Resources Corporation

Diana Hoff

Telephone:

By:

Its:

VP of Production

303-357-7223

Address: 1615 Wynkoop Street

Denver, CO 80202

Facsimile: 303-357-7315

Email: mgriffith@anteroresources.com

NOTARY SEAL

MEGAN GRIFFITH NOTARY PUBLIC STATE OF COLORADO NOTARY ID 20184011666 MY COMMISSION EXPIRES MARCH 13, 2022 Subscribed and sworn before me this

Notary Public

My Commission Expires

Oil and Gas Privacy Notice:

The Office of Oil and Gas processes your personal information, such as name, address and telephone number, as part of our regulatory duties. Your personal information may be disclosed to other State agencies or third parties in the normal course of business or as needed to comply with statutory or regulatory requirements, including Freedom of Information Act requests. Our office will appropriately secure your personal information. If you have any questions about our use or your personal information, please contact DEP's Chief Privacy Officer at depprivacyofficer@wv.gov.

> RECEIVED Office of Oil and Gas

FEB 26 2021

API NO. 47- 094 7 0 9 5 0 2 7 2 9 OPERATOR WELL NO. Wade Unit 1H Well Pad Name: Blizzard Pad

STATE OF WEST VIRGINIA DEPARTMENT OF ENVIRONMENTAL PROTECTION, OFFICE OF OIL AND GAS NOTICE OF APPLICATION

Not	ice Time Require	ment: notice shall be pro-	vided no later than	the filing date of permit application.	
Dat	e of Notice:	Date Permit Applic	ation Filed:		
	ice of:	_			
V	PERMIT FOR A			ROVAL FOR THE N IMPOUNDMENT OR PIT	
Deli	ivery method pur	suant to West Virginia (Code § 22-6A-10(b)	
	PERSONAL	☐ REGISTERED		DD OF DELIVERY THAT REQUIRES A	
	SERVICE	MAIL	RECEI	PT OR SIGNATURE CONFIRMATION	4.7
oil a descoper more well imp have proven substraction of the control of the contr	surface of the tract of and gas leasehold be cribed in the erosion rator or lessee, in the ecoal seams; (4) The work, if the surface oundment or pit as a water well, springled water for consuposed well work act section (b) of this sourds of the sheriff revision of this article le R. § 35-8-5.7.a. r	on which the well is or is pening developed by the proper and sediment control plane e event the tract of land on the owners of record of the e tract is to be used for the described in section nine of a gor water supply source for interprise to take place. (c)(1) ection hold interests in the equired to be maintained put to the contrary, notice to a equires, in part, that the opening and sediment of the contrary, that the opening is and sediment of the contrary, notice to a equires, in part, that the opening is not to the contrary, that the opening is not to the contrary.	proposed to be local osed well work, if a submitted pursual which the well pro- surface tract or trac- placement, constru- if this article; (5) A ocated within one to estic animals; and of If more than three lands, the applican ursuant to section en in lien holder is not perator shall also pr	the well plat to each of the following persons: (1) The counted; (2) The owners of record of the surface tract or to the surface tract is to be used for roads or other land on the surface tract is to be used for roads or other land on the surface tract is to be used for roads or other land on the surface tract is to be used for roads or other land of the surface to be drilled is located [sic] is known to be uncts overlying the oil and gas leasehold being developed uction, enlargement, alteration, repair, removal or abainly surface owner or water purveyor who is known to thousand five hundred feet of the center of the well pay (6) The operator of any natural gas storage field with the tenants in common or other co-owners of interests determines in common or other co-owners of interests determines in common or other elevental upon the person of ight, article one, chapter elevental of this code. (2) No notice to a landowner, unless the lien holder is the landovide the Well Site Safety Plan ("WSSP") to the surface provided in section 15 of this rule.	acts overlying the listurbance as the coal owner, derlain by one or d by the proposed indonment of any the applicant to d which is used to in which the escribed in described in the twithstanding any indowner, W. Va.
	Application Notice	e 🛮 WSSP Notice 🖾 E	&S Plan Notice	☑ Well Plat Notice is hereby provided to:	
Ø S	URFACE OWNE	R(s)		☐ COAL OWNER OR LESSEE	
Nar	ne: Roger D. Blizzard &	Ruth E. Spencer		Name: NO DECLARATIONS ON RECORD WITH COUNTY	
Add	dress: 3135 Gorrells Ro	un Road		Address:	
-	lebourne, WV 26149			Tax is record years.	RECEIVED
Nar			-	COAL OPERATOR	Office of Oil and Gas
Add	iress:	7	-	Name: NO DECLARATIONS ON RECORD WITH COUNTY	FEB 2 6 2021
m c	LIDEACE OUNEI	R(s) (Road and/or Other I	Natural and a	Address:	FED ZO ZUZI
_	ne: Roger D. Blizzard &	CARL MAN AND AND AND AND AND AND AND AND AND A	Jisturbance)	☐ WATER PURVEYOR(s)/OWNER(s) OF WATER WELL,	WAY Department of
	iress: 3135 Gorrells Ri		-	SPRING OR OTHER WATER SUPPLY SOURCE	WV Department of Environmental Protection
	lebourne, WV 26149	an road	_	Name: NONE IDENTIFIED WITHIN 1500'	
_			_	Address:	
Ado	fress:		_	riduress.	
□ S Nar	URFACE OWNEJ	R(s) (Impoundments or Pi	its)	□ OPERATOR OF ANY NATURAL GAS STOR Name: Address;	
Add	iress:			*Please attach additional forms if necessary	3



FEB 26 2021

API NO. 47- 095

OPERATOR WELL NO. Wade Unit 1H
Well Pad Name: Blizzard Pad

Notice is hereby given:

VIV Department of

Pursuant to West Virginia Code § 22-6A-10(b), notice is hereby given that the undersigned well operator has applied for a permit for well work or for a certificate of approval for the construction of an impoundment or pit.

This Notice Shall Include:

Pursuant to W. Va. Code § 22-6A-10(b), this notice shall include: (1) copies of the application; (2) the erosion and sediment control plan required by section seven of this article; and (3) the well plat.

Pursuant to W. Va. Code § 22-6A-10(f), this notice shall include: (1) a statement of the time limits for filing written comments; (2) who may file written comments; (3) the name and address of the secretary for the purpose of filing the comments and obtaining additional information; and (4) a statement that the persons may request, at the time of submitting written comments, notice of the permit decision and a list of persons qualified to test water.

Pursuant to W. Va. Code R. § 35-8-5.7.a, the operator shall provide the Well Site Safety Plan to the surface owner and any water purveyor or surface owner subject to notice and water testing as provided in section 15 of this rule.

Pursuant to W. Va. Code R. § 35-8-15.2.c, this notice shall: (1) contain a statement of the surface owner's and water purveyor's right to request sampling and analysis; (2) advise the surface owner and water purveyor of the rebuttable presumption for contamination or deprivation of a fresh water source or supply; advise the surface owner and water purveyor that refusal to allow the operator to conduct a pre-drilling water well test constitutes a method to rebut the presumption of liability; (3) advise the surface owner and water purveyor of his or her independent right to sample and analyze any water supply at his or her own expense; advise the surface owner and water purveyor whether or not the operator will utilize an independent laboratory to analyze any sample; and (4) advise the surface owner and or water purveyor that he or she can obtain from the Chief a list of water testing laboratories in the subject area capable of and qualified to test water supplies in accordance with standard acceptable methods.

Additional information related to horizontal drilling may be obtained from the Secretary, at the WV Department of Environmental Protection headquarters, located at 601 57th Street, SE, Charleston, WV 25304 (304-926-0450) or by visiting www.dep.wv.gov/oil-and-gas/pages/default.aspx.

Well Location Restrictions

Pursuant to W. Va. Code § 22-6A-12, Wells may not be drilled within two hundred fifty feet measured horizontally from any existing water well or developed spring used for human or domestic animal consumption. The center of well pads may not be located within six hundred twenty-five feet of an occupied dwelling structure, or a building two thousand five hundred square feet or larger used to house or shelter dairy cattle or poultry husbandry. This limitation is applicable to those wells, developed springs, dwellings or agricultural buildings that existed on the date a notice to the surface owner of planned entry for surveying or staking as provided in section ten of this article or a notice of intent to drill a horizontal well as provided in subsection (b), section sixteen of this article was provided, whichever occurs first, and to any dwelling under construction prior to that date. This limitation may be waived by written consent of the surface owner transmitted to the department and recorded in the real property records maintained by the clerk of the county commission for the county in which such property is located. Furthermore, the well operator may be granted a variance by the secretary from these distance restrictions upon submission of a plan which identifies the sufficient measures, facilities or practices to be employed during well site construction, drilling and operations. The variance, if granted, shall include terms and conditions the department requires to ensure the safety and protection of affected persons and property. The terms and conditions may include insurance, bonding and indemnification, as well as technical requirements. (b) No well pad may be prepared or well drilled within one hundred feet measured horizontally from any perennial stream, natural or artificial lake, pond or reservoir, or a wetland, or within three hundred feet of a naturally reproducing trout stream. No well pad may be located within one thousand feet of a surface or ground water intake of a public water supply. The distance from the public water supply as identified by the department shall be measured as follows: (1) For a surface water intake on a lake or reservoir, the distance shall be measured from the boundary of the lake or reservoir. (2) For a surface water intake on a flowing stream, the distance shall be measured from a semicircular radius extending upstream of the surface water intake. (3) For a groundwater source, the distance shall be measured from the wellhead or spring. The department may, in its discretion, waive these distance restrictions upon submission of a plan identifying sufficient measures, facilities or practices to be employed during well site construction, drilling and operations to protect the waters of the state. A waiver, if granted, shall impose any permit conditions as the secretary considers necessary. (c) Notwithstanding the foregoing provisions of this section, nothing contained in this section prevents an operator from conducting the activities permitted or authorized by a Clean Water Act Section 404 permit or other approval from the United States Army Corps of Engineers within any waters of the state or within the restricted areas referenced in this section. (d) The well location restrictions set forth in this section shall not apply to any well on a multiple well pad if at least one of the wells was permitted prior to the effective date of this article. (e) The secretary shall, by December 31, 2012, report to the Legislature on the noise, light, dust and volatile organic compounds generated by the drilling of horizontal wells as they relate to the well location restrictions regarding occupied dwelling structures pursuant to this section. Upon a finding, if any, by the secretary that the well location restrictions regarding occupied dwelling structures are inadequate or otherwise require alteration to address the items

RECEIVED
Office of Oil and Gas

FEB 26 2021

API NO. 47- 095 OPERATOR WELL NO. Wade Unit 1H
Well Pad Name: Blizzard Pad

examined in the study required by this subsection, the secretary shall have the authority to propose for promulgation legislative rules establishing guidelines and procedures regarding reasonable particular to drilling horizontal wells, including reasonable means of mitigating such factors, if necessary.

Water Well Testing:

Pursuant to West Virginia Code § 22-6A-10(d), notification shall be made, with respect to surface landowners identified in subsection (b) or water purveyors identified in subdivision (5), subsection (b) of this section, of the opportunity for testing their water well. The operator shall provide an analysis to such surface landowner or water purveyor at their request.

Water Testing Laboratories:

Pursuant to West Virginia Code § 22-6A-10(i), persons entitled to notice pursuant to subsection (b) of this section may contact the department to ascertain the names and locations of water testing laboratories in the subject area capable and qualified to test water supplies in accordance with standard accepted methods. In compiling that list of names the department shall consult with the state Bureau for Public Health and local health departments. A surface owner and water purveyor has an independent right to sample and analyze any water supply at his or her own expense. The laboratory utilized by the operator shall be approved by the agency as being certified and capable of performing sample analyses in accordance with this section.

Rebuttable Presumption for Contamination or Deprivation of a Fresh Water Source or Supply:

W. Va. Code § 22-6A-18 requires that (b) unless rebutted by one of the defenses established in subsection (c) of this section, in any action for contamination or deprivation of a fresh water source or supply within one thousand five hundred feet of the center of the well pad for horizontal well, there is a rebuttable presumption that the drilling and the oil or gas well or either was the proximate cause of the contamination or deprivation of the fresh water source or supply. (c) In order to rebut the presumption of liability established in subsection (b) of this section, the operator must prove by a preponderance of the evidence one of the following defenses: (1) The pollution existed prior to the drilling or alteration activity as determined by a predrilling or prealteration water well test. (2) The landowner or water purveyor refused to allow the operator access to the property to conduct a predrilling or prealteration water well test. (3) The water supply is not within one thousand five hundred feet of the well. (4) The pollution occurred more than six months after completion of drilling or alteration activities. (5) The pollution occurred as the result of some cause other than the drilling or alteration activity. (d) Any operator electing to preserve its defenses under subdivision (1), subsection (c) of this section shall retain the services of an independent certified laboratory to conduct the predrilling or prealteration water well test. A copy of the results of the test shall be submitted to the department and the surface owner or water purveyor in a manner prescribed by the secretary. (e) Any operator shall replace the water supply of an owner of interest in real property who obtains all or part of that owner's supply of water for domestic, agricultural, industrial or other legitimate use from an underground or surface source with a comparable water supply where the secretary determines that the water supply has been affected by contamination, diminution or interruption proximately caused by the oil or gas operation, unless waived in writing by that owner. (f) The secretary may order the operator conducting the oil or gas operation to: (1) Provide an emergency drinking water supply within twenty-four hours; (2) Provide temporary water supply within seventy-two hours; (3) Within thirty days begin activities to establish a permanent water supply or submit a proposal to the secretary outlining the measures and timetables to be used in establishing a permanent supply. The total time in providing a permanent water supply may not exceed two years. If the operator demonstrates that providing a permanent replacement water supply cannot be completed within two years, the secretary may extend the time frame on case-by-case basis; and (4) Pay all reasonable costs incurred by the real property owner in securing a water supply. (g) A person as described in subsection (b) of this section aggrieved under the provisions of subsections (b), (e) or (f) of this section may seek relief in court... (i) Notwithstanding the denial of the operator of responsibility for the damage to the real property owner's water supply or the status of any appeal on determination of liability for the damage to the real property owner's water supply, the operator may not discontinue providing the required water service until authorized to do so by the secretary or a court of competent jurisdiction.

Written Comment:

Pursuant to West Virginia Code § 22-6A-11(a), all persons described in subsection (b), section ten of this article may file written comments with the secretary as to the location or construction of the applicant's proposed well work within thirty days after the application is filed with the secretary. All persons described in West Virginia Code § 22-6A-10(b) may file written comments as to the location or construction of the applicant's proposed well work to the Secretary at:

Chief, Office of Oil and Gas Department of Environmental Protection 601 57th St. SE Charleston, WV 25304 (304) 926-0450

Such persons may request, at the time of submitting written comments, notice of the permit decision and a list of persons qualified to test water. **NOTE: YOU ARE NOT REQUIRED TO FILE ANY COMMENT.**

API NO. 47- 095 OPERATOR WELL NO. Wade Unit 1H
Well Pad Name: Blizzard Pad

Time Limits and Methods for Filing Comments.

The law requires these materials to be served on or before the date the operator files its Application. You have THIRTY (30) DAYS after the filing date to file your comments. Comments must be filed in person or received in the mail by the Chief's office by the time stated above. You may call the Chief's office to be sure of the date. Check with your postmaster to ensure adequate delivery time or to arrange special expedited handling. If you have been contacted by the well operator and you have signed a "voluntary statement of no objection" to the planned work described in these materials, then the permit may be issued at any time.

Pursuant to West Virginia Code § 22-6A-11(c)(2), Any objections of the affected coal operators and coal seam owners and lessees shall be addressed through the processes and procedures that exist under sections fifteen, seventeen and forty, article six of this chapter, as applicable and as incorporated into this article by section five of this article. The written comments filed by the parties entitled to notice under subdivisions (1), (2), (4), (5) and (6), subsection (b), section ten of this article shall be considered by the secretary in the permit issuance process, but the parties are not entitled to participate in the processes and proceedings that exist under sections fifteen, seventeen or forty, article six of this chapter, as applicable and as incorporated into this article by section five of this article.

Comment Requirements

Your comments must be in writing and include your name, address and telephone number, the well operator's name and well number and the approximate location of the proposed well site including district and county from the application. You may add other documents, such as sketches, maps or photographs to support your comments.

Disclaimer: All comments received will be placed on our web site http://www.dep.wv.gov/oil-and-gas/Horizontal-Permits/Pages/default.aspx and the applicant will automatically be forwarded an email notice that such comments have been submitted. The applicant will be expected to provide a response to comments submitted by any surface owner, water purveyor or natural gas storage operator noticed within the application.

Permit Denial or Condition

The Chief has the power to deny or condition a well work permit. Pursuant to West Virginia Code § 22-6A-8(d), the permit may not be issued or be conditioned, including conditions with respect to the location of the well and access roads prior to issuance if the director determines that:

- (1) The proposed well work will constitute a hazard to the safety of persons;
- (2) The plan for soil erosion and sediment control is not adequate or effective;
- (3) Damage would occur to publicly owned lands or resources; or
- (4) The proposed well work fails to protect fresh water sources or supplies.

A permit may also be denied under West Virginia Code § 22-6A-7(k), the secretary shall deny the issuance of a permit if the secretary determines that the applicant has committed a substantial violation of a previously issued permit for a horizontal well, including the applicable erosion and sediment control plan associated with the previously issued permit, or a substantial violation of one or more of the rules promulgated under this article, and in each instance has failed to abate or seek review of the violation within the time prescribed by the secretary pursuant to the provisions of subdivisions (1) and (2), subsection (a), section five of this article and the rules promulgated hereunder, which time may not be unreasonable.

Pursuant to West Virginia Code § 22-6A-10(g), any person entitled to submit written comments to the secretary pursuant to subsection (a), section eleven of this article, shall also be entitled to receive from the secretary a copy of the permit as issued or a copy of the order modifying or denying the permit if the person requests receipt of them as a part of the written comments submitted concerning the permit application. Such persons may request, at the time of submitting written comments, notice of the permit decision and a list of persons qualified to test water.

RECEIVED Office of Oil and Gas

FEB 26 2021

API NO. 47-095 OPERATOR WELL NO. Wade Unit 1H Well Pad Name: Blizzard Pad

Notice is hereby given by:

Well Operator: Antero Resources Corporation

Telephone: (303) 357-7223

Diana Email: mgriffith@anteroresources.com

Address: 1615 Wynkoop Street

Denver, CO 80202

Facsimile: 303-357-7315

Oil and Gas Privacy Notice:

The Office of Oil and Gas processes your personal information, such as name, address and telephone number, as part of our regulatory duties. Your personal information may be disclosed to other State agencies or third parties in the normal course of business or as needed to comply with statutory or regulatory requirements, including Freedom of Information Act requests. Our office will appropriately secure your personal information. If you have any questions about our use or your personal information, please contact DEP's Chief Privacy Officer at depprivacyofficer@wv.gov.

MEGAN GRIFFITH NOTARY PUBLIC STATE OF COLORADO NOTARY ID 20184011666 MY COMMISSION EXPIRES MARCH 13, 2022

Subscribed and sworn before me this

Notary Public

My Commission Expires

RECEIVED Office of Oil and Gas

FEB 26 2021

Operator Well No. Wade Unit 1H

WW-6A5 (1/12)

STATE OF WEST VIRGINIA DEPARTMENT OF ENVIRONMENTAL PROTECTION, OFFICE OF OIL AND GAS NOTICE OF PLANNED OPERATION

	e Time R of Notice	equirement: notice shall be p		o later than the filing pplication Filed:	date of permit	application.	
Delive	ery meth	od pursuant to West Virgini	a Code §	22-6A-16(c)			
	CERTIFI	ED MAIL		HAND			
		N RECEIPT REQUESTED		DELIVERY			
return the pla require drillin damag (d) Th of noti	receipt re anned op ed to be p g of a ho ges to the ne notices ice.	Va. Code § 22-6A-16(c), not equested or hand delivery, giveration. The notice required provided by subsection (b), separation and (3) A prosurface affected by oil and garequired by this section shall be approvided to the SUPFACE.	ve the surfaction ten o posed surfaction ten o posed surfaction be given t	ace owner whose land ubsection shall include if this article to a surfa ace use and compens are to the extent the da to the surface owner a	will be used for de: (1) A copy ace owner whose sation agreement amages are com	or the drilling of of this code see land will be not containing a pensable under	of a horizontal well notice of ection; (2) The information used in conjunction with the n offer of compensation for rarticle six-b of this chapter.
(at the	address	by provided to the SURFAC listed in the records of the she					
		lizzard & Ruth E. Spencer		Name:			
	SS: 3135 G			Address	3:		
operat State; Count		ne surface owner's land for th West Virginia Tyler	e purpose (of drilling a horizonta UTM NAD 8	Facting	512810.442m 4372104.105m	ollows:
Distric	ct:	Ellsworth		Public Road		US Route 34	
		Shirley 7.5'		Generally use	ed farm name;	Roger D. Blizzard	& Ruth E. Spencer
Water	rshed:	Outlet Middle Island Creek		_			
Pursua to be horizo surfac inform headq	ant to We provided ontal well ce affecte nation reluarters, l	est Virginia Code § 22-6A-16 by W. Va. Code § 22-6A-16; and (3) A proposed surface d by oil and gas operations to lated to horizontal drilling management	0(b) to a use and co o the exter ay be obta	surface owner whose ompensation agreeme at the damages are co ained from the Secret	e land will be and containing an ompensable und tary, at the WV	used in conjur n offer of comp der article six-l / Department o	action with the drilling of a pensation for damages to the b of this chapter. Additional of Environmental Protection g www.dep.wv.gov/oil-and-
gas/pa	ages/defa	uit.aspx.					RECEIVED Office of Oil and Gas
	Operator:	Antero Resources Corporation		Address:	1615 Wynkoop Stre	eet	0.0001
Telepl		(303) 357-7310			Denver, CO 80202		FEB 26 2021
Email	2	mgriffith@anteroresources.com		Facsimile:	303-357-7315		WV Department of
011		and the same					Environmental Protection
		rivacy Notice: Oil and Gas processes your pe	reonal info	ormation such as nam	ne address and	telenhone num	

The Office of Oil and Gas processes your personal information, such as name, address and telephone number, as part of our regulatory duties. Your personal information may be disclosed to other State agencies or third parties in the normal course of business or as needed to comply with statutory or regulatory requirements, including Freedom of Information Act requests. Our office will appropriately secure your personal information. If you have any questions about our use or your personal information, please contact DEP's Chief Privacy Officer at deprivacyofficer@wv.gov.



WEST VIRGINIA DEPARTMENT OF TRANSPORTATION Division of Highways

1900 Kanawha Boulevard East • Building Five • Room 110 Charleston, West Virginia 25305-0430 • (304) 558-3505

February 18, 2021

Byrd E. White, III Secretary of Transportation/ Commissioner of Highways

> Jimmy Wriston, P. E. Deputy Secretary/ Deputy Commissioner

James A. Martin, Chief Office of Oil and Gas Department of Environmental Protection 601 57th Street, SE Charleston, WV 25304

Subject: DOH Permit for the Grand Pad, Tyler County

Wade Unit 1H Well Site

Dear Mr. Martin,

This well site will be accessed from a DOH permit #06-2020-0048 which has been issued to Antero Resources for access to the State Road for a well site located off Tyler County Route 34 SLS MP 6.91.

This operator is in compliance with §22-6A-20 of the WV Code. Operator has signed a STATEWIDE OIL AND GAS ROAD MAINTENANCE BONDING AGREEMENT and provided the required Bond. This operator is currently in compliance with the DOH OIL AND GAS POLICY dated October 1, 2018. This letter is valid for permitting purposes for one year from the date of this letter.

RECEIVED Office of Oil and Gas

Very Truly Yours,

FEB 26 2021

WV Department of Environmental Protection

Gary K. Clayton, P.E.

Regional Maintenance Engineer Central Office O&G Coordinator

Cc: Megan Griffith Antero Resources

CH, OM, D-6

File

List of Anticipated Additives Used for Fracturing or Stimulating Well

Additives	Chemical Abstract Service Number (CAS #)	
Fresh Water	7732-18-5	[
2 Phosphobutane 1,2,4 tricarboxylic acid	37971-36-1	
Ammonium Persulfate	7727-54-0	
Anionic copolymer	Proprietary	<u> </u>
Anionic polymer	Proprietary	
BTEX Free Hydrotreated Heavy Naphtha	64742-48-9	
Cellulase enzyme	Proprietary	
Demulsifier Base	Proprietary	<u> </u>
Ethoxylated alcohol blend	Mixture	
Ethoxylated Nonylphenol	68412-54-4]
Ethoxylated oleylamine	26635-93-8	<u> </u>
Ethylene Glycol	107-21-1	
Glycol Ethers	111-76-2	
Guar gum	9000-30-0	
Hydrogen Chloride	7647-01-0	
Hydrotreated light distillates, non-aromatic, BTEX free	64742-47-8	1
Isopropyl alcohol	67-63-0	1
liquid, 2,2-dibromo-3-nitrilopropionamide	10222-01-2	1
Microparticle	Proprietary	1
Petroleum Distillates (BTEX Below Detect)	64742-47-8	1
Polyacrylamide	57-55-6	1
Propargyl Alcohol	107-19-7	1
Propylene Glycol	57-55-6	1
Quartz	14808-60-7	1
Sillica, crystalline quartz	7631-86-9	1
Sodium Chloride	7647-14-5	1
Sodium Hydroxide	1310-73-2	1
Sugar	57-50-1	1
Surfactant	68439-51-0	1
Suspending agent (solid)	14808-60-7	1
Tar bases, guinoline derivs, benzyl chloride-quaternized	72480-70-7	1
Solvent Naphtha, petroleum, heavy aliph	64742-96-7	1
Soybean Oil, Me ester	67704.00.0	EIVED
Copolymer of Maleic and Acrylic Acid	52255-49-9 Office of	oil and Gas
DETA phosphonate		6 2021
Hexamthylene Triamine Penta	34690-00-1	6 2021
Phosphino Carboxylic acid polymer		artment of Ital Protection
Hexamethylene Diamine Tetra	23605-75-5	tal Protection
2-Propenoic acid, polymer with 2 propenamide	9003-06-9	1
Hexamethylene diamine penta (methylene phosphonic acid)	23605-74-5	1
Diethylene Glycol	111-46-6	1
Methenamine	100-97-0	1
Polyethylene polyamine	68603-67-8	1
Coco amine	61791-14-8	1
2-Propyn-1-olcompound with methyloxirane	38172-91-7	†
2 1 Topyn-1-olcompound with methyloxidalie	301/2-31-/	J

FEB 26 2021

Antero Resources Corporation Erosion and Sediment Control Moderation Protection Blizzard Well Pad

Antero Resources Corporation (Antero) is submitting the following narrative and set of drawings in compliance with §35-8-5.4. This plan is submitted in conjunction with the Blizzard Well Pad Site Design & Construction Plan, Erosion & Sediment Control Plans prepared in accordance with the West Virginia Code of State Rules, Division of Environmental Protection and Office of Oil and Gas, and certified by Navitus Engineering, Inc., a West Virginia registered professional engineer.

Requirement §5.4.b.1. A general sequence of events that describe in relative terms how and when each construction phase (i.e. clearing and grubbing, mass grading, stabilization) will occur and when each erosion and sediment control best management practice ("BMP") will be installed;

Antero Response:

The following includes a general sequence of events that describe in relative terms how and when each construction phase is anticipated to occur and erosion and sediment control BMPs to be installed. Please refer to the Blizzard Well Pad Site Design & Construction Plan, Erosion & Sediment Control Plans (Site Design) prepared and certified by Navitus Engineering, Inc. for specific construction measures. Compliance with the measures outlined in the Site Construction Plan (§35-8-5.4) submitted in conjunction with this plan will also be maintained.

- Stake the limits of construction and mark/flag all identified wetlands, streams, utilities, and
 other areas of concern for construction activities. Install signs to designate the areas and orange
 safety fence to identify important project attributes such as approved access roads, no refueling
 zones, wetlands/steam bounds, etc.
- A pre-construction conference with the contactor and the appropriate erosion and sediment control inspector 48 hours prior to beginning work to review the construction drawings and provide any requested guidance.
- 3. Construct the rock construction entrance. All vehicles entering and exiting the site shall do so via the rock construction entrance.
- 4. Construct all BMP's as soon as clearing and grubbing operations allow. Once installed, the area encompassing the BMP's outside the grading limits shall be seeded and mulched immediately.
- If applicable, convey upslope drainage around the Access Road, Well Pad, and Water Containment Pad areas by constructing all diversion berm(s) and/or compost filter sock diversion(s) as shown on the plans.
- 6. Clear and grub the site. All woody material, brush, trees, stumps, large roots, boulders, and debris shall be cleared from the site area and kept to the minimum necessary for proper construction, including the installation of necessary sediment controls. Trees, brush, & stumps shall be cut and/or grubbed and windrowed in appropriate areas for use as sediment barriers at water drainage outlets (as shown on the plans), burned (as per WV forest fire laws), removed from site, or disposed of by other methods approved by WV DEP.
- 7. If applicable, install all wetland or stream crossings as shown on the plans.
- Strip the topsoil from the access road. Topsoil stripping shall be kept to a minimum necessary to
 construct access road. Prior to placing any fill, the exposed subgrade shall be compacted and

- proof rolled to produce a stable and unyielding site. All stripped topsoil shall be stockpiled in areas shown in the plans, or re-spread at an approximate depth of 2-4 inches on all proposed 2:1 or flatter slopes, and immediately stabilized. Additional BMP measures shall be constructed around topsoil stockpiles, if necessary.
- 9. Construct the access road. All fill areas, including excess material stockpiles, shall be "Keyed In" and compacted in horizontal lifts with a maximum loose lift thickness of 12" and maximum particle size as outlined in the geotechnical report. All fill shall be compacted by a vibrating sheepsfoot roller to 95% per the standard proctor test (ASTM D698). Moisture content will be controlled in accordance with the standard proctor test (ASTM D698) results. It is also recommended that each lift be proof rolled with a loaded haul truck where applicable. Ditch relief culverts shall be installed at a grade of 1-8% to minimize outlet velocities to the extent possible. Install outlet protection once ditch relief culverts are installed, as shown on plans. Stabilize the road with geotextile fabric & stone and side slopes as specified with permanent seeding. Excess material shall be stockpiled (if necessary) in areas shown in the plans and immediately stabilized. Topsoil shall be stripped from all stockpile areas prior to construction of stockpiles. After stockpiles are constructed, topsoil is to be reapplied at a depth of 2"-4". Slopes shall be tracked by running tracked machinery up and down the slope, leaving tread marks parallel to the contour. All ditch lines shall be cleaned prior to installation of lined protection.
- 10. Strip the topsoil from the well pad and water containment pad. Topsoil stripping shall be kept to a minimum necessary to construct well pad and water containment pad. Prior to placing any fill, the exposed subgrade shall be compacted and proof rolled to produce a stable and unyielding site. All stripped topsoil shall be stockpiled in areas shown in the plans, or re-spread at an approximate depth of 2-4 inches on all proposed 2:1 or flatter slopes, and immediately stabilized. Additional BMP measures shall be constructed around topsoil stockpiles, if necessary.
- 11. Grade the well pad and water containment pad areas as shown on the plans. Install pad sumps (with 4" PVC drain pipe and outlet protection) and containment berm liner system. Immediately stabilize the outer areas of the well pad and water containment pad. The well pad and water containment pad areas shall be stabilized with geotextile fabric & stone and the side slopes with seed and mulch. Install all straw wattles as shown on plans. Apply seed and mulch to all disturbed areas. This shall include all areas that will not be subject to regular traffic activity (to be stabilized with stone), or any disturbed area that will not be re-disturbed before site reclamation begins.
- 12. The construction site should be stabilized as soon as possible after completion. Establishment of final stabilization must be initiated no later than 7 days after reaching final grade. Final stabilization means that all soil-disturbing activities are completed, and that either a permanent vegetative cover with a density of 70% or greater has been established or that the surface has been stabilized by hard cover such as pavement or buildings. It should be noted that the 70% requirement refers to the total area vegetated and not just a percent of the site.
- 13. Commence well drilling activity.
- 14. All BMP's must remain in place and functional until all areas within the limit of disturbance are complete and permanently stabilized. Maintenance must include inspection of all erosion and sediment controls after each runoff event in excess of 0.5" in twenty-four (24) hour period..
- 15. All permanent sediment control measures can be removed after the site is permanently stabilized and approval is received from the WVDEP.
- 16. Any areas disturbed by removal of controls shall be repaired, stabilized, and permanently seeded.



FEB 26 2021

Requirement §5.4.b.2. A description of the stabilization methods to be used, including the application rates for temporary and permanent seeding and mulching, and provide the timeframes for establishing stabilization

Antero Response:

Stabilization methods used include seeding and mulching of disturbed areas as well as the implementation of erosion and sediment control BMPs. Please refer to "Construction and E&S Control Notes" on page 2 and "Construction Details" on pages 18-25 for detailed descriptions of the different stabilization methods to be used. Seeding and mulching is to be in accordance with the WVDOT Standard Specifications unless specified otherwise in the plans or unless specified otherwise by the construction engineer or Antero representative. Please refer to "Erosion and Sediment Control Narrative" under "Construction and E&S Control Notes" on page 2 as well as "Revegetation" on page 25 of the Site Design for more specific information regarding application, liming, and mulching rates.

Erosion and sediment BMPs will be constructed, stabilized, and functional before site disturbance begins within the tributary areas of those BMPs. In a timely manner after earth disturbance activities cease, Antero shall stabilize any areas disturbed by the activities. During non-germination periods, mulch must be applied at the specified rates. Disturbed areas which are not at finish grade and which will be redisturbed within 1 year will be stabilized in accordance with the temporary vegetative stabilization and specifications. Disturbed areas which are finished grade or which will not be re-disturbed within 1 year will be stabilized in accordance with the permanent vegetative stabilization specification. Please refer to "Construction and E&S Control Notes" on page 2 for more information regarding timeframes for establishing stabilization and erosion and sediment BMPs.

The site shall be considered to have achieved full stabilization when it has a minimum uniform 70% perennial vegetative cover or other permanent non-vegetative cover with a density sufficient to resist accelerated surface erosion and subsurface characteristics to resist sliding and other movements. Until the site achieves final stabilization, Antero will assure that the best management practices (BMPs) are implemented, inspected, operated, and maintained. As such, Antero will maintain written inspection logs. All maintenance work, including cleaning, repair, replacement, regarding, and re-stabilization shall be performed immediately upon discovery of deficiency. After final stabilization has been achieved, temporary erosion and sediment BMPs controls will be removed. Areas disturbed during removal of the BMPs will be stabilized immediately.

Requirement §5.4.b.3. Details of specifications for the erosion and sediment control BMPs employed on the project.

Antero Response:

Please refer to the "Construction and E&S Control Notes," and "Construction Details" on pages 2 and 18-25 in the Site Design for specifications including instructions for installation, inspection, and maintenance for erosion and sediment control BMPs employed at this site.

Requirement §5.4.c.1. A vicinity map locating the site in relation to the surrounding area and roads;

Antero Response:

A vicinity map locating the site in relation to the surrounding area and roads is included on page 1 of the Site Design.

RECEIVED
Office of Oil and Gas

FEB **26** 2021_{04/02/2021}

Requirement §5.4.c.2 A plan view site map at a scale of one inch equal to one hundred feet (1"=100') or greater, showing appropriate detail of all site features, including the identification of site access that provides for a stabilized construction entrance and exit to reduce tracking of sediment onto public or private roads; and


Antero Response:

"Overall Plan Sheet Index & Volumes," "Access Road & Stockpile Plan," "Access Road Plan," "Well Pad & Stockpile Plan," and "Well Pad Grading Plan," maps are included on pages 8-11 of the Site Design. Specific design, layout and inspection and maintenance notes for a stabilized construction entrance are included in the "Construction and E&S Control Notes" verbiage on page 2.

Requirement §5.4.c.3. The location of all proposed erosion and sediment control BMPs

Antero Response:

"Overall Plan Sheet Index & Volumes," "Access Road & Stockpile Plan," "Access Road Plan," "Well Pad & Stockpile Plan," and "Well Pad Grading Plan," maps are included on pages 8-11 of the Site Design locate all proposed erosion and sediment control BMPs.

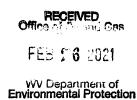

LOCATION COORDINATES:
ACCESS ROAD ENTRANCE
LATITUDE: 39.495265 LONGITUDE: -80.850047 (NAD 83)
LATITUDE: 39.495266 LONGITUDE: -80.951118 (NAD 27)
N.4371709.71 & 515318.27 (LUTA ZONE 17 METZE)

CENTROID OF PAD
LATITUDE: 38-488729 LANGITUDE: -80.850869 (NAD 83)
LATITUDE: 39-49851 LONGITUDE: -80.850841 (NAD 27)
N 437213410 E 51283834 (UTM ZONE 17 METERS)

GENERAL DESCRIPTION:
THE ACCESS ROAD(S) AND WELL PAD HAVE BEEN CONSTRUCTED TO AID IN THE DEVELOPMENT OF INDIVIDUAL MARCHALD SHALL DEA WELLS.

MISS UTILITY STATEMENT.

THE STATEMENT OF THE LOCATING OF THE PROJECT DESIGN. TICKET #1905041743. IN ADOTTICK, MISS UTILITY WILL SECONTACTED BY THE CONTRACTOR PRODE TO THE TANK! OF CONSTRUCTION FOR THIS PROJECT.

ONLY OF THE CONTRACTOR PRODE TO THE TANK! OF CONSTRUCTION FOR THIS PROJECT.

ENTRANCE PERMIT

ANTER RESOLUTES COMPOSITION ILS OFFICIAND AN ENCROACHMENT PERMIT (FORM MM-100) FROM THE

CONSTRUCTION ACTIVITIES.

OF TRANSPORTATION DIVISION OF HIGHWAYS, PRIOR TO COMMENCEMENT OF

CONSTRUCTION ACTIVITIES.

FLOODPLAIN NOTES:
THE STE IS LOCATED WITHIN FEMA FLOOD ZONE "X" PER PEMA FLOOD MAP #64005C0175C

THE SITE IS LOCATED WITHIN FEMA FLOOD ZUNE, "X" PER FEMA PLOOD MAP #64005CO175C.

ENVIRONMENTAL NOTES:
STREAM AND SETIAND ELECATIONS WEIGE PERFORMED IN DECEMBER 2018 & LANUARY 2019 BY ALLSTAR
ECOLOCY TO REVIEW THE SITE FOR WAITEN AND WEIGHARDS THAT ARE MOST LIKELY WITHIN THE
REGULATORY PUWEND OF THE U.S. ARRY CORES OF EMPERSON CO. SOLD PROFILE PROTECTION
TO SET AND ADDRESS OF THE STREAM PROFILE PROFILE PROTECTION TO SET AND ADDRESS OF THE RESULTS OF THE PIECE DEDICATION TO SET AND PROFILE PROFILE

GEOTECHNICAL NOTES:
A SUBSURFACE INVESTIGATION OF THE SITE WAS PERFORMED BY PENNSYLVANIA SOIL & ROCK, INC, IN MARCE 2019. IT HE REPORT PREZARED BY PENNSYLVANIA SOIL & POCK, INC, DATED MAY OI, 2019. REPLICTS THE RESULTS OF THE SUBSURFACE INVESTIGATION. THE BYOTHATION MOY DESCRIBED IN THIS REPORT OF THE SUBSURFACE INVESTIGATION THE SUBSURFACE IN THE SUBSURFACE OF THE SUBS

PROJECT CONTACTS:

OPERATOR.
ANTERO RESOURCES CORPORATION
SOS WHITE OAKS BLVB.
REDGEPORT, WY 26330
PHONE: (304) 642-4108
PAX: (304) 842-4102

ELL WAGONER - ENVIRONMENTAL ENGINEER & REGULATORY MARAGER
OFFICE: (304) 842-4068 CELL: (304) 476-0770

DIANA HOFF - SVP OPERATIONS OFFICE: (303) 357-8904

AARON KUNZLER - CONSTRUCTION MANAGER CELL (304) 842-4191

CHARLES E. COMPTON, UI - UTILITY COORDINATOR CELL: (200) 719-8449

DAVID PATSY - LAND AGENT CELL (304) 476-8090

ENGINEER/SURVEYOR NAVITUS ENGINEERING, INC. CYRUS S. KUMP, PE PROJECT

MANAGER/ENGINEER OFFICE: (008) 602-4105 CELL: (540) 606-6747

ENVIRONMENTAL ALISTAR ECOLOGY, LLC BYAN L WARD - ENVIRONMENTAL SCIENTIST DIFFICE: (BGB) 233-2356 CELL (304) 692-7477

AARON KUNZLER - CONSTRUCTION MANAGER
CELL (304) 842-4030
CFECK (304) 842-4100
CFELL (304) 827-7405
CFECK (304) 842-4100
CFELL (304) 827-7405
CFECK (304) 842-8000
CFELL (304) 827-7405

- MALEMAN.

 ALL BUP'S MUST REMAIN IN PLACE AND FUNCTIONAL UNTIL ALL AREAS WITHER THE LIMIT OF
 DISTURBANCE ARE COMPLETE AND PERMANENTLY STABILIZED, MARTENANCE MUST DICLUDE
 RESPECTION OF ALL REGISION AND SEDMENT CONTROLS AFTER EACH RUNOFF EVENT IN EXCESS OF
 0.5' AND OA A SPEEKLY BASIS.
- THE CONSTRUCTION SITE SHOULD BE STABILIZED AS SOON AS POSSIBLE AFTER COMPLETION. ESTABLISHMENT OF FINAL STABILIZATION MUST BE DIGITATED NO LATER THAN 7 DAYS AFTER REACHIND FINAL GRADE FINAL STABILIZATION MEANS THAT ALL SOLL-BEST-MEND ACTIVITIES ARE COMPLETED. AND THAT ESTIMES A PERMANENT VESCHATIVE COVER WITH A BENEFIT OF 700 OR ORBATER LIGH SEEDIN STABILIZATION. STABILIZATION OF THE SECOND STABILIZATION OF THE STABILIZATION AND ASSOCIATION OF THE STABILIZATION AREA VESCHATER AND NOT JUST A PERCENT OF THE STAT.
- ALL PERMANENT SEDIMENT CONTROL MEASURES CAN BE REMOVED AFTER THE SITE IS PERMANENTLY STABILIZED AND APPROVAL IS RECEIVED FROM THE WYDEP.
- ANY AREAS DISTURBED BY REMOVAL OF CONTROLS SHALL BE REPAIRED, STABILIZED, AND PERMANENTLY SEEDED.
- 5. THE AS-BUILT INFORMATION SHOWN HEREON REFLECTS FUELD DATA COLLECTED RELATING TO THE FINAL GRADING OF THE DISTURBED AREA AS OF MARCH 27, CROS NATURUS ENGINEERING IS NOT RESPONSIBLE FOR ANY CHANGES MADE TO THE STITE AFTER THE ABOVE MERIONED DATES.
- 8. THE EXISTING CONTAINMENT BEEN AROUND THE WELL PAD SHALL BE REPAIRED AS NECESSARY TO ENSURE 100% CONTAINMENT OF ALL FLUIDS PRICE TO DRILLING OPERATIONS
- THE EXISTING EGRESSES TO THE WELL PAD SHALL HAVE THE MOUNTABLE BERMS REPAIRED AS NECESSARY TO ENSURE 100% CONTAINMENT OF ALL FLUIDS PRIOR TO DRILLING OPERATIONS.

REPRODUCTION NOTE:

THESE PLANS WERE CHEATED TO BE PLOTTED ON SECTOR (ANS) BY PAPER HALF SCALS DISWINGS ARE ON LIVIT' (ARE) BY PAPER.

THESE PLANS HERE CHEATED FOR COLUM PLATTING AND ANT EXPRODUCTIONS IN CHAY SCALS OR COLOR MAY RESULT IN A LOSS OF FROMMATION AND THOUGH NOT HE USED FOR CONSTRUCTION PURPOSES

BLIZZARD WELL PAD AS-BUILT EROSION & SEDIMENT CONTROL IMPROVEMENT PLAN

ELLSWORTH DISTRICT, TYLER COUNTY, WV GORRELL RUN-MIDDLE ISLAND CREEK WATERSHED

USGS 7.5 MIDDLEBOURNE, PADEN CITY, PORTERS FALL & SHIRLEY QUAD MAPS



WEST VIRGINIA COUNTY MAP



(NOT TO SCALE)

AS-BUILT CERTIFICATIONS:
THE DIRAMINGS, CONSTRUCTION NOTES, AND
REFERENCE DIAGRAMS ATTACED HERETO HAVE
BEEN PERPARED IN ACCORDANCE WITH THE
WEST VIRGINAL COUP OF STATE RULES, DIVISION
OF ENVIRONMENTAL PROTECTION, OFFICE UP OIL
AND GAS CES 53-6.



MISS Utility of West Virginia 1-800-245-4848 West Virginia State Law (Section XIV: Chapter 24-C) Requires that you call two business days before you dig in the state of West Virginia. IT'S THE LAW!!



545

- SHEET INDEX:

 1 COVER SHEET

 2 LESIED

 3 OVERALL PLAS SHEET INDEX

 4 ACCESS ROAD & STOCKPILE AS-BUILT PLAN

 5 WELL PAD & STOCKPILE AS-BUILT PLAN

 6 WELL PAD & STOCKPILE AS-BUILT PLAN

 7 WELL PAD AS-BUILT SECTION

 8 STOCKPILE AS-BUILT SECTION

 8 STOCKPILE AS-BUILT SECTION

BLIZZARD LIMITS OF DISTURBANCE A	REA (AC)
Total Site	
Existing Accurs Road (1,366)	3.76
Access Road "A" (401")	1.47
Access Road "B" (893")	1.84
Staging Area	102
Well Pad	9.52
Excess/Topsoil Material Stockpiles	9.19
Total Affected Area	28.80
Total Wooded Acres Disturbed	B.14
Impacts to County Route 34 RA	
Existing Access Road (4')	0.05
Total Affected Area	0.05
Total Wooded Acres Disturbed	0.00
Impacts to Roger D. Blazzard & Ruth E. Sper	rcer TM 15-33
Existing Access Road (1,352)	3.71
Access Road "A" (401")	1.47
Access Road "B" (893')	1.84
Staging Area	1:02
Well Pad	9.52
Excess/Topsoil Material Stockpiles	9.13
Total Affected Area	26.89

Inc TM 15.30

0.06

BLIZZARD EPHEMERAL STREAM IMPACT (LINEAR FEET)					
	Permanent Impacts		Temp. Impacts		Total Impact
Stream and Impact Cause		Inlets/Outlets Structures (LF)	Controls (LF)	Distance to L.O.D. (LF)	(LF)
Steam ASE 09 (Ex. Access Road)	0	0	0	5	0

Excess/Topsoil Material Stockpiles Total Affected Area

tal Wooded Acres Disturb

BLOZARD WETI	LAND MAPAC	T (SQUARE FEE	T)
Wetland and Impact Cause	Fill (SF)	Total Impact (SF)	Total Impact (AC)
ASE Wetland02 (Stockpile)	1.618	1,618	0.04

Proposed Well Name	WV North NAD 27	NAD 27 Lat & Long	UTM (METERS) Zone 17	NAD ALL & Lon
Wade	N 306498 23	LAT 39-29-04 17:03	N 4372104.11	LAT 39-29-64 4032
Unit 1H	E 1618720.00	LONG-80-51-64 2494	E 512910.44	LCNG -80-61-01 6290
Wade	N 366509.01	LAT 39-29-54-2733	N 4372107.44	LAT 39-29-54 5812
Unit 2H	E 1616730.44	LONG-80-51-04 1180	E \$12813 57	LONG -80-51-03-4969
Whitmore	N 385519.75	LAT 22-79-54 3803	N 4372110.75	LAT 39-29-54 R683
Unit 1H	E 1818740.88	LOVO-80-51-03.9873	E 512516.69	LONG -80-51-03 3678
Whitmare	N 398530.55	LAT 39-29-54-4944	N 4372114.11	LAT 39-29-54.7773
Unit 2H	E 1618751.32	LONG -80-51-03-6562	E 512819 82	LONG -80-51-03 2367
Pachora	N 396941 33	LAT 39-29-54 (1024	N 4372117.45	LAT 39-29-54 8853
Unit 1H	E 1616761.78	LONG-80-51-03 7251	E 512022 94	LONG-80-81-08.1057
Pechora	N 368552.10	LAT 29-29-54-7104	N 4372120.78	LAT 39-29-54,9933
Unit 2H	E 1818772.18	LONG -80-51-03:5941	E 512829.07	LONG -80-51-02,9745
Loraina	N 3565/9.98	LAT 39-29-55 9897	N 4372180 27	LAT 39-29-04 2726
Unit 1H	E 1618976.38	LONG-80-51-02-7696	E 512857 15	LONG -85-51-01 6700
Loraina	N 366690.38	LAT 39-29-56 094T	N 4372163.50	LAT 30-29-56.5771
Unit 251	E 1618687.19	LONG -80-51-02 1537	E 512980.40	LONG -80-81-01-5342
Richmond	N 366700.79	LAT 29-29-56-1966	N 4372186.72	LAT 30-29-56-4815
Unit 1H	E 1518997 99	LONG -80-51-02:0179	E 512953.64	CONG -80-61-01.3164
Richmond	N-306711.19	LAT 29-29-50,3030	N 4372189.95	LAT 39-29-50,5859
Unit 2H	E 1518908.80	LONG -80-51-01 8820	£ 512006.00	LONG -80-61-01,2625
Kerns	N 386721.59	LAT 29-29-55 4274	N 4372173.17	COSS 20-29-50 8000
Unit 1H	E 1516919 80	LDNG-80-51-01.7482	E 512870.12	LDNG-80-61-01 1267
Karna	N 368732.00	LAT 39-29-56-5118	N 4372176.40	LAT 39-29-56-7948
Unit 2H	E 1618930.41	LONG -80-51-01 8103	£ 512070.05	UDNG -00-51-00-0908
Lorsina Unit 3H (Parmitted)	N 388506.81	LAT 29-29-54 2507	N.4372108.88	(AT 29-29-54 5478
AP\$# 47-095-02620	E 1618751.37	LONG -80-51-03 8510	E 512819.95	LONG -80-81-03-2315
As-Built Well Pad Elevation	1,004.0			



S







WAS PREPARED FOR: AKTERO RESOURCES CORPORATION

BLIZZARD WELL

COVER



DATE: 04/06/2020 SCALE AS SHOWN SHEET 1 OF 8

