


FILE #: TRR2  
 DRAWING #: 3000  
 SCALE: 1" = 200'  
 MINIMUM DEGREE OF ACCURACY: 1/300  
 PROVEN SOURCE: SURVEYING MAPPING  
 OF ELEVATION: STATE GPS

I, THE UNDERSIGNED, HEREBY CERTIFY THAT THIS PLAT IS CORRECT TO THE BEST OF MY KNOWLEDGE AND BELIEF AND SHOWS ALL THE INFORMATION REQUIRED BY LAW AND THE REGULATIONS ISSUED AND PRESCRIBED BY THE DEPARTMENT OF MINERAL RESOURCES.  
 Signed: *[Signature]*  
 L.L.S. #2124 : Ernest J. Benckey III

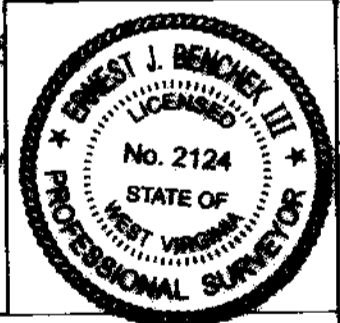

(+) DENOTES LOCATION OF WELL ON UNITED STATES TOPOGRAPHIC MAPS W/NEIP  
 OFFICE OF OIL & GAS  
 ONE STATE STREET  
 CHARLESTON, WV 25304  
 Well Type:  Oil  Waste Disposal  Production  Deep  
 Gas  Liquid Injection  Storage  Shallow  
 WATERSHED: GARLET MIDDLE ISLAND CREEK  
 COUNTY/DISTRICT: TYLER / MELROY  
 SURFACE OWNER: WEST VIRGINIA DEPT. OF NATURAL RESOURCES  
 OIL & GAS ROYALTY OWNER: Tribune Resources, LLC, Et Al  
 LEASE NUMBERS:

DATE: SEPTEMBER 1, 2022  
 OPERATOR'S WELL #: BFT 7H  
 API WELL #: 47 95 00237  
 STATE COUNTY PERMIT  
 AS-BUILT ELEVATION: 880'  
 QUADRANGLE: CENTER POINT  
 ACREAGE: 110.00 + 12/02/2022  
 ACREAGE: 919.7 +/-

DRILL  CONVERT  DRILL DEEPER  REGRILL  FRACTURE OR STIMULATE   
 PLUG OFF FORMATION  PERFORATE NEW FORMATION  PLUG & ABANDON   
 CLEAN OUT & REPLUG  OTHER CHANGE  (SPECIFY):  
 TARGET FORMATION: MARCELLUS  
 ESTIMATED DEPTH: TMD: 6927' TMD: 19381.15'  
 WELL OPERATOR: TRIBUNE RESOURCES, LLC  
 DESIGNATED AGENT: MARSHAL BROWN  
 ADDRESS: 301 AMBERWOOD DRIVE, CHARLESTON, WV 25301  
 ADDRESS: 1800 HUNTINGTON AVENUE  
 CITY: WHEELING STATE: LA ZIP CODE: 26001  
 CITY: WHEELING STATE: WV ZIP CODE: 26001

PROPERTY OWNER INDEX	
5-8-8	WV DEPT. OF NATURAL RESOURCES COMMERCE
5-8-6	RUSSELL P. STACKPOLE
5-8-5	JOHN D. STACKPOLE
5-8-3	MICHAEL PERRY & MARK PERRY
5-8-1	WILLIAM CARL THOMPSON
5-25-17	WV DIVISION OF NATURAL RESOURCES
5-25-16	COASTAL FOREST RESOURCES CO.
5-25-6	STATE OF WV PUBLIC LAND CORP.
5-8-34	ROBERT MARK HUFFMAN
5-8-21	JERRY L WALTERS
5-8-22	WV DEPT OF NATURAL RESOURCES COMMERCE DIVISION

LEASE INDEX			
A	MARC00717-001	F	MARC00727-001
B	MARC00765-000	G	MARC00727-001
C	MARC00713-000	H	MARC02996-000
D	MARC00713-000	I	MARC00744-000
E	MARC03487-000	J	MARC03689-001
		K	MARC01099-001

12/02/2022

FILE #: TRB2

DRAWING #: 3080

SCALE: N/A

DATE: SEPTEMBER 1, 2022

OPERATOR'S WELL #: BFT 7H

API WELL #: 47 095  
STATE COUNTY PERMIT