






Antero Resources
Well No. Elexa 1H
As-Drilled
Antero Resources Corporation

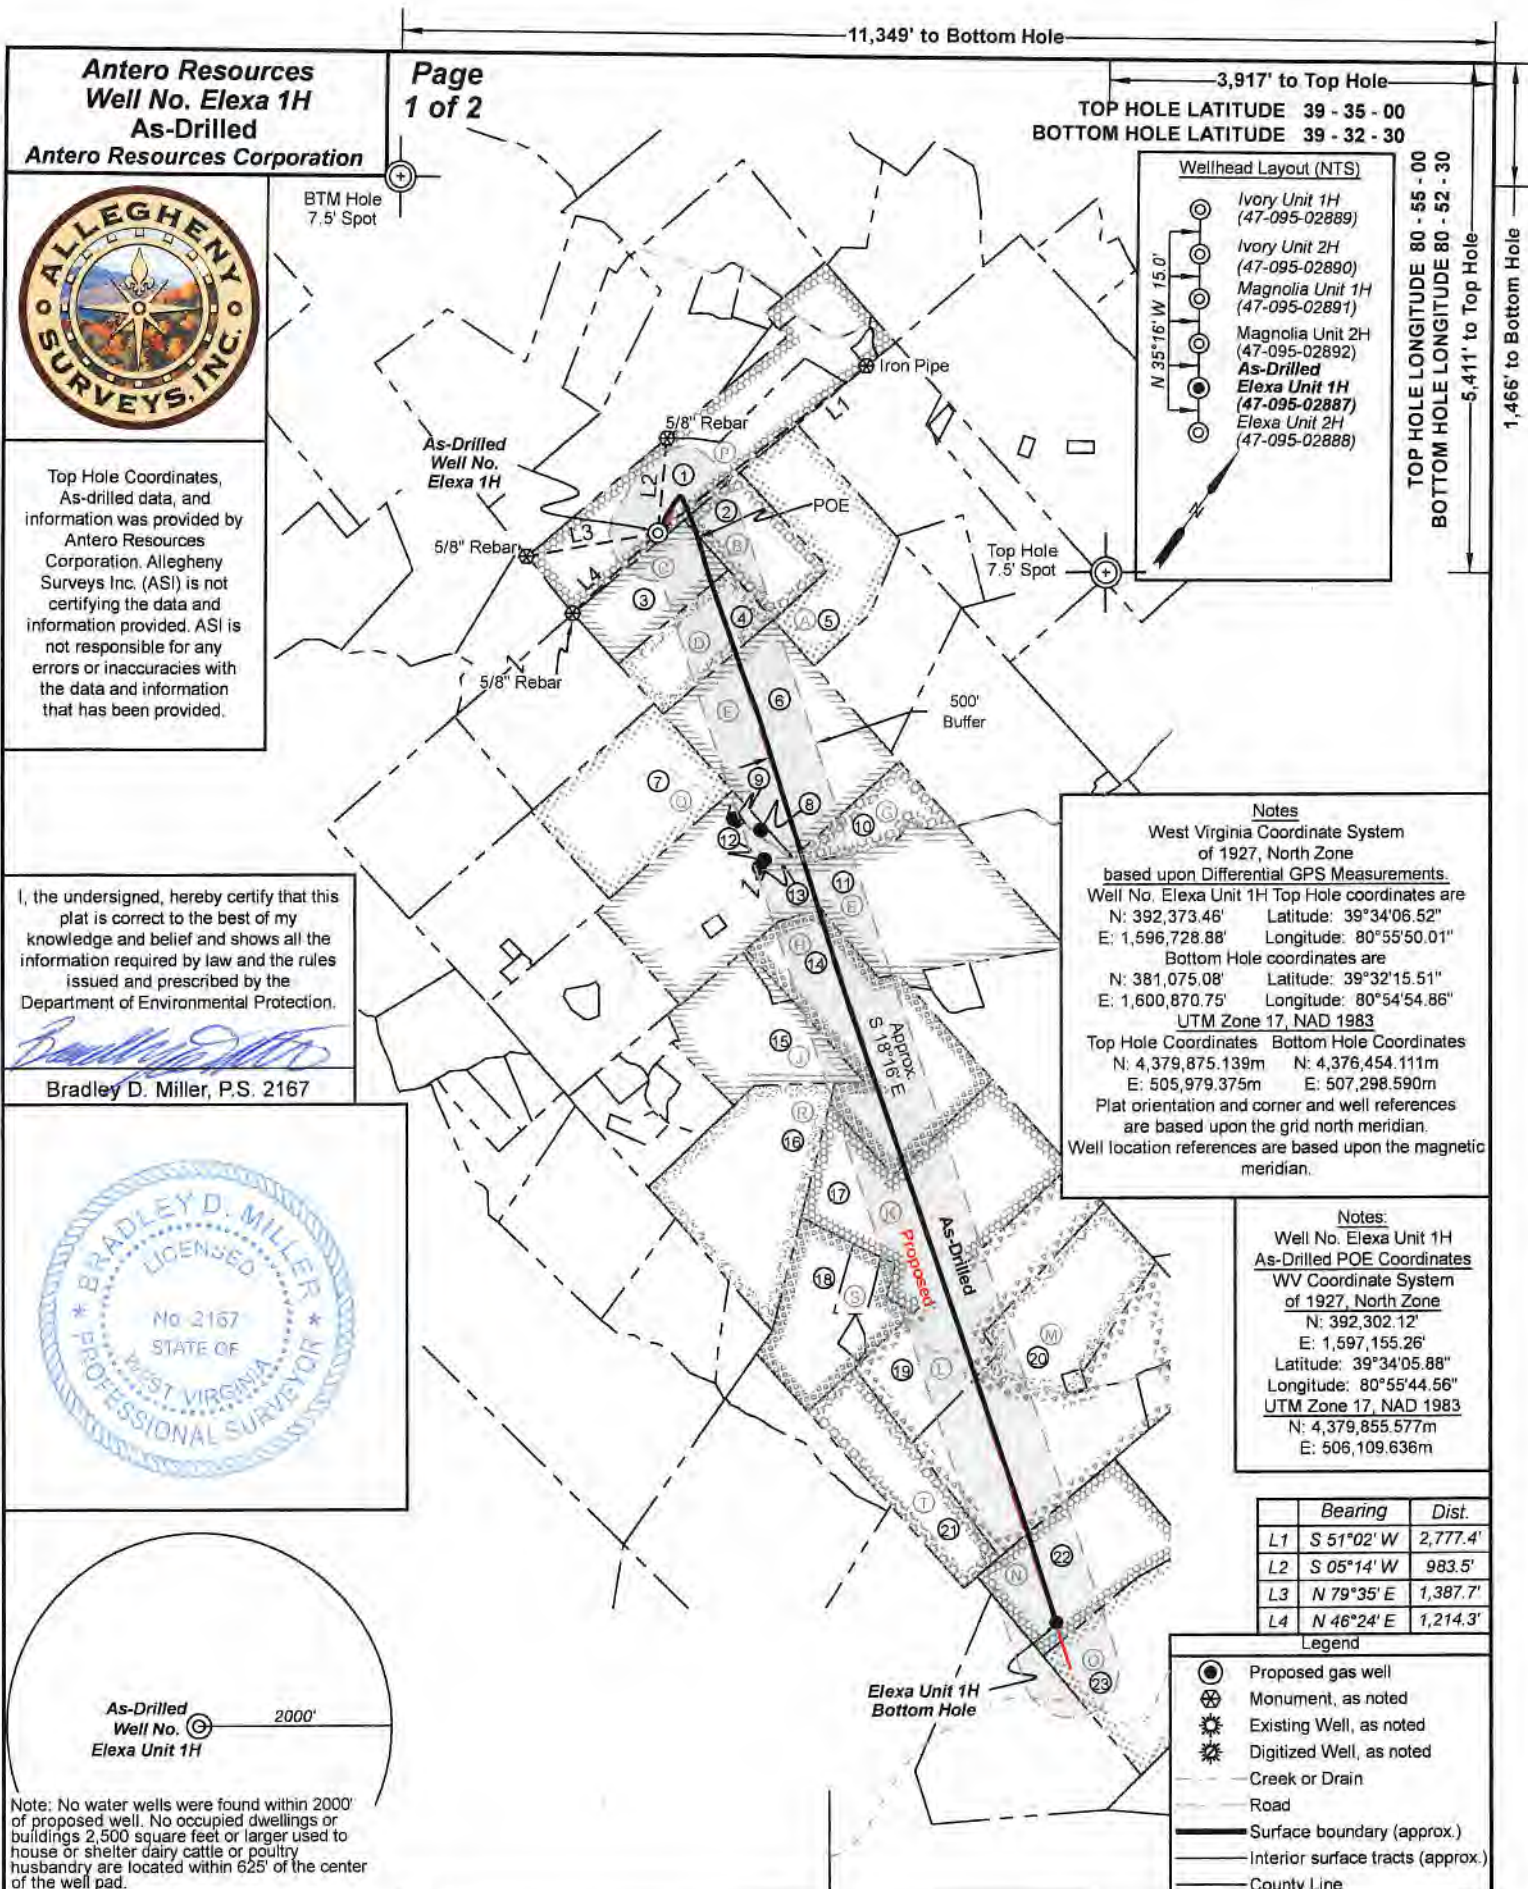

Top Hole Coordinates,
As-drilled data, and
information was provided by
Antero Resources
Corporation. Allegheny
Surveys Inc. (ASI) is not
certifying the data and
information provided. ASI is
not responsible for any
errors or inaccuracies with
the data and information
that has been provided.

I, the undersigned, hereby certify that this
plat is correct to the best of my
knowledge and belief and shows all the
information required by law and the rules
issued and prescribed by the
Department of Environmental Protection.

Bradley D. Miller, P.S. 2167

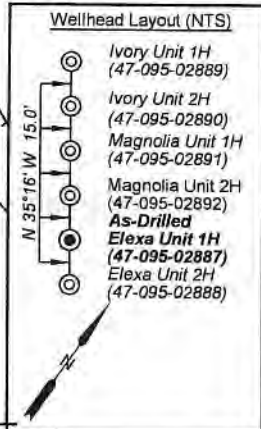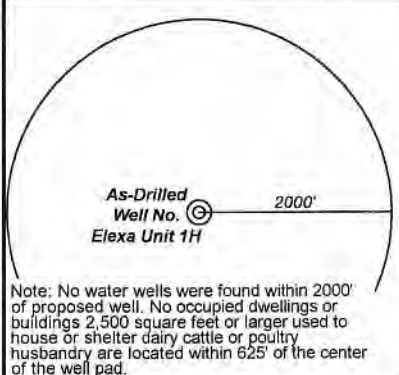

Notes
West Virginia Coordinate System
of 1927, North Zone
based upon Differential GPS Measurements.
Well No. Elexa Unit 1H Top Hole coordinates are
N: 392,373.46' Latitude: 39°34'06.52"
E: 1,596,728.88' Longitude: 80°55'50.01"
Bottom Hole coordinates are
N: 381,075.08' Latitude: 39°32'15.51"
E: 1,600,870.75' Longitude: 80°54'54.86"
UTM Zone 17, NAD 1983
Top Hole Coordinates Bottom Hole Coordinates
N: 4,379,875.139m N: 4,376,454.111m
E: 505,979.375m E: 507,298.590m
Plat orientation and corner and well references
are based upon the grid north meridian.
Well location references are based upon the magnetic
meridian.

Notes:
Well No. Elexa Unit 1H
As-Drilled POE Coordinates
WV Coordinate System
of 1927, North Zone
N: 392,302.12'
E: 1,597,155.26'
Latitude: 39°34'05.88"
Longitude: 80°55'44.56"
UTM Zone 17, NAD 1983
N: 4,379,855.577m
E: 506,109.636m

	Bearing	Dist.
L1	S 51°02' W	2,777.4'
L2	S 05°14' W	983.5'
L3	N 79°35' E	1,387.7'
L4	N 46°24' E	1,214.3'

- Legend**
- Proposed gas well
 - Monument, as noted
 - Existing Well, as noted
 - Digitized Well, as noted
 - Creek or Drain
 - Road
 - Surface boundary (approx.)
 - Interior surface tracts (approx.)
 - County Line

FILE NO: 158-54-L-23
DRAWING NO: Elexa 1H As-Drilled
SCALE: 1" = 2000'
MINIMUM DEGREE OF ACCURACY:
Submeter
PROVEN SOURCE OF ELEVATION:
WVDOT, Harrisville, WV

STATE OF WEST VIRGINIA
DEPARTMENT OF ENVIRONMENTAL PROTECTION
OIL AND GAS DIVISION

DATE: July 2 20 25
OPERATOR'S WELL NO. Elexa 1H
API WELL NO
47 - 095 - 02887
STATE COUNTY PERMIT

WELL TYPE: ☐ OIL ☒ GAS ☐ LIQUID INJECTION ☐ WASTE DISPOSAL
(IF GAS) PRODUCTION: ☐ STORAGE ☐ DEEP ☒ SHALLOW
LOCATION: ELEVATION: As-built Elev: 1,091' WATERSHED: Outlet Middle Island Creek QUADRANGLE: Paden City
DISTRICT: Lincoln COUNTY: Tyler 09/12/2025
SURFACE OWNER: Neil R. Stebbins ACREAGE: 51.48
ROYALTY OWNER: AMP IV, LP LEASE NO: ACREAGE: 80.37
PROPOSED WORK: ☐ DRILL ☐ CONVERT ☒ DRILL DEEPER ☐ FRACTURE OR STIMULATE ☐ PLUG OFF OLD FORMATION
☐ PERFORATE NEW FORMATION ☒ OTHER PHYSICAL CHANGE IN WELL (SPECIFY) As-Drilled 6,380' TVD
☐ PLUG AND ABANDON ☐ CLEAN OUT AND REPLUG TARGET FORMATION: Marcellus Shale ESTIMATED DEPTH: 18,308' MD

WELL OPERATOR: Antero Resources Corporation DESIGNATED AGENT: Conrad Baston
ADDRESS: 1615 Wynkoop Street ADDRESS: 535 White Oaks Blvd.
Denver, CO 80202 Bridgeport, WV 26330



Leases	
A	Robert F. & Rita K. Scardina
B	Robert F. & Rita K. Scardina
D	Robert F. & Rita K. Scardina
C	Robert F. & Rita K. Scardina
E	Earl K. Grimes, et ux
G	BRC Appalachian Minerals I, LLC
H	Breck Minerals, LP
J	Bounty Minerals, LLC
K	Ethan A. & Marsh L. Riffle, JTWROS
L	Blanche B. Bailey & Shelby R. Bailey
M	Charles R. Jobs
N	Melodee A. Matheny
O	Heritage Resources-Marcellus, LLC
P	AMP IV, LP
Q	Date Palm Resources, LLC
R	Robert L. Bolner
S	Bounty Minerals, LLC
T	MMA Mineral Group, LLC

ID	TM-Par	Owner	Bk/Pg	Acres
1	5-9.4	Neil R. Stebbins	366/436	51.48
2	5-12	Robert F. & Rita K. Scardina	320/646	25.00
3	5-11	Robert F. & Rita K. Scardina	320/646	25.00
4	5-10	Robert F. & Rita K. Scardina	320/646	25.00
5	5-13	Robert F. & Rita K. Scardina	320/646	46.00
6	9-3	D.E. Grimes & Sons Farm, LLC	209/496	67.00
7	9-1	Dickie L. Morgan	605/478	50.00
8	9-2	D.E. Grimes & Sons Farm, LLC	209/496	1.59
9	9-16.3	Timothy Grimes & Pamela Robinson	OR204/32	0.55
10	9-4	Brandon Scott Grimes	637/841	20.00
11	9-16	D.E. Grimes & Sons Farm, LLC	209/496	118.22
12	9-16.4	Darrell Kurt Grimes & Amy J. Grimes	617/383	0.24
13	9-16.1	Darrell K. & Amy J. Grimes	OR87/558	0.25
14	9-15.1	Larry M. & Betty L. Jochum; Mark Lee Jochum	573/794	75.00
15	9-43	Larry M. & Betty L. Jochum; Mark Lee Jochum	573/794	36.55
16	9-23	Robert L. Bolner	347/235	61.00
17	9-24	Ethan A. & Marsha L. Riffle	299/26	82.00
18	9-25	Vonlie Cooper	289/103	31.48
19	9-27	Robert Livio Bolner	226/593	59.00
20	9-28	Constance Heintzman	WB43/505	104.50
21	13-2	Idona Cooper Estate	109/234	30.00
22	13-3	Mark E. Heintzman	221/635	51.96
23	13-8	D.H. Lancaster, Jr.	351/288	52.84


FILE NO: 158-54-L-23
DRAWING NO: Elexa 1H As-Drilled
SCALE: 1" = 2000'
MINIMUM DEGREE OF ACCURACY:
Submeter
PROVEN SOURCE OF ELEVATION:
WVDOT, Harrisville, WV

STATE OF WEST VIRGINIA
DEPARTMENT OF ENVIRONMENTAL PROTECTION
OIL AND GAS DIVISION

DATE: July 2 2025
OPERATOR'S WELL NO. Elexa 1H
API WELL NO
47 - 095 - 02887
STATE COUNTY PERMIT

WELL TYPE: ☐ OIL ☒ GAS ☐ LIQUID INJECTION ☐ WASTE DISPOSAL
(IF GAS) PRODUCTION : ☐ STORAGE ☐ DEEP ☒ SHALLOW
LOCATION: ELEVATION: As-built Elev: 1,091' WATERSHED: Outlet Middle Island Creek QUADRANGLE: Paden City
DISTRICT: Lincoln COUNTY: Tyler
SURFACE OWNER: Neil R. Stebbins ACREAGE: 51.48
ROYALTY OWNER: AMP IV, LP LEASE NO: ACREAGE: 80.37
PROPOSED WORK: ☐ DRILL ☐ CONVERT ☒ DRILL DEEPER ☐ FRACTURE OR STIMULATE ☐ PLUG OFF OLD FORMATION
☐ PERFORATE NEW FORMATION ☒ OTHER PHYSICAL CHANGE IN WELL (SPECIFY) As-Drilled 6,380' TVD
☐ PLUG AND ABANDON ☐ CLEAN OUT AND REPLUG TARGET FORMATION: Marcellus Shale ESTIMATED DEPTH: 18,308' MD

WELL OPERATOR: Antero Resources Corporation DESIGNATED AGENT: Conrad Baston
ADDRESS: 1615 Wynkoop Street ADDRESS: 535 White Oaks Blvd.
Denver, CO 80202 Bridgeport, WV 26330

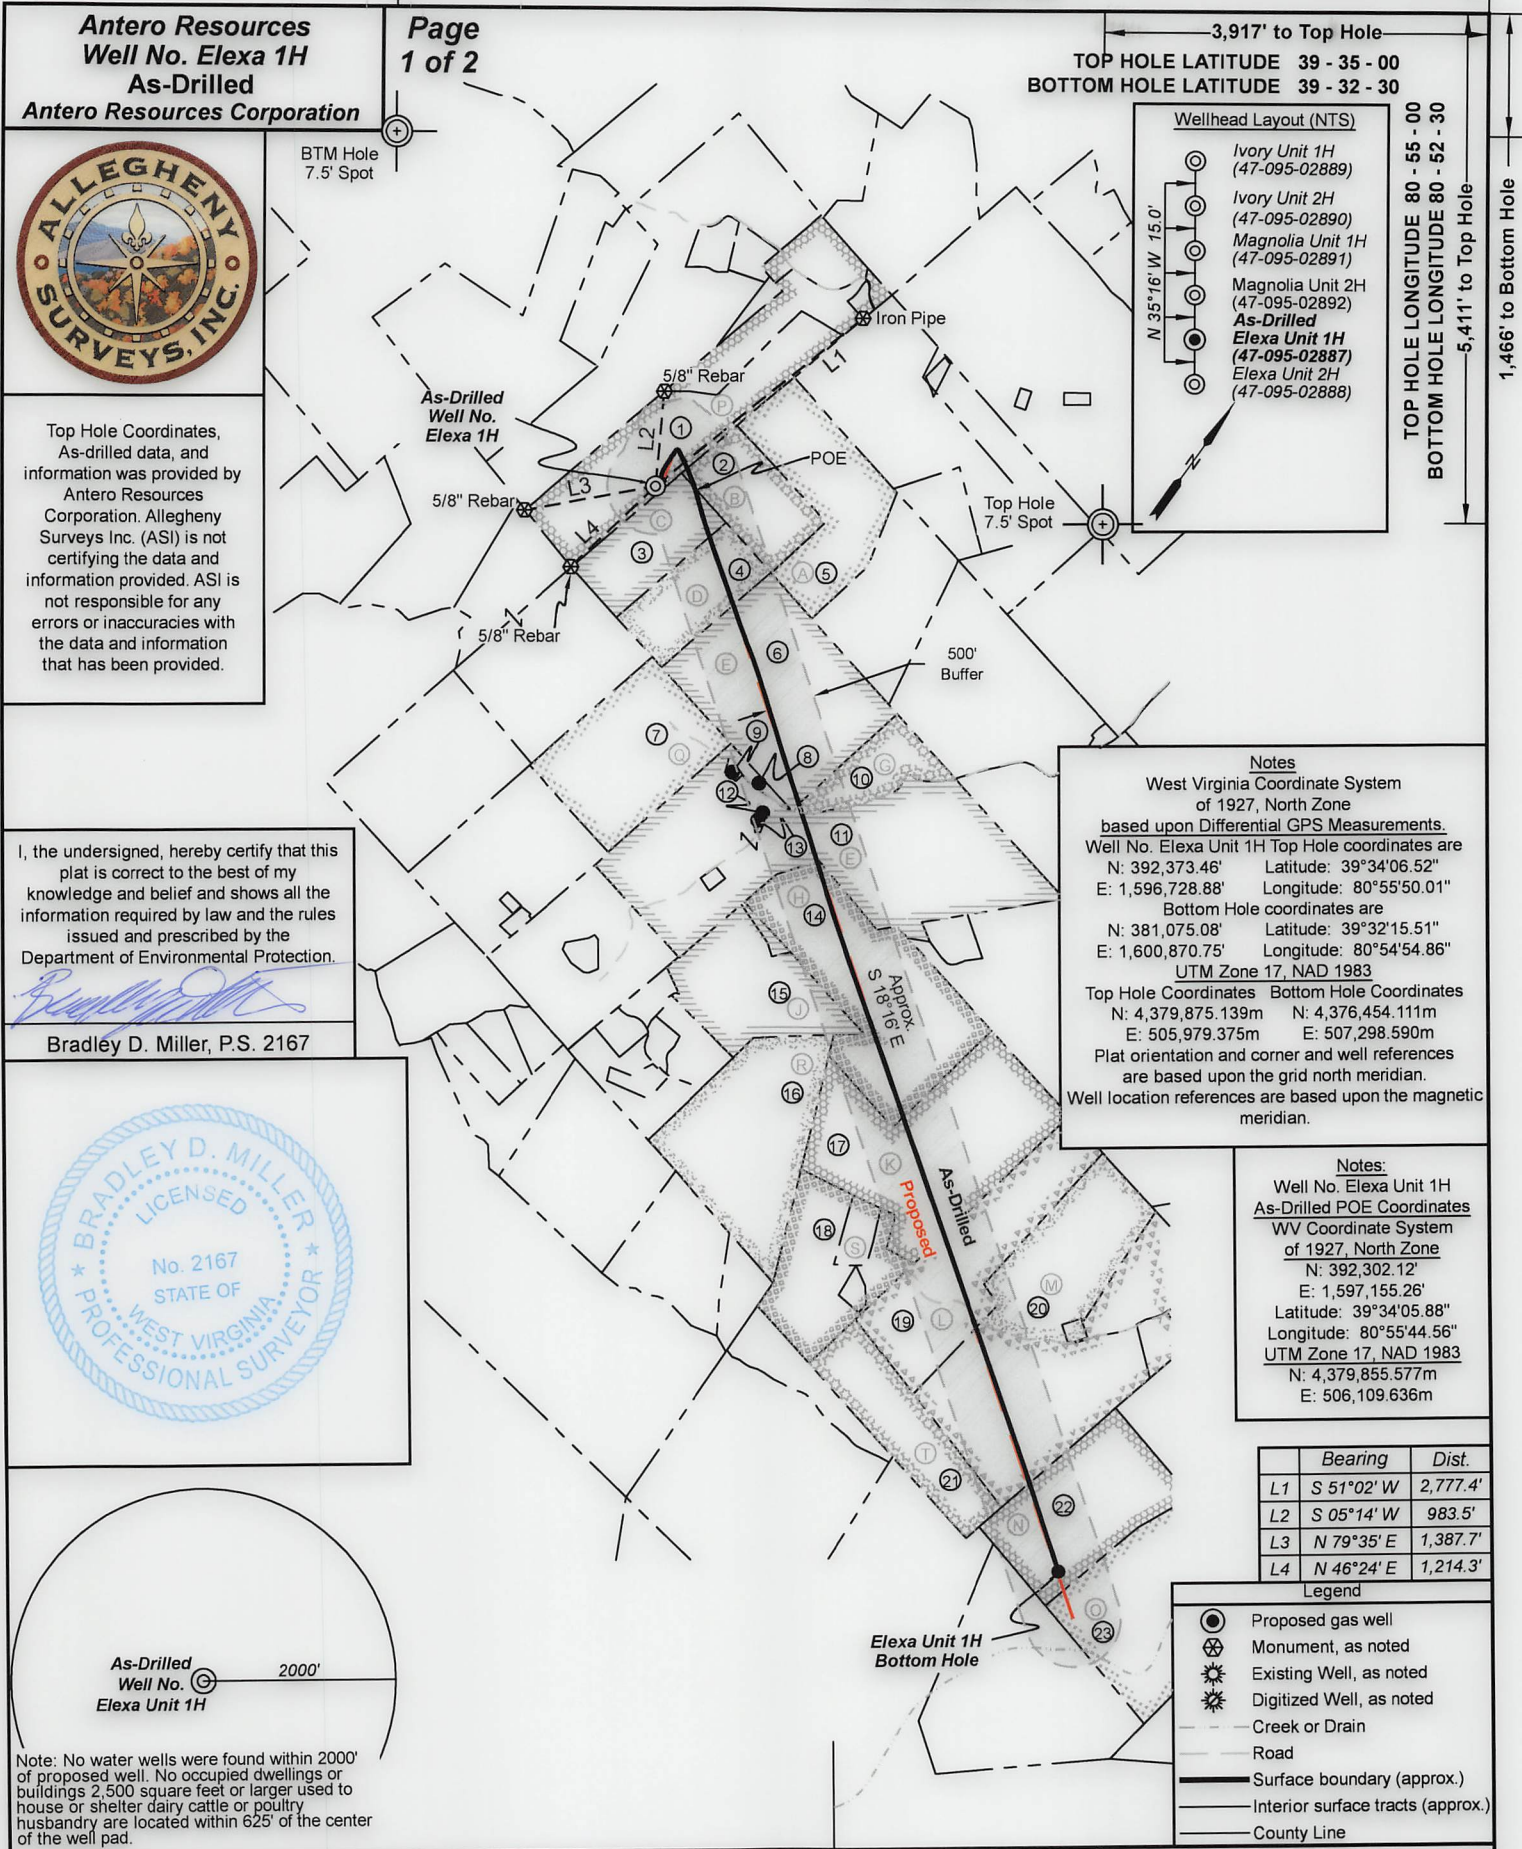

FILE NO: 158-54-L-23 DRAWING NO: Elexa 1H As-Drilled SCALE: 1" = 2000' MINIMUM DEGREE OF ACCURACY: Submeter PROVEN SOURCE OF ELEVATION: WVDOT, Harrisville, WV	STATE OF WEST VIRGINIA DEPARTMENT OF ENVIRONMENTAL PROTECTION OIL AND GAS DIVISION	DATE: July 2 20 25 OPERATOR'S WELL NO. Elexa 1H API WELL NO 47 - 095 - 02887 STATE COUNTY PERMIT
WELL TYPE: ☐ OIL ☒ GAS ☐ LIQUID INJECTION ☐ WASTE DISPOSAL (IF GAS) PRODUCTION: ☐ STORAGE ☐ DEEP ☒ SHALLOW		
LOCATION: ELEVATION: As-built Elev: 1,091' WATERSHED: Outlet Middle Island Creek QUADRANGLE: Paden City DISTRICT: Lincoln COUNTY: Tyler SURFACE OWNER: Neil R. Stebbins ACREAGE: 51.48 ROYALTY OWNER: AMP IV, LP LEASE NO: ACREAGE: 80.37		
PROPOSED WORK: ☐ DRILL ☐ CONVERT ☒ DRILL DEEPER ☐ FRACTURE OR STIMULATE ☐ PLUG OFF OLD FORMATION ☐ PERFORATE NEW FORMATION ☒ OTHER PHYSICAL CHANGE IN WELL (SPECIFY) As-Drilled 6,380' TVD ☐ PLUG AND ABANDON ☐ CLEAN OUT AND REPLUG TARGET FORMATION: Marcellus Shale ESTIMATED DEPTH: 18,308' MD		
WELL OPERATOR: Antero Resources Corporation DESIGNATED AGENT: Conrad Baston ADDRESS: 1615 Wynkoop Street ADDRESS: 535 White Oaks Blvd. Denver, CO 80202 Bridgeport, WV 26330		



Leases	
A	Robert F. & Rita K. Scardina
B	Robert F. & Rita K. Scardina
D	Robert F. & Rita K. Scardina
C	Robert F. & Rita K. Scardina
E	Earl K. Grimes, et ux
G	BRC Appalachian Minerals I, LLC
H	Breck Minerals, LP
J	Bounty Minerals, LLC
K	Ethan A. & Marsh L. Riffle, JTWROS
L	Blanche B. Bailey & Shelby R. Bailey
M	Charles R. Jobes
N	Melodee A. Matheny
O	Heritage Resources-Marcellus, LLC
P	AMP IV, LP
Q	Date Palm Resources, LLC
R	Robert L. Bolner
S	Bounty Minerals, LLC
T	MMA Mineral Group, LLC

ID	TM-Par	Owner	Bk/Pg	Acres
1	5-9.4	Neil R. Stebbins	366/436	51.48
2	5-12	Robert F. & Rita K. Scardina	320/646	25.00
3	5-11	Robert F. & Rita K. Scardina	320/646	25.00
4	5-10	Robert F. & Rita K. Scardina	320/646	25.00
5	5-13	Robert F. & Rita K. Scardina	320/646	46.00
6	9-3	D.E. Grimes & Sons Farm, LLC	209/496	67.00
7	9-1	Dickie L. Morgan	605/478	50.00
8	9-2	D.E. Grimes & Sons Farm, LLC	209/496	1.59
9	9-16.3	Timothy Grimes & Pamela Robinson	OR204/32	0.55
10	9-4	Brandon Scott Grimes	637/841	20.00
11	9-16	D.E. Grimes & Sons Farm, LLC	209/496	118.22
12	9-16.4	Darrell Kurt Grimes & Amy J. Grimes	617/383	0.24
13	9-16.1	Darrell K. & Amy J. Grimes	OR87/558	0.25
14	9-15.1	Larry M. & Betty L. Jochum; Mark Lee Jochum	573/794	75.00
15	9-43	Larry M. & Betty L. Jochum; Mark Lee Jochum	573/794	36.55
16	9-23	Robert L. Bolner	347/235	61.00
17	9-24	Ethan A. & Marsha L. Riffle	299/26	82.00
18	9-25	Vonlie Cooper	289/103	31.48
19	9-27	Robert Livio Bolner	226/593	59.00
20	9-28	Constance Heintzman	WB43/505	104.50
21	13-2	Idona Cooper Estate	109/234	30.00
22	13-3	Mark E. Heintzman	221/635	51.96
23	13-8	D.H. Lancaster, Jr.	351/288	52.84

FILE NO: 158-54-L-23
DRAWING NO: Elexa 1H As-Drilled
SCALE: 1" = 2000'
MINIMUM DEGREE OF ACCURACY:
Submeter
PROVEN SOURCE OF ELEVATION:
WVDOT, Harrisville, WV

STATE OF WEST VIRGINIA
DEPARTMENT OF ENVIRONMENTAL PROTECTION
OIL AND GAS DIVISION

DATE: July 2 20 25
OPERATOR'S WELL NO. Elexa 1H
API WELL NO
47 - 095 - 02887
STATE COUNTY PERMIT

WELL TYPE: ☐ OIL ☒ GAS ☐ LIQUID INJECTION ☐ WASTE DISPOSAL
(IF GAS) PRODUCTION : ☐ STORAGE ☐ DEEP ☒ SHALLOW
LOCATION: ELEVATION: As-built Elev. 1,091' WATERSHED: Outlet Middle Island Creek QUADRANGLE: Paden City
DISTRICT: Lincoln COUNTY: Tyler
SURFACE OWNER: Neil R. Stebbins ACREAGE: 51.48
ROYALTY OWNER: AMP IV, LP LEASE NO: ACREAGE: 80.37
PROPOSED WORK: ☐ DRILL ☐ CONVERT ☒ DRILL DEEPER ☐ FRACTURE OR STIMULATE ☐ PLUG OFF OLD FORMATION
☐ PERFORATE NEW FORMATION ☒ OTHER PHYSICAL CHANGE IN WELL (SPECIFY) As-Drilled 6,380' TVD
☐ PLUG AND ABANDON ☐ CLEAN OUT AND REPLUG TARGET FORMATION: Marcellus Shale ESTIMATED DEPTH: 18,308' MD

WELL OPERATOR: Antero Resources Corporation DESIGNATED AGENT: Conrad Baston
ADDRESS: 1615 Wynkoop Street ADDRESS: 535 White Oaks Blvd.
Denver, CO 80202 Bridgeport, WV 26330