


Antero Resources Well No. Elexa 2H As-Drilled Antero Resources Corporation

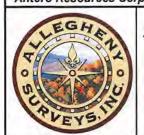

Page 2 of 2


	Leases			
Α	Robert F. & Rita K. Scardina			
В	Robert F. & Rita K. Scardina			
C	Robert F. & Rita K. Scardina			
D	Robert F. & Rita K. Scardina			
E Earl K. Grimes, et ux				
F BRC Appalachian Minerals I, LLC				
G BRC Appalachian Minerals I, LL				
Н	Breck Minerals, LP			
1	BRC Appalachian Minerals I, LLC			
K	Ethan A. & Marsh L. Riffle, JTWROS			
L	Blanche B. Bailey & Shelby R. Bailey			
М	Charles R. Jobes			
Ν	Melodee A. Matheny			
0	O Heritage Resources-Marcellus, LLC			
P	P AMP IV, LP			
Q	Q Janet L. Heintzman			
R	Diane W. Kestle			

Denver, CO 80202


ID	TM-Par	Owner	Bk/Pg	Acres
1	5-9.4	Neil R. Stebbins	366/436	51.48
2	5-12	Robert F. & Rita K. Scardina	320/646	25.00
3	5-11	Robert F. & Rita K. Scardina	320/646	25.00
4	5-10	Robert F. & Rita K. Scardina	320/646	25.00
5	5-13	Robert F. & Rita K. Scardina	320/646	46.00
6	9-3	D.E. Grimes & Sons Farm, LLC	209/496	67.00
7	5-18	Melvin S. Stern, et al	155/637	43.50
8	9-5	D.E. Grimes & Sons Farm, LLC	209/496	1.59
9	9-4	Brandon Scott Grimes	637/841	20.00
10	9-16	D.E. Grimes & Sons Farm, LLC	209/496	118.22
11	9-15.1	Larry M. & Betty L. Jochum; Mark Lee Jochum	573/794	75.00
12	9-17.1	James E. Vancamp & Barbie Jean Palmer	318/485	4.91
13	9-17	Ethan A. & Marsha L. Riffle	323/649	90.04
14	9-24	Ethan A. & Marsha L. Riffle	299/26	82.00
15	9-27	Robert Livio Bolner	226/593	59.00
16	9-28	Constance Heintzman	WB43/505	104.50
17	9-29	Russell D. & Mary A. Adams	190/300	1.00
18	9-36	Diane Weaver Clark	WB39/544	59.00
19	13-3	Mark E. Heintzman	221/635	51.96
20	13-8	D.H. Lancaster, Jr.	351/288	52.84

Bridgeport, WV 26330

FILE NO: 158-54-L-23  DRAWING NO: Elexa 2H As-Drilled  SCALE: 1" = 2000'  MINIMUM DEGREE OF ACCURACY: Submeter  PROVEN SOURCE OF ELEVATION: WVDOT, Harrisville, WV	STATE OF WEST VIRGINIA DEPARTMENT OF ENVIRONMENTAL PROTECTION OIL AND GAS DIVISION	DATE: July 2 20 25  OPERATOR'S WELL NO. Elexa 2H  API WELL NO  47 - 095 - 02888  STATE COUNTY PERMIT
WELL TYPE:  OIL	1,091' WATERSHED: Outlet Middle Island Creek QUA	DRANGLE: <u>Paden City</u> OUNTY:
☐ PERFORATE NEW FORMATION	DUT AND REPLUG TARGET FORMATION: LEASE NO;  LEASE NO;  PROVIDENT MODILL DEEPER □FRACTURE OR STIMULA:  WOTHER PHYSICAL CHANGE IN WELL (SPECIFY)  DUT AND REPLUG TARGET FORMATION: Marcellus SI	As-Drilled 6.403' TVD
WELL OPERATOR: Antero Resources Co	BEGIOTHTEB / IOEITT	

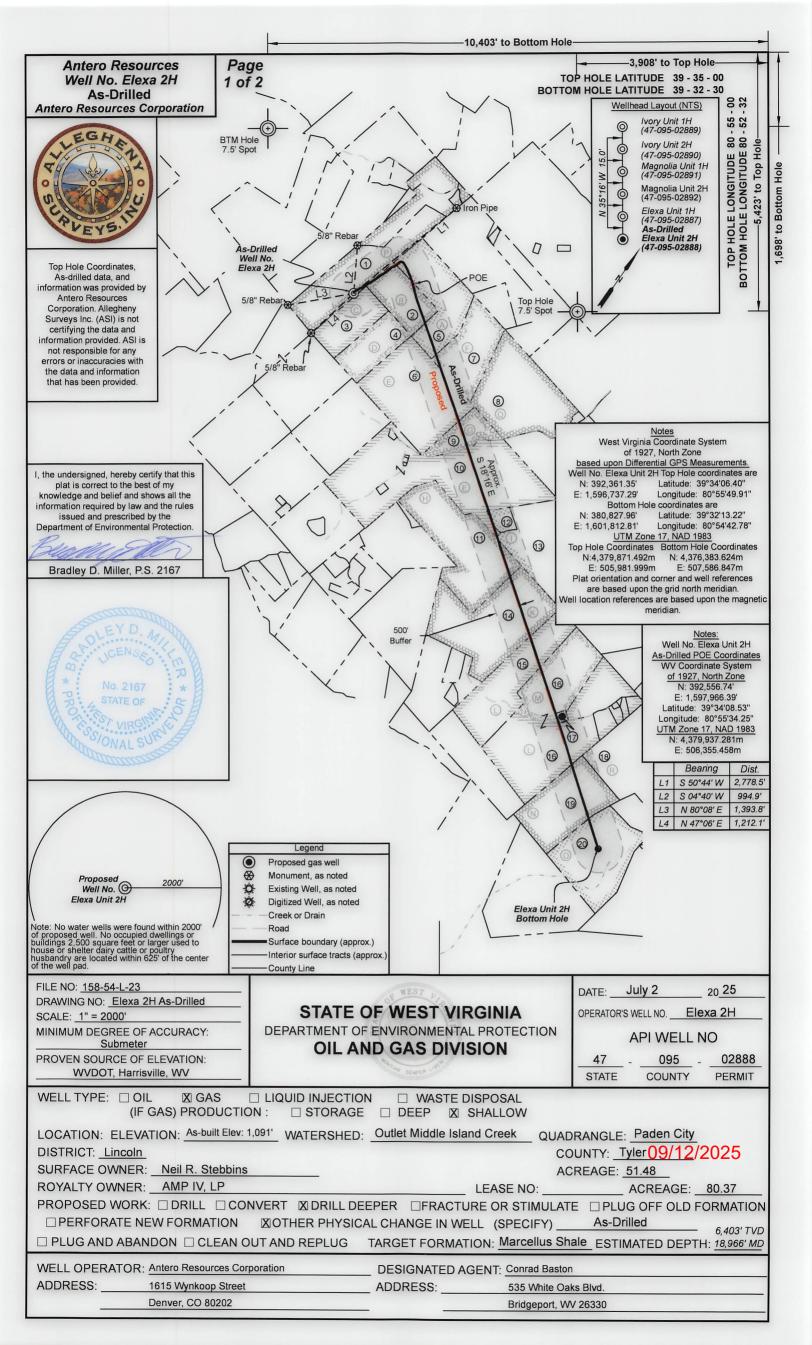

Antero Resources
Well No. Elexa 2H
As-Drilled
Antero Resources Corporation

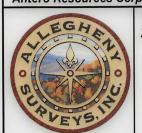

Page 2 of 2

	Leases		
Α	Robert F. & Rita K. Scardina		
В	Robert F. & Rita K. Scardina		
С	Robert F. & Rita K. Scardina		
D	Robert F. & Rita K. Scardina		
Е	Earl K. Grimes, et ux		
F	BRC Appalachian Minerals I, LLC		
G	BRC Appalachian Minerals I, LLC		
Н	Breck Minerals, LP		
1	BRC Appalachian Minerals I, LLC		
K	Ethan A. & Marsh L. Riffle, JTWROS		
L	Blanche B. Bailey & Shelby R. Bailey		
М	Charles R. Jobes		
N	Melodee A. Matheny		
0	Heritage Resources-Marcellus, LLC		
Р	AMP IV, LP		
Q	Janet L. Heintzman		
R	Diane W. Kestle		

ID	TM Des	O	Dk/Da	Acres
ID	TM-Par	Owner	Bk/Pg	
1	5-9.4	Neil R. Stebbins	366/436	51.48
2	5-12	Robert F. & Rita K. Scardina	320/646	25.00
3	5-11	Robert F. & Rita K. Scardina	320/646	25.00
4	5-10	Robert F. & Rita K. Scardina	320/646	25.00
5	5-13	Robert F. & Rita K. Scardina	320/646	46.00
6	9-3	D.E. Grimes & Sons Farm, LLC	209/496	67.00
7	5-18	Melvin S. Stern, et al	155/637	43.50
8	9-5	D.E. Grimes & Sons Farm, LLC	209/496	1.59
9	9-4	Brandon Scott Grimes	637/841	20.00
10	9-16	D.E. Grimes & Sons Farm, LLC	209/496	118.22
11	9-15.1	Larry M. & Betty L. Jochum; Mark Lee Jochum	573/794	75.00
12	9-17.1	James E. Vancamp & Barbie Jean Palmer	318/485	4.91
13	9-17	Ethan A. & Marsha L. Riffle	323/649	90.04
14	9-24	Ethan A. & Marsha L. Riffle	299/26	82.00
15	9-27	Robert Livio Bolner	226/593	59.00
16	9-28	Constance Heintzman	WB43/505	104.50
17	9-29	Russell D. & Mary A. Adams	190/300	1.00
18	9-36	Diane Weaver Clark	WB39/544	59.00
19	13-3	Mark E. Heintzman	221/635	51.96
20	13-8	D.H. Lancaster, Jr.	351/288	52.84

FILE NO: 158-54-L-23				
DRAWING NO: Elexa 2H As-Drilled				
SCALE: 1" = 2000'				
MINIMUM DEGREE OF ACCURACY:				
Submeter				
PROVEN SOURCE OF ELEVATION:				
WVDOT, Harrisville, WV				
WELL TYPE: ☐ OIL X GAS				

## STATE OF WEST VIRGINIA DEPARTMENT OF ENVIRONMENTAL PROTECTION OIL AND GAS DIVISION

DATE: July 2 20 25

OPERATOR'S WELL NO. Elexa 2H

API WELL NO

47 - 095 - 02888

WVDOT, Harrisville, WV	AM SEMPE	R LUBON	STATE	COUNTY	PERMIT
	☐ LIQUID INJECTION ☐ V N : ☐ STORAGE ☐ DEE	VASTE DISPOSAL P ⊠ SHALLOW			
LOCATION: ELEVATION: As-built Elev: 1	,091' WATERSHED: Outlet M	ddle Island Creek QUAD	RANGLE:	Paden City	
DISTRICT: Lincoln		CC	UNTY:	ту <b>@</b> 9/12/	2025
SURFACE OWNER: Neil R. Stebbins		AC	REAGE: 5	51.48	
ROYALTY OWNER: AMP IV, LP		LEASE NO:		ACREAGE: _	80.37
PROPOSED WORK: ☐ DRILL ☐ CON	NVERT X DRILL DEEPER	FRACTURE OR STIMULAT	E PLUC	GOFF OLD F	ORMATION
☐ PERFORATE NEW FORMATION	<b>⊠OTHER PHYSICAL CHANG</b>	E IN WELL (SPECIFY)	As-Dri	lled	6.403' TVD
☐ PLUG AND ABANDON ☐ CLEAN O	UT AND REPLUG TARGET I	FORMATION: Marcellus Sh	ale_ESTIM	IATED DEPTI	H: <u>18,966' MD</u>
WELL OPERATOR: Antero Resources Corp	poration DESIGN	IATED AGENT: Conrad Bastor			
ADDRESS: 1615 Wynkoop Street	ADDRES	SS: 535 White Oa	ks Blvd.		
Denver, CO 80202		Bridgeport, W	V 26330		