




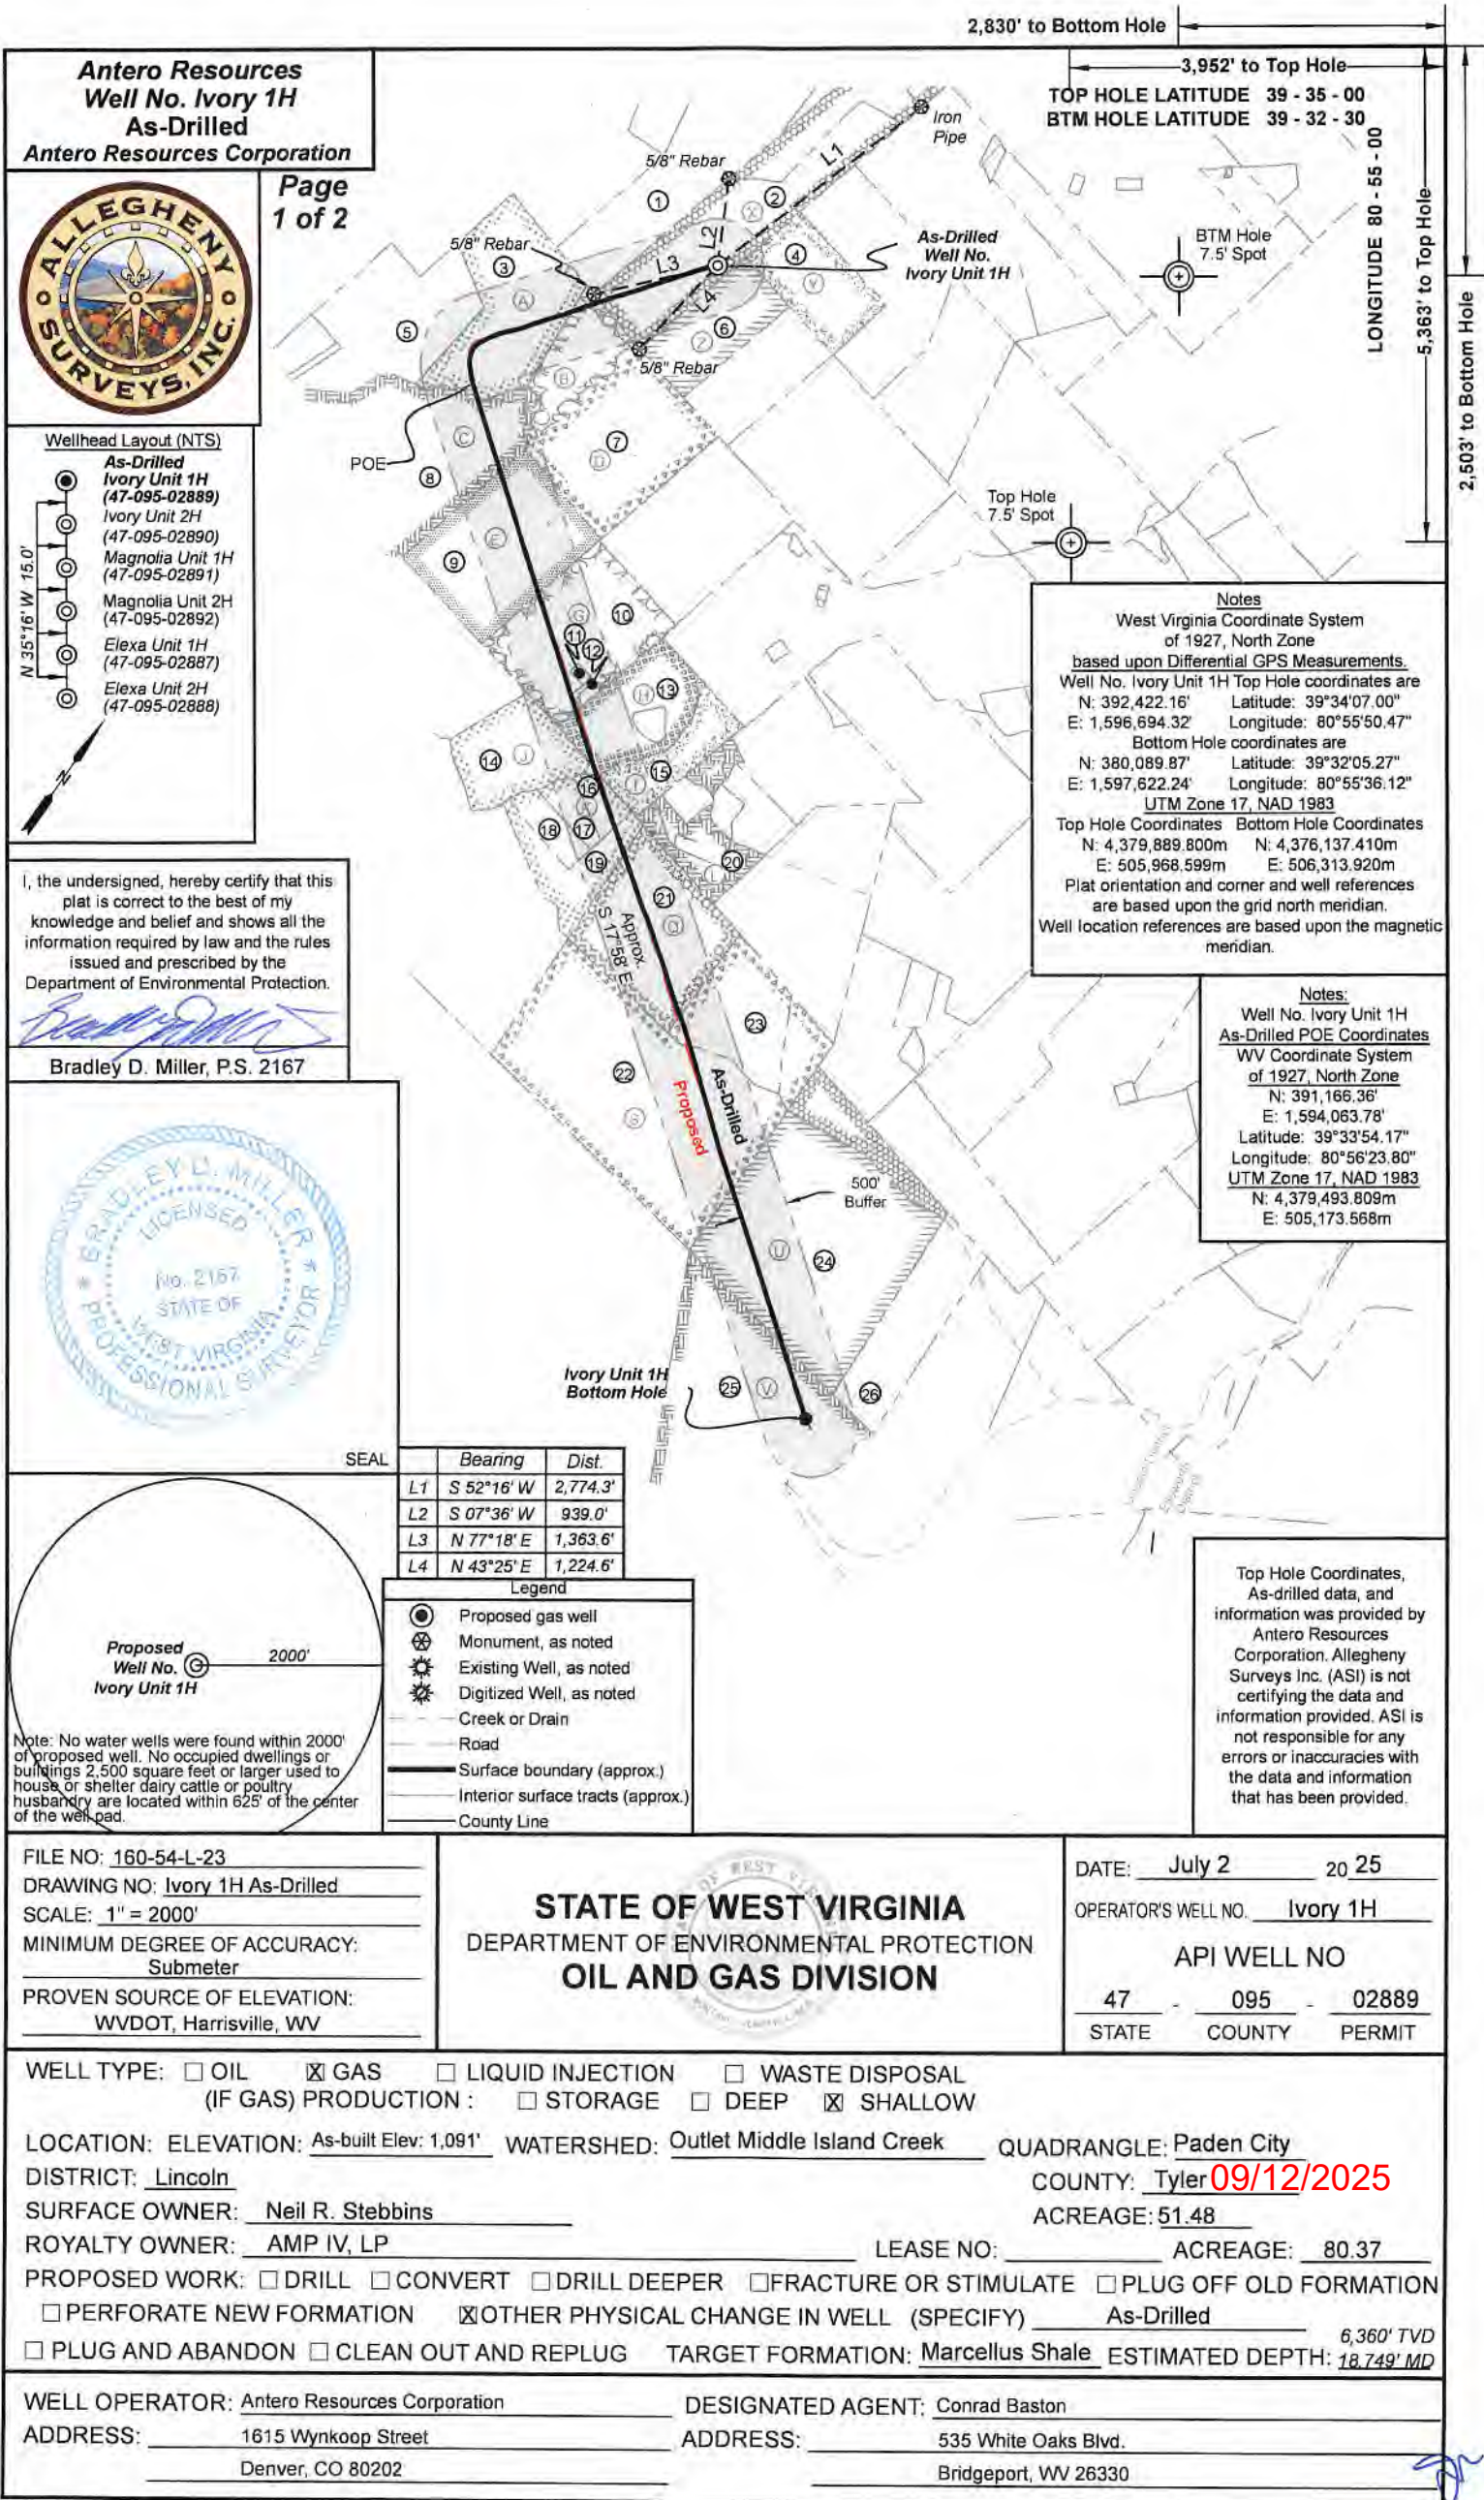

Leases	
A	Moore Self Storage, North Carolina, LLC
B	Robert F. & Rita K. Scardina
C	Evon Heintzman, by Debra K. Spencer as AIF
D	Robert F. & Rita K. Scardina
E	Bounty Minerals, LLC
G	Theresa J. Drain
H	Bounty Minerals, LLC
I	Delbert D. & Betty R. Rush
J	M. Sharon Deaton
K	Larry A. & Karen B. Wells
L	Delbert D. & Betty R. Rush
Q	Gerald W. Meckley, Jr. et al
S	Arlen Glen Wells, Jr.
U	Gerald W. Meckley, Jr. et al
V	Gerald W. Meckley, Jr. et al
X	AMP IV, LP
Y	Robert F. & Rita K. Scardina
Z	Robert F. & Rita K. Scardina

ID	TM-Par	Owner	Bk/Pg	Acres
1	5-4	Ralph D. & Sophia Judge	306/681	60.77
2	5-9.4	Neil R. Stebbins	366/436	51.48
3	4-91	Donna Kathy Johnston	184/133	54.06
4	5-12	Robert F. & Rita K. Scardina	320/646	25.00
5	4-90.1	Gary B. & Melinda J. Lewis	473/1	47.33
6	5-11	Robert F. & Rita K. Scardina	320/646	25.00
7	8-14	Robert F. & Rita K. Scardina	320/646	72.79
8	8-12	Donna Kathy Johnston	184/133	86.89
9	8-13	Donna Kathy Johnston	184/133	50.00
10	8-24	Theresa J. Drain	428/607	49.47
11	8-25	Theresa J. Drain	342/614	0.53
12	8-24.1	Thomas P. & Debra N. Doig	383/394	1.09
13	8-26	Delbert D. & Betty Ruth Rush	191/125	20.65
14	8-27	Sharon M. & Jeffrey Darrin Deaton	349/176	24.652
15	9-12	Betty Ruth Rush	162/25	23.00
16	8-30.4	Rada Ann Weekley	OR135/379	5.007
17	8-30.1	Rada Ann Weekley	WB30/516	5.007
18	8-30.3	Coy L. Moffitt	10/439	6.772
19	8-30.2	Nevin J. Moffitt	332/25	16.380
20	9-14	Donal Lee & Ronal Wayne Rush	368/825	32.71
21	9-22	GR Meckley Family Trust	OR50/28	43.75
22	8-61	GR Meckley Family Trust	OR50/28	106.51
23	9-45	GR Meckley Family Trust	OR50/608	26.05
24	13-1	GR Meckley Family Trust	OR50/28	99.00
25	13-9.6	GR Meckley Family Trust	OR50/28	65.48
26	13-5	GR Meckley Family Trust	OR50/28	31.50

FILE NO: 160-54-L-23
DRAWING NO: Ivory 1H As-Drilled
SCALE: 1" = 2000'
MINIMUM DEGREE OF ACCURACY:
Submeter
PROVEN SOURCE OF ELEVATION:
WVDOT, Harrisville, WV

STATE OF WEST VIRGINIA
DEPARTMENT OF ENVIRONMENTAL PROTECTION
OIL AND GAS DIVISION

DATE: July 2, 20 25
OPERATOR'S WELL NO. Ivory 1H
API WELL NO
47 - 095 - 02889
STATE COUNTY PERMIT

WELL TYPE: ☐ OIL ☒ GAS ☐ LIQUID INJECTION ☐ WASTE DISPOSAL
(IF GAS) PRODUCTION: ☐ STORAGE ☐ DEEP ☒ SHALLOW
LOCATION: ELEVATION: As-built Elev: 1,091' WATERSHED: Outlet Middle Island Creek QUADRANGLE: Paden City
DISTRICT: Lincoln COUNTY: Tyler **09/12/2025**
SURFACE OWNER: Neil R. Stebbins ACREAGE: 51.48
ROYALTY OWNER: AMP IV, LP LEASE NO: _____ ACREAGE: 80.37
PROPOSED WORK: ☐ DRILL ☐ CONVERT ☐ DRILL DEEPER ☐ FRACTURE OR STIMULATE ☐ PLUG OFF OLD FORMATION
☐ PERFORATE NEW FORMATION ☒ OTHER PHYSICAL CHANGE IN WELL (SPECIFY) As-Drilled 6,360' TVD
☐ PLUG AND ABANDON ☐ CLEAN OUT AND REPLUG TARGET FORMATION: Marcellus Shale ESTIMATED DEPTH: 18,749' MD


WELL OPERATOR: Antero Resources Corporation DESIGNATED AGENT: Conrad Baston
ADDRESS: 1615 Wynkoop Street ADDRESS: 535 White Oaks Blvd.
Denver, CO 80202 Bridgeport, WV 26330

Antero Resources
Well No. Ivory 1H
As-Drilled
Antero Resources Corporation




Page
1 of 2

Wellhead Layout (NTS)

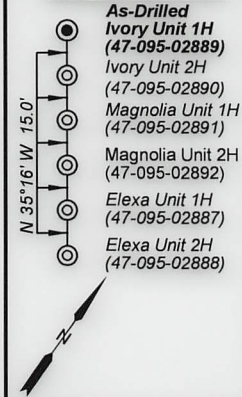


I, the undersigned, hereby certify that this plat is correct to the best of my knowledge and belief and shows all the information required by law and the rules issued and prescribed by the Department of Environmental Protection.

Bradley D. Miller, P.S. 2167

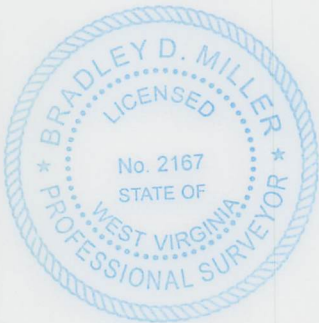

SEAL

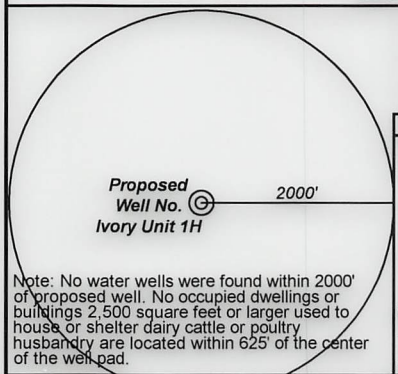

	Bearing	Dist.
L1	S 52°16' W	2,774.3'
L2	S 07°36' W	939.0'
L3	N 77°18' E	1,363.6'
L4	N 43°25' E	1,224.6'

Legend

- Proposed gas well
- Monument, as noted
- Existing Well, as noted
- Digitized Well, as noted
- Creek or Drain
- Road
- Surface boundary (approx.)
- Interior surface tracts (approx.)
- County Line

FILE NO: 160-54-L-23
DRAWING NO: Ivory 1H As-Drilled
SCALE: 1" = 2000'
MINIMUM DEGREE OF ACCURACY: Submeter
PROVEN SOURCE OF ELEVATION: WVDOT, Harrisville, WV

STATE OF WEST VIRGINIA
DEPARTMENT OF ENVIRONMENTAL PROTECTION
OIL AND GAS DIVISION

DATE: July 2 20 25
OPERATOR'S WELL NO. Ivory 1H
API WELL NO
47 - 095 - 02889
STATE COUNTY PERMIT

WELL TYPE: ☐ OIL ☒ GAS ☐ LIQUID INJECTION ☐ WASTE DISPOSAL
(IF GAS) PRODUCTION: ☐ STORAGE ☐ DEEP ☒ SHALLOW
LOCATION: ELEVATION: As-built Elev: 1,091' WATERSHED: Outlet Middle Island Creek QUADRANGLE: Paden City
DISTRICT: Lincoln COUNTY: Tyler 09/12/2025
SURFACE OWNER: Neil R. Stebbins ACREAGE: 51.48
ROYALTY OWNER: AMP IV, LP LEASE NO: ACREAGE: 80.37
PROPOSED WORK: ☐ DRILL ☐ CONVERT ☐ DRILL DEEPER ☐ FRACTURE OR STIMULATE ☐ PLUG OFF OLD FORMATION
☐ PERFORATE NEW FORMATION ☒ OTHER PHYSICAL CHANGE IN WELL (SPECIFY) As-Drilled
☐ PLUG AND ABANDON ☐ CLEAN OUT AND REPLUG TARGET FORMATION: Marcellus Shale ESTIMATED DEPTH: 6,360' TVD 18,749' MD

WELL OPERATOR: Antero Resources Corporation DESIGNATED AGENT: Conrad Baston
ADDRESS: 1615 Wynkoop Street ADDRESS: 535 White Oaks Blvd.
Denver, CO 80202 Bridgeport, WV 26330

2,830' to Bottom Hole

3,952' to Top Hole

TOP HOLE LATITUDE 39 - 35 - 00
BTM HOLE LATITUDE 39 - 32 - 30

LONGITUDE 80 - 55 - 00

5,363' to Top Hole
2,503' to Bottom Hole

Notes

West Virginia Coordinate System of 1927, North Zone
based upon Differential GPS Measurements.
Well No. Ivory Unit 1H Top Hole coordinates are
N: 392,422.16' Latitude: 39°34'07.00"
E: 1,596,694.32' Longitude: 80°55'50.47"
Bottom Hole coordinates are
N: 380,089.87' Latitude: 39°32'05.27"
E: 1,597,622.24' Longitude: 80°55'36.12"
UTM Zone 17, NAD 1983
Top Hole Coordinates Bottom Hole Coordinates
N: 4,379,889.800m N: 4,376,137.410m
E: 505,968.599m E: 506,313.920m
Plat orientation and corner and well references are based upon the grid north meridian.
Well location references are based upon the magnetic meridian.

Notes:

Well No. Ivory Unit 1H
As-Drilled POE Coordinates
WV Coordinate System of 1927, North Zone
N: 391,166.36'
E: 1,594,063.78'
Latitude: 39°33'54.17"
Longitude: 80°56'23.80"
UTM Zone 17, NAD 1983
N: 4,379,493.809m
E: 505,173.568m

Top Hole Coordinates, As-drilled data, and information was provided by Antero Resources Corporation. Allegheny Surveys Inc. (ASI) is not certifying the data and information provided. ASI is not responsible for any errors or inaccuracies with the data and information that has been provided.



Leases	
A	Moore Self Storage, North Carolina, LLC
B	Robert F. & Rita K. Scardina
C	Evon Heintzman, by Debra K. Spencer as AIF
D	Robert F. & Rita K. Scardina
E	Bounty Minerals, LLC
G	Theresa J. Drain
H	Bounty Minerals, LLC
I	Delbert D. & Betty R. Rush
J	M. Sharon Deaton
K	Larry A. & Karen B. Wells
L	Delbert D. & Betty R. Rush
Q	Gerald W. Meckley, Jr. et al
S	Arlen Glen Wells, Jr.
U	Gerald W. Meckley, Jr. et al
V	Gerald W. Meckley, Jr. et al
X	AMP IV, LP
Y	Robert F. & Rita K. Scardina
Z	Robert F. & Rita K. Scardina

ID	TM-Par	Owner	Bk/Pg	Acres
1	5-4	Ralph D. & Sophia Judge	306/681	60.77
2	5-9.4	Neil R. Stebbins	366/436	51.48
3	4-91	Donna Kathy Johnston	184/133	54.06
4	5-12	Robert F. & Rita K. Scardina	320/646	25.00
5	4-90.1	Gary B. & Melinda J. Lewis	473/1	47.33
6	5-11	Robert F. & Rita K. Scardina	320/646	25.00
7	8-14	Robert F. & Rita K. Scardina	320/646	72.79
8	8-12	Donna Kathy Johnston	184/133	86.89
9	8-13	Donna Kathy Johnston	184/133	50.00
10	8-24	Theresa J. Drain	428/607	49.47
11	8-25	Theresa J. Drain	342/614	0.53
12	8-24.1	Thomas P. & Debra N. Doig	383/394	1.09
13	8-26	Delbert D. & Betty Ruth Rush	191/125	20.65
14	8-27	Sharon M. & Jeffrey Darrin Deaton	349/176	24.652
15	9-12	Betty Ruth Rush	162/25	23.00
16	8-30.4	Rada Ann Weekley	OR135/379	5.007
17	8-30.1	Rada Ann Weekley	WB30/516	5.007
18	8-30.3	Coy L. Moffitt	10/439	6.772
19	8-30.2	Nevin J. Moffitt	332/25	16.380
20	9-14	Donal Lee & Ronal Wayne Rush	368/825	32.71
21	9-22	GR Meckley Family Trust	OR50/28	43.75
22	8-61	GR Meckley Family Trust	OR50/28	106.51
23	9-45	GR Meckley Family Trust	OR50/606	26.05
24	13-1	GR Meckley Family Trust	OR50/28	99.00
25	13-9.6	GR Meckley Family Trust	OR50/28	65.48
26	13-5	GR Meckley Family Trust	OR50/28	31.50

FILE NO: 160-54-L-23
DRAWING NO: Ivory 1H As-Drilled
SCALE: 1" = 2000'
MINIMUM DEGREE OF ACCURACY:
Submeter
PROVEN SOURCE OF ELEVATION:
WVDOT, Harrisville, WV

STATE OF WEST VIRGINIA
DEPARTMENT OF ENVIRONMENTAL PROTECTION
OIL AND GAS DIVISION

DATE: July 2 20 25
OPERATOR'S WELL NO. Ivory 1H
API WELL NO
47 - 095 - 02889
STATE COUNTY PERMIT

WELL TYPE: ☐ OIL ☒ GAS ☐ LIQUID INJECTION ☐ WASTE DISPOSAL
(IF GAS) PRODUCTION : ☐ STORAGE ☐ DEEP ☒ SHALLOW
LOCATION: ELEVATION: As-built Elev: 1,091' WATERSHED: Outlet Middle Island Creek QUADRANGLE: Paden City
DISTRICT: Lincoln COUNTY: Tyler
SURFACE OWNER: Neil R. Stebbins ACREAGE: 51.48
ROYALTY OWNER: AMP IV, LP LEASE NO: ACREAGE: 80.37
PROPOSED WORK: ☐ DRILL ☐ CONVERT ☐ DRILL DEEPER ☐ FRACTURE OR STIMULATE ☐ PLUG OFF OLD FORMATION
☐ PERFORATE NEW FORMATION ☒ OTHER PHYSICAL CHANGE IN WELL (SPECIFY) As-Drilled
☐ PLUG AND ABANDON ☐ CLEAN OUT AND REPLUG TARGET FORMATION: Marcellus Shale ESTIMATED DEPTH: 18,749' MD

WELL OPERATOR: Antero Resources Corporation DESIGNATED AGENT: Conrad Baston
ADDRESS: 1615 Wynkoop Street ADDRESS: 535 White Oaks Blvd.
Denver, CO 80202 Bridgeport, WV 26330