





Antero Resources
Well No. Ivory 2H
As-Drilled
Antero Resources Corporation

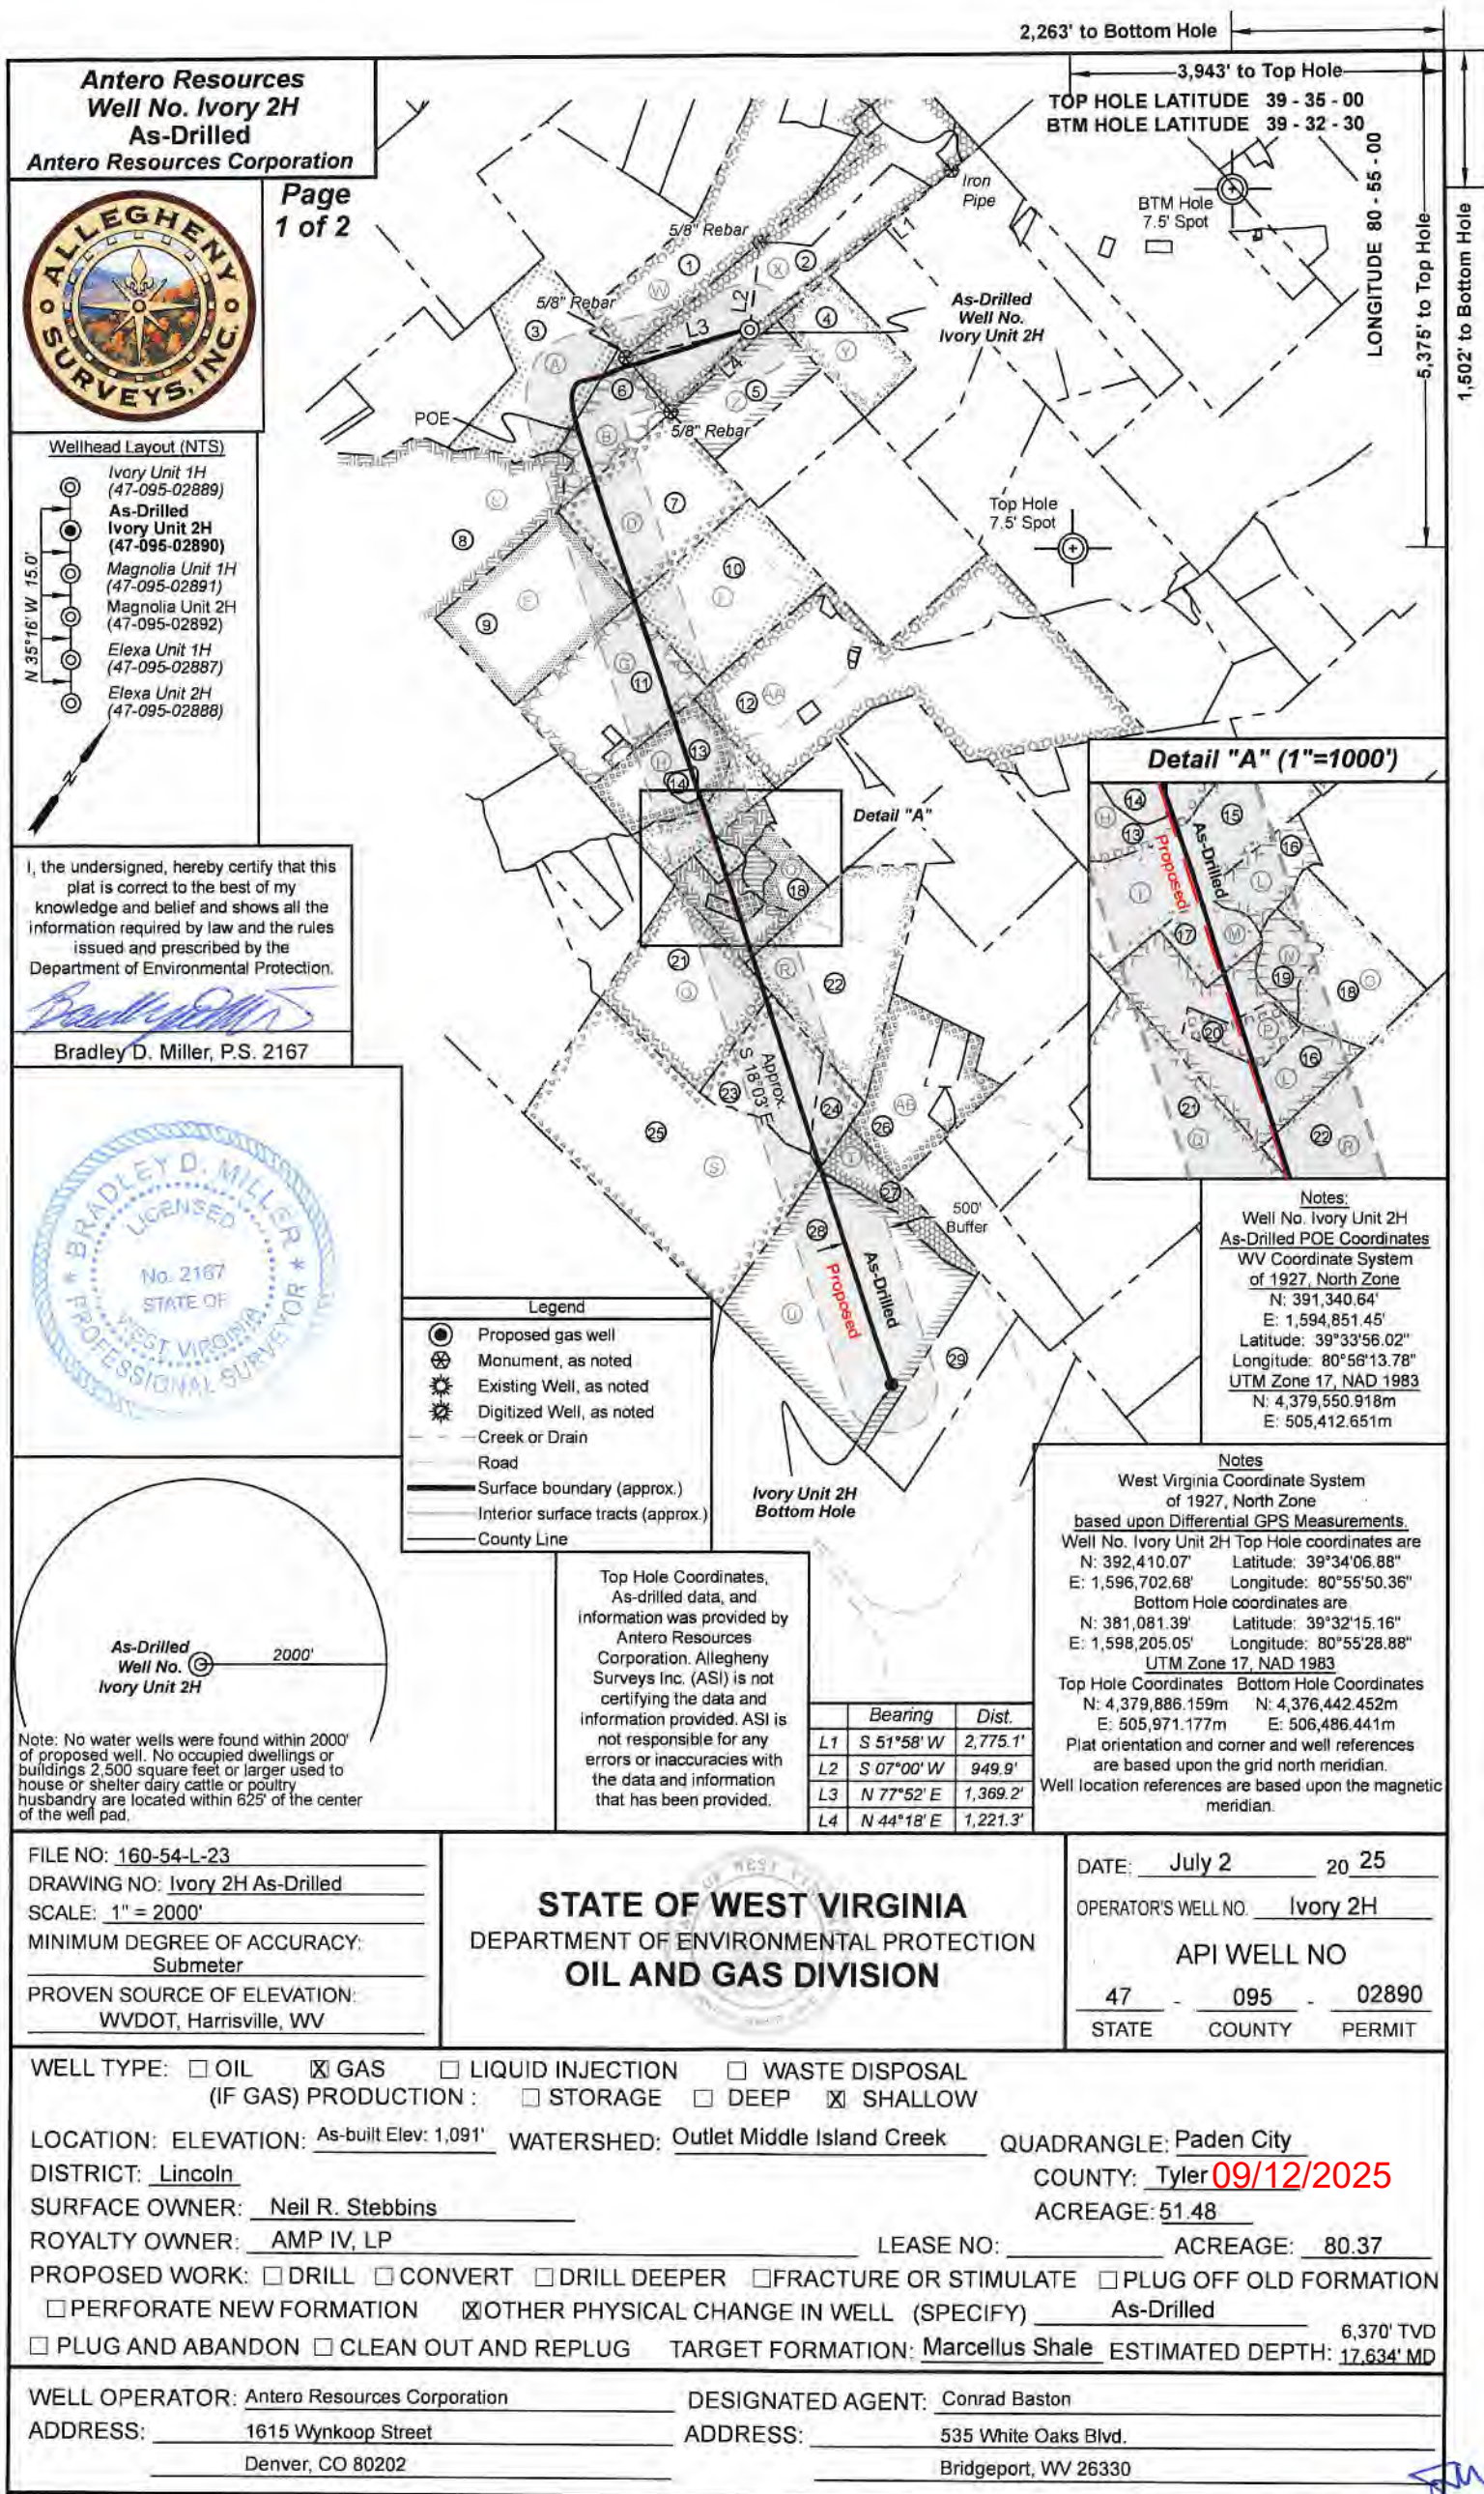


Page
1 of 2

Wellhead Layout (NTS)

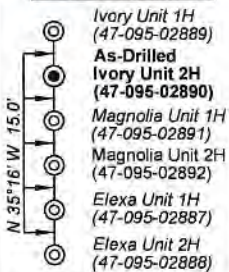

I, the undersigned, hereby certify that this plat is correct to the best of my knowledge and belief and shows all the information required by law and the rules issued and prescribed by the Department of Environmental Protection.

Bradley D. Miller, P.S. 2167

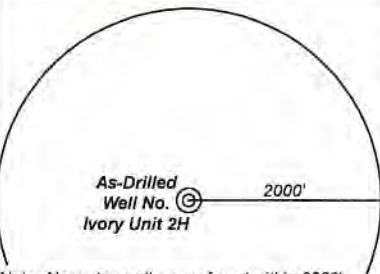

Note: No water wells were found within 2000' of proposed well. No occupied dwellings or buildings 2,500 square feet or larger used to house or shelter dairy cattle or poultry husbandry are located within 625' of the center of the well pad.

FILE NO: 160-54-L-23
DRAWING NO: Ivory 2H As-Drilled
SCALE: 1" = 2000'
MINIMUM DEGREE OF ACCURACY: Submeter
PROVEN SOURCE OF ELEVATION: WVDOT, Harrisville, WV

STATE OF WEST VIRGINIA
DEPARTMENT OF ENVIRONMENTAL PROTECTION
OIL AND GAS DIVISION

DATE: July 2 20 25
OPERATOR'S WELL NO: Ivory 2H
API WELL NO
47 - 095 - 02890
STATE COUNTY PERMIT

WELL TYPE: ☐ OIL ☒ GAS ☐ LIQUID INJECTION ☐ WASTE DISPOSAL
(IF GAS) PRODUCTION: ☐ STORAGE ☐ DEEP ☒ SHALLOW
LOCATION: ELEVATION: As-built Elev: 1,091' WATERSHED: Outlet Middle Island Creek QUADRANGLE: Paden City
DISTRICT: Lincoln COUNTY: Tyler 09/12/2025
SURFACE OWNER: Neil R. Stebbins ACREAGE: 51.48
ROYALTY OWNER: AMP IV, LP LEASE NO: ACREAGE: 80.37
PROPOSED WORK: ☐ DRILL ☐ CONVERT ☐ DRILL DEEPER ☐ FRACTURE OR STIMULATE ☐ PLUG OFF OLD FORMATION
☐ PERFORATE NEW FORMATION ☒ OTHER PHYSICAL CHANGE IN WELL (SPECIFY) As-Drilled
☐ PLUG AND ABANDON ☐ CLEAN OUT AND REPLUG TARGET FORMATION: Marcellus Shale ESTIMATED DEPTH: 6,370' TVD
17,634' MD

WELL OPERATOR: Antero Resources Corporation DESIGNATED AGENT: Conrad Baston
ADDRESS: 1615 Wynkoop Street ADDRESS: 535 White Oaks Blvd.
Denver, CO 80202 Bridgeport, WV 26330



Leases	
A	Moore Self Storage, North Carolina, LLC
B	Robert F. & Rita K. Scardina
C	Evon Heintzman, by Debra K. Spencer as AIF
D	Robert F. & Rita K. Scardina
E	Bounty Minerals, LLC
F	Date Palm Resources, LLC
G	Theresa J. Drain
H	Bounty Minerals, LLC
I	Delbert D. & Betty R. Rush
L	Delbert D. & Betty R. Rush
M	Betty Ruth Rush, et al
N	Kimberly J. Bassett, DSSP
O	Larry M. & Betty L. Jochum, JTWROS
P	Ronal Wayne Rush
Q	Gerald W. Meckley, Jr. et al
R	Robert L. Bolner
S	Arlen Glen Wells, Jr.
T	Frank Krynicki
U	Gerald W. Meckley, Jr. et al
W	Ralph & Stella Judge
X	AMP IV, LP
Y	Robert F. & Rita K. Scardina
Z	Robert F. & Rita K. Scardina
AA	Earl Grimes, et ux
AB	Bounty Minerals, LLC

ID	TM-Par	Owner	Bk/Pg	Acres
1	5-4	Ralph D. & Sophia Judge	306/681	60.77
2	5-9.4	Neil R. Stebbins	366/436	51.48
3	4-91	Donna Kathy Johnston	184/133	54.06
4	5-12	Robert F. & Rita K. Scardina	320/646	25.00
5	5-11	Robert F. & Rita K. Scardina	320/646	25.00
6	8-14	Robert F. & Rita K. Scardina	320/646	72.79
7	8-14	Robert F. & Rita K. Scardina	320/646	72.79
8	8-12	Donna Kathy Johnston	184/133	86.89
9	8-13	Donna Kathy Johnston	184/133	50.00
10	9-1	Dickie L. Morgan	605/478	50.00
11	8-24	Theresa J. Drain	428/607	49.47
12	9-16	D.E. Grimes & Sons Farm, LLC	209/496	118.215
13	8-26	Delbert D. & Betty Ruth Rush	191/125	20.65
14	8-26.1	Donal L. & Joyce J. Rush	230/44	2.345
15	9-12	Betty Ruth Rush	162/25	23.00
16	9-14	Donal Lee & Ronal Wayne Rush	368/825	32.71
17	9-13	Betty Ruth & Delbert Rush	368/825	3.5
18	9-15	Larry M. & Betty L. Jochum; Mark Lee Jochum	391/407	7.301
19	9-15.2	Kimberly J. Williamson, et al	451/715	4.00
20	9-14.1	Ronal Wayne Rush	308/306	2.79
21	9-22	G.R. Meckley Family Trust	OR50/28	43.75
22	9-23	Robert L. Bolner	347/235	61.00
23	9-45	G.R. Meckley Family Trust	OR50/606	26.05
24	9-45.1	G.R. Meckley Family Trust	OR50/606	9.94
25	8-61	G.R. Meckley Family Trust	OR50/28	106.51
26	9-25	Vonlie Cooper	289/103	31.48
27	9-26	Margaret Krynicki, et al	404/293	15.00
28	13-1	G.R. Meckley Family Trust	OR50/28	99.00
29	13-5	G.R. Meckley Family Trust	OR50/28	31.50


FILE NO: 160-54-L-23
DRAWING NO: Ivory 2H As-Drilled
SCALE: 1" = 2000'
MINIMUM DEGREE OF ACCURACY:
Submeter
PROVEN SOURCE OF ELEVATION:
WVDOT, Harrisville, WV

STATE OF WEST VIRGINIA
DEPARTMENT OF ENVIRONMENTAL PROTECTION
OIL AND GAS DIVISION

DATE: July 2 20 25
OPERATOR'S WELL NO. Ivory 2H
API WELL NO
47 - 095 - 02890
STATE COUNTY PERMIT

WELL TYPE: ☐ OIL ☒ GAS ☐ LIQUID INJECTION ☐ WASTE DISPOSAL
(IF GAS) PRODUCTION : ☐ STORAGE ☐ DEEP ☒ SHALLOW
LOCATION: ELEVATION: As-built Elev. 1,091' WATERSHED: Outlet Middle Island Creek QUADRANGLE: Paden City
DISTRICT: Lincoln COUNTY: Tyler
SURFACE OWNER: Neil R. Stebbins ACREAGE: 51.48
ROYALTY OWNER: AMP IV, LP LEASE NO: ACREAGE: 80.37
PROPOSED WORK: ☐ DRILL ☐ CONVERT ☐ DRILL DEEPER ☐ FRACTURE OR STIMULATE ☐ PLUG OFF OLD FORMATION
☐ PERFORATE NEW FORMATION ☒ OTHER PHYSICAL CHANGE IN WELL (SPECIFY) As-Drilled
☐ PLUG AND ABANDON ☐ CLEAN OUT AND REPLUG TARGET FORMATION: Marcellus Shale ESTIMATED DEPTH: 6,370' TVD 17,634' MD

WELL OPERATOR: Antero Resources Corporation DESIGNATED AGENT: Conrad Baston
ADDRESS: 1615 Wynkoop Street ADDRESS: 535 White Oaks Blvd.
Denver, CO 80202 Bridgeport, WV 26330

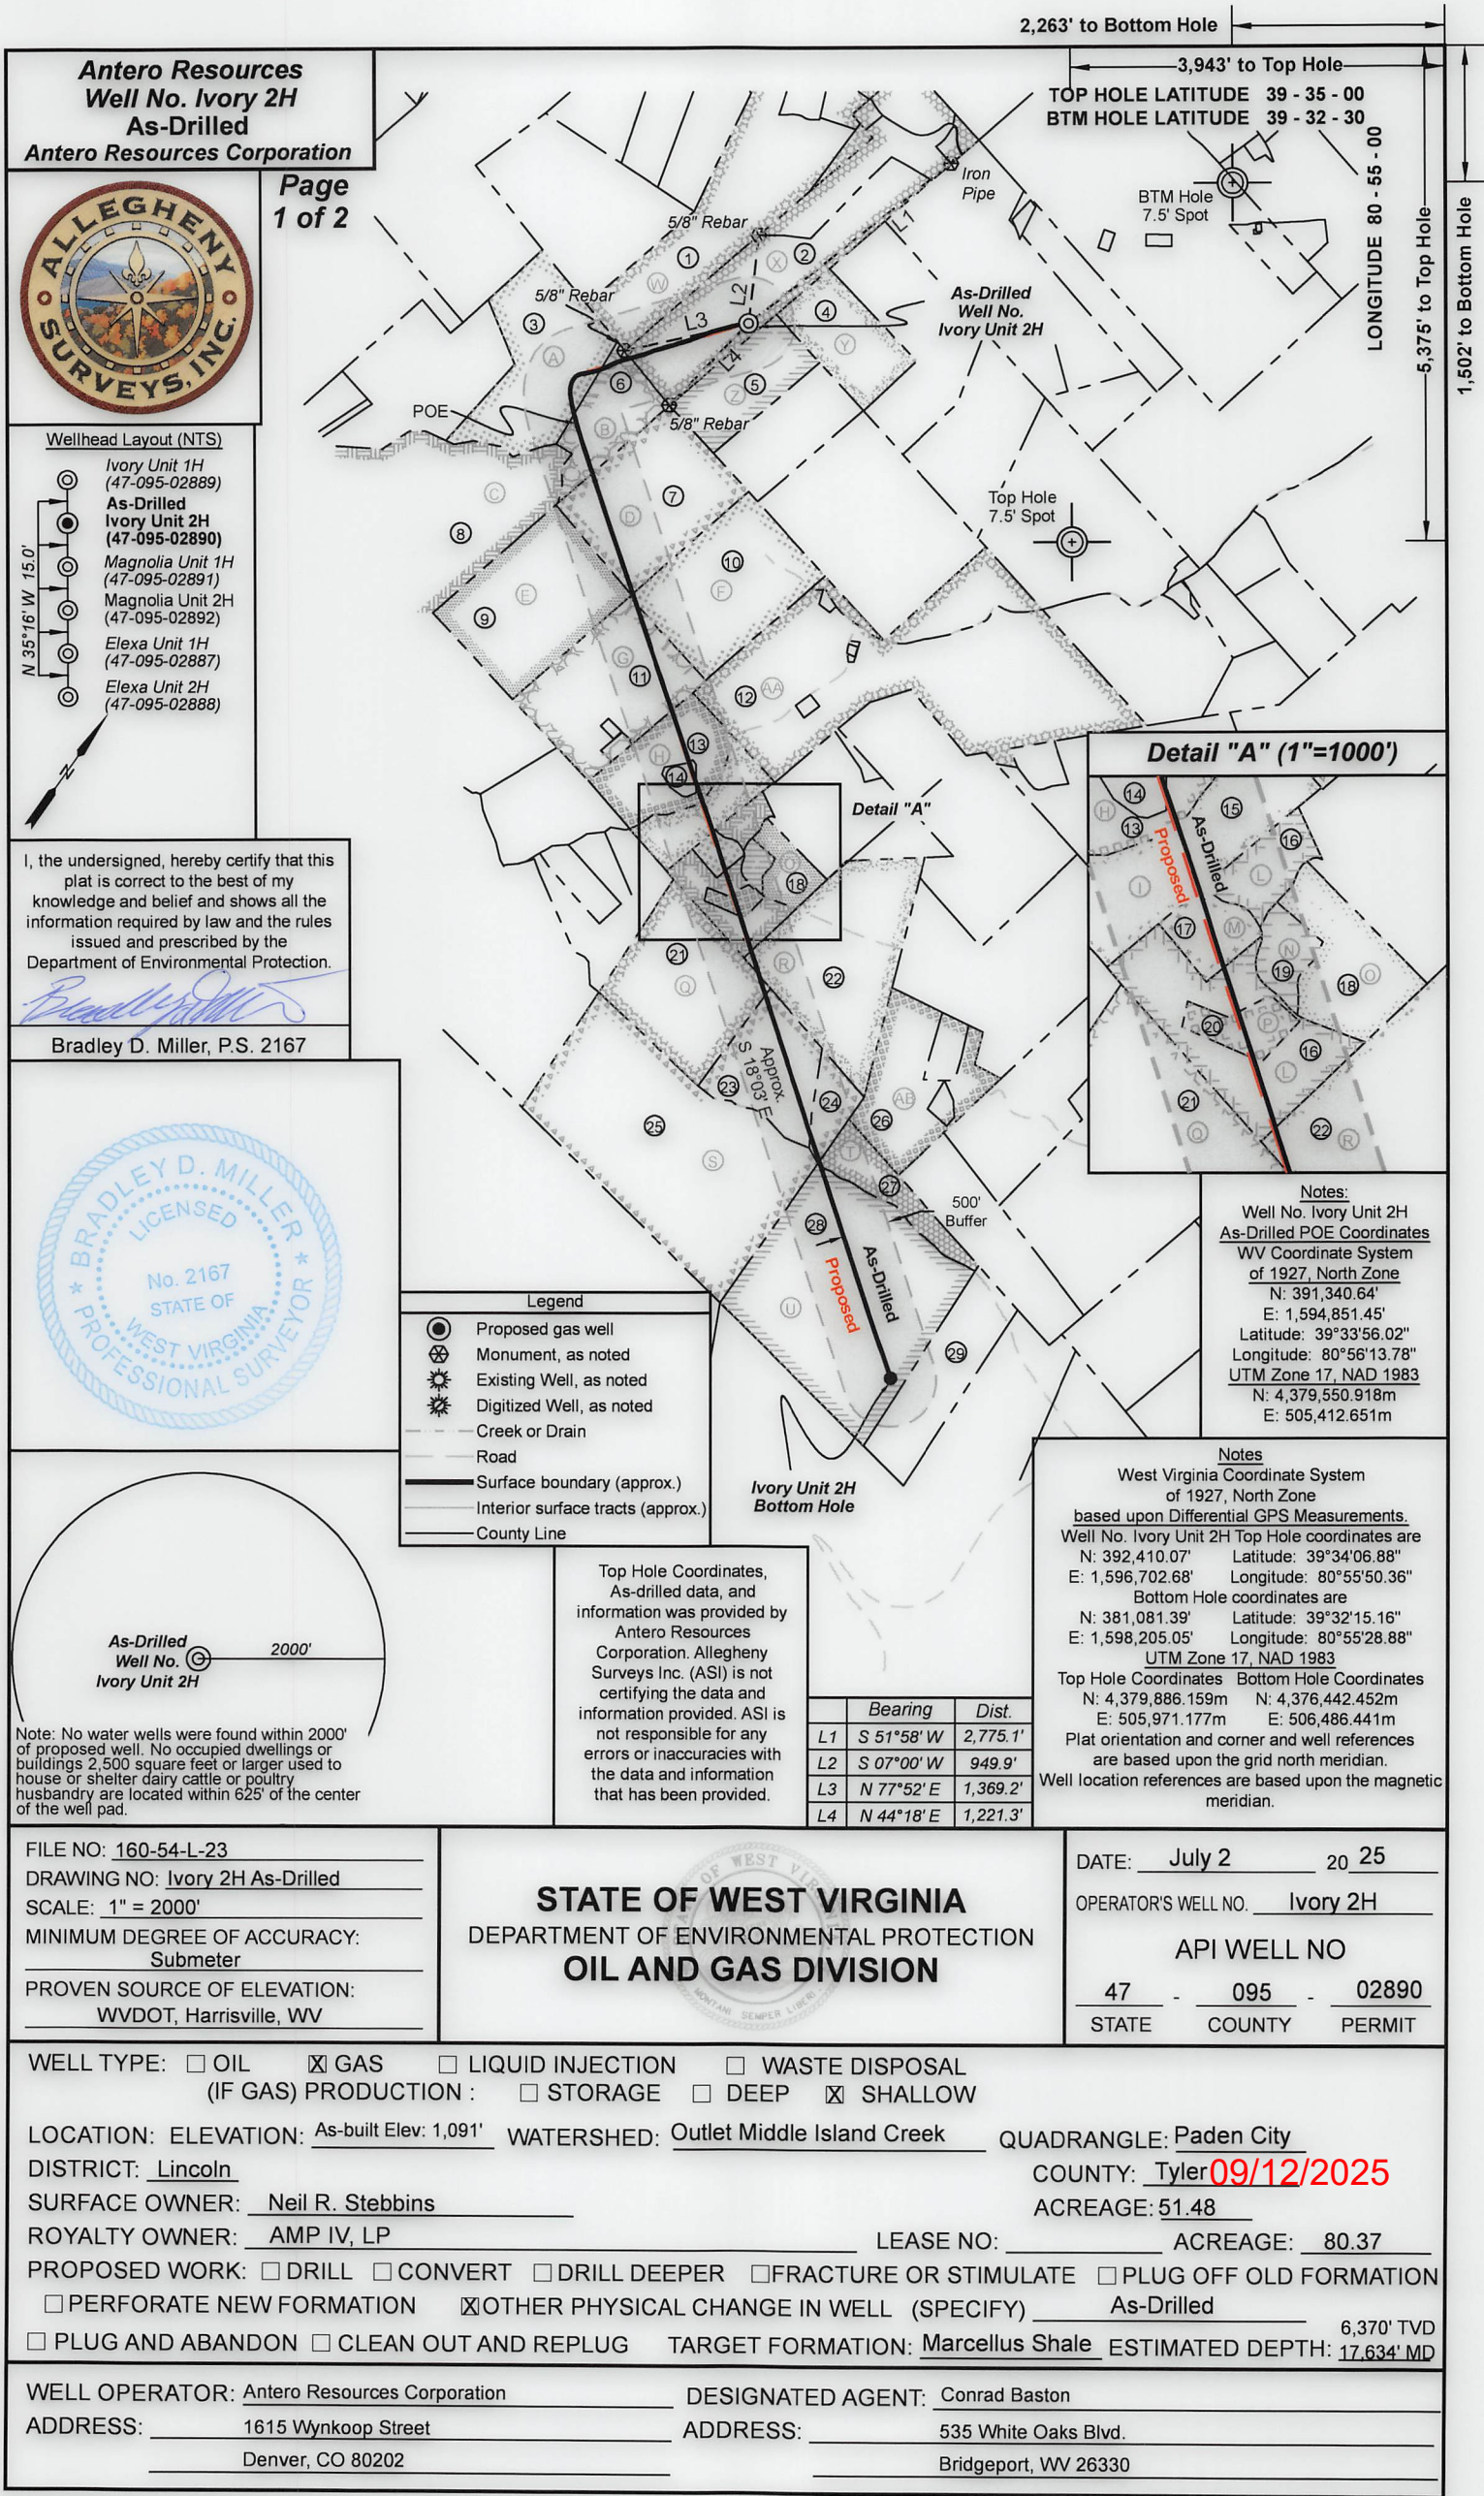



Leases	
A	Moore Self Storage, North Carolina, LLC
B	Robert F. & Rita K. Scardina
C	Evon Heintzman, by Debra K. Spencer as AIF
D	Robert F. & Rita K. Scardina
E	Bounty Minerals, LLC
F	Date Palm Resources, LLC
G	Theresa J. Drain
H	Bounty Minerals, LLC
I	Delbert D. & Betty R. Rush
L	Delbert D. & Betty R. Rush
M	Betty Ruth Rush, et al
N	Kimberly J. Bassett, DSSP
O	Larry M. & Betty L. Jochum, JTWROS
P	Ronal Wayne Rush
Q	Gerald W. Meckley, Jr. et al
R	Robert L. Bolner
S	Arlen Glen Wells, Jr.
T	Frank Krynicki
U	Gerald W. Meckley, Jr. et al
W	Ralph & Stella Judge
X	AMP IV, LP
Y	Robert F. & Rita K. Scardina
Z	Robert F. & Rita K. Scardina
AA	Earl Grimes, et ux
AB	Bounty Minerals, LLC

ID	TM-Par	Owner	Bk/Pg	Acres
1	5-4	Ralph D. & Sophia Judge	306/681	60.77
2	5-9.4	Neil R. Stebbins	366/436	51.48
3	4-91	Donna Kathy Johnston	184/133	54.06
4	5-12	Robert F. & Rita K. Scardina	320/646	25.00
5	5-11	Robert F. & Rita K. Scardina	320/646	25.00
6	8-14	Robert F. & Rita K. Scardina	320/646	72.79
7	8-14	Robert F. & Rita K. Scardina	320/646	72.79
8	8-12	Donna Kathy Johnston	184/133	86.89
9	8-13	Donna Kathy Johnston	184/133	50.00
10	9-1	Dickie L. Morgan	605/478	50.00
11	8-24	Theresa J. Drain	428/607	49.47
12	9-16	D.E. Grimes & Sons Farm, LLC	209/496	118.215
13	8-26	Delbert D. & Betty Ruth Rush	191/125	20.65
14	8-26.1	Donal L. & Joyce J. Rush	230/44	2.345
15	9-12	Betty Ruth Rush	162/25	23.00
16	9-14	Donal Lee & Ronal Wayne Rush	368/825	32.71
17	9-13	Betty Ruth & Delbert Rush	368/825	3.5
18	9-15	Larry M. & Betty L. Jochum; Mark Lee Jochum	391/407	7.301
19	9-15.2	Kimberly J. Williamson, et al	451/715	4.00
20	9-14.1	Ronal Wayne Rush	308/306	2.79
21	9-22	G.R. Meckley Family Trust	OR50/28	43.75
22	9-23	Robert L. Bolner	347/235	61.00
23	9-45	G.R. Meckley Family Trust	OR50/606	26.05
24	9-45.1	G.R. Meckley Family Trust	OR50/606	9.94
25	8-61	G.R. Meckley Family Trust	OR50/28	106.51
26	9-25	Vonlie Cooper	289/103	31.48
27	9-26	Margaret Krynicki, et al	404/293	15.00
28	13-1	G.R. Meckley Family Trust	OR50/28	99.00
29	13-5	G.R. Meckley Family Trust	OR50/28	31.50

FILE NO: 160-54-L-23
DRAWING NO: Ivory 2H As-Drilled
SCALE: 1" = 2000'
MINIMUM DEGREE OF ACCURACY:
Submeter
PROVEN SOURCE OF ELEVATION:
WVDOT, Harrisville, WV

STATE OF WEST VIRGINIA
DEPARTMENT OF ENVIRONMENTAL PROTECTION
OIL AND GAS DIVISION

DATE: July 2 20 25
OPERATOR'S WELL NO. Ivory 2H
API WELL NO
47 - 095 - 02890
STATE COUNTY PERMIT

WELL TYPE: ☐ OIL ☒ GAS ☐ LIQUID INJECTION ☐ WASTE DISPOSAL
(IF GAS) PRODUCTION : ☐ STORAGE ☐ DEEP ☒ SHALLOW
LOCATION: ELEVATION: As-built Elev: 1,091' WATERSHED: Outlet Middle Island Creek QUADRANGLE: Paden City
DISTRICT: Lincoln COUNTY: Tyler
SURFACE OWNER: Neil R. Stebbins ACREAGE: 51.48
ROYALTY OWNER: AMP IV, LP LEASE NO: ACREAGE: 80.37
PROPOSED WORK: ☐ DRILL ☐ CONVERT ☐ DRILL DEEPER ☐ FRACTURE OR STIMULATE ☐ PLUG OFF OLD FORMATION
☐ PERFORATE NEW FORMATION ☒ OTHER PHYSICAL CHANGE IN WELL (SPECIFY) As-Drilled
☐ PLUG AND ABANDON ☐ CLEAN OUT AND REPLUG TARGET FORMATION: Marcellus Shale ESTIMATED DEPTH: 17,634' MD 6,370' TVD

WELL OPERATOR: Antero Resources Corporation DESIGNATED AGENT: Conrad Baston
ADDRESS: 1615 Wynkoop Street ADDRESS: 535 White Oaks Blvd.
Denver, CO 80202 Bridgeport, WV 26330