

Antero Resources
Well No. Jessica 1H
As-Drilled
Antero Resources Corporation




Page
1 of 2


Top Hole Coordinates,
As-drilled data, and
information was provided by
Antero Resources
Corporation. Allegheny
Surveys Inc. (ASI) is not
certifying the data and
information provided. ASI is
not responsible for any
errors or inaccuracies with
the data and information
that has been provided.

I, the undersigned, hereby certify that this
plat is correct to the best of my
knowledge and belief and shows all the
information required by law and the rules
issued and prescribed by the
Department of Environmental Protection.

Bradley D. Miller
Bradley D. Miller, P.S. 2167

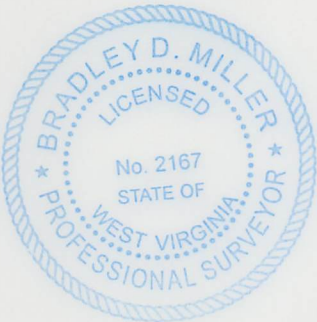

SEAL

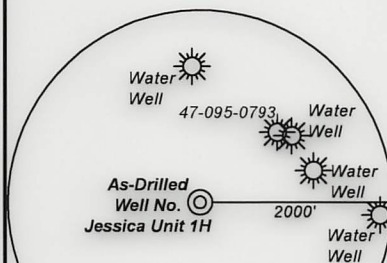

Note: Four water wells were found within 2000'
of proposed well. No occupied dwellings or
buildings 2,500 square feet or larger used to
house or shelter dairy cattle or poultry
husbandry are located within 625' of the center
of the well pad.

	Bearing	Dist.
L1	N 05°52' E	806.0'
L2	N 26°35' W	3,314.9'
L3	S 45°04' E	1,458.4'
L4	N 69°14' E	3,422.4'

FILE NO: 32-54-L-17
DRAWING NO: Jessica Unit 1H As-Drilled
SCALE: 1" = 2000'
MINIMUM DEGREE OF ACCURACY:
Submeter
PROVEN SOURCE OF ELEVATION:
WVDOT, Harrisville, WV

STATE OF WEST VIRGINIA
DEPARTMENT OF ENVIRONMENTAL PROTECTION
OIL AND GAS DIVISION



DATE: July 28 2025
OPERATOR'S WELL NO. Jessica Unit 1H
API WELL NO
47 - 095 - 02899
STATE COUNTY PERMIT

WELL TYPE: ☐ OIL ☒ GAS ☐ LIQUID INJECTION ☐ WASTE DISPOSAL
(IF GAS) PRODUCTION: ☐ STORAGE ☐ DEEP ☒ SHALLOW

LOCATION: ELEVATION: As-Built 1,036' WATERSHED: Outlet Middle Island Creek QUADRANGLE: Paden City
DISTRICT: Lincoln COUNTY: Tyler 09/26/2025
SURFACE OWNER: Antero Resources Corporation ACREAGE: 52.51
ROYALTY OWNER: Raymond B. Heintzman, et ux LEASE NO: ACREAGE: 100
PROPOSED WORK: ☐ DRILL ☐ CONVERT ☐ DRILL DEEPER ☐ FRACTURE OR STIMULATE ☐ PLUG OFF OLD FORMATION
☐ PERFORATE NEW FORMATION ☒ OTHER PHYSICAL CHANGE IN WELL (SPECIFY) As-Drilled 6,247' TVD
☐ PLUG AND ABANDON ☐ CLEAN OUT AND REPLUG TARGET FORMATION: Marcellus Shale ESTIMATED DEPTH: 16,077' MD

WELL OPERATOR: Antero Resources Corporation DESIGNATED AGENT: Conrad Baston
ADDRESS: 1615 Wynkoop Street ADDRESS: 535 White Oaks Blvd.
Denver, CO 80202 Bridgeport, WV 26330

Notes
West Virginia Coordinate System
of 1927, North Zone
based upon Differential GPS Measurements.
Well No. Jessica Unit 1H Top Hole coordinates are
N: 387,335.94' Latitude: 39°33'15.96"
E: 1,591,820.87' Longitude: 80°56'51.65"
Bottom Hole coordinates are
N: 377,643.59' Latitude: 39°31'40.25"
E: 1,592,300.69' Longitude: 80°56'43.53"
UTM Zone 17, NAD 1983
Top Hole Coordinates Bottom Hole Coordinates
N: 4,378,315.418m N: 4,375,365.022m
E: 504,509.708m E: 504,705.111m
Plat orientation and corner and well references
are based upon the grid north meridian.
Well location references are based upon the magnetic
meridian.

Notes:
Well No. Jessica Unit 1H
As-Drilled POE Coordinates
WV Coordinate System
of 1927, North Zone
N: 386,329.12'
E: 1,589,479.19'
Latitude: 39°33'05.64"
Longitude: 80°57'21.33"
UTM Zone 17, NAD 1983
N: 4,377,996.753m
E: 503,801.417m

Wellhead Layout (NTS)
Tennessee Unit 2H
(API# 47-095-02903)
Tennessee Unit 1H
(API# 47-095-02902)
Acadia Unit 2H
(API# 47-095-02898)
Acadia Unit 1H
(API# 47-095-02897)
Jessica Unit 3H
(API# 47-095-02901)
Jessica Unit 2H
(API# 47-095-02900)
As-Drilled
Jessica Unit 1H
(API# 47-095-02899)

Legend
 Proposed gas well
 Monument, as noted
 Existing Well, as noted
 Digitized Well, as noted
--- Creek or Drain
--- Road
--- Surface boundary (approx.)
--- Interior surface tracts (approx.)

Antero Resources
Well No. Jessica 1H
As-Drilled
Antero Resources Corporation



Detail A
(n.t.s.)



ID	TM-Par	Owner	Bk/Pg	Acres
1	8-21.2	Antero Resources Corporation	296/494	35.52
2	8-21	Antero Resources Corporation	296/490	52.51
3	8-19	Olive Branch Animal Rescue	333/804	173.48
4	8-19.1	Hope Gas, Inc.	337/454	0.52
5	8-39	Virginia A. Nalley	190/482	70.65
6	8-38.4	Carl W. Woolwine	636/677	21.32
7	8-54	Virginia A. Nalley	190/482	63.01
8	8-55	Douglas Ray Carson, Jr.	595/111	25.62
9	8-56	Douglas Ray Carson, Jr.	595/111	14.96
10	12-16	Harry H. II & Rebecca A. Huff	230/546	45.11
11	12-17	Lylde S. & Melodee A. Matheny	504/633	36.00
12	12A-8	James O. & Nancy J. McMullen	341/483	0.79
13	12-40.7	Lylde S. & Melodee A. Matheny	535/275	0.08
14	12-18	David E. & Shelley R. Maxwell	307/676	29.04
15	12-40.6	Richard D. & Rachel D. Lewis	535/275	2.39
16	12-40.3	Amelia D. Hubbard	WB29/784	1.25
17	12A-15	Shirley G. Wilson	166/81	1.50
18	12A-14	Andrew M. Weekley	427/536	0.29
19	12-40.4	Andrew M. Weekley	427/536	0.16
20	12A-13	Amerlia D. Hubbard	WB75/343	0.29
21	12-40.1	Amelia D. Hubbard	WB75/343	1.61
22	12-40.5	Amelia D. Hubbard	WB75/343	0.96
23	12-40.2	Andrew M. Weekley	427/536	0.49
24	12-40	David E. Wells	335/133	34.38
25	12-41	Shaun M. & Carrie A. Meckley	633/569	43.28
26	12-53.5	Walter J. West	359/817	29.04
27	12-71.1	James Perry & Melissa Flesher	316/137	63.45
28	12-53.4	Walter J. West	359/817	52.95
29	12-53.8	Daniel J. & Donald E. Regan	372/164	7.80
30	12-53	Walter J. West	359/817	18.33
31	12-53.3	Walter J. West	359/817	9.04
32	12-53.7	John Backel & Mary Beth Tomaselli	321/138	10.01
33	12-53.6	Roller Coaster Resources LLC	259/698	27.26
34	12-52.1	Roller Coaster Resources LLC	259/698	3.45

Leases	
A	Raymond B. Heintzman, et ux
B	Nevin Porter, et al
C	Virginia A. Nalley
D	Victoria Keller, et al
G	The Norma T. Long Trust
H	The Norma T. Long Trust
J	Helen Heintzman, et vir
M	David E. Maxwell, et ux
N	Lylde S. & Melodee A. Matheny
O	Harry H. Huff, II, et ux
P	Richard D. Lewis, et ux
Q	James O. McMullen, et ux
X	Amelia D. Hubbard
Y	Andrew Weekley
Z	Andrew Weekley
AA	Shirley G. Wilson
AJ	David E. Wells, et ux
AM	Roy L. Craig
AN	James Perry & Melissa B. Flesher
AO	Walter J. West
AP	Donald E. Regan
AS	Amelia D. Hubbard

FILE NO: 32-54-L-17
DRAWING NO: Jessica Unit 1H As-Drilled
SCALE: 1" = 2000'
MINIMUM DEGREE OF ACCURACY:
Submeter
PROVEN SOURCE OF ELEVATION:
WVDOT, Harrisville, WV

STATE OF WEST VIRGINIA
DEPARTMENT OF ENVIRONMENTAL PROTECTION
OIL AND GAS DIVISION



DATE: July 28 20 25
OPERATOR'S WELL NO. Jessica Unit 1H
API WELL NO
47 - 095 - 02899
STATE COUNTY PERMIT

WELL TYPE: ☐ OIL ☒ GAS ☐ LIQUID INJECTION ☐ WASTE DISPOSAL
(IF GAS) PRODUCTION: ☐ STORAGE ☐ DEEP ☒ SHALLOW
LOCATION: ELEVATION: As-Built 1,036' WATERSHED: Outlet Middle Island Creek QUADRANGLE: Paden City
DISTRICT: Lincoln COUNTY: Tyler 09/26/2025
SURFACE OWNER: Antero Resources Corporation ACREAGE: 52.51
ROYALTY OWNER: Raymond B. Heintzman, et ux LEASE NO: ACREAGE: 100
PROPOSED WORK: ☐ DRILL ☐ CONVERT ☐ DRILL DEEPER ☐ FRACTURE OR STIMULATE ☐ PLUG OFF OLD FORMATION
☐ PERFORATE NEW FORMATION ☒ OTHER PHYSICAL CHANGE IN WELL (SPECIFY) As-Drilled 6,247' TVD
☐ PLUG AND ABANDON ☐ CLEAN OUT AND REPLUG TARGET FORMATION: Marcellus Shale ESTIMATED DEPTH: 16,077' MD

WELL OPERATOR: Antero Resources Corporation DESIGNATED AGENT: Conrad Baston
ADDRESS: 1615 Wynkoop Street ADDRESS: 535 White Oaks Blvd.
Denver, CO 80202 Bridgeport, WV 26330

Antero Resources
Well No. Jessica 1H
As-Drilled
Antero Resources Corporation



Page
1 of 2


Top Hole Coordinates,
As-drilled data, and
information was provided by
Antero Resources
Corporation. Allegheny
Surveys Inc. (ASI) is not
certifying the data and
information provided. ASI is
not responsible for any
errors or inaccuracies with
the data and information
that has been provided.

I, the undersigned, hereby certify that this
plat is correct to the best of my
knowledge and belief and shows all the
information required by law and the rules
issued and prescribed by the
Department of Environmental Protection.

Bradley D. Miller
Bradley D. Miller, P.S. 2167



SEAL

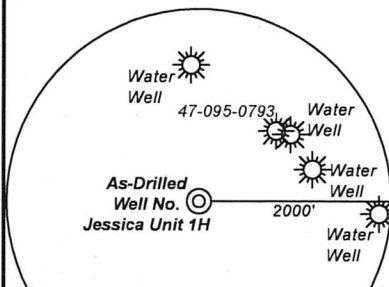

Note: Four water wells were found within 2000'
of proposed well. No occupied dwellings or
buildings 2,500 square feet or larger used to
house or shelter dairy cattle or poultry
husbandry are located within 625' of the center
of the well pad.

	Bearing	Dist.
L1	N 05°52' E	806.0'
L2	N 26°35' W	3,314.9'
L3	S 45°04' E	1,458.4'
L4	N 69°14' E	3,422.4'

FILE NO: 32-54-L-17

DRAWING NO: Jessica Unit 1H As-Drilled

SCALE: 1" = 2000'

MINIMUM DEGREE OF ACCURACY:
Submeter

PROVEN SOURCE OF ELEVATION:
WVDOT, Harrisville, WV

STATE OF WEST VIRGINIA
DEPARTMENT OF ENVIRONMENTAL PROTECTION
OIL AND GAS DIVISION



DATE: July 28 2025

OPERATOR'S WELL NO. Jessica Unit 1H

API WELL NO

47 - 095 - 02899
STATE COUNTY PERMIT

WELL TYPE: ☐ OIL ☒ GAS ☐ LIQUID INJECTION ☐ WASTE DISPOSAL
(IF GAS) PRODUCTION: ☐ STORAGE ☐ DEEP ☒ SHALLOW

LOCATION: ELEVATION: As-Built 1,036' WATERSHED: Outlet Middle Island Creek QUADRANGLE: Paden City
DISTRICT: Lincoln COUNTY: Tyler 09/26/2025

SURFACE OWNER: Antero Resources Corporation

ACREAGE: 52.51

ROYALTY OWNER: Raymond B. Heintzman, et ux

LEASE NO: ACREAGE: 100

PROPOSED WORK: ☐ DRILL ☐ CONVERT ☐ DRILL DEEPER ☐ FRACTURE OR STIMULATE ☐ PLUG OFF OLD FORMATION
☐ PERFORATE NEW FORMATION ☒ OTHER PHYSICAL CHANGE IN WELL (SPECIFY) As-Drilled 6,247' TVD

☐ PLUG AND ABANDON ☐ CLEAN OUT AND REPLUG TARGET FORMATION: Marcellus Shale ESTIMATED DEPTH: 16,077' MD

WELL OPERATOR: Antero Resources Corporation

DESIGNATED AGENT: Conrad Baston

ADDRESS: 1615 Wynkoop Street
Denver, CO 80202

ADDRESS: 535 White Oaks Blvd.
Bridgeport, WV 26330

8,104' to Bottom Hole
8,742' to Top Hole
TOP HOLE LATITUDE 39 - 35 - 00
BTM HOLE LATITUDE 39 - 32 - 30

Notes
West Virginia Coordinate System
of 1927, North Zone
based upon Differential GPS Measurements.
Well No. Jessica Unit 1H Top Hole coordinates are
N: 387,335.94' Latitude: 39°33'15.96"
E: 1,591,820.87' Longitude: 80°56'51.65"
Bottom Hole coordinates are
N: 377,643.59' Latitude: 39°31'40.25"
E: 1,592,300.69' Longitude: 80°56'43.53"
UTM Zone 17, NAD 1983
Top Hole Coordinates Bottom Hole Coordinates
N: 4,378,315.418m N: 4,375,365.022m
E: 504,509.708m E: 504,705.111m
Plat orientation and corner and well references
are based upon the grid north meridian.
Well location references are based upon the magnetic
meridian.

Notes:
Well No. Jessica Unit 1H
As-Drilled POE Coordinates
WV Coordinate System
of 1927, North Zone
N: 386,329.12'
E: 1,589,479.19'
Latitude: 39°33'05.64"
Longitude: 80°57'21.33"
UTM Zone 17, NAD 1983
N: 4,377,996.753m
E: 503,801.417m

RECEIVED
Office of Oil and Gas
JUL 30 2025
WV Department of
Environmental Protection

Wellhead Layout (NTS)
Tennessee Unit 2H
(API# 47-095-02903)
Tennessee Unit 1H
(API# 47-095-02902)
Acadia Unit 2H
(API# 47-095-02898)
Acadia Unit 1H
(API# 47-095-02897)
Jessica Unit 3H
(API# 47-095-02901)
Jessica Unit 2H
(API# 47-095-02900)
As-Drilled
Jessica Unit 1H
(API# 47-095-02899)




Legend

- Proposed gas well
- Monument, as noted
- Existing Well, as noted
- Digitized Well, as noted
- Creek or Drain
- Road
- Surface boundary (approx.)
- Interior surface tracts (approx.)

Antero Resources
Well No. Jessica 1H
As-Drilled
Antero Resources Corporation



Page
2 of 2

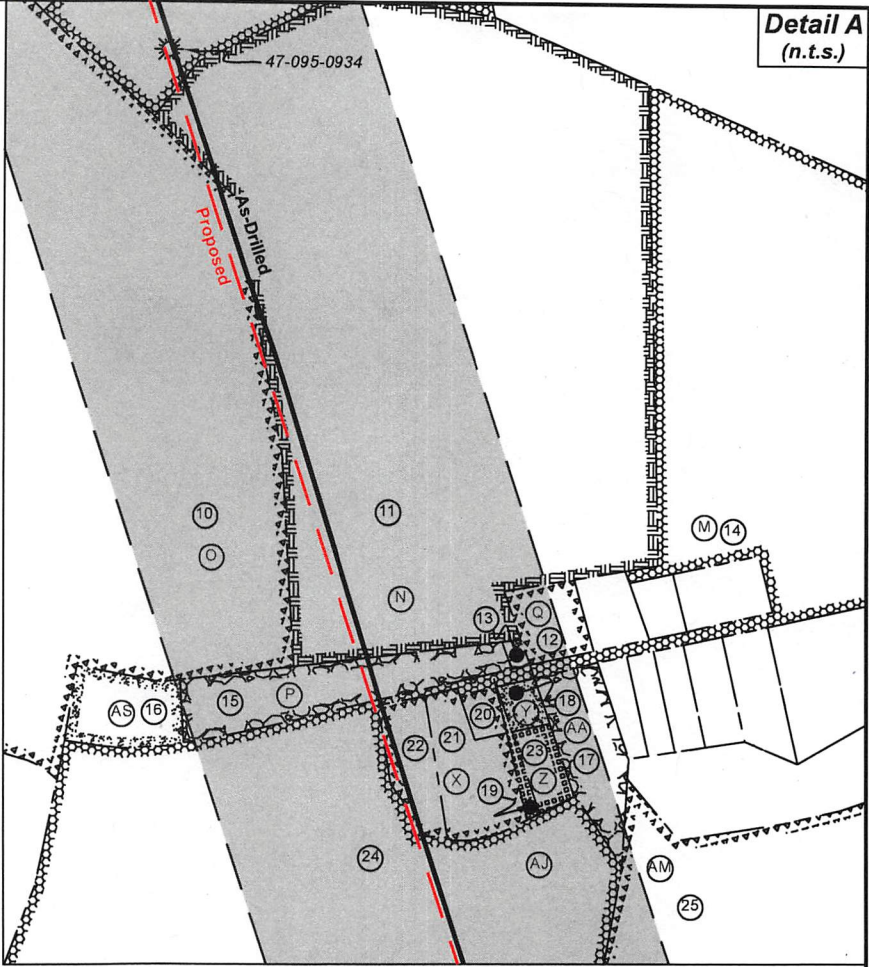

Detail A
(n.t.s.)

ID	TM-Par	Owner	Bk/Pg	Acres
1	8-21.2	Antero Resources Corporation	296/494	35.52
2	8-21	Antero Resources Corporation	296/490	52.51
3	8-19	Olive Branch Animal Rescue	333/804	173.48
4	8-19.1	Hope Gas, Inc.	337/454	0.52
5	8-39	Virginia A. Nalley	190/482	70.65
6	8-38.4	Carl W. Woolwine	636/677	21.32
7	8-54	Virginia A. Nalley	190/482	63.01
8	8-55	Douglas Ray Carson, Jr.	595/111	25.62
9	8-56	Douglas Ray Carson, Jr.	595/111	14.96
10	12-16	Harry H. II & Rebecca A. Huff	230/546	45.11
11	12-17	Lylde S. & Melodee A. Matheny	504/633	36.00
12	12A-8	James O. & Nancy J. McMullen	341/483	0.79
13	12-40.7	Lylde S. & Melodee A. Matheny	535/275	0.08
14	12-18	David E. & Shelley R. Maxwell	307/676	29.04
15	12-40.6	Richard D. & Rachel D. Lewis	535/275	2.39
16	12-40.3	Amelia D. Hubbard	WB29/784	1.25
17	12A-15	Shirley G. Wilson	166/81	1.50
18	12A-14	Andrew M. Weekley	427/536	0.29
19	12-40.4	Andrew M. Weekley	427/536	0.16
20	12A-13	Amerlia D. Hubbard	WB75/343	0.29
21	12-40.1	Amelia D. Hubbard	WB75/343	1.61
22	12-40.5	Amelia D. Hubbard	WB75/343	0.96
23	12-40.2	Andrew M. Weekley	427/536	0.49
24	12-40	David E. Wells	335/133	34.38
25	12-41	Shaun M. & Carrie A. Meckley	633/569	43.28
26	12-53.5	Walter J. West	359/817	29.04
27	12-71.1	James Perry & Melissa Flesher	316/137	63.45
28	12-53.4	Walter J. West	359/817	52.95
29	12-53.8	Daniel J. & Donald E. Regan	372/164	7.80
30	12-53	Walter J. West	359/817	18.33
31	12-53.3	Walter J. West	359/817	9.04
32	12-53.7	John Backel & Mary Beth Tomaselli	321/138	10.01
33	12-53.6	Roller Coaster Resources LLC	259/698	27.26
34	12-52.1	Roller Coaster Resources LLC	259/698	3.45

RECEIVED
Office of Oil and Gas
JUL 30 2025
WV Department of
Environmental Protection

Leases	
A	Raymond B. Heintzman, et ux
B	Nevin Porter, et al
C	Virginia A. Nalley
D	Victoria Keller, et al
G	The Norma T. Long Trust
H	The Norma T. Long Trust
J	Helen Heintzman, et vir
M	David E. Maxwell, et ux
N	Lydie S. & Melodee A. Matheny
O	Harry H. Huff, II, et ux
P	Richard D. Lewis, et ux
Q	James O. McMullen, et ux
X	Amelia D. Hubbard
Y	Andrew Weekley
Z	Andrew Weekley
AA	Shirley G. Wilson
AJ	David E. Wells, et ux
AM	Roy L. Craig
AN	James Perry & Melissa B. Flesher
AO	Walter J. West
AP	Donald E. Regan
AS	Amelia D. Hubbard

FILE NO: 32-54-L-17

DRAWING NO: Jessica Unit 1H As-Drilled

SCALE: 1" = 2000'

MINIMUM DEGREE OF ACCURACY:
Submeter

PROVEN SOURCE OF ELEVATION:
WVDOT, Harrisville, WV

STATE OF WEST VIRGINIA
DEPARTMENT OF ENVIRONMENTAL PROTECTION
OIL AND GAS DIVISION

DATE: July 28 2025

OPERATOR'S WELL NO. Jessica Unit 1H

API WELL NO

47 - 095 - 02899
STATE COUNTY PERMIT

WELL TYPE: ☐ OIL ☒ GAS ☐ LIQUID INJECTION ☐ WASTE DISPOSAL
(IF GAS) PRODUCTION: ☐ STORAGE ☐ DEEP ☒ SHALLOW

LOCATION: ELEVATION: As-Built 1,036' WATERSHED: Outlet Middle Island Creek QUADRANGLE: Paden City

DISTRICT: Lincoln COUNTY: Tyler 09/26/2025

SURFACE OWNER: Antero Resources Corporation ACREAGE: 52.51

ROYALTY OWNER: Raymond B. Heintzman, et ux LEASE NO: ACREAGE: 100

PROPOSED WORK: ☐ DRILL ☐ CONVERT ☐ DRILL DEEPER ☐ FRACTURE OR STIMULATE ☐ PLUG OFF OLD FORMATION

☐ PERFORATE NEW FORMATION ☒ OTHER PHYSICAL CHANGE IN WELL (SPECIFY) As-Drilled 6,247' TVD

☐ PLUG AND ABANDON ☐ CLEAN OUT AND REPLUG TARGET FORMATION: Marcellus Shale ESTIMATED DEPTH: 16,077' MD

WELL OPERATOR: Antero Resources Corporation

DESIGNATED AGENT: Conrad Baston

ADDRESS: 1615 Wynkoop Street

ADDRESS: 535 White Oaks Blvd.

Denver, CO 80202

Bridgeport, WV 26330