


LEGEND

- Proposed gas well
- ⊗ Existing Well, as noted
- ⊗ Digitized Well, as noted



The orientation of this survey is Grid North, and its coordinate base is the West Virginia Coordinate System of 1927, North Zone

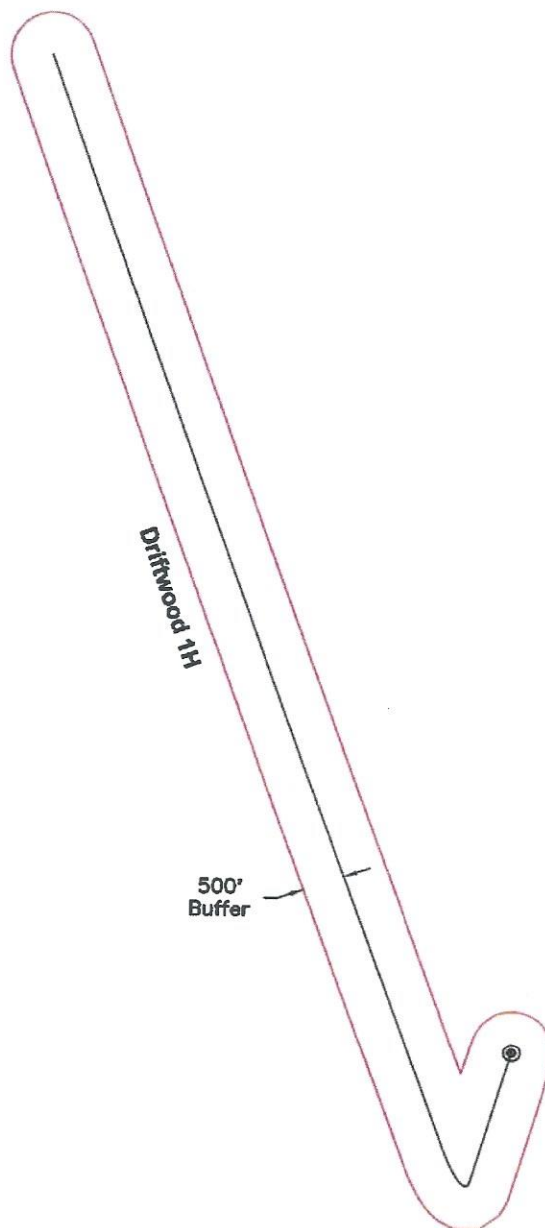

RECEIVED
Office of Oil and Gas

APR 02 2025

WV Department of
Environmental Protection



Bridgeport Office
Phone: (304) 848-5035
Fax: (304) 848-5037

172 Thompson Drive
Bridgeport, WV 26330

PARTY CHIEF: C. Lynch

DRAWN BY: J. McNemar

RESEARCH: J. Miller

PREPARED: March 10, 2025

SURVEYED: Dec. 2016

PROJECT NO: 154-54-L-23

FIELD CREW: C.L., K.M.

Sheet 1 of 1

DRAWING NO: Driftwood 1H AOR



Scale: 1 inch = 2000 feet

04/18/2025

Antero Resources
Well No. Driftwood 1H
BHL_MOD
Antero Resources Corporation


Page 1 of 6

Top Hole
7.5' Spot

7,398' to Top Hole

1,468' to Bottom Hole

TOP LATITUDE 39 - 35 - 00
BTM LATITUDE 39 - 37 - 30

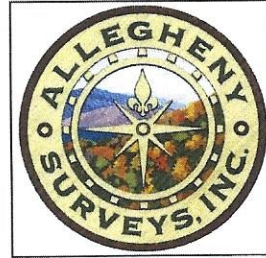



TOP HOLE LONGITUDE 80 - 52 - 30
BTM HOLE LONGITUDE 80 - 55 - 00

814' to Top Hole

Bottom Hole
7.5' Spot


4,416' to Bottom Hole

Well Location References
Not to Scale

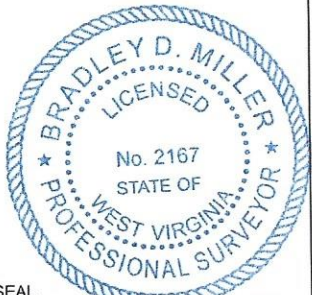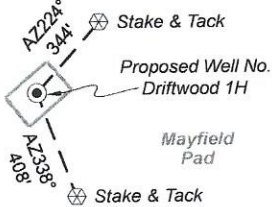

I, the undersigned, hereby certify
that this plat is correct to the best
of my knowledge and belief and
shows all the information required
by law and the rules issued and
prescribed by the Department of
Environmental Protection.

Bradley D. Miller, P.S. 2167

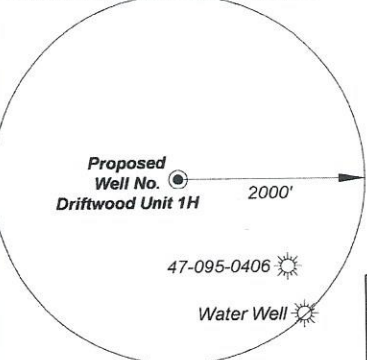

Note: 1 water well were found within 2000'
of proposed well. No occupied dwellings or
buildings 2,500 square feet or larger used
to house or shelter dairy cattle or poultry
husbandry are located within 625' of the
center of the well pad.

Tag	Bearing	Dist.	Monument
L1	N 27°09' W	2,052.9'	Center of bridge
L2	N 50°37' W	1,487.9'	47-095-00406
L3	S 65°58' W	610.5'	Roof bolt on creek bank
L4	S 24°23' E	1,936.6'	5/8" Rebar
L5	S 34°50' W	1,403.1'	Point of Entry (POE)

Wellhead Layout (NTS)

- Gorby Unit 2H (API# 47-095-02910)
- Gorby Unit 1H (API# 47-095-02909)
- Driftwood Unit 2H (API# 47-095-02908)
- Proposed Well Driftwood Unit 1H (API# 47-095-02907)
- Rigby Unit 1H (API# 47-095-02911)



RECEIVED
Office of Oil and Gas
APR 02 2025
Department of
Environmental Protection

STATE OF WEST VIRGINIA
DEPARTMENT OF ENVIRONMENTAL PROTECTION
OIL AND GAS DIVISION

DATE: March 7 20 25
OPERATOR'S WELL NO. Driftwood 1H
API WELL NO
47 - 095 - 02907
STATE COUNTY PERMIT

WELL TYPE: ☐ OIL ☒ GAS ☐ LIQUID INJECTION ☐ WASTE DISPOSAL
(IF GAS) PRODUCTION: ☐ STORAGE ☐ DEEP ☒ SHALLOW

LOCATION: ELEVATION: As-Built: 864' Existing: 874' WATERSHED: Outlet Middle Island Creek

DISTRICT: Lincoln / Magnolia

SURFACE OWNER: Antero Resources Corp.

ROYALTY OWNER: Dennis Swindall & Constance Swindall Trustees for the Swindall Revoable Trust LEASE NO: ACREAGE: 208

PROPOSED WORK: ☐ DRILL ☐ CONVERT ☒ DRILL DEEPER ☒ FRACTURE OR STIMULATE ☐ PLUG OFF OLD FORMATION
☐ PERFORATE NEW FORMATION ☒ OTHER PHYSICAL CHANGE IN WELL (SPECIFY) BHL-MOD 6,600' TVD


☐ PLUG AND ABANDON ☐ CLEAN OUT AND REPLUG TARGET FORMATION: Marcellus Shale ESTIMATED DEPTH: 23,000' MD

WELL OPERATOR: Antero Resources Corporation DESIGNATED AGENT: Conrad Baston
ADDRESS: 1615 Wynkoop Street ADDRESS: 535 White Oaks Blvd.
Denver, CO 80202 Bridgeport, WV 26330


Smr 3/21/25

Antero Resources
Well No. Driftwood 1H
BHL_MOD
Antero Resources Corporation


Page 2 of 6

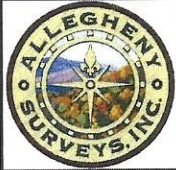



Detail 1 (1"=500')

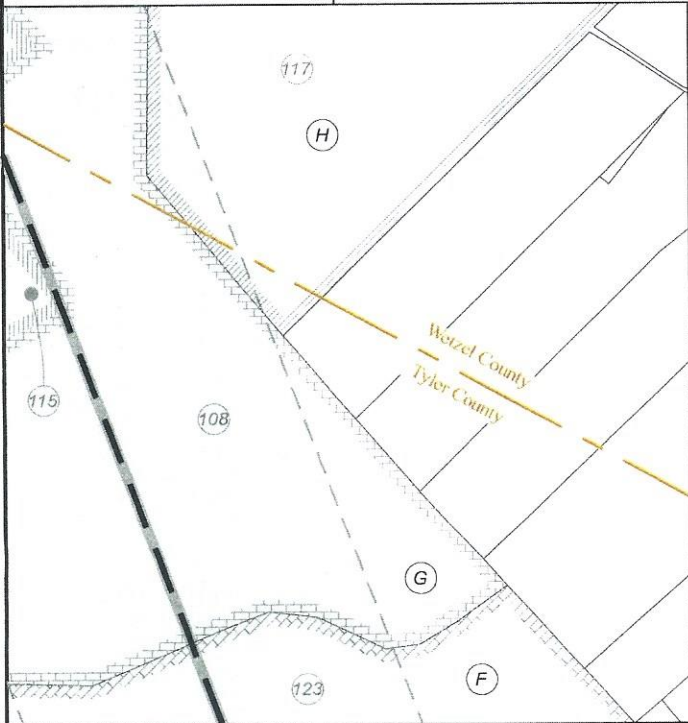

Detail 2 (1"=500')

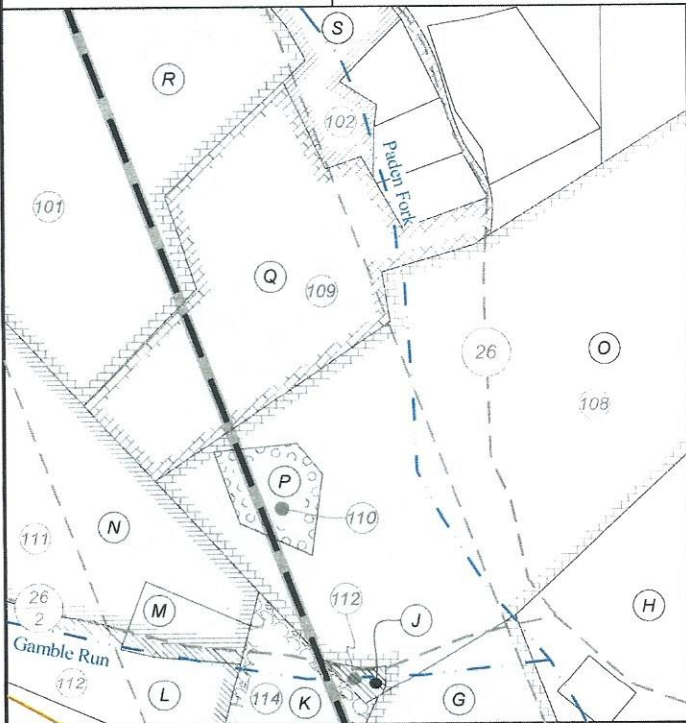

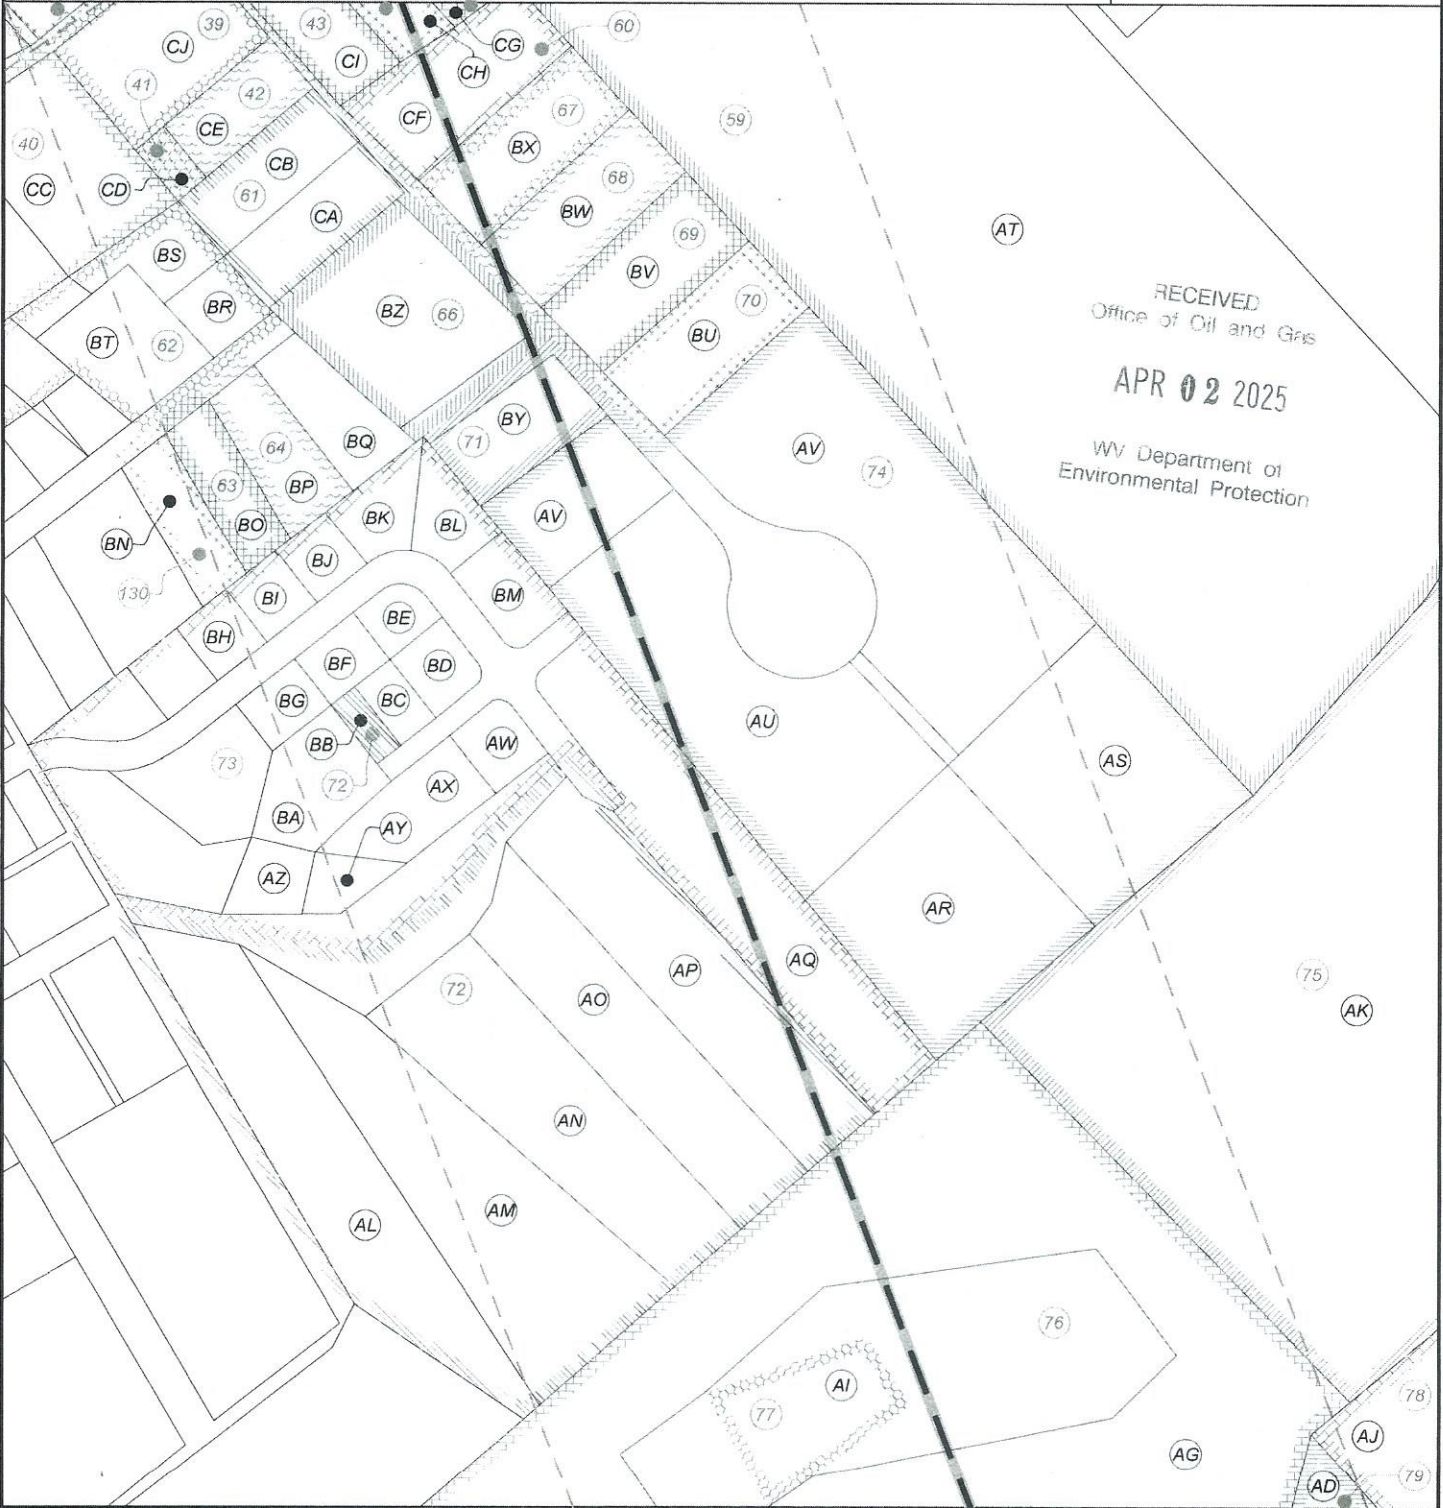Antero Resources Well No. Driftwood 1H BHL_MOD Antero Resources Corporation Page 3 of 6					
Detail 4 (1"=250') 					
FILE NO: 154-54-L-23 DRAWING NO: Driftwood 1H Well Plat SCALE: 1" = 2000' MINIMUM DEGREE OF ACCURACY: Submeter PROVEN SOURCE OF ELEVATION: WVDOT, Harrisville, WV		STATE OF WEST VIRGINIA DEPARTMENT OF ENVIRONMENTAL PROTECTION OIL AND GAS DIVISION		DATE: March 7 20 25 OPERATOR'S WELL NO. Driftwood 1H API WELL NO 47 — 095 — 02907 STATE COUNTY PERMIT	
WELL TYPE: ☐ OIL ☒ GAS ☐ LIQUID INJECTION ☐ WASTE DISPOSAL (IF GAS) PRODUCTION: ☐ STORAGE ☐ DEEP ☒ SHALLOW LOCATION: ELEVATION: As-Built: 864' DISTRICT: Lincoln / Magnolia SURFACE OWNER: Antero Resources Corp. ROYALTY OWNER: Dennis Swindall & Constance Swindall Trustees for the Swindall Revoable Trust LEASE NO: ACREAGE: 208 PROPOSED WORK: ☐ DRILL ☐ CONVERT ☒ DRILL DEEPER ☒ FRACTURE OR STIMULATE ☐ PLUG OFF OLD FORMATION ☐ PERFORATE NEW FORMATION ☒ OTHER PHYSICAL CHANGE IN WELL (SPECIFY) BHL-MOD ☐ PLUG AND ABANDON ☐ CLEAN OUT AND REPLUG TARGET FORMATION: Marcellus Shale ESTIMATED DEPTH: 6,600' TVD 23,000' MD					
WELL OPERATOR: Antero Resources Corporation ADDRESS: 1615 Wynkoop Street Denver, CO 80202		DESIGNATED AGENT: Conrad Baston ADDRESS: 535 White Oaks Blvd. Bridgeport, WV 26330			

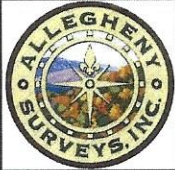


RECEIVED

APR 02 2025

WV Department of
Environmental Protection

Detail 5 (1"=250')

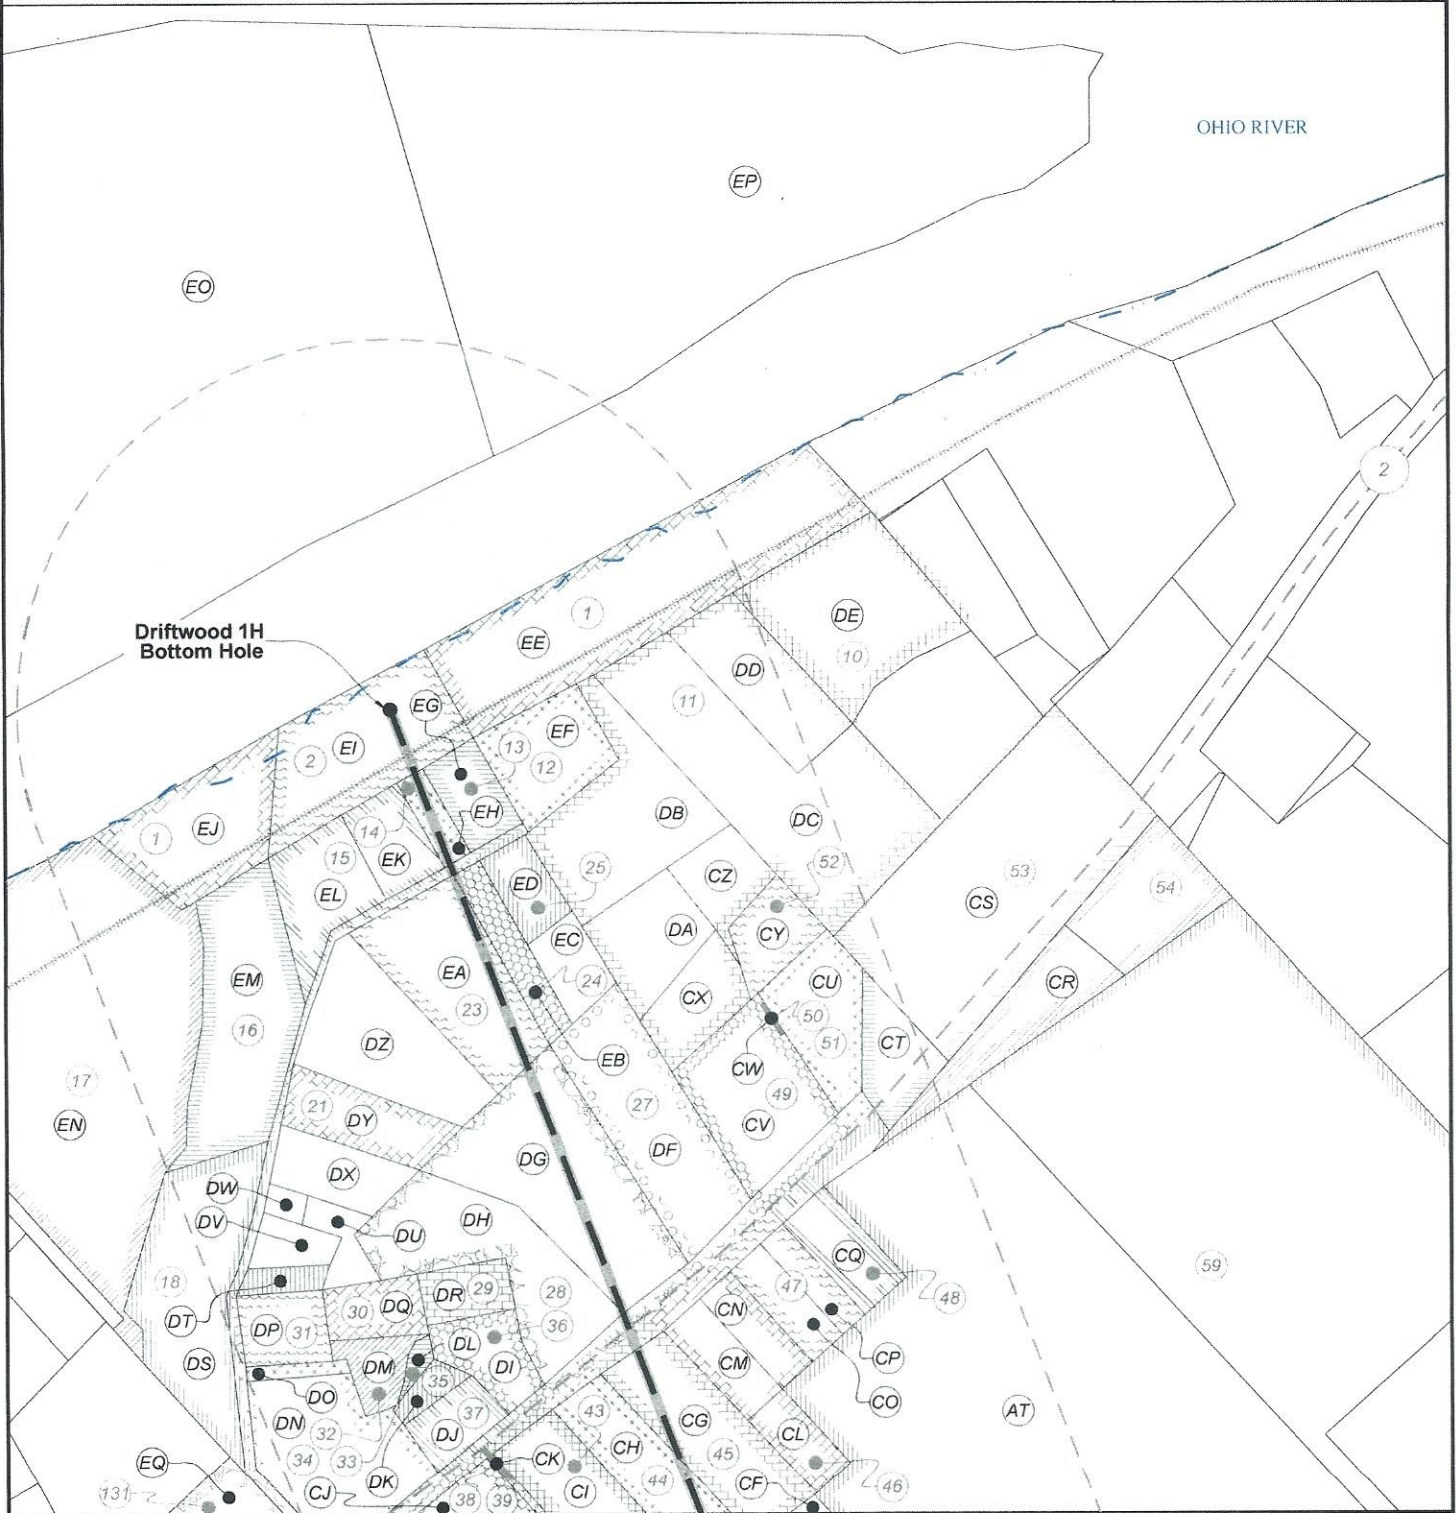

FILE NO: 154-54-L-23

DRAWING NO: Driftwood 1H Well Plat

SCALE: 1" = 2000'

MINIMUM DEGREE OF ACCURACY:
Submeter

PROVEN SOURCE OF ELEVATION:
WVDOT, Harrisville, WV

STATE OF WEST VIRGINIA
DEPARTMENT OF ENVIRONMENTAL PROTECTION
OIL AND GAS DIVISION

DATE: March 7 20 25

OPERATOR'S WELL NO. Driftwood 1H

API WELL NO

47 — 095 — 02907
STATE COUNTY PERMIT

WELL TYPE: ☐ OIL ☒ GAS ☐ LIQUID INJECTION ☐ WASTE DISPOSAL
(IF GAS) PRODUCTION: ☐ STORAGE ☐ DEEP ☒ SHALLOW

LOCATION: ELEVATION: Existing: 874'
As-Built: 864'

WATERSHED: Outlet Middle Island Creek

QUADRANGLE: Paden City

DISTRICT: Lincoln / Magnolia

COUNTY: Tyler / Wetzel

SURFACE OWNER: Antero Resources Corp.

ACREAGE: 208

ROYALTY OWNER: Dennis Swindall & Constance Swindall Trustees for the Swindall Revoable Trust

LEASE NO: ACREAGE: 208

PROPOSED WORK: ☐ DRILL ☐ CONVERT ☒ DRILL DEEPER ☒ FRACTURE OR STIMULATE ☐ PLUG OFF OLD FORMATION
☐ PERFORATE NEW FORMATION ☒ OTHER PHYSICAL CHANGE IN WELL (SPECIFY) BHL-MOD


☐ PLUG AND ABANDON ☐ CLEAN OUT AND REPLUG TARGET FORMATION: Marcellus Shale ESTIMATED DEPTH: 23,000' MD 6,600' TVD

WELL OPERATOR: Antero Resources Corporation

DESIGNATED AGENT: Conrad Baston

ADDRESS: 1615 Wynkoop Street
Denver, CO 80202

ADDRESS: 535 White Oaks Blvd.
Bridgeport, WV 26330

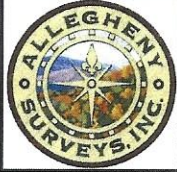

RECEIVED
Office of Oil and Gas

APR 02 2025

WV Department of
Environmental Protection

ID	Lease
1	Kimela Mathews
2	Kimela Mathews
10	Phillip S. Herrick & Karrie M. Herrick
11	Roger L. Kline
12	Kimela Mathews
13	Kimela Mathews
14	Kimela Mathews
15	Gary Cardelein
16	Paul Wissmach Glass Company, Inc.
17	Nathan B. Anderson
18	Dale E. Henthorn Sr. & Sheila I. Henthorn, JTWROS
21	Ronald L. & Brenda S. Wright
23	Kimela Mathews
24	Kimela Mathews
25	Kimela Mathews
27	Ricky C. & Carla F. Riggenschach
28	Paden City Gardens Limited
29	Linda K. Knight
30	Georgia Sue Tennant & Jack M. Tennant
31	Carol Sue Loy
32	Roy Gene McDonnell
33	April D. Clarke
34	Diana Cecil, Life Tenant & Carrie Renee Still
35	April D. Clarke
36	Stone Property Management Group, LLC
37	April D. Clarke
38	Heather L. Tedrow
39	Robin Ann Fox
40	Beth Ann Shreve
41	Beth Ann Shreve
42	Michelle Smith
43	Heather L. Tedrow
44	Stephen Gabriel Pierce & Regina L. Pierce, JTWROS
45	Amy L. Sulsberger & Justin M. Wade
46	Donna Gean Ice
47	David S. Asher
48	Katherine M. Steadman
49	Brian J. & Sherry A. Croasmun
50	Kevin H. & Stacey N. Yoho, JTWROS
51	Kevin H. & Stacey N. Yoho, JTWROS
52	Kevin H. & Stacey N. Yoho, JTWROS
53	Linda L. Forrester
54	Jesse D. & Betty Lou Danielson, JTWROS
59	Patterson, LLC
60	Peggy A. Beckett
61	Danny R. Anderson

ID	Lease
62	Robert L. Jones Jr. & Donna K. Jones, JTWROS
63	Richard K. Long II
64	Marvin Williams & Bonnie Williams, JTWROS
66	Brenda Sue Palmer
67	Frank G. Knight & Connie E. Knight
68	Danny K. Carney & Stacey L. Carney
69	Bryon D. Hatfield
70	Jeffery R. Stackpole & Susan L. Stackpole, JTWROS
71	Brenda Sue Palmer
72	Branson Lee Corcoran
73	Elk Range Royalties II, LP
74	Anthony R. & Toni L. Glover
75	Mineral Acquisition Company, I, LP
76	Mineral Acquisition Company, I, LP
77	Pamela Sue Billeter
78	Alexander Brast Thomas & Carol Thomas Revocable Trust
79	Shirley M. Blatt
80	Glenn W. Tarbett, et ux
91	Paul S. Cunningham
94	Adam R. & Renee L. Pennell, JTWROS
95	Adam R. & Renee L. Pennell, JTWROS
96	Michael Stracher
97	Ronald F. Billeter
98	Ronald F. Billeter
99	Carol S. Cunningham
100	Gracie Viola Richard
101	John Ventemiglia
102	Trustees of Paden Fork Chapel Christian Church Lease
108	Lawrence Grayson Walker III, et ux
109	Brandon P. Mason & Katie Elizabeth Amos
110	Linda Allen
111	Ralph Job Howell Trust
112	Clinton Leasure
114	Clinton Levi Leasure
115	Lawrence Grayson Walker III & Amelia Ann Walker
117	Billy K. Goddard
123	Lawrence Grayson Walker III et ux
124	Ridgetop Capital II, LP
126	Dennis Swindall & Constance L. Swindall, Trustees for the Swindall Revocable Trust
127	Cynthia M. Oldham
128	Cynthia M. Oldham
129	Susan D. Paden
130	Markus E. & Ruth E. Derby
131	Christopher A. Jackson, et ux

FILE NO: 154-54-L-23

DRAWING NO: Driftwood 1H Well Plat

SCALE: 1" = 2000'

MINIMUM DEGREE OF ACCURACY:
Submeter

PROVEN SOURCE OF ELEVATION:
WVDOT, Harrisville, WV

STATE OF WEST VIRGINIA
DEPARTMENT OF ENVIRONMENTAL PROTECTION
OIL AND GAS DIVISION

DATE: March 7 20 25

OPERATOR'S WELL NO. Driftwood 1H

API WELL NO

47 — 095 — 02907
STATE COUNTY PERMIT

WELL TYPE: ☐ OIL ☒ GAS ☐ LIQUID INJECTION ☐ WASTE DISPOSAL
(IF GAS) PRODUCTION: ☐ STORAGE ☐ DEEP ☒ SHALLOW

LOCATION: ELEVATION: As-Built: 864'
Existing: 874'

WATERSHED: Outlet Middle Island Creek

QUADRANGLE: Paden City

DISTRICT: Lincoln / Magnolia

COUNTY: Tyler / Wetzel

SURFACE OWNER: Antero Resources Corp.

ACREAGE: 04/18/2025

ROYALTY OWNER: Dennis Swindall & Constance Swindall Trustees for the Swindall Revoable Trust

LEASE NO: ACREAGE: 208

PROPOSED WORK: ☐ DRILL ☐ CONVERT ☒ DRILL DEEPER ☒ FRACTURE OR STIMULATE ☐ PLUG OFF OLD FORMATION
☐ PERFORATE NEW FORMATION ☒ OTHER PHYSICAL CHANGE IN WELL (SPECIFY) BHL-MOD


☐ PLUG AND ABANDON ☐ CLEAN OUT AND REPLUG TARGET FORMATION: Marcellus Shale ESTIMATED DEPTH: 6,600' TVD
23,000' MD

WELL OPERATOR: Antero Resources Corporation

DESIGNATED AGENT: Conrad Baston

ADDRESS: 1615 Wynkoop Street
Denver, CO 80202

ADDRESS: 535 White Oaks Blvd.
Bridgeport, WV 26330

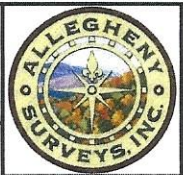

RECEIVED
Office of Oil and Gas
APR 02 2025
WV Department of Environmental Protection

Tyler County				
No.	TM / Par	Owner	Bk / Pg	Ac.
A	5 / 63.1	Antero Resources Corp.	OR299 / 308	60.96
B	5 / 63	James D. Kimble	W35 / 174	94.23
C	5 / 60	Suasn D. Paden, et al	W26 / 586	36.79
D	5 / 26	Robert L. & Cynthia M. Oldham	OR23 / 300	36.79
E	5 / 64	Wesley Shriver	490 / 758	80.38
F	5 / 65	Russell E. Hussey, et al	OR247 / 747	82.25
Wetzel County				
No.	TM / Par	Owner	Bk / Pg	Ac.
G	16 / 46	Russell E. Hussey, et al	503 / 481	131.04
H	16 / 31	Billy K. Goddard	277 / 286	72.50
I	16 / 47	Evans Cemetery	xxx / xxx	0.77
J	16 / 25.1	Clinton Leasure	428 / 155	0.23
K	16 / 45	Clinton Leasure	428 / 155	5.00
L	16 / 44	Clinton Leasure	428 / 155	5.32
M	16 / 16.1	Ralph Job Howell Trust	423 / 367	1.10
N	16 / 16	Ralph Job Howell Trust	421 / 33	37.52
O	16 / 25	Billy K. & Carolyn S. Goddard	502 / 370	32.57
P	16 / 30	Kendle Cemetery	PB1 / 116	1.00
Q	16 / 24	Brandon P. Mason, et al	420 / 315	12.51
R	16 / 17	John & Rebecca S. Weekly	358 / 425	21.13
S	16 / 19	Paden Fork Christian Chapel	286 / 414	2.75
T	16 / 17.1	John & Rebecca S. Weekly	358 / 425	1.87
U	16 / 18	John & Rebecca S. Weekly	358 / 425	0.50
V	16 / 2	Ronald Billiter	288 / 288	34.82
W	16 / 17.2	Donald E. Richard	331 / 8	0.19
X	16 / 73	Ronald Billiter	288 / 288	2.11
Y	16 / 4	Evelyn M. Cross	242 / 252	12.26
Z	16 / 77	Michael Starcher	445 / 156	1.52
AA	16 / 73	Adam R. & Renee L. Pennell	411 / 981	1.00
AB	11 / 83.5	Matthew J. & Carla R. Hudson	405 / 1	5.70
AC	16 / 76	Adam R. & Renee L. Pennell	439 / 153	2.11
AD	11 / 83	Donald Blatt, et al	288 / 499	29.45
AE	11 / 83.4	Glen W. & Carolyn A. Tarbett	300 / 478	3.47
AF	10 / 65.4	John M. & Vicky L. Myers	481 / 815	4.78
AG	10 / 65	Teresa K. Goots	501 / 764	34.89
AH	10 / 65.1	Teresa K. Goots	501 / 764	2.49
AI	10 / 65.2	Pamela S. & Jerry S. Billeter	458 / 358	3.53
AJ	11 / 84.4	Carl Sweeny	388 / 312	30.73
AK	11 / 67	Carl L. Sweeny, et al	452 / 681	27.50
AL	5 / 29	Brandon L. Corcoran	488 / 237	2.78
AM	5 / 28	Brandon L. Corcoran	488 / 237	2.76
AN	5 / 27	Robert J. Gibbs, et ux	450 / 302	1.67
AO	5 / 26	Robert J. Gibbs, et ux	450 / 302	1.64
AP	5 / 25	Robert J. Gibbs, et ux	450 / 302	1.87
AQ	5 / 24	Robert J. Gibbs, et ux	428 / 820	1.86
AR	10 / 75.1	Anthony R. & Toni L. Glover	388 / 239	1.90
AS	10 / 75	Anthony R. & Toni L. Glover	421 / 698	1.80
AT	11 / 62	TW Enterprises	465 / 115	20.11
AU	10 / 70.1	Anthony R. & Toni L. Glover	388 / 239	2.50
AV	10 / 70	Anthony R. & Toni L. Glover	421 / 698	3.22
AW	5 / 20	Aaron Ramsey	459 / 569	0.24
AX	5 / 19	Brent A. Smith	423 / 978	0.42
AY	5 / 18	Brandon L. Corcoran	488 / 237	0.15
AZ	5 / 17	Brandon L. Corcoran	488 / 237	0.17
BA	5 / 16	Brandon L. Corcoran	488 / 237	0.49
BB	5 / 15	Brandon L. Corcoran	488 / 237	0.09
BC	5 / 15.1	Michael A. Smith	359 / 367	0.14
BD	5 / 14	Michael A. Smith, et al	355 / 290	0.21
BE	5 / 13	David & Kelly Schultheis	378 / 391	0.18
BF	5 / 12	Mark A. & Robyn A. Durant	410 / 599	0.18
BG	5 / 11	Jennifer J. Latimer	441 / 105	0.18
BH	5 / 3	Crystal L. Ebert, et al	453 / 86	0.18
BI	5 / 4	Kyra D. Slampak	479 / 866	0.18
BJ	5 / 5	Donna J. Giles	386 / 366	0.18
BK	5 / 6	Donna J. Giles	386 / 366	0.32
BL	5 / 7	Donna J. Giles	386 / 366	0.32
BM	5 / 8	Terrell E. & Judith M. Yeager	289 / 181	0.29
BN	10A / 22	Markus E. & Ruth E. Derby	357 / 238	0.37
BO	10A / 23	Christopher G. Potoczny	514 / 479	0.38
BP	10A / 30	Christopher G. Potoczny	514 / 479	0.45

Wetzel County				
No.	TM / Par	Owner	Bk / Pg	Ac.
BR	10A / 31	Erica L. Doll	455 / 891	0.44
BS	10A / 29.1	Donna K. & Robert L. Jones	322 / 478	0.23
BT	10A / 29	Donna K. & Robert L. Jones	311 / 516	0.29
BU	10A / 28.1	Donna K. & Robert L. Jones	302 / 432	0.59
BV	10 / 69	Jeffery R. & Susan L. Stackpole	431 / 745	0.73
BW	10 / 68	Bryon D. Hatfield	489 / 322	0.75
BX	10 / 67	Danny K. & Stacy L. Carney	340 / 451	0.76
BY	10 / 66	Frank G. & Connie Knight	291 / 117	0.75
BZ	10 / 81	Brenda S. Palmer	467 / 925	0.54
CA	10 / 82	Brenda S. Palmer	467 / 925	1.24
CB	10 / 49.1	Andrew J. Stevens	508 / 316	0.50
CC	10 / 49.4	Andrew J. Stevens	508 / 316	0.50
CD	10 / 41	Beth A. Shreve	355 / 212	1.08
CE	10 / 49.5	Beth A. Shreve	383 / 518	0.10
CF	10 / 49.7	Michelle Smith	513 / 341	0.38
CG	10 / 49.2	Peggy Beckett	220 / 56	0.84
CH	10 / 44	Amy L. Sulsberger, et al	466 / 927	0.69
CI	10 / 43	Stephen G. & Regina Pierce	418 / 551	0.55
CJ	10 / 42	Heather L. Caruth	428 / 300	0.69
CK	10 / 49	Robin A. Fox	323 / 75	0.86
CL	10 / 49.6	Heather L. Caruth	428 / 300	0.01
CM	10 / 49.3	Donna G. Ice	325 / 233	0.20
CN	10 / 45	Donna G. Ice	325 / 233	0.25
CO	10 / 46	Donna G. Ice	325 / 233	0.21
CP	10 / 46.1	David S. Asher	444 / 398	0.19
CQ	10 / 46.2	David S. Asher	444 / 398	0.15
CR	10 / 47	Katherine M. Toothman	361 / 495	0.28
CS	10 / 47.1	Jesse D. & Betty L. Danielson	421 / 36	0.31
CT	11 / 47	Jason E. & Bernadette Hood	494 / 690	1.50
CU	10B / 39	Jason E. & Bernadette Hood	494 / 690	0.14
CV	10B / 32.1	Kevin N. & Stacey N. Yoho	422 / 606	0.47
CW	10B / 32.7	Brian J. & Sherry A. Croasmun	347 / 576	0.77
CX	10B / 32.5	Kevin N. & Stacey N. Yoho	422 / 606	0.01
CY	10B / 32.6	Karen Burkhardt, et al	379 / 203	0.33
CZ	10B / 32.8	Kevin N. & Stacey N. Yoho	422 / 606	0.26
DA	10B / 32.2	Roger L. Kline	371 / 370	0.25
DB	10B / 32.3	Roger L. Kline	422 / 358	0.44
DC	10B / 32	Roger L. Kline	336 / 377	0.91
DD	10B / 33.1	Roger L. Kline	329 / 44	1.56
DE	10B / 33	Roger L. Kline	329 / 44	0.58
DF	10B / 34.1	Phillip S. & Karen M. Herrick	331 / 529	1.00
DG	10B / 38	Ricky C. & Carla F. Rigenbach	482 / 458	1.00
DH	3A / 9	Paden City Gardens, LP	315 / 366	1.21
DI	3A / 8	Paden City Gardens, LP	336 / 627	0.92
DJ	3A / 6.1	Stone Property Management Group, LLC.	488 / 539	0.28
DK	3A / 6	April Stackpole	514 / 236	0.20
DL	3A / 6.2	April D. Clarke	369 / 501	0.09
DM	3A / 4.1	April D. Clarke	401 / 442	0.04
DN	3A / 4	Roy G. McDonald, et al	W58 / 90	0.22
DO	3A / 2	Carrie R. Still	424 / 161	0.61
DP	3A / 3	Carrie R. Still	424 / 161	0.18
DQ	10B / 22	Patricia Ruth Loy Estate, et al	W20 / 494	0.25
DR	3A / 5	Jack M. & Georgia S. Tennant	313 / 637	0.23
DS	3A / 7	Linda K. & Robert G. Knight	304 / 227	0.19
DT	10B / 18	Sheila I. & Dale E. Henthorn, Sr.	373 / 386	1.00
DU	10B / 24	Sheila I. & Dale E. Henthorn, Sr.	373 / 386	0.10
DV	10B / 25	William E. Jacobs, Jr.	476 / 581	0.17
DW	10B / 26	William E. Jacobs, Jr.	476 / 581	0.15
DX	10B / 27	William E. Jacobs, Jr.	469 / 842	0.05
DY	10B / 28	William E. Jacobs, Jr.	469 / 842	0.33
DZ	10B / 28.1	Ronald L. & Brenda S. Wright	441 / 180	0.40
EA	10B / 29	Eric D. & Amy P. Weber	374 / 78	0.78
EB	10B / 13	Kimela A. Mathews	476 / 97	0.80
EC	10B / 31.2	Kimela A. Mathews	417 / 115	0.23
ED	10B / 31.3	Merry A. Westbrooks (L/E), et al	438 / 294	0.18
EE	10B / 31	Kimela A. Mathews	436 / 150	0.20
EF	10B / 3	Kimela A. Mathews	475 / 394	2.50
EG	10B / 14	F.E. Schamp, et al	427 / 314	0.36
EH	10B / 31.1	Kimela A. Mathews	348 / 9	0.24
EI	10B / 31.4	Kimela A. Mathews	348 / 9	0.11
EJ	10B / 13.3	Kimela A. Mathews	475 / 394	0.40
EK	10B / 4	Kimela A. Mathews	475 / 394	0.25
EL	10B / 13.1	Gary & Phillip Cardelein	466 / 492	0.26
EM	10B / 13.2	Gary & Phillip Cardelein	466 / 492	0.26
EN	10B / 12	Paul Wissmach Glass Co.	333 / 342	1.05
EO	10B / 11	Nathan B. Anderson	433 / 329	3.83
EP	10 / 1	United States of America	333 / 690	75.00
EQ	10 / 1.1	United States of America	256 / 227	5.13
ER	3A / 1	Terrell L. Paden	329 / 492	1.40

FILE NO: 154-54-L-23	DATE: March 7 20 25
DRAWING NO: Driftwood 1H Well Plat	OPERATOR'S WELL NO. Driftwood 1H
SCALE: 1" = 2000'	API WELL NO
MINIMUM DEGREE OF ACCURACY: Submeter	47 — 095 — 02907
PROVEN SOURCE OF ELEVATION: WVDOT, Harrisville, WV	STATE COUNTY PERMIT
STATE OF WEST VIRGINIA DEPARTMENT OF ENVIRONMENTAL PROTECTION OIL AND GAS DIVISION	
WELL TYPE: ☐ OIL ☒ GAS ☐ LIQUID INJECTION ☐ WASTE DISPOSAL (IF GAS) PRODUCTION: ☐ STORAGE ☐ DEEP ☒ SHALLOW	
LOCATION: ELEVATION: As-Built: 864' Existing: 874'	WATERSHED: Outlet Middle Island Creek
DISTRICT: Lincoln / Magnolia	QUADRANGLE: Paden City
SURFACE OWNER: Antero Resources Corp.	COUNTY: Tyler / Wetzel
ROYALTY OWNER: Dennis Swindall & Constance Swindall Trustees for the Swindall Revoable Trust	ACREAGE: 60.96
PROPOSED WORK: ☐ DRILL ☐ CONVERT ☒ DRILL DEEPER ☒ FRACTURE OR STIMULATE ☐ PLUG OFF OLD FORMATION	LEASE NO: ACREAGE: 208
☐ PERFORATE NEW FORMATION ☒ OTHER PHYSICAL CHANGE IN WELL (SPECIFY) BHL-MOD	ESTIMATED DEPTH: 6,600' TVD
☐ PLUG AND ABANDON ☐ CLEAN OUT AND REPLUG TARGET FORMATION: Marcellus Shale	ESTIMATED DEPTH: 23,000' MD
WELL OPERATOR: Antero Resources Corporation	DESIGNATED AGENT: Conrad Baston
ADDRESS: 1615 Wynkoop Street	ADDRESS: 535 White Oaks Blvd.
Denver, CO 80202	Bridgeport, WV 26330