

LEGEND

- Proposed gas well
- Existing Well, as noted
- Digitized Well, as noted




The orientation of this survey is Grid North, and its coordinate base is the West Virginia Coordinate System of 1927, North Zone

RECEIVED
Office of Oil and Gas

JUN 26 2025

WV Department of
Environmental Protection

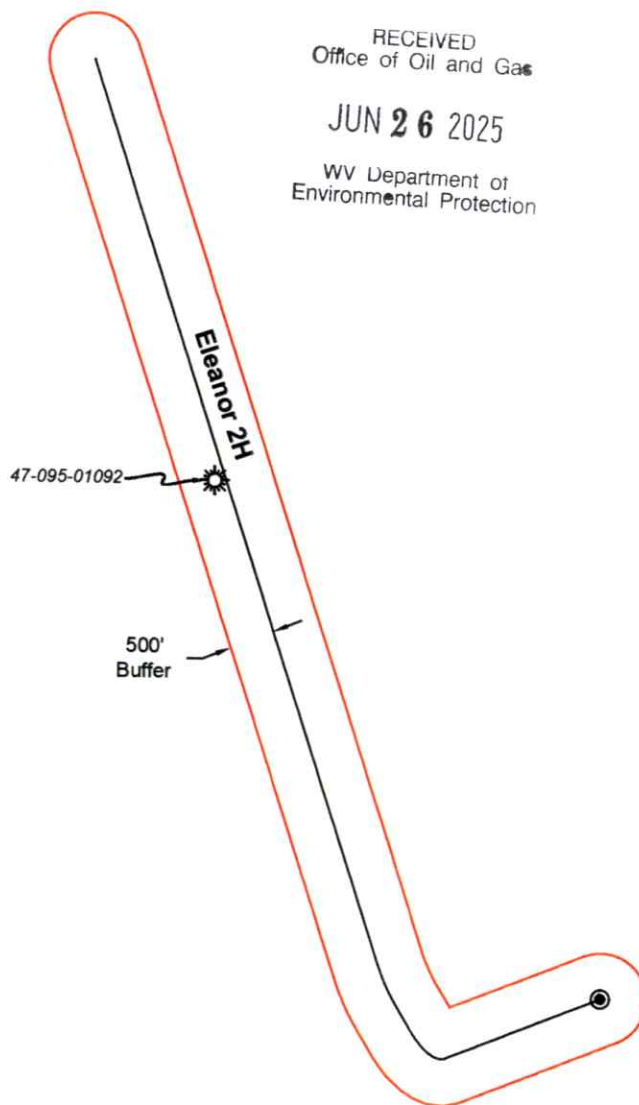

Bridgeport Office
Phone: (304) 848-5035
Fax: (304) 848-5037

172 Thompson Drive
Bridgeport, WV 26330



PARTY CHIEF: C. Lynch

DRAWN BY: C. Robinson

RESEARCH: J. Miller

PREPARED: June 13, 2025

SURVEYED: Dec. 2016

PROJECT NO: 157-54-L-23

FIELD CREW: C.L., K.M.


Sheet 1 of 1

DRAWING NO: Eleanor 2H AOR



Scale: 1 inch = 2000 feet

07/04/2025

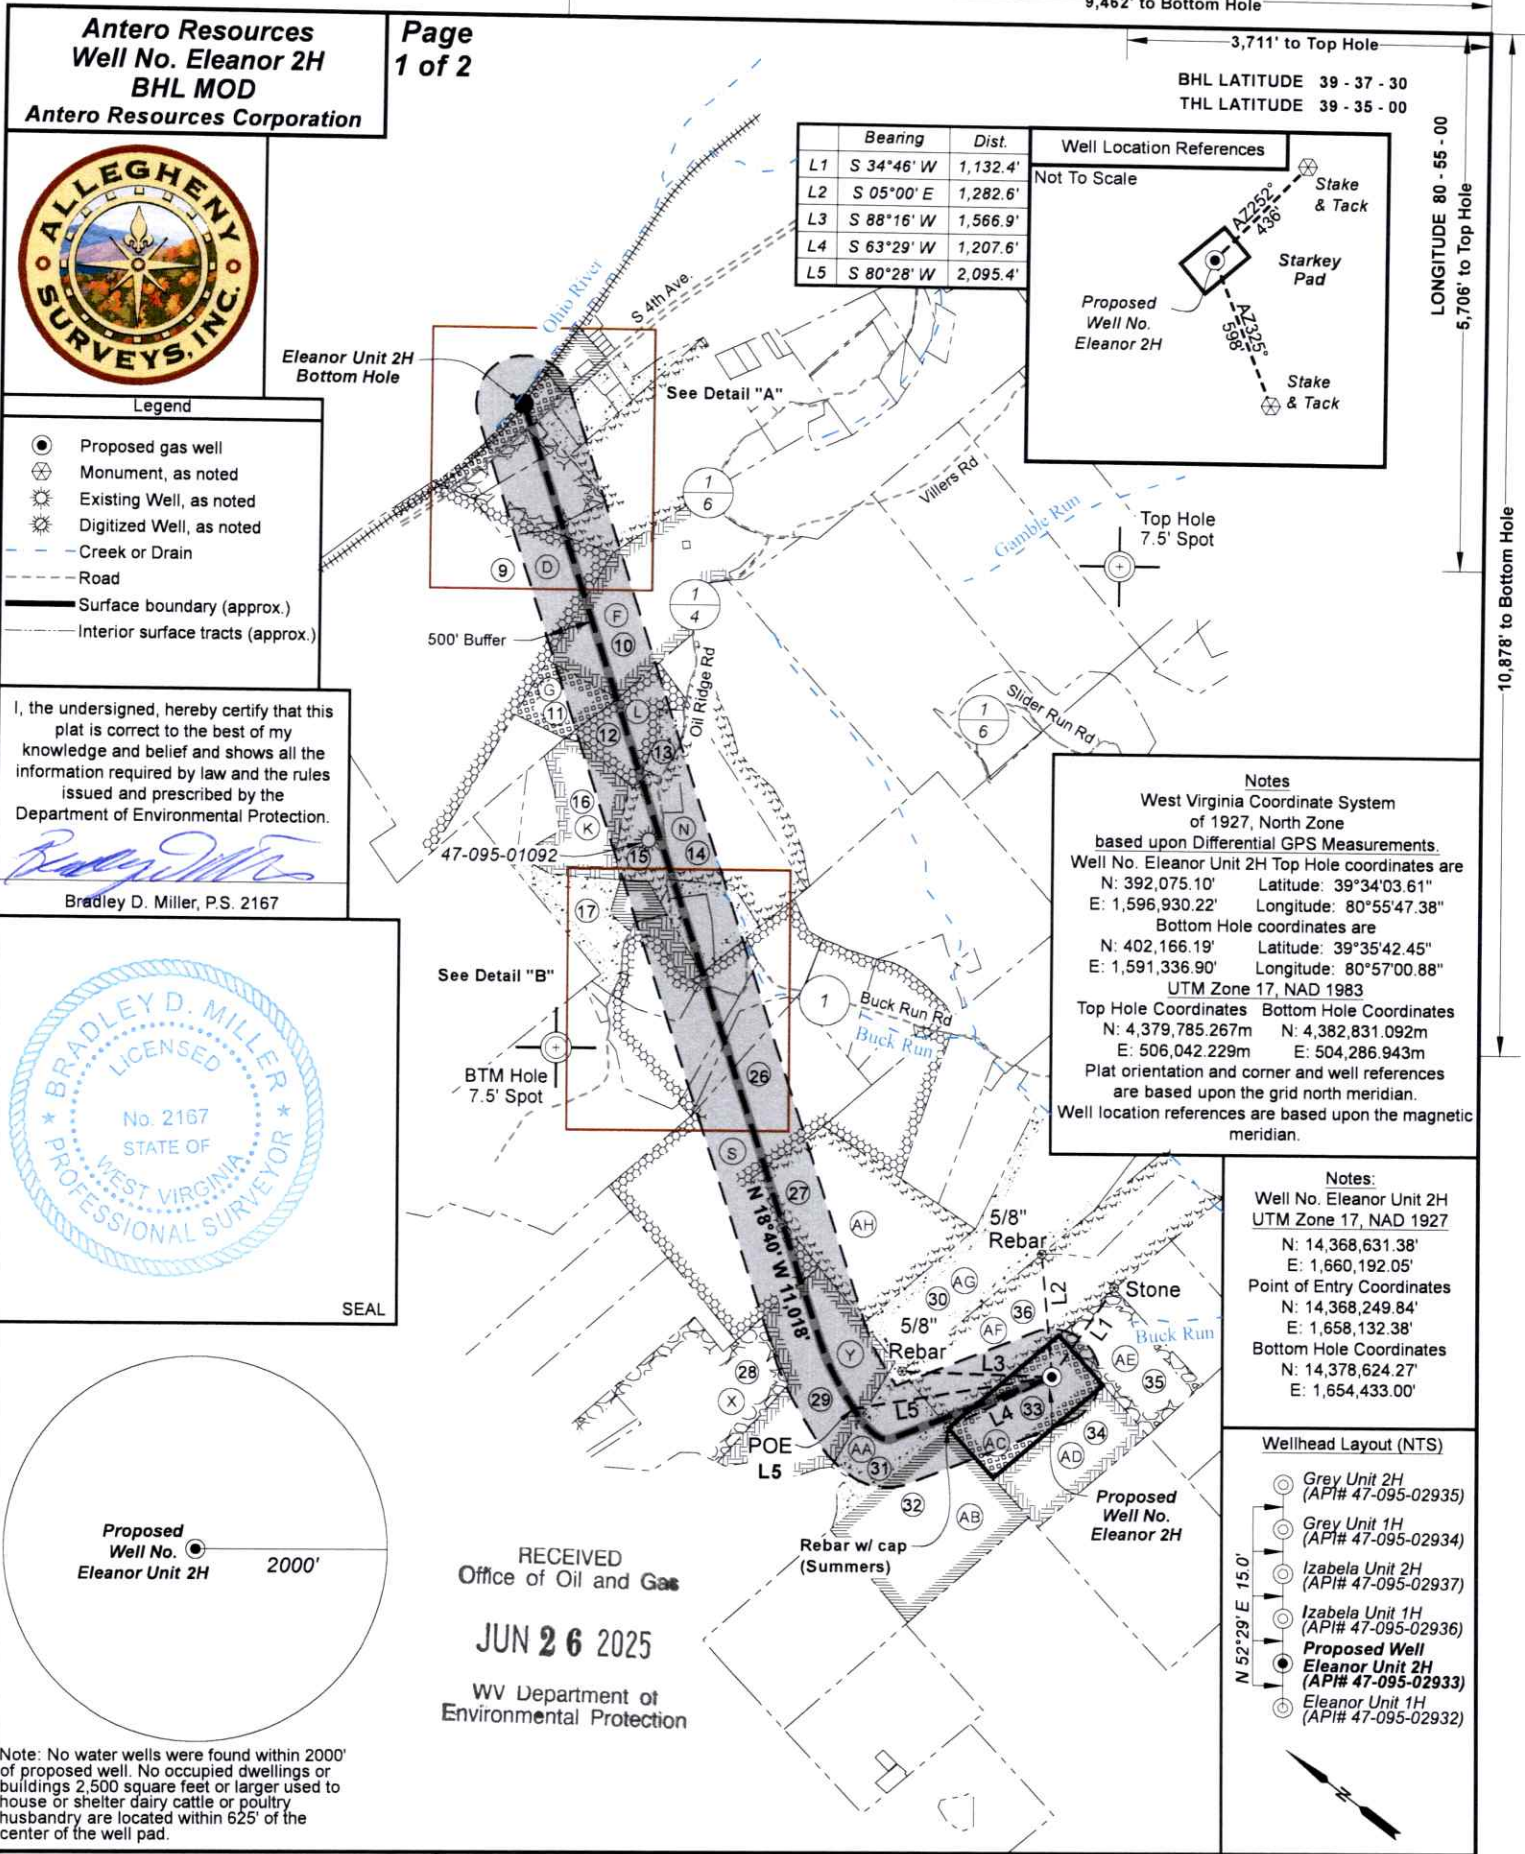

FILE NO: 157-54-L-23

DRAWING NO: Eleanor Unit 2H Well Plat

SCALE: 1" = 2000'

MINIMUM DEGREE OF ACCURACY: Submeter

PROVEN SOURCE OF ELEVATION: WVDOT, Harrisville, WV

STATE OF WEST VIRGINIA
DEPARTMENT OF ENVIRONMENTAL PROTECTION
OIL AND GAS DIVISION

DATE: June 18 2025

OPERATOR'S WELL NO. Eleanor Unit 2H

API WELL NO

47 - 095 - 02933

STATE COUNTY PERMIT

WELL TYPE: ☐ OIL ☒ GAS ☐ LIQUID INJECTION ☐ WASTE DISPOSAL

(IF GAS) PRODUCTION: ☐ STORAGE ☐ DEEP ☒ SHALLOW

LOCATION: ELEVATION: As-Built 1,092' WATERSHED: Outlet Middle Island Creek QUADRANGLE: Paden City

DISTRICT: Lincon COUNTY: Tyler 07/04/2025

SURFACE OWNER: Robert F. Scardina & Rita K. Scardina ACREAGE: 25.00

ROYALTY OWNER: Robert F. Scardina & Rita K. Scardina LEASE NO: ACREAGE: 25

PROPOSED WORK: ☐ DRILL ☐ CONVERT ☒ DRILL DEEPER ☐ FRACTURE OR STIMULATE ☐ PLUG OFF OLD FORMATION

☐ PERFORATE NEW FORMATION ☒ OTHER PHYSICAL CHANGE IN WELL (SPECIFY) BHL MOD

☐ PLUG AND ABANDON ☐ CLEAN OUT AND REPLUG TARGET FORMATION: Marcellus Shale ESTIMATED DEPTH: 20,700' MD

WELL OPERATOR: Antero Resources Corporation DESIGNATED AGENT: Conrad Baston

ADDRESS: 1615 Wynkoop Street ADDRESS: 535 White Oaks Blvd.

Denver, CO 80202 Bridgeport, WV 26330





RECEIVED
Office of Oil and Gas

JUN 26 2025

WV Department of
Environmental Protection

Leases	
A	Paul Wissmach Glass Company
B	T&D Corporation, et al
C	Albert Merton & Barbara Jo Mohrman
D	Golden Eagle Resources II, LLC
E	Stanley E. Dennis & Edith L. Dennis, JTWROS
F	Henry P. Snyder, et al
G	Stanley E. Dennis & Edith L. Dennis, h/w
K	OCTO Energy
L	Eagle Investments, LLC
N	Ralph Mikes or Dora Mikes, h/w
O	Virgil L. Cooper & Tracie J. Cooper
S	John L. Renner, II
U	Maxine Ankrom
V	Alice M. Bungard
X	Shirley Myers
Y	Moore Self Storage, North Carolina, LLC
AA	Robert F. & Rita K. Scardina
AB	Robert F. Scardina, et ux
AC	Robert F. Scardina, et ux
AD	Robert F. Scardina, et ux
AE	Robert F. Scardina, et ux
AF	AMP IV, LP
AG	Ralph David & Sophia Judge
AH	Robert W. Cross & Jean A. Cross, JTWROS
AI	Joseph D. Giovinazzo

ID	TM-Par	Owner	Bk/Pg	Acres
1	xx-xx	Owner	xx/xx	x.xx
2	3-157	Paul Wissmach Glass Co.	224/252	7.00
3	3-155	Joseph Giovinazzo, et al	WB87/748	6.07
4	1-20.4	Timothy B. & Carolyn R. Hizer	311/682	2.03
5	1-20.5	John T. Daugherty	330/854	1.91
6	1-2	Albert Merton & Barbara Jo Mohrman	399/329	5.18
7	1-3	Albert Merton & Barbara Jo Mohrman	399/329	17.50
8	1-20.1	Stanley E. & Edith L. Dennis	350/414	49.97
9	1-4	Haessly Hardwood Lumber Co.	290/457	166.20
10	1-21	Stanley E. & Edith L. Dennis	350/414	77.71
11	4-56	Stanley E. & Edith L. Dennis	394/61	11.75
12	4-63	Eagle Hardwood Inc.	345/195	16.79
13	4-62	Stephanie D. & Terrance D. Francis	537/521	3.75
14	4-65	Carl D. O'Neil	248/117	45.90
15	4-65.1	Carl D. O'Neil	WB36/381	13.26
16	4-61	Carl D. O'Neil	133/175	18.81
17	4-82.4	Virgil L. & Tracie J. Cooper	444/521	13.00
18	4-82.2	Virgil L. & Tracie J. Cooper	333/220	4.46
19	4-80	Alice M., Harley R. & Judy Bungard	352/104	8.34
20	4-81	Alice M., Harley R. & Judy Bungard	352/104	7.00
21	4-82.1	Ricky & Barbra Keys	416/328	5.80
22	4-82	Virgil E. Cooper	199/41	10.90
23	4-84	Virgil E. Cooper Jr. & Barbra J. Cooper	264/182	19.98
24	4-78.1	Earl Snider	220/11	6.63
25	4-78	Lesley J. Snider	220/13	6.83
26	4-76	Scott & Jeffery Grim	387/119	90.00
27	4-92	Robert W. & Jean A. Cross	342/751	53.00
28	4-90.1	Gary B. & Melinda J. Lewis	473/1	47.33
29	4-91	Donna K. Johnston	184/133	54.06
30	5-4	Ralph D. & Sophia Judge	306/681	60.77
31	8-12	Donna Kathy Johnston	184/133	86.89
32	8-14	Robert F. Scardina, et ux	320/646	72.79
33	5-11	Robert F. Scardina, et ux	320/646	25.00
34	5-10	Robert F. Scardina, et ux	320/646	25.00
35	5-12	Robert F. Scardina, et ux	320/646	25.00
36	5-9.4	Neil R. Stebbins	366/436	51.48

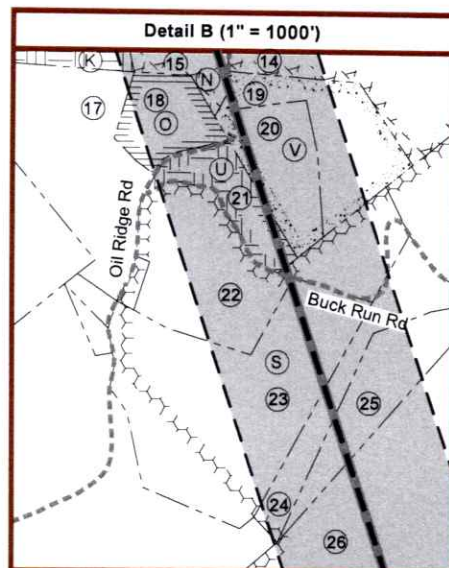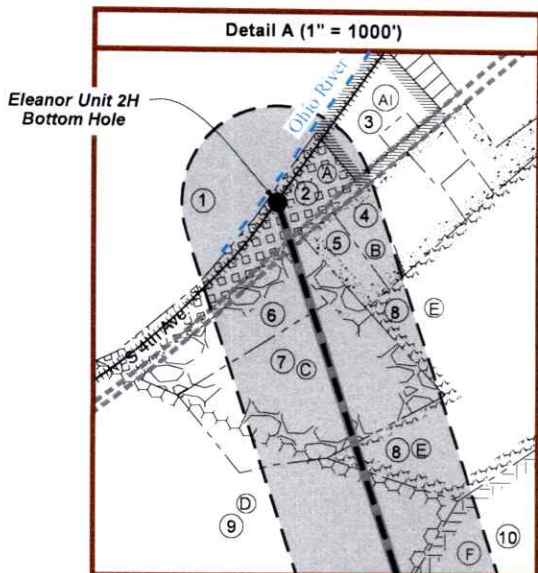

FILE NO: 157-54-L-23
DRAWING NO: Eleanor Unit 2H Well Plat
SCALE: 1" = 2000'
MINIMUM DEGREE OF ACCURACY:
Submeter
PROVEN SOURCE OF ELEVATION:
WV DOT, Harrisville, WV

STATE OF WEST VIRGINIA
DEPARTMENT OF ENVIRONMENTAL PROTECTION
OIL AND GAS DIVISION

DATE: June 18 2025
OPERATOR'S WELL NO: Eleanor Unit 2H
API WELL NO
47 - 095 - 02933
STATE COUNTY PERMIT

WELL TYPE: ☐ OIL ☒ GAS ☐ LIQUID INJECTION ☐ WASTE DISPOSAL
(IF GAS) PRODUCTION: ☐ STORAGE ☐ DEEP ☒ SHALLOW
LOCATION: ELEVATION: As-Built 1,092' WATERSHED: Outlet Middle Island Creek QUADRANGLE: Paden City
DISTRICT: Lincon COUNTY: Tyler 07/04/2025
SURFACE OWNER: Robert F. Scardina & Rita K. Scardina ACREAGE: 25.00
ROYALTY OWNER: Robert F. Scardina & Rita K. Scardina LEASE NO: ACREAGE: 25
PROPOSED WORK: ☐ DRILL ☐ CONVERT ☒ DRILL DEEPER ☐ FRACTURE OR STIMULATE ☐ PLUG OFF OLD FORMATION
☐ PERFORATE NEW FORMATION ☒ OTHER PHYSICAL CHANGE IN WELL (SPECIFY) BHL MOD 6,700' TVD
☐ PLUG AND ABANDON ☐ CLEAN OUT AND REPLUG TARGET FORMATION: Marcellus Shale ESTIMATED DEPTH: 20,700' MD

WELL OPERATOR: Antero Resources Corporation DESIGNATED AGENT: Conrad Baston
ADDRESS: 1615 Wynkoop Street ADDRESS: 535 White Oaks Blvd.
Denver, CO 80202 Bridgeport, WV 26330